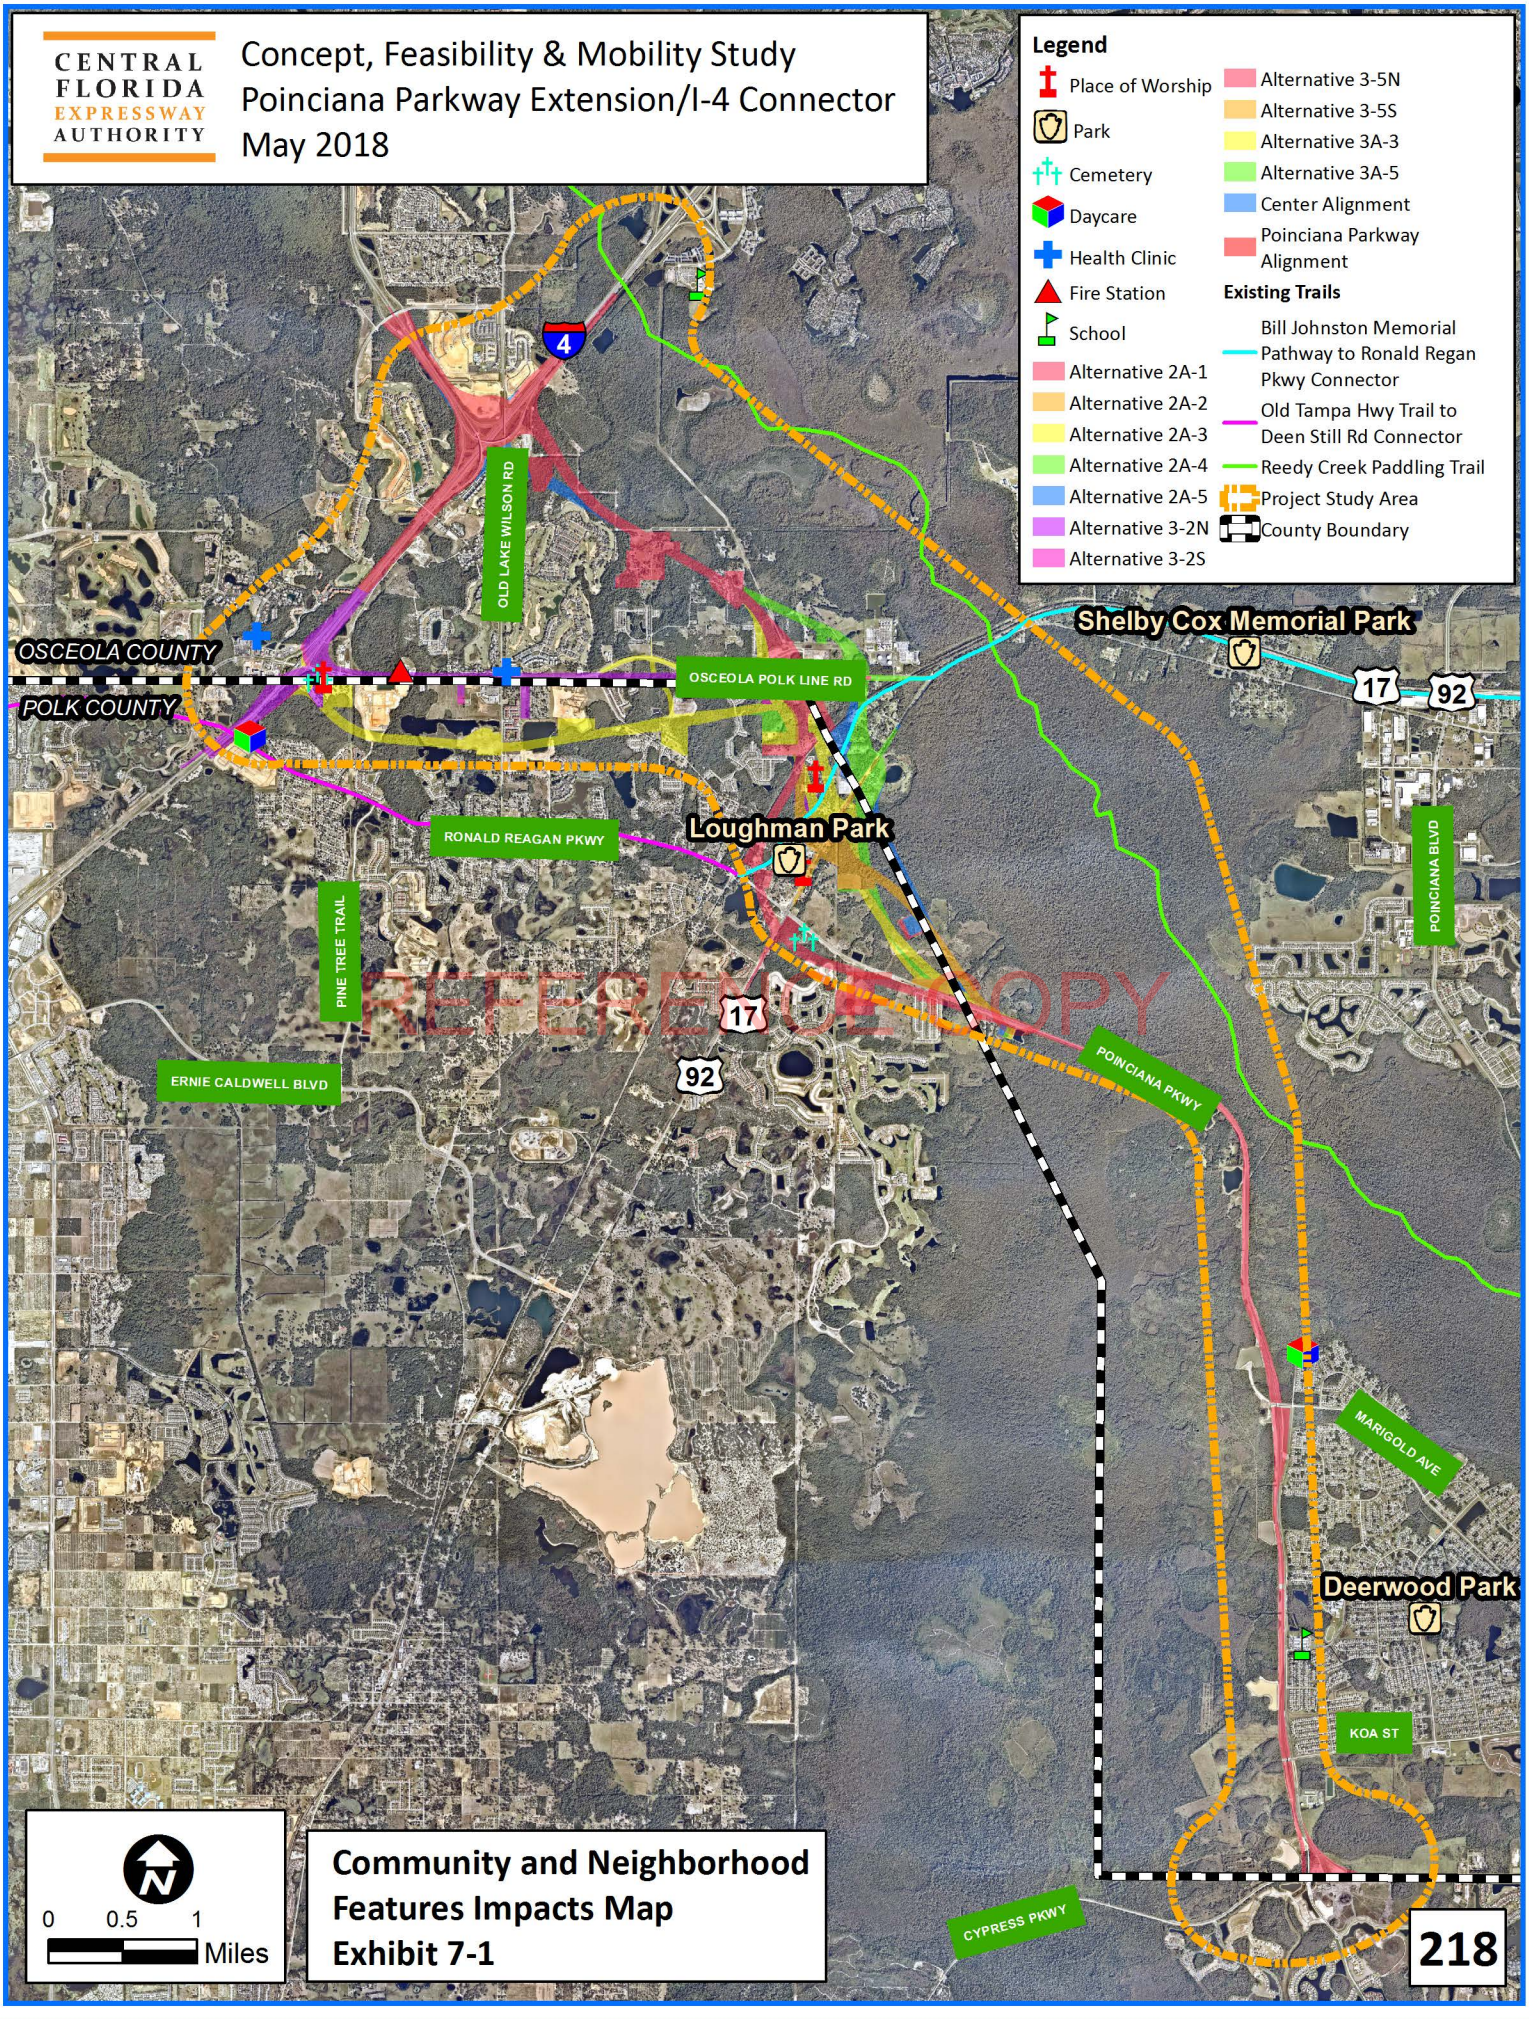

REFERENCE COPY


REFERENCE COPY




REFERENCE COPY



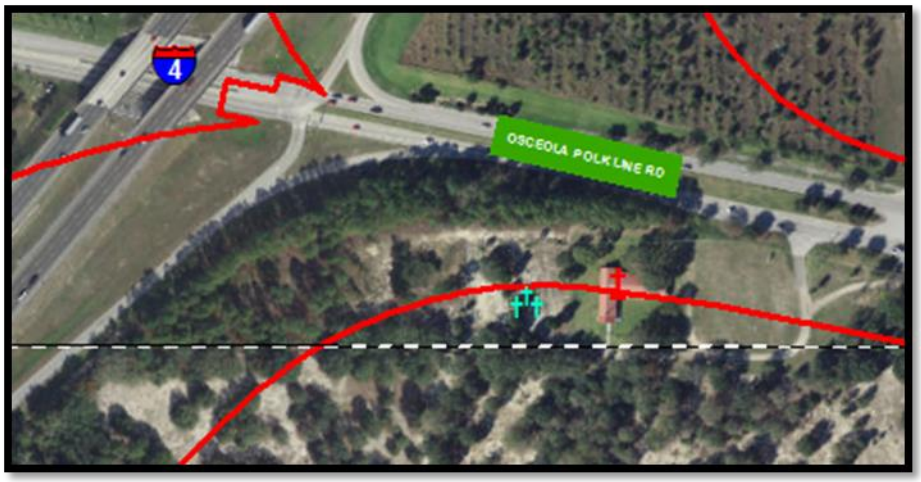


Community Cohesion






REFERENCE COPY



FMSF No.	Resource Name	Resource Type	State Historic Preservation Officer (SHPO) Evaluation	Alternative Name

REFERENCE COPY




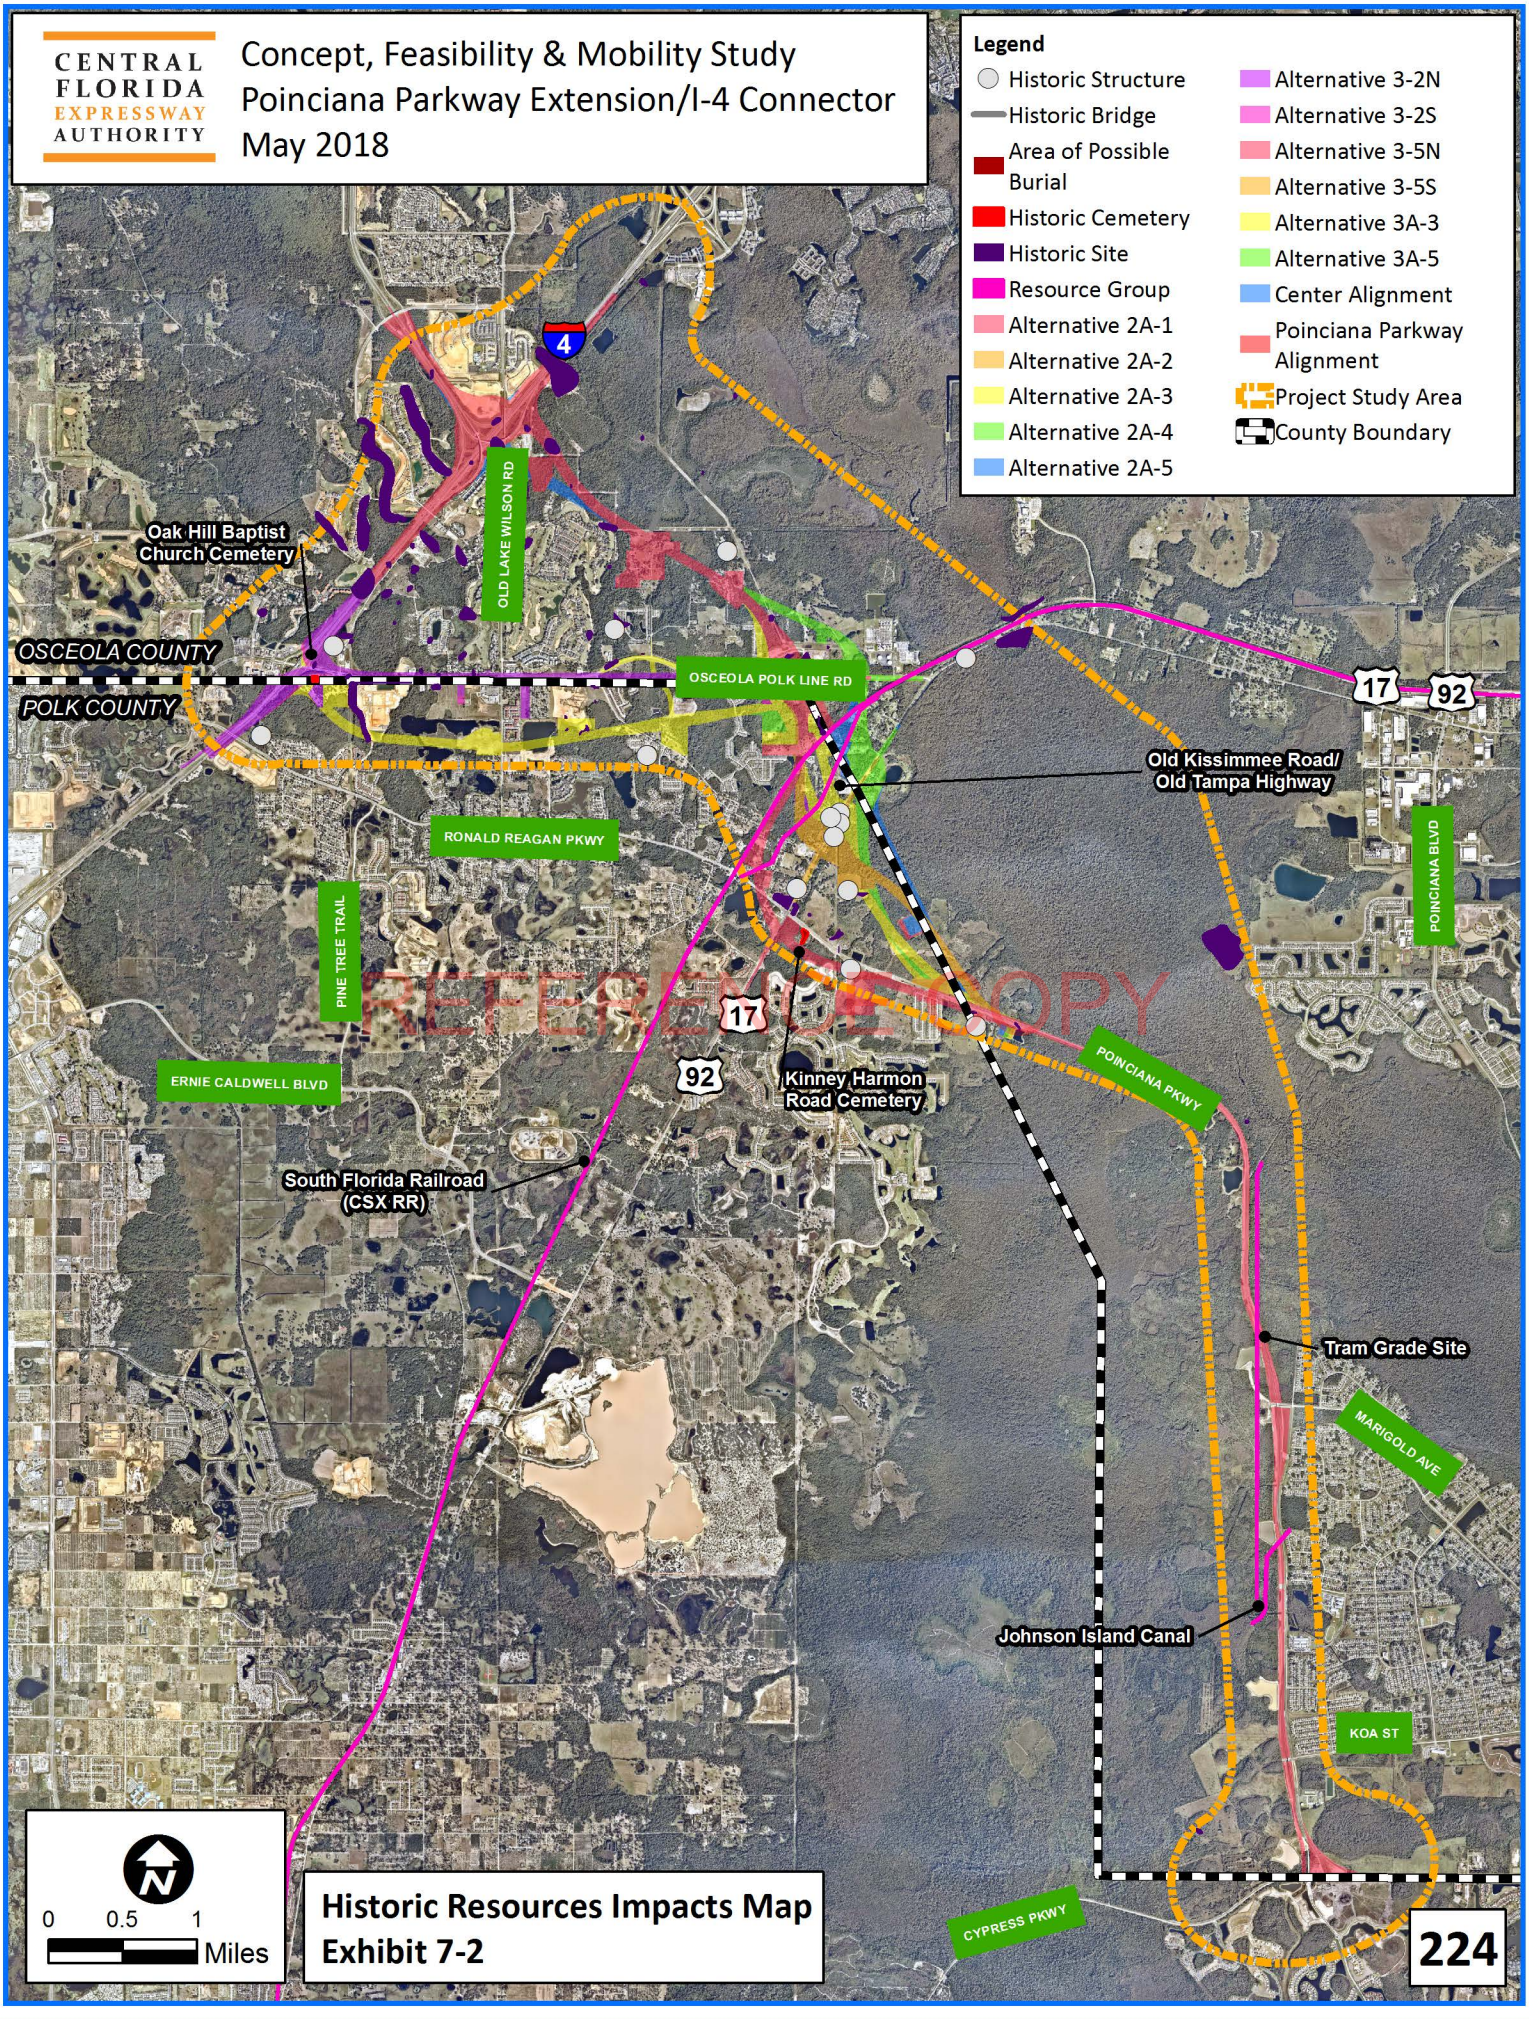
CENTRAL FLORIDA EXPRESSWAY AUTHORITY
Concept, Feasibility & Mobility Study
Poinciana Parkway Extension/I-4 Connector
May 2018
Legend
Historic Structure
Historic Bridge
Area of Possible Burial
Historic Cemetery
Historic Site
Resource Group
Alternative 2A-1
Alternative 2A-2
Alternative 2A-3
Alternative 2A-4
Alternative 2A-5
Alternative 3-2N
Alternative 3-2S
Alternative 3-5N
Alternative 3-5S
Alternative 3A-3
Alternative 3A-5
Center Alignment
Poinciana Parkway Alignment
Project Study Area
County Boundary
Oak Hill Baptist Church Cemetery
OLD LAKE WILSON RD
OSCEOLA COUNTY
POLK COUNTY
OSCEOLA POLK LINE RD
Old Kissimmee Road/ Old Tampa Highway
RONALD REAGAN PKWY
PINE TREE TRAIL
POINCIANA BLVD
ERNIE CALDWELL BLVD
Kinney Harmon Road Cemetery
South Florida Railroad (CSX RR)
POINCIANA PKWY
Tram Grade Site
MARIGOLD AVE
Johnson Island Canal
KOA ST
CYPRESS PKWY
4
17
92
0 0.5 1 Miles
Historic Resources Impacts Map
Exhibit 7-2
224





Alternatives	Previously Recorded Resources	Unrecorded Resources		
	Linear Resource	County Property Appraiser Historic-Age Parcels	Other Potential Historic Resources	Total Unrecorded Resources

REFERENCE COPY




Alternatives	Impacts





7.3 NOISE


7.4 AIR QUALITY




7.5 CONTAMINATION




Alternatives	GWCA (Acres)	Contamination Sites and Facilities

REFERENCE COPY

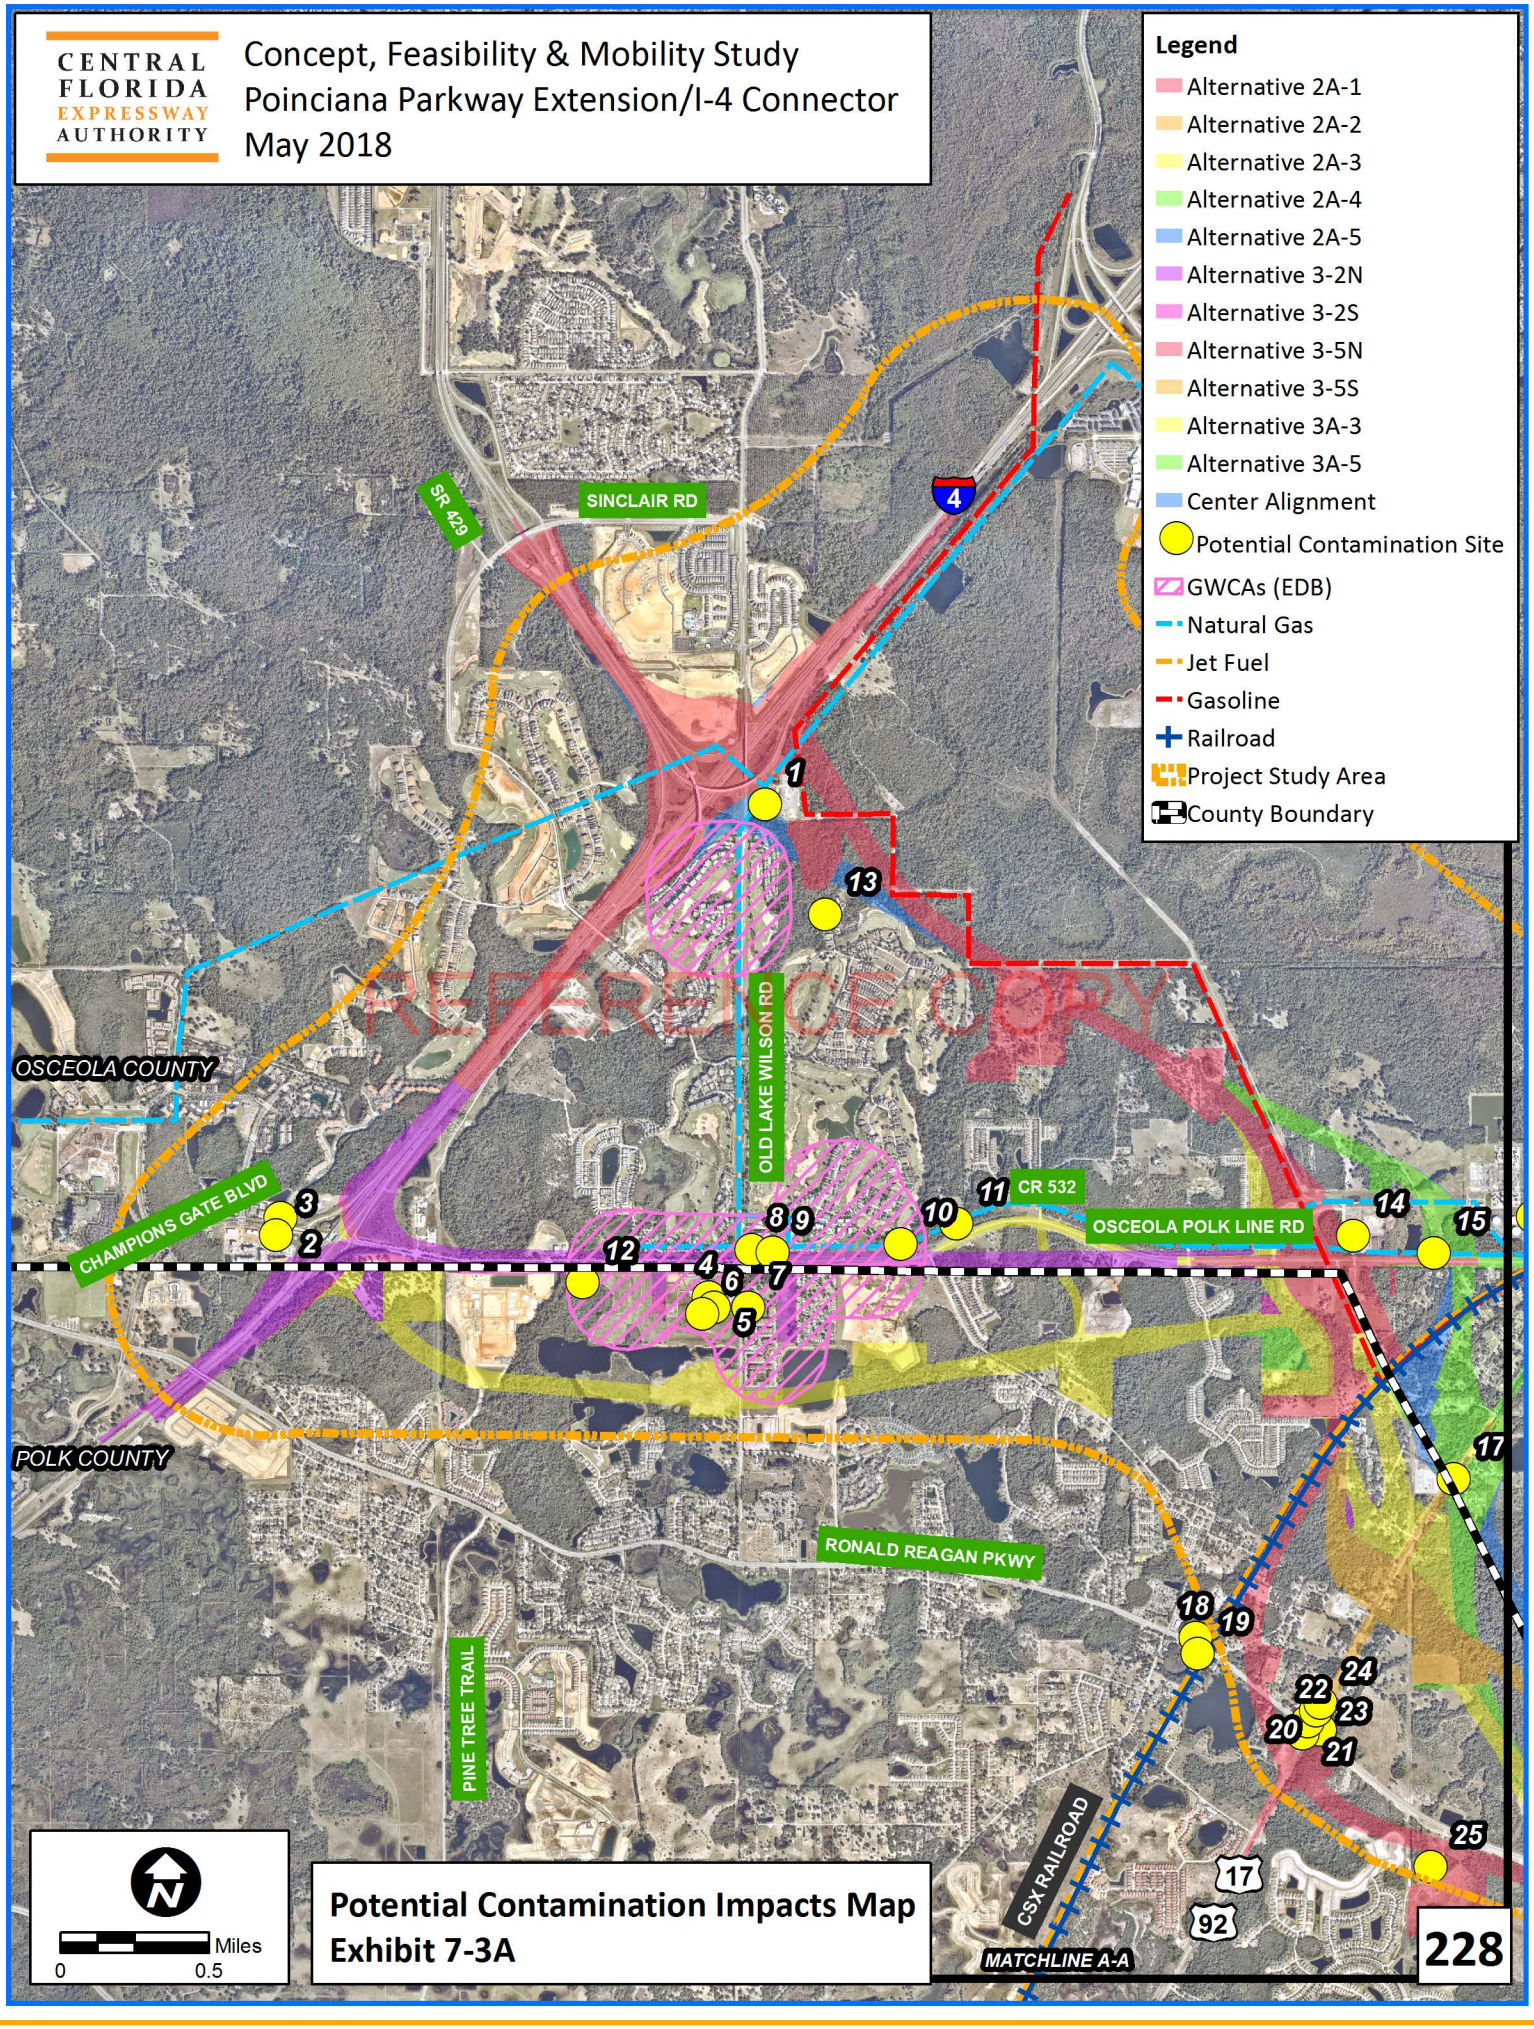
CENTRAL FLORIDA EXPRESSWAY AUTHORITY
Concept, Feasibility & Mobility Study
Poinciana Parkway Extension/I-4 Connector
May 2018
Legend
Alternative 2A-1
Alternative 2A-2
Alternative 2A-3
Alternative 2A-4
Alternative 2A-5
Alternative 3-2N
Alternative 3-2S
Alternative 3-5N
Alternative 3-5S
Alternative 3A-3
Alternative 3A-5
Center Alignment
Potential Contamination Site
GWCAs (EDB)
Natural Gas
Jet Fuel
Gasoline
Railroad
Project Study Area
County Boundary
SR 429
SINCLAIR RD
4
OSCEOLA COUNTY
OLD LAKE WILSON RD
CHAMPIONS GATE BLVD
CR 532
OSCEOLA POLK LINE RD
POLK COUNTY
RONALD REAGAN PKWY
PINE TREE TRAIL
CSX RAILROAD
MATCHLINE A-A
1
2
3
4
5
6
7
8
9
10
11
12
13
14
15
17
18
19
20
21
22
23
24
25
92
REFERENCE COPY
N
Miles
0
0.5
Potential Contamination Impacts Map
Exhibit 7-3A
228

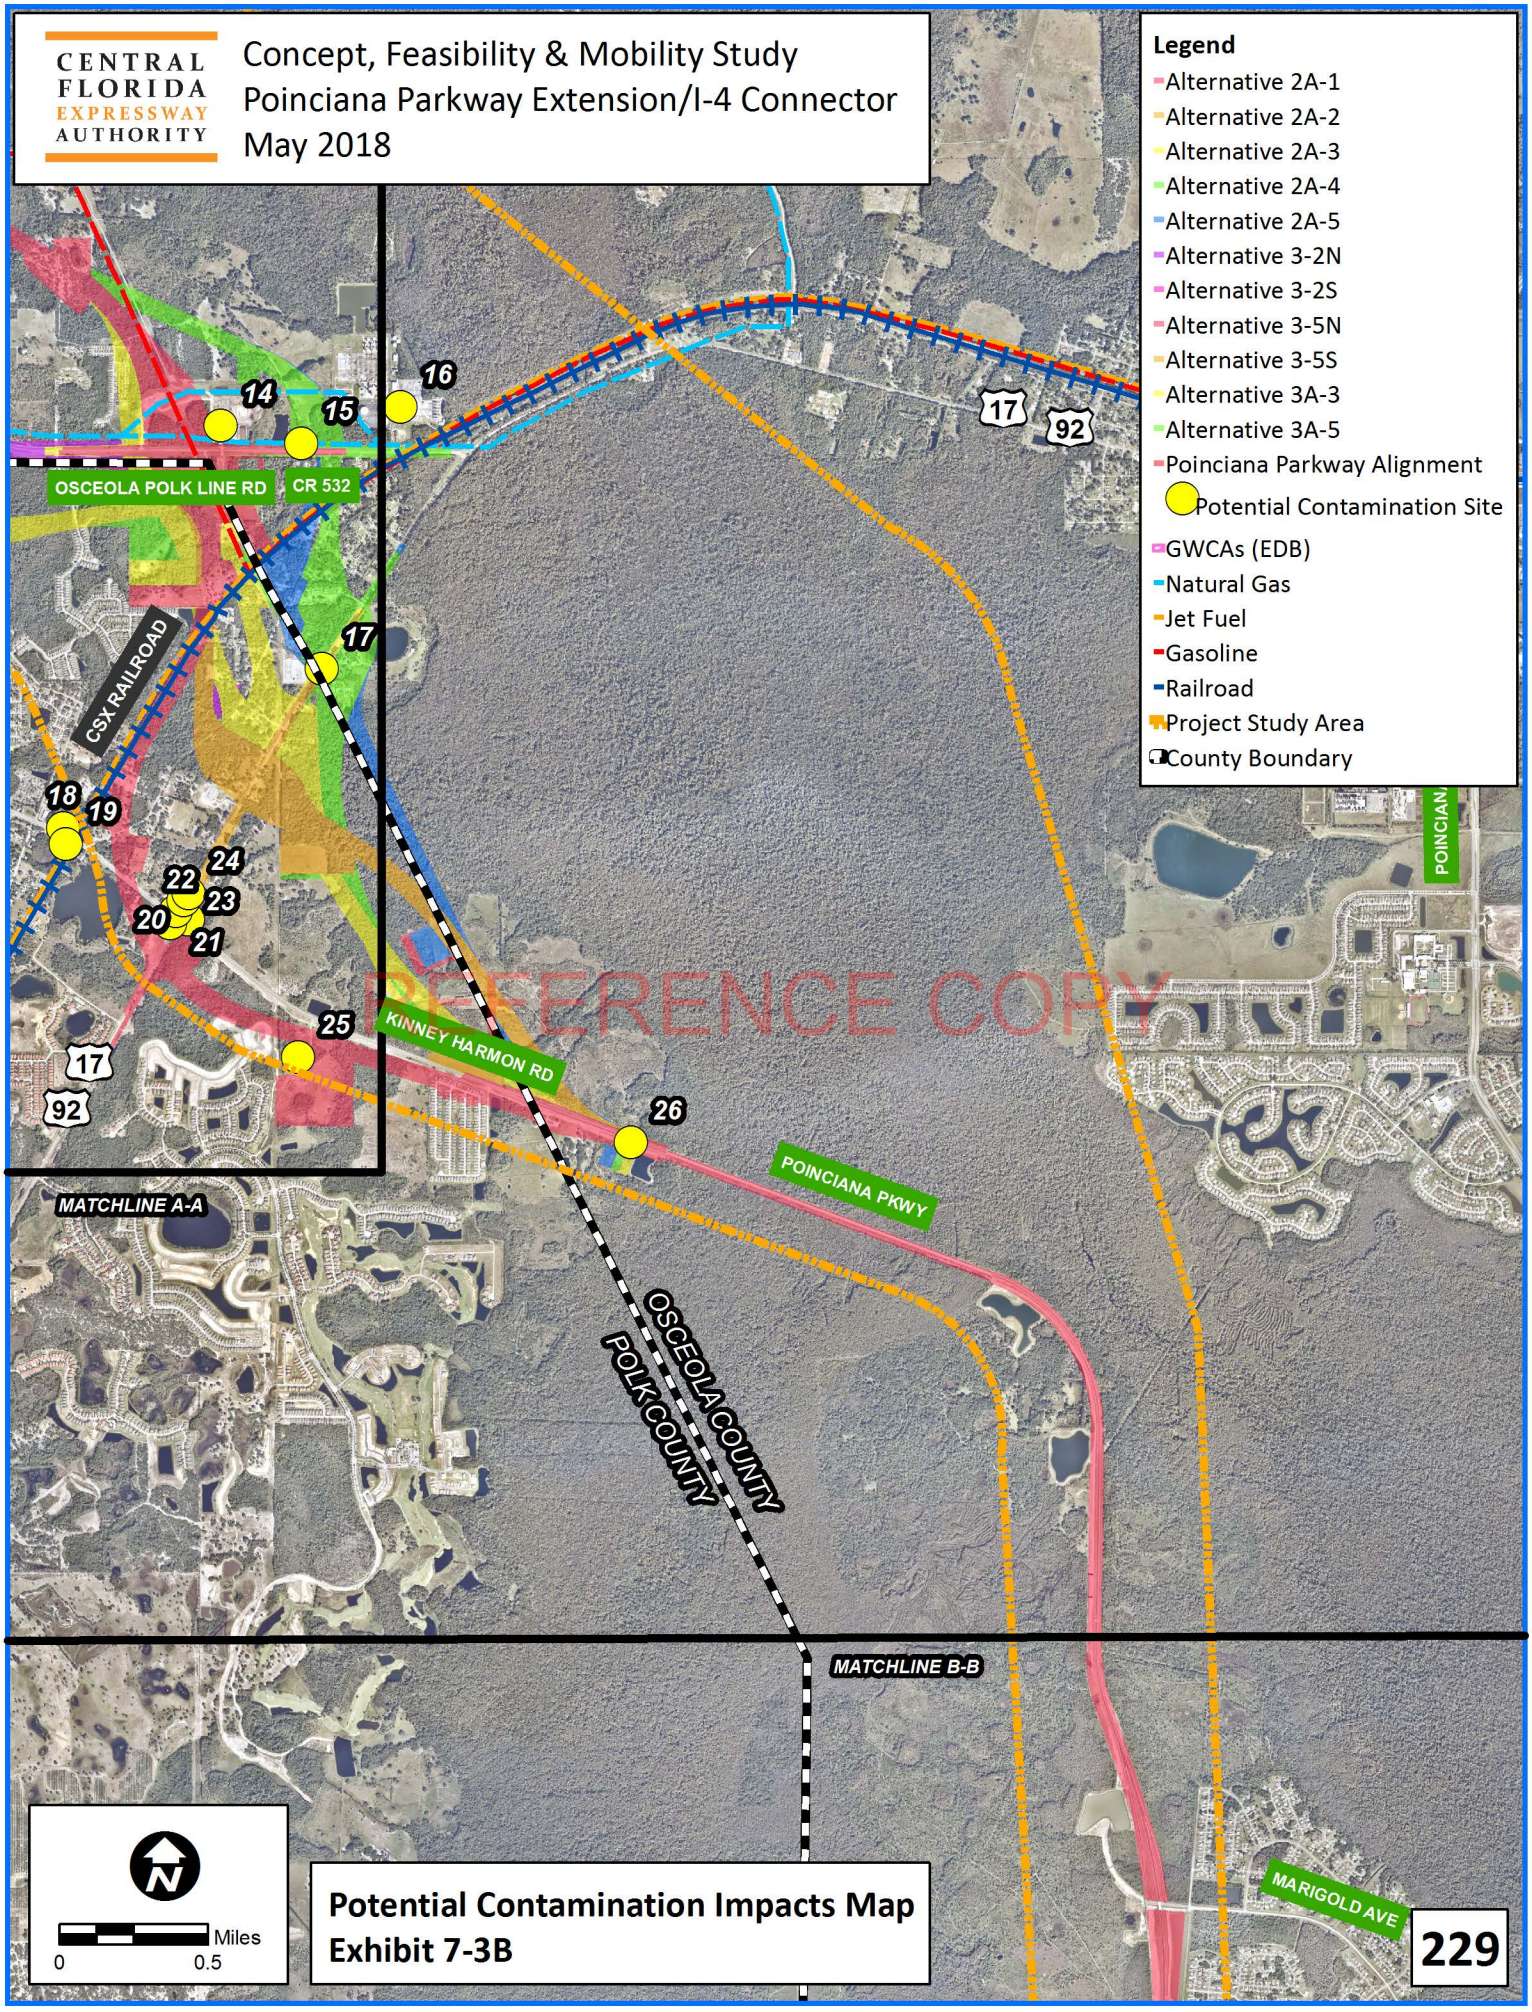
CENTRAL FLORIDA EXPRESSWAY AUTHORITY
Concept, Feasibility & Mobility Study
Poinciana Parkway Extension/I-4 Connector
May 2018
Legend
Alternative 2A-1
Alternative 2A-2
Alternative 2A-3
Alternative 2A-4
Alternative 2A-5
Alternative 3-2N
Alternative 3-2S
Alternative 3-5N
Alternative 3-5S
Alternative 3A-3
Alternative 3A-5
Poinciana Parkway Alignment
Potential Contamination Site
GWCAs (EDB)
Natural Gas
Jet Fuel
Gasoline
Railroad
Project Study Area
County Boundary
OSCEOLA POLK LINE RD
CR 532
CSX RAILROAD
KINNEY HARMON RD
POINCIANA PKWY
OSCEOLA COUNTY
POLK COUNTY
MATCHLINE A-A
MATCHLINE B-B
MARIGOLD AVE
14
15
16
17
18
19
20
21
22
23
24
25
26
92
REFERENCE COPY
Miles
0
0.5
Potential Contamination Impacts Map
Exhibit 7-3B
229

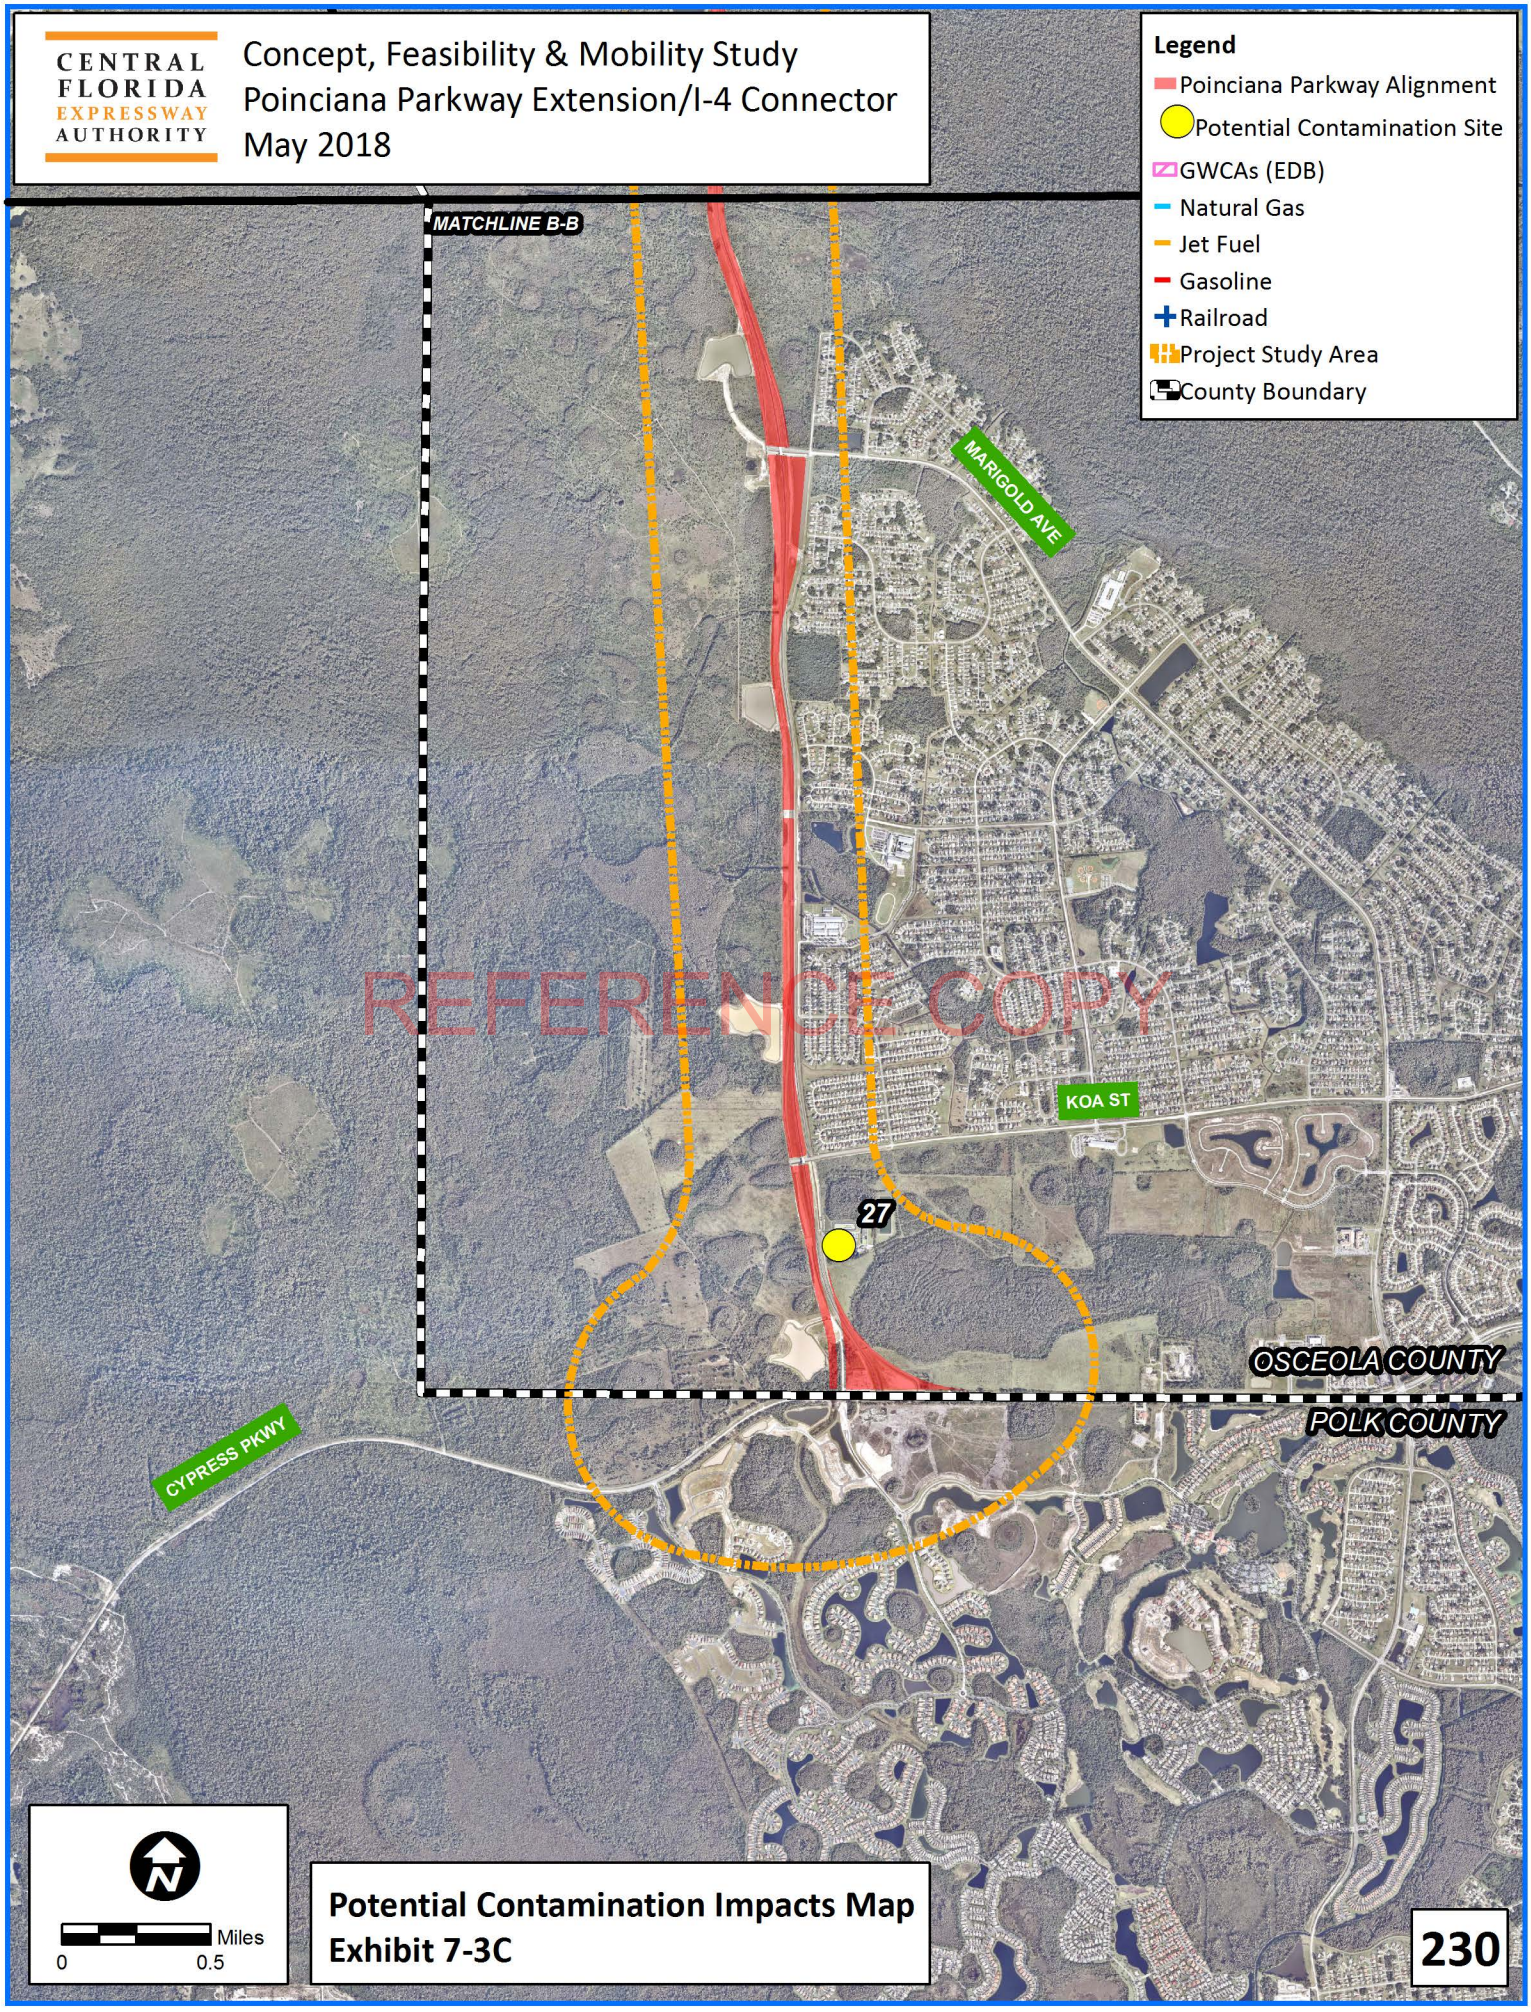
CENTRAL FLORIDA EXPRESSWAY AUTHORITY
Concept, Feasibility & Mobility Study
Poinciana Parkway Extension/I-4 Connector
May 2018
Legend
Poinciana Parkway Alignment
Potential Contamination Site
GWCAs (EDB)
Natural Gas
Jet Fuel
Gasoline
Railroad
Project Study Area
County Boundary
MATCHLINE B-B
MARIGOLD AVE
KOA ST
27
OSCEOLA COUNTY
POLK COUNTY
CYPRESS PKWY
REFERENCE COPY
Miles
0
0.5
Potential Contamination Impacts Map
Exhibit 7-3C
230

7.6 UTILITIES



Alternative 2A I-4 Interchange at S.R. 429, North Alignment

Existing Utility Impacts:


Planned Utility Impacts:


Alternative 2A I-4 Interchange at S.R. 429, Center Alignment

Existing Utility Impacts:


Planned Utility Impacts:


Alternatives 2A-1, 2A-2, and 2A-3

Existing Utility Impacts:


REFERENCE COPY


Planned Utility Impacts:


Alternatives 2A-4 and 2A-5

Existing Utility Impacts:


Planned Utility Impacts:


REFERENCE COPY

Alternative 3-2N

Existing Utility Impacts:


Planned Utility Impacts:


Alternative 3-2S

Existing Utility Impacts:


Planned Utility Impacts:


Alternative 3-5N

Existing Utility Impacts:


Planned Utility Impacts:


Alternative 3-5S

Existing Utility Impacts:


REFERENCE COPY


Planned Utility Impacts:


Alternatives 3A-3 and 3A-5

Existing Utility Impacts:


7.7 RAILROADS


REFERENCE COPY

7.8 ANTICIPATED PERMITS REQUIRED





7.9 SUMMARY MATRIX - ANTICIPATED EFFECTS


[3] **Because the project extends over two water management districts, it is anticipated that one water management district would take the lead in issuance of the ERP.**


Evaluation Criteria	Unit of Measure	2A-1	2A-2	2A-3	2A-4	2A-5	3-2N	3-2S	3-5N	3-5S	3A-3	3A-5
Physical												

REFERENCE COPY




Evaluation Criteria	Unit of Measure	2A-1	2A-2	2A-3	2A-4	2A-5	3-2N	3-2S	3-5N	3-5S	3A-3	3A-5

REFERENCE COPY















REFERENCE COPY

8.0 STAKEHOLDER INVOLVEMENT

8.1 INTRODUCTION

Stakeholder and public involvement was an integral part of the Concept, Feasibility and Mobility Study. Multiple opportunities for participation were provided, including:

- Environmental Advisory Group meetings
- Project Advisory Group meetings
- Meetings with local governments
- Meetings with various stakeholders (e.g., property owners, utility providers, community groups, and transportation agencies)
- Public Meetings

A summary of stakeholder involvement is provided below.

8.2 STAKEHOLDER COORDINATION AND MEETINGS

8.2.1 ENVIRONMENTAL ADVISORY GROUP

An Environmental Advisory Group (EAG) was formed to provide input to the four Concept, Feasibility and Mobility Studies being conducted by CFX. The four corridors being studied are:

- Poinciana Parkway Extension/I-4 Connector Expressway (13 miles);
- Southport Connector Expressway (13 miles);
- Northeast Connector Expressway (25 miles); and
- Osceola Parkway Extension (9 miles).

REFERENCE COPY

The first EAG meeting was held on July 11, 2017. The purpose of this EAG meeting was to review the study corridors, to present an update on the status of potential impacts, and to inform the study teams of local needs, issues and concerns within the study limits with regard to environmental impacts. There were 25 attendees, including representatives from the following:

- Audubon Society – Central Florida
- East Central Florida Regional Planning Council
- Florida Department of Transportation (FDOT), District Five
- Florida Fish and Wildlife Conservation Commission
- Florida's Turnpike Enterprise (FTE)
- Orange County Environmental Protection Division
- Osceola County Environmental Lands Conservation Program
- Osceola County Transportation
- Poinciana Residents for Smart Change
- Polk County
- Reedy Creek Improvement District (RCID)
- Sierra Club
- South Florida Water Management District
- City of St. Cloud, Planning and Zoning
- Walt Disney Imagineering











REFERENCE COPY











REFERENCE COPY












REFERENCE COPY






















REFERENCE COPY


















REFERENCE COPY









REFERENCE COPY





















REFERENCE COPY


8.3 PROJECT WEB SITE





8.4 MEDIA COVERAGE




PUBLIC VERSION COPY








REFERENCE COPY

9.0 FEASIBILITY AND VIABILITY OF THE PROPOSED PROJECT

9.1 BENEFITS OF THE PROPOSED PROJECT













REFERENCE COPY

9.2 CONTROVERSY OF THE PROPOSED PROJECT

Some residents in Loughman oppose an expressway which travels through their community, especially the area around the New Antioch Baptist Church and cemetery. During a meeting with these residents, they did support Alternative 2A-5, if the project is constructed. Based on conversations with some of these residents during the public meetings, Alternatives 2A-4 and 2A-5 would also be preferred over any of the other build alternatives.

In general, residents with property impacted by the various alternatives are opposed to that alternative, and some support alternatives which do not impact their property. For example, some residents impacted by alternatives 3A-3 or 3A-5 oppose these alternatives while supporting the other alternatives. More information about specific public comments is provided in Section 8.2.6.

There is general consensus that a connection to I-4 at S.R. 429 is preferred over connecting to I-4 at C.R. 532, including the views of the Florida Department of Transportation (FDOT). Currently, there is significant congestion on I-4 between C.R. 532 and S.R. 429 and the expectation is that connecting to I-4 at C.R. 532 would worsen the congestion on I-4. This concern is supported by the analysis documented in Section 6 of this report.

The Reunion Community Development District (CDD) is opposed to alternatives which require the reconstruction of C.R. 532 (Alternatives 3-2N, 3-2S, 3-5N and 3-5S). They consider C.R. 532 to be the gateway to their development and believe the expressway would be detrimental to their entrance. However, some Reunion residents oppose the 2A alternatives.

Florida Gas Transmission expressed opposition to any alternatives which impact their substation located south of I-4 near S.R. 429.

REFERENCE COPY

9.3 SUPPORT FOR THE PROPOSED PROJECT

There was general support for the project during meetings with the Project Advisory Group, the Environmental Advisory Group, stakeholders, and the public. The proposed project is expected to help relieve existing congestion on C.R. 532, Lake Wilson Road and U.S. 17/92.

Stakeholders expressing support for the project include:

- FDOT (connection to I-4 at S.R. 429)
- Florida's Turnpike Enterprise (connection to I-4 at S.R. 429)
- Reunion CDD (connection to I-4 at S.R. 429)
- ChampionsGate CDD (connection to I-4 at S.R. 429)
- Walt Disney Imagineering
- Reedy Creek Improvement District
- Osceola County
- Polk County

9.4 PROJECTED PROJECT COSTS

Table 9-1 summarizes the projected costs for each alternative, which include roadway construction, bridge construction, interchange construction, toll collection equipment, right-of-way (including ponds), and mitigation for wetlands and wildlife. All costs are in 2017 dollars.


Total	**$1,398,400,000**	**$1,315,900,000**	**$1,330,600,000**	**$1,258,400,000**	**$1,288,600,000**	**$1,075,500,000**	**$989,700,000**	**$1,061,800,000**	**$986,700,000**	**$734,000,000**	**$745,600,000**

REFERENCE COPY

The 2A alternatives have the highest costs, ranging from $1,258,400,000 (Alternative 2A-4) to $1,398,400,000 (Alternative 2A-1). The 3-2 alternatives range in cost from $986,700,000 (Alternative 3-5S) to $1,258,400,000 (Alternative 3-2N). The 3A alternatives have the lowest costs, ranging from $734,000,000 (Alternative 3A-3) to $745,600,000 (Alternative 3A-5).

There is the potential for CFX to implement the Poinciana Parkway Extension/I-4 Connector in phases, with the first phase extending the expressway to C.R. 532. Table 9-2 summarizes the costs for constructing the expressway from the north end of the existing Poinciana Parkway bridge to C.R. 532 for Alternatives 2A-1, 2A-2, 2A-3, 2A-4 and 2A-5. These costs range from $320,000,000 to $409,800,000. In addition to this improvement, widening the existing Poinciana Parkway to 4-lanes, from Cypress Parkway to the north end of the existing bridge, is projected to cost $99,300,000. The total cost for widening and extending Poinciana Parkway to C.R. 532 range from $419,300,000 to $509,100,000.

Table 9-2: Summary of Projected Costs - Cypress Parkway to C.R. 532

Cost Estimate	2A-1	2A-2	2A-3	2A-4	2A-5
Poinciana Parkway Extension, from north end of Poinciana Parkway Bridge to C.R. 532	$409,800,000	$349,600,000	$353,400,000	$320,000,000	$345,000,000
Widen Poinciana Parkway, from Cypress Parkway to north end of Poinciana Parkway Bridge	$99,300,000	$99,300,000	$99,300,000	$99,300,000	$99,300,000
Total	$509,100,000	$448,900,000	$452,700,000	$419,300,000	$444,300,000

REFERENCE COPY

To facilitate traffic accessing Poinciana Parkway Extension to/from I-4, C.R. 532 should be widened and the C.R. 532 interchange with I-4 should be improved. Widening C.R. 532 is planned by Osceola County; however, it is not in their current five-year improvement program. To address existing congestion at the C.R. 532/I-4 interchange, as well as additional traffic using the Poinciana Parkway Extension, the FDOT should consider implementing as soon as possible their planned approach of converting the existing interchange to a diverging diamond interchange.

9.5 PROJECTED TRAFFIC AND REVENUE

9.5.1 2045 REVENUE ANALYSIS

Using the CFX 3.0 travel demand model, CDM Smith prepared planning-level estimates of annual transaction and toll revenue attributable to the proposed Poinciana Parkway/I-4 Connector project. Traffic and revenue (T&R) estimates were prepared for each of the alternatives based on the physical alignments and connection points to the local street system. Toll collection was assumed to be all-electronic toll collection with one toll collection location per segment (between interchanges). Toll rates were set on a per-mile basis, with a base toll rate of $0.18/mile in FY 2018 dollars, escalated at 1.5 percent per year, consistent with the CFX Customer First Toll Policy. Toll sensitivity analysis was completed for each of the project alternatives with a No-build, Build No-Toll, and a range of toll rates between $0.13/mile to $0.28/mile. These estimates contain a T&R from new toll collection locations on the Poinciana Parkway Extension/I-4 Connector, and do not include the T&R from the existing section of the Poinciana Parkway. The medium socio-economic data set was used for the T&R estimates, with

sensitivity testing completed using the low-side and high-side socio-economic data sets. A summary of the annual transactions and annual toll revenue of each alternative over the thirty-year study period are depicted on Exhibits 9-1 and 9-2.

Exhibit 9-1: Poinciana Parkway Extension/I-4 Connector Alternatives Annual Transactions

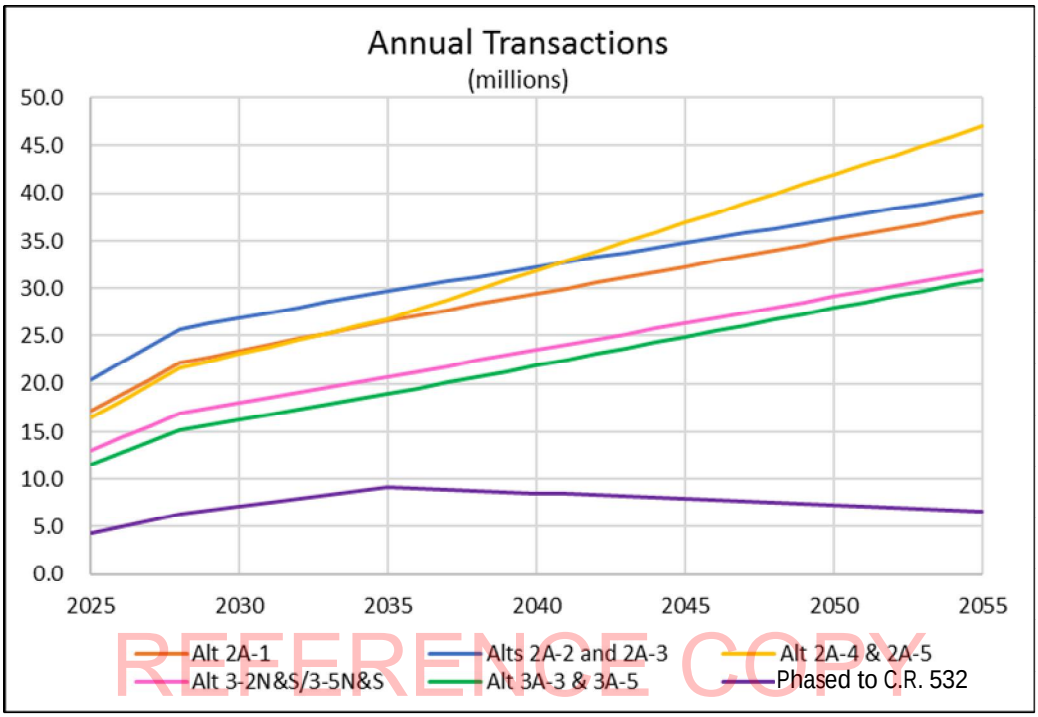

REFERENCE COPY

Exhibit 9-2: Poinciana Parkway Extension/I-4 Connector Alternatives Annual Toll Revenue

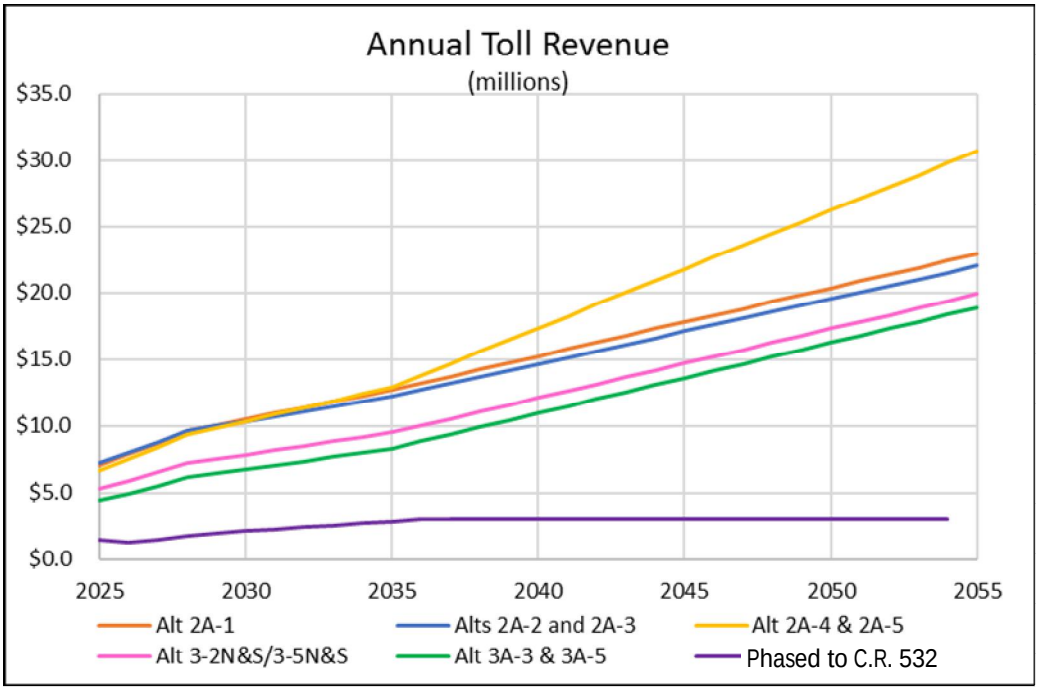





Revenue Assumptions	2A-1 [1]	2A-2 2A-3 [2]	2A-4 2A-5 [3]	3-2N&S 3-5N&S [4]	3A-3 3A-5 [5]	Phased to C.R. 532 [6]

Project Notes:

REFERENCE COPY

9.6 ALTERNATIVE COMPARISON MATRIX




Evaluation Criteria	Unit of Measure	2A-1	2A-2	2A-3	2A-4	2A-5	3-2N	3-2S	3-5N	3-5S	3A-3	3A-5
Design												
Alternative Length (approximate)	Miles	13.3	12.7	12.7	13.0	12.9	13.3	13.3	13.2	13.2	13.4	13.3
Proposed Right-of-Way Width (general and varies at interchanges)	feet	324	324	324	324	324	324 & 304	324 & 304	324 & 304	324 & 304	324	324
Proposed Bridges	Structures	37	27	27	20	24	26	26	25	25	26	26
(total structures per alternative / total length of all structures)	feet	23,404	21,347	21,078	21,403	22,029	11,391	11,490	11,263	11,394	8,690	8,236
Proposed Interchanges	Number	5	5	5	5	5	6	6	6	6	5	5
Projected 2045 Annual Average Daily Traffic (AADT) Volume (as a tolled facility)	vehicles	46,600	44,400	44,400	41,900	41,900	30,800	30,800	30,800	30,800	31,700	31,700
Physical												
Major Utility Conflicts - Existing	No. of Conflicts	27	27	27	26	28	15	13	14	13	8	8
Major Utility Conflicts - Planned	No. of Conflicts	2	2	2	3	3	1	1	2	1	1	1
Contamination Sites & Facilities	No. of Conflicts	2	3	3	3	3	4	2	6	3	1	2
Railroad Involvement	No. of Conflicts	1	1	1	1	1	1	1	1	1	1	1
Cultural Environment Effects												
Public Lands	acres	0	0	0	0	0	0	0	0	0	0	0
Section 4(f) Coordination Required(Public Recreation Lands, Wildlife Refuges, etc.)	Y/N	Y	Y	Y	Y	Y	Y	Y	Y	Y	Y	Y
Potential Historic Resources	No. of Conflicts	2	1	1	2	2	1	1	2	2	1	3
Potential Historic Linear Resources (Canals/Highways/Railroads)	No. of Resources	1	1	1	2	3	1	1	3	3	1	3
Potential Archaeological Resources	No. of Resources	3	3	3	3	3	2	0	2	0	0	0
Natural Environment												
Water Features												
Ponds / Lakes	acres	1	0	0	1	1	0	0	1	1	9	10
Canals/Regulated Floodways	No. of Conflicts	6	6	6	8	8	0	0	2	2	1	2
Flood Hazard Areas - 100 Year Floodplain	acres	176	222	203	149	130	204	211	128	136	247	220
Wetlands (non-forested and forested)	acres	171	185	162	165	165	105	108	84	84	155	169
Potential Habitat - Federal Listed Species	acres	555	576	564	511	506	406	411	396	375	463	461
Potential Habitat - State Listed Species	acres	298	297	296	254	258	294	301	245	247	387	363
Potential Bald Eagle Nest	Y/N	N	N	N	N	N	N	N	N	N	N	N
Potential Species Impacts (composite rating)	Rating	HIGH	HIGH	HIGH	HIGH	HIGH	HIGH	HIGH	HIGH	HIGH	HIGH	HIGH
Mitigation Banks												
Reedy Creek Mitigation Bank	acres	11	52	41	36	46	52	52	48	48	33	48
Conservation Easements												
Upper Lakes Basin Watershed	acres	0	0	0	1	21	0	0	21	21	0	22
Reedy Creek Improvement District	acres	11	11	11	11	11	0	0	0	0	0	0
SFWMD Conservation Lands	acres	57	35	35	35	35	0	0	2	2	2	2
Social												
Right-of-Way Area (including proposed ponds)	acres	560	541	532	502	492	341	346	312	309	455	454
Potential Residential Impacts (includes partially impacted parcels)	Total Parcels	174	141	213	190	154	87	107	85	104	156	130
Existing	*Parcels*	*76*	*40*	*81*	*73*	*54*	*58*	*63*	*52*	*61*	*58*	*41*
Planned	*Parcels*	*98*	*101*	*132*	*117*	*100*	*29*	*44*	*33*	*43*	*98*	*89*
Potential Non-Residential Impacts (includes partially impacted parcels)	Total Parcels	98	100	89	66	57	111	91	102	97	76	72
Existing	*Parcels*	*47*	*48*	*46*	*42*	*41*	*57*	*42*	*52*	*46*	*31*	*32*
Planned	*Parcels*	*51*	*52*	*43*	*24*	*16*	*54*	*49*	*50*	*51*	*45*	*40*
Community Facilities	No. of Conflicts	1	2	2	1	1	4	4	3	3	1	1
Parks and Recreational Facilities (public and private)	No. of Conflicts	0	0	0	0	0	0	0	0	0	0	0
Trails	No. of Conflicts	1	1	1	1	1	1	1	1	1	1	1
Community Cohesion Effects	Ranking	HIGH	HIGH	HIGH	LOW	LOW	HIGH	HIGH	MEDIUM	MEDIUM	HIGH	LOW
Socioeconomic Impacts to Special Populations	Ranking	HIGH	HIGH	HIGH	LOW	LOW	HIGH	HIGH	LOW	LOW	HIGH	LOW
Proposed Development (PD) / Development of Regional Impact (DRI)	acres	256	166	175	176	176	95	63	95	63	37	37
Estimated Costs												
Roadway Construction	2017 $	$211,200,000	$207,700,000	$200,200,000	$201,800,000	$201,600,000	$324,100,000	$331,500,000	$312,400,000	$319,800,000	$205,500,000	$214,100,000
Bridges Construction	2017 $	$122,100,000	$89,400,000	$88,600,000	$86,000,000	$90,900,000	$118,600,000	$118,600,000	$122,800,000	$122,800,000	$107,900,000	$102,100,000
Interchanges Construction	2017 $	$629,100,000	$652,200,000	$663,900,000	$640,800,000	$655,700,000	$303,500,000	$303,500,000	$304,700,000	$304,700,000	$262,100,000	$269,600,000
Toll Collection Equipment	2017 $	$2,600,000	$2,600,000	$2,600,000	$2,600,000	$2,600,000	$2,600,000	$2,600,000	$2,600,000	$2,600,000	$2,600,000	$2,600,000
Right-of-Way Areas (including proposed ponds)	2017 $	$398,300,000	$323,000,000	$338,400,000	$291,300,000	$297,400,000	$301,800,000	$208,400,000	$295,000,000	$212,400,000	$127,100,000	$121,500,000
Mitigation, Wetlands, & Wildlife	2017 $	$35,100,000	$41,000,000	$36,900,000	$35,900,000	$40,400,000	$24,900,000	$25,100,000	$24,300,000	$24,400,000	$28,800,000	$35,700,000
Total Estimated Alternative Costs		**$1,398,400,000**	**$1,315,900,000**	**$1,330,600,000**	**$1,258,400,000**	**$1,288,600,000**	**$1,075,500,000**	**$989,700,000**	**$1,061,800,000**	**$986,700,000**	**$734,000,000**	**$745,600,000**
Projected Traffic Revenue (2045)		**TBD**	**TBD**	**TBD**	**TBD**	**TBD**	**TBD**	**TBD**	**TBD**	**TBD**	**TBD**	**TBD**

REFERENCE COPY

9.7 CFX FINANCIAL VIABILITY CRITERIA



> *""Viable" or "Viability" shall mean an OCX Segment or any portion thereof that is projected in writing by CFX's traffic and revenue consultant to generate toll revenues over a period of thirty years equal to at least fifty percent (50%) of the cost of such OCX Segment or applicable portion thereof…"*



REFERENCE COPY


Alternative	Total Cost	Project at $0.18/mile plus Poinciana Parkway at $2.00	Project at $0.23/mile plus Poinciana Parkway at $2.00	Range on Low Side	Range on High Side	Project at $0.18/mile plus Poinciana Parkway at $2.00		Project at $0.18/mile plus Poinciana Parkway at $2.00		Project at $0.23/mile plus Poinciana Parkway at $2.00		Project at $0.23/mile plus Poinciana Parkway at $2.00	
						Projected Low Revenue	Percent of Total Cost	Projected High Revenue	Percent of Total Cost	Projected Low Revenue	Percent of Total Cost	Projected High Revenue	Percent of Total Cost


REFERENCE COPY

9.8 FINDINGS OF THE CONCEPT, FEASIBILITY, AND MOBILITY STUDY

Based on the findings from this study, and the results of the viability determination, various alternatives achieve greater than 50 percent of their cost while other alternatives approach 50 percent of their cost. Therefore, the project is determined to be financially feasible and viable.

REFERENCE COPY

APPENDIX A


REFERENCE COPY

COMPONENTS OF CONTRACT PLANS SET

ROADWAY PLANS
SIGNING AND PAVEMENT MARKING PLANS
STRUCTURE PLANS (NOT INCLUDED)
TOLL GANTRY PLANS (NOT INCLUDED)

A DETAILED INDEX APPEARS ON THE KEY SHEET OF EACH COMPONENT

OSCEOLA COUNTY EXPRESSWAY AUTHORITY

FINAL "AS-BUILT" PLANS

POINCIANA PARKWAY DESIGN BUILD SEGMENT 3

THIS PROJECT WAS CONSTRUCTED IN SUBSTANTIAL COMPLIANCE WITH THESE PLANS AS APPROVED BY THE ENGINEER OF RECORD. IF CHANGES WERE MADE, THOSE CHANGES ARE INDICATED BY RED INK AND BEAR THE SEAL, SIGNATURE AND DATE OF THE RESPONSIBLE ENGINEER.

RESPONSIBLE ENGINEER — DATE: 12/22/16

TERRY MUSE — LICENSE No. 54360 — STATE OF FLORIDA — PROFESSIONAL ENGINEER

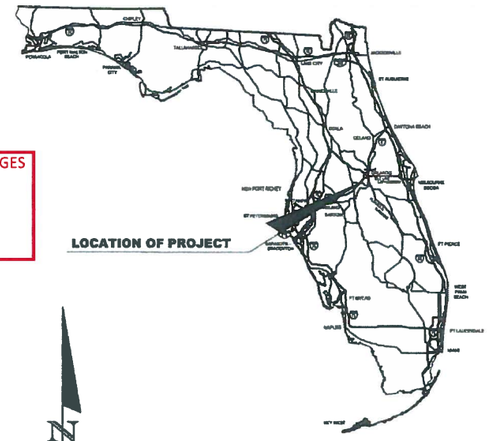

INDEX OF ROADWAY PLANS

SHEET NO.	SHEET DESCRIPTION	
1	KEY SHEET	
2-7	DRAINAGE MAPS	
5 8-11, 11A	TYPICAL SECTION	
12-15	SUMMARY OF DRAINAGE STRUCTURES	
16	OPTIONAL MATERIALS TABULATIONS	
17	GENERAL NOTES	
18-33	ROADWAY PLAN/PROFILE	
34-44	DRAINAGE STRUCTURE CROSS SECTIONS	
45	DRAINAGE DETAILS	
46-49	POND DETAIL SHEETS	
50	SOIL SURVEY	
51-196	CROSS SECTIONS	
~~197~~	~~TRAFFIC CONTROL PLAN~~	NOT INCLUDED

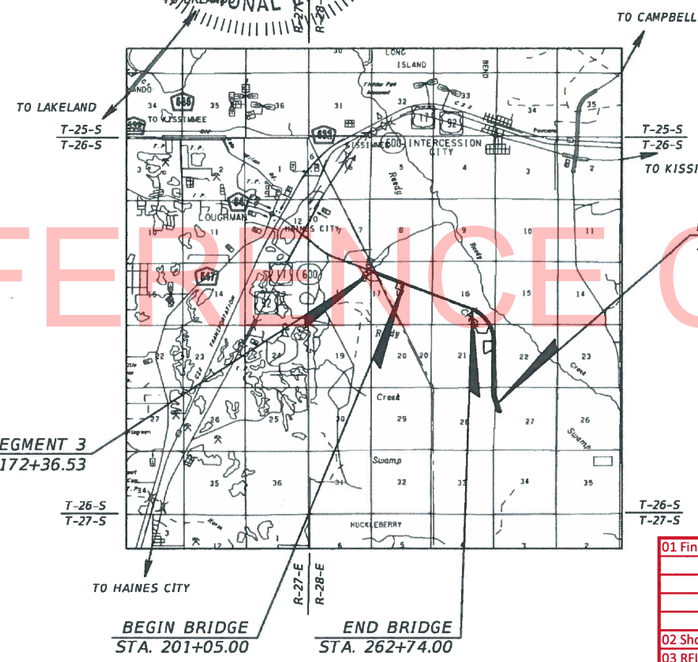

NAME OF PRIME CONTRACTOR:	JR. DAVIS CONSTRUCTION
NAME OF PRIME CONSULTANT:	DEWBERRY
NAME OF CEI CONSULTANT:	AECOM
DISTRICT SECRETARY:	NORANNE DOWNS
RESIDENT ENGINEER:	TERRY MUSE, P.E.
OCX PROJECT MANAGER:	FRANK RAYMOND
PROJECT ADMINISTRATOR:	JAMES FITZER
DATE WORK STARTED:	12/19/2013
DATE WORK FINAL ACCEPTED:	12/22/2016

REFERENCE COPY

GOVERNING STANDARDS AND SPECIFICATIONS:

Florida Department of Transportation, 2013 Design Standards and revised Index Drawings as appended herein, and 2013 Standard Specifications for Road and Bridge Construction, as amended by Contract Documents.

For Design Standards click on the "Design Standards" link at the following web site:
http://www.dot.state.fl.us/rddesign/

For the Standard Specifications for Road and Bridge Construction click on the "Specifications" link at the following web site:
http://www.dot.state.fl.us/specificationsoffice/

REVISIONS

REVISED SHEETS 18 & 34 DATE 12-5-14 (1)
ADDED SHEET 34A DATE 12-5-14
REVISED SHEET 8,18,19,24-31 DATE 2-4-15 (2)
REVISED SHEET 1,8,29-31,174-176 DATE 4-17-15 (3)
DELETED SHEETS 32,33,44,177-196 DATE 4-17-15
REVISED SHEET 19 DATE 7-20-15 (4)
REVISED SHEETS 11A, 18-20, 24-31, 46-47 DATE 9-3-15 (5)
REVISED SHEET S-1, S-3, S-13 THRU S-15, S-19, S-22, S-23 DATE 2-8-16 (6)
DELETED SHEETS S-16 THRU S-18, S-20, S-21 DATE 2-8-16
ADDED SHEETS S-15A THRU S-15D, S-17A, S-18A, S-20A, S-20B, S-20C DATE 2-8-16

LENGTH OF PROJECT

	LINEAR FEET	MILES
ROADWAY	12,244.47	2.319
BRIDGES	6,169.00	1.168
NET LENGTH OF PROJECT	18,413.47	3.487
EXCEPTIONS	0.000	0.000
GROSS LENGTH OF PROJECT	18,413.47	3.487

01 Final As-Built Contract Plans
01 Final As-Built Plan Sets
02 Drainage As-Builts (SFWMD)
03 As-Built Surveys
04 Bridge Load Ratings
02 Shop Drawings
03 RFI
04 ITS
05 Toll Gantry

KEY SHEET REVISIONS

DATE	DESCRIPTION
4-17-15	REMOVED EARLY TOLLING (3)
9-3-15	REVISED INDEX (5)

(3)

PLANS PREPARED BY:
DEWBERRY | BOWYER-SINGLETON
520 SOUTH MAGNOLIA AVENUE
ORLANDO, FLORIDA 32801
407-843-5120
CERTIFICATE OF AUTHORIZATION NO. 8794
VENDOR NUMBER F130746510001
CONTRACT NO. 13-001

NOTE: THE SCALE OF THESE PLANS MAY HAVE CHANGED DUE TO REPRODUCTION.

KEVIN EUGENE KNUDSEN — LICENSE No. 41062 — 2-10-16 — STATE OF FLORIDA — PROFESSIONAL ENGINEER

ROADWAY PLANS
ENGINEER OF RECORD: KEVIN E. KNUDSEN, P.E.
P.E. NO.: 41062

FISCAL YEAR	SHEET NO.
14	1

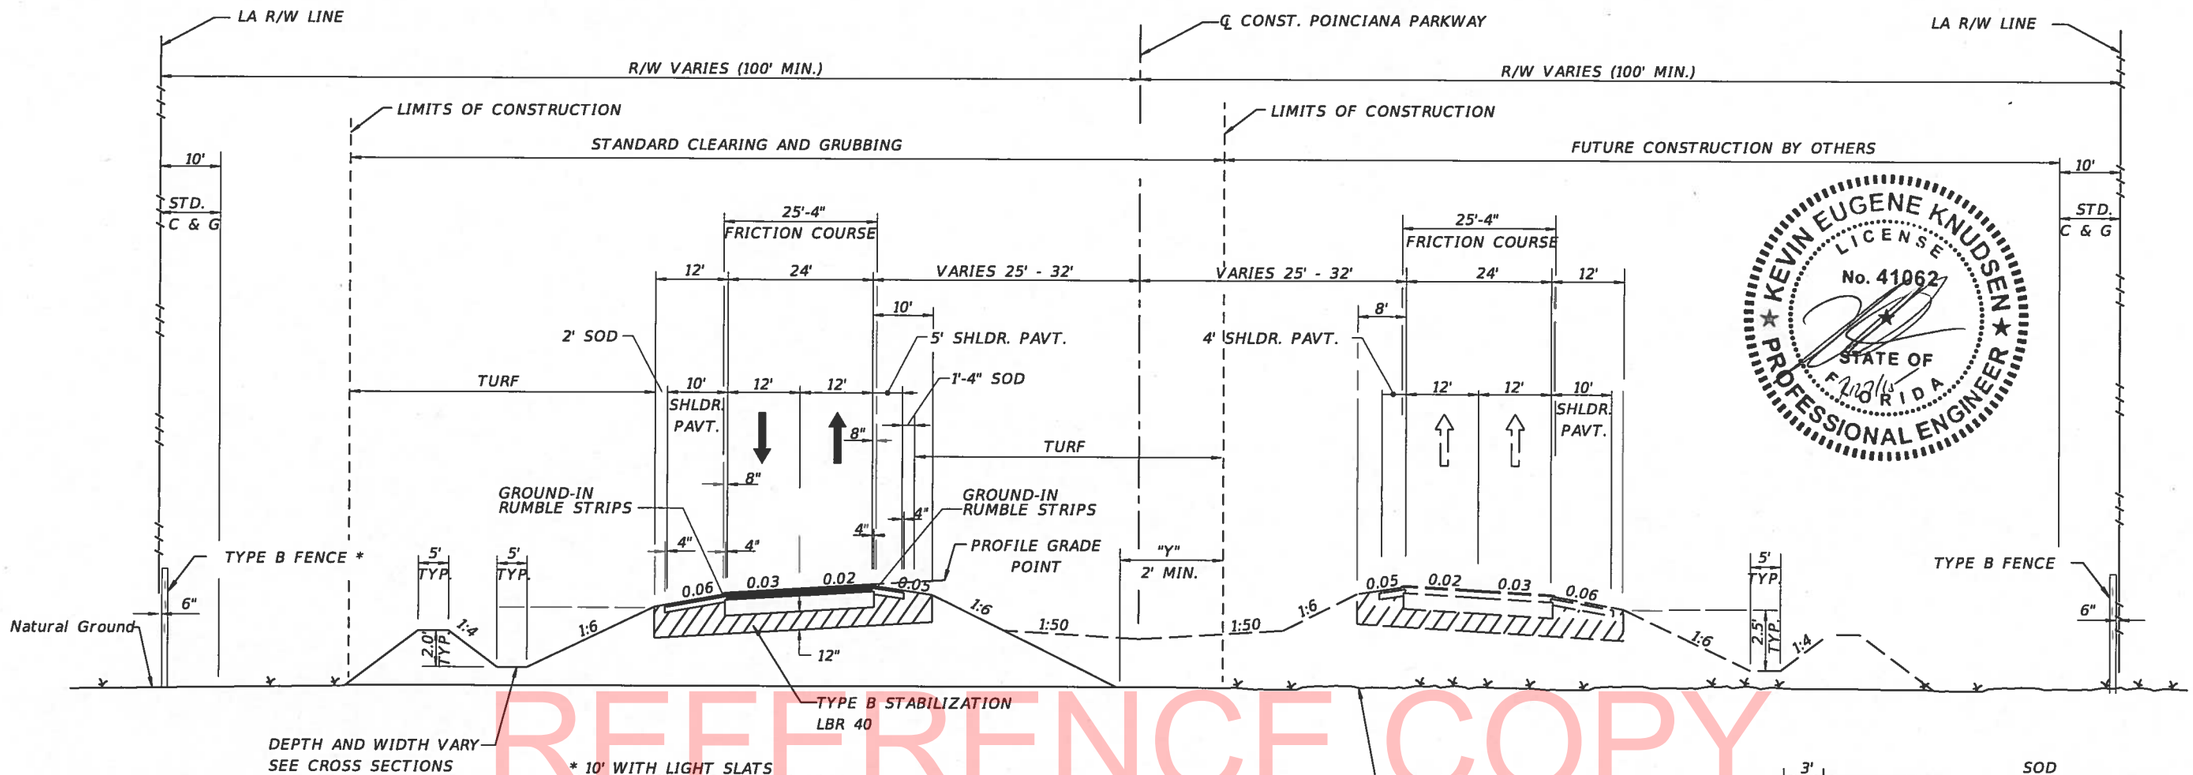

REFERENCE COPY

TRAFFIC DATA

CURRENT YEAR = 2013 AADT = N/A
ESTIMATED OPENING YEAR = 2015 AADT = 8,300
ESTIMATED DESIGN YEAR = 2035 AADT = 27,700
K = N/A% D = N/A% T = 3 % (24 HOUR)

DESIGN SPEED = 70 MPH

NOTE:
FOR SUPER ELEVATED SECTIONS GREATER THAN 5% THE FULL HIGH SIDE SHOULDER CROSS SLOPES SHALL SLOPE THE SAME DIRECTION.

PAVEMENT DESIGN MAINLINE AND SHOULDERS
STA 331+50.00 TO STA 332+50.00

OPTIONAL BASE GROUP 11(7" TYPE B 12.5) WITH
TYPE SP STRUCTURAL COURSE (TRAFFIC C) (4" (TOP LIFT PG76-22))
AND FRICTION COURSE FC-12.5 (1 1/2")

3

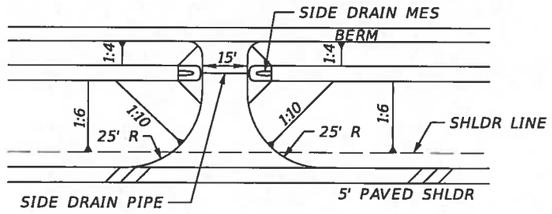

TYPICAL ACCESS DETAIL 'A'

SEE PLAN SHEETS FOR LOCATIONS AND PIPE SIZES
SEE SUMMARY OF DRAINAGE STRUCTURES FOR DETAILS

TYPICAL SECTION
POINCIANA PARKWAY
STA 172+36.53 TO STA 201+05.00
STA 262+74.00 TO STA 356+50.00

NEW CONSTRUCTION

10" OF LIMEROCK ~~OPTIONAL BASE GROUP 9~~ WITH
TYPE SP STRUCTURAL COURSE (TRAFFIC B) (2 1/2")
AND FRICTION COURSE FC-5 (3/4")

2

SHOULDER PAVEMENT

4" OF LIMEROCK ~~OPTIONAL BASE GROUP 1~~ WITH
TYPE SP STRUCTURAL COURSE (TRAFFIC B) (1-1/2")

2

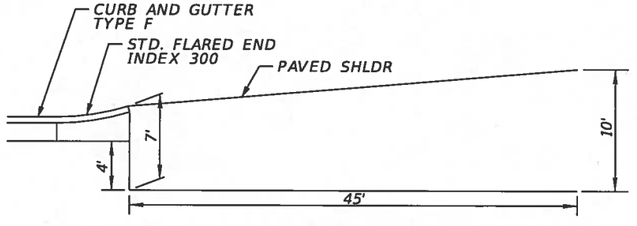

CURB TO SHOULDER PAVEMENT DETAIL

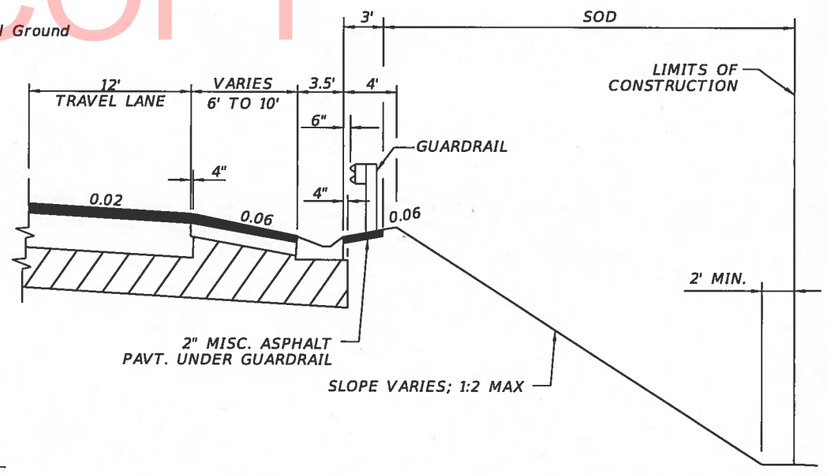

SHOULDER PAVEMENT & SHOULDER GUTTER DETAIL

SEGMENT 3

REVISIONS			
DATE	DESCRIPTION	DATE	DESCRIPTION
2-4-14	ADDED DETAIL AND REVISED PAVEMENT DESIGN 2		
4-22-14	ADDED PAVEMENT DESIGN 3		

KEVIN E. KNUDSEN, P.E.
P.E. LICENSE NUMBER 41062
DEWBERRY | BOWYER-SINGLETON
520 SOUTH MAGNOLIA AVENUE
ORLANDO, FL 32801
CERTIFICATE OF AUTHORIZATION 8794

OSCEOLA COUNTY EXPRESSWAY AUTHORITY

ROAD NO.	COUNTY	FINANCIAL PROJECT ID
	OSCEOLA	

TYPICAL SECTION
POINCIANA PARKWAY

SHEET NO. 8

$USER$ $DATE$ $TIME$ $FILE$

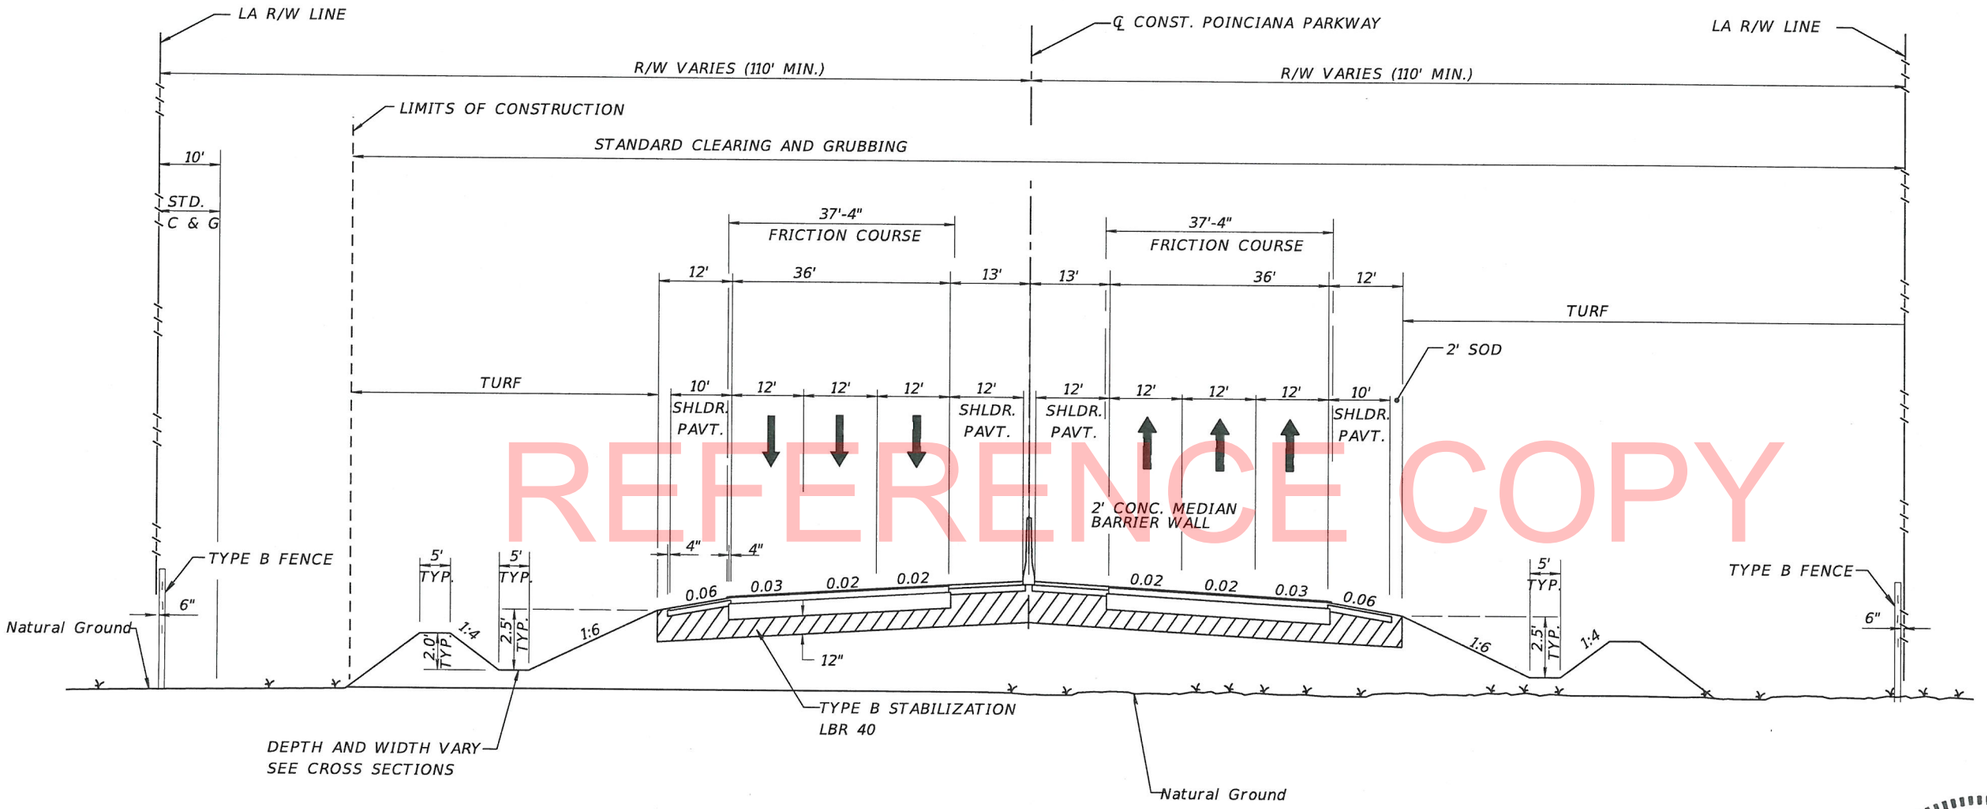

FUTURE 6 LANE TYPICAL SECTION
POINCIANA PARKWAY

INFORMATION ONLY

REFERENCE COPY

TRAFFIC DATA

CURRENT YEAR = 2013 AADT = N/A
ESTIMATED OPENING YEAR = 2015 AADT = 8,300
ESTIMATED DESIGN YEAR = 2035 AADT = 27,700
K = N/A% D = N/A% T = 3 % (24 HOUR)

DESIGN SPEED = 70 MPH

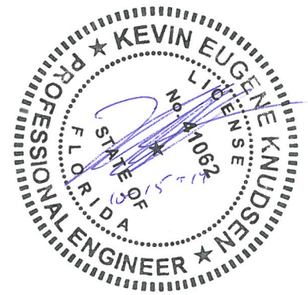

SEGMENT 3

REVISIONS			
DATE	DESCRIPTION	DATE	DESCRIPTION

KEVIN E. KNUDSEN, P.E.
P.E. LICENSE NUMBER 41062
DEWBERRY | BOWYER-SINGLETON
520 SOUTH MAGNOLIA AVENUE
ORLANDO, FL 32801
CERTIFICATE OF AUTHORIZATION 8794

OSCEOLA COUNTY EXPRESSWAY AUTHORITY

ROAD NO.	COUNTY	FINANCIAL PROJECT ID
	OSCEOLA	

TYPICAL SECTION
POINCIANA PARKWAY

SHEET NO. 10

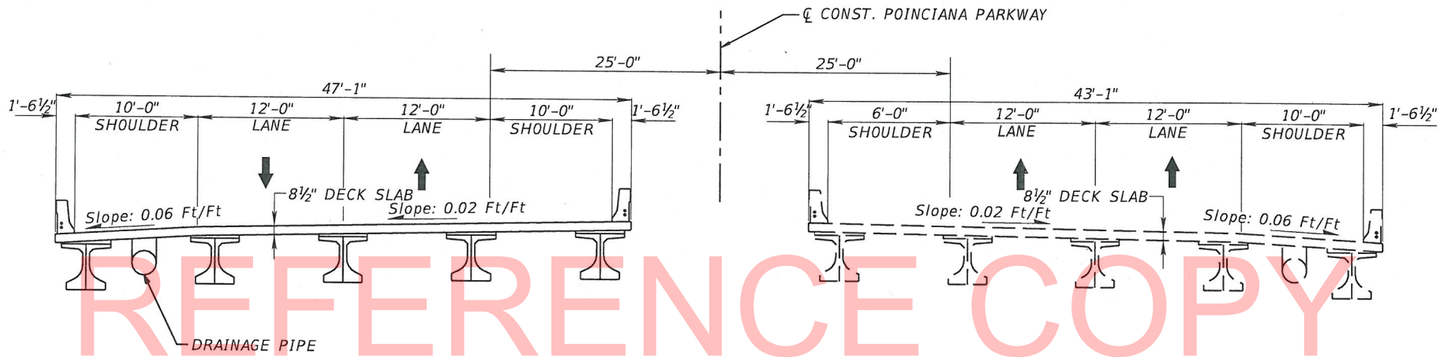

REFERENCE COPY

BRIDGE TYPICAL SECTION
POINCIANA PARKWAY
STA 201+05.00 TO STA 262+74.00

TRAFFIC DATA

CURRENT YEAR = 2013 AADT = N/A
ESTIMATED OPENING YEAR = 2015 AADT = 8,300
ESTIMATED DESIGN YEAR = 2035 AADT = 27,700
K = N/A% D = N/A% T = 3 % (24 HOUR)

DESIGN SPEED = 70 MPH

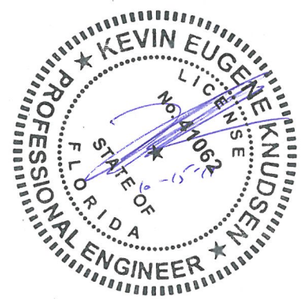

SEGMENT 3

REVISIONS			
DATE	DESCRIPTION	DATE	DESCRIPTION

KEVIN E. KNUDSEN, P.E.
P.E. LICENSE NUMBER 41062
DEWBERRY | BOWYER-SINGLETON
520 SOUTH MAGNOLIA AVENUE
ORLANDO, FL 32801
CERTIFICATE OF AUTHORIZATION 8794

OSCEOLA COUNTY EXPRESSWAY AUTHORITY

ROAD NO.	COUNTY	FINANCIAL PROJECT ID
	OSCEOLA	

TYPICAL SECTION
POINCIANA PARKWAY

SHEET NO. 11

dfalk 10/15/2014 11:30:20 AM S:\50062305_Poinciana Parkway\Design\roadway\typsrd03.dgn

COMPONENTS OF CONTRACT PLANS SET

ROADWAY PLANS
SIGNING AND PAVEMENT MARKING PLANS

A DETAILED INDEX APPEARS ON THE KEY SHEET OF EACH COMPONENT

INDEX OF ROADWAY PLANS

SHEET NO.	SHEET DESCRIPTION
1	KEY SHEET
2-6	DRAINAGE MAPS
7	FLOOD DATA
8-14	TYPICAL SECTION
15-19	SUMMARY OF DRAINAGE STRUCTURES
20	OPTIONAL MATERIALS TABULATION
21	GENERAL NOTES
22-36	ROADWAY PLAN/PROFILE
37-46	RAMP PROFILES
47-52	SIDE STREET PLANS\PROFILES
53-57	INTERSECTION DETAILS
58-61	RAMP TERMINAL DETAILS
62-93	DRAINAGE STRUCTURES
94	BOX CULVERT DATA TABLE
95-97	BOX CULVERT SPT BORINGS
98-103	BOX CULVERT REINFORCING BAR LIST
104-106	DRAINAGE DETAILS
107-111	POND DETAILS
112-115	ROADWAY SOIL SURVEY SHEET
116-298	CROSS SECTIONS
299-312	UTILITY ADJUSTMENT PLANS
~~313-313~~	~~TRAFFIC CONTROL PLANS~~ NOT INCLUDED

01 Final As-Built Contract Plans
01 Final As-Built Plan Sets
02 Drainage As-Builts (SFWMD)
03 As-Built Surveys
04 Bridge Load Ratings
02 Shop Drawings
03 RFI
04 ITS
05 Toll Gantry

GOVERNING STANDARDS AND SPECIFICATIONS:

Florida Department of Transportation, 2013 Design Standards and revised Index Drawings as appended herein, and 2013 Standard Specifications for Road and Bridge Construction, as amended by Contract Documents.

For Design Standards click on the "Design Standards" link at the following web site:
http://www.dot.state.fl.us/rddesign/

For the Standard Specifications for Road and Bridge Construction click on the "Specifications" link at the following web site:
http://www.dot.state.fl.us/specificationsoffice/

REVISIONS

1. SHEETS MODIFIED 1, 8, 15, 19, 22-25, 27, 47-49, ADDED 48A, 62, ADDED 63A & 63B, 64, 73, 91, 107, 116-145, 263-275
2. SHEETS MODIFIED 23-25, 27-29, 31-36, 48A, 50-52, 106-111 (REVISED 10-15-15)
3. SHEETS MODIFIED 2, 5-6, 8, 10, 12, 19, 22-24, 47-49, 52-53, 91, 93, 106, 253-279, S-23 - S-26 (REVISED 12-21-15)
4. SHEETS MODIFIED S-1, S-10, S-11, S-16 THRU S-19, S-24, S-26, S-28, S-33, S-40 THRU S-42 (REVISED 2-8-16)
   SHEETS DELETED S-20, S-21, S-30, S-31, S-32
5. SHEETS ADDED 314A-314D

OSCEOLA COUNTY EXPRESSWAY AUTHORITY

FINAL "AS-BUILT" PLANS

POINCIANA PARKWAY DESIGN/BUILD SEGMENT 4

THIS PROJECT WAS CONSTRUCTED IN SUBSTANTIAL COMPLIANCE WITH THESE PLANS AS APPROVED BY THE ENGINEER OF RECORD. IF CHANGES WERE MADE, THOSE CHANGES ARE INDICATED BY REDLINE AND BEAR THE SEAL, SIGNATURE AND DATE OF THE RESPONSIBLE ENGINEER.

RESPONSIBLE ENGINEER — DATE 12/22/16

TERRY MUSE LICENSE No. 54360 STATE OF FLORIDA PROFESSIONAL ENGINEER

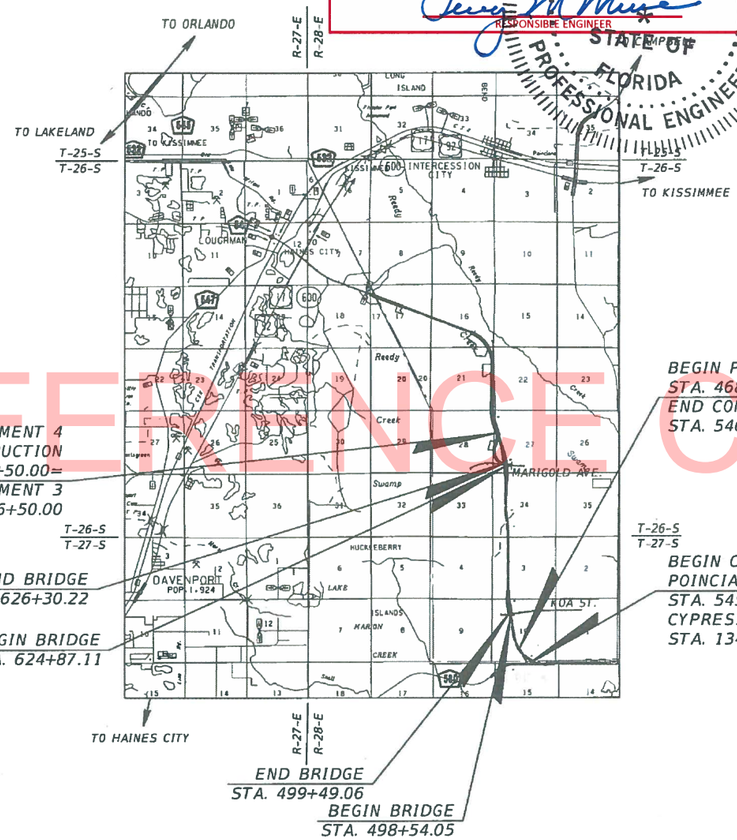

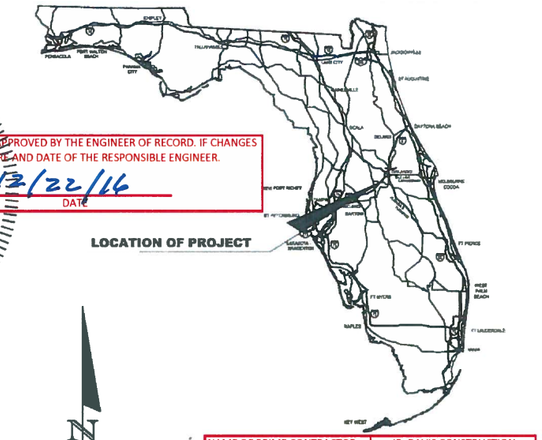

NAME OF PRIME CONTRACTOR:	JR. DAVIS CONSTRUCTION
NAME OF PRIME CONSULTANT:	DEWBERRY
NAME OF CEI CONSULTANT:	AECOM
DISTRICT SECRETARY:	NORANNE DOWNS
RESIDENT ENGINEER:	TERRY MUSE, P.E.
OCX PROJECT MANAGER:	FRANK RAYMOND
PROJECT ADMINISTRATOR:	JAMES FITZER
DATE WORK STARTED:	12/19/2013
DATE WORK FINAL ACCEPTED:	12/22/2016

BEGIN PROJECT SEGMENT 4
STA. 468+74.85=
END CONSTRUCTION POINCIANA SPUR
STA. 5468+74.85

END PROJECT SEGMENT 4
END CONSTRUCTION
STA. 653+50.00=
PROJECT SEGMENT 3
STA. 356+50.00

END BRIDGE
STA. 626+30.22

BEGIN BRIDGE
STA. 624+87.11

END BRIDGE
STA. 499+49.06

BEGIN BRIDGE
STA. 498+54.05

BEGIN CONSTRUCTION
POINCIANA PARKWAY SPUR
STA. 5453+69.79
CYPRESS PARKWAY
STA. 134+40.00

PLANS PREPARED BY:

DEWBERRY | BOWYER-SINGLETON
520 SOUTH MAGNOLIA AVENUE
ORLANDO, FLORIDA 32801
407-843-5120
CERTIFICATE OF AUTHORIZATION NO. 8794
VENDOR NUMBER F130746510001
CONTRACT NO. 13-001

NOTE: THE SCALE OF THESE PLANS MAY HAVE CHANGED DUE TO REPRODUCTION.

KEVIN EUGENE KNUDSEN LICENSE No. 41062 STATE OF FLORIDA PROFESSIONAL ENGINEER 4/9/16

REVISION 5
April 12, 2016

ROADWAY PLANS
ENGINEER OF RECORD: KEVIN E. KNUDSEN, P.E.

P.E. NO.: 41062

FISCAL YEAR	SHEET NO.
14	1

LENGTH OF PROJECT

	LINEAR FEET	MILES
ROADWAY	18,237.03	3.454
BRIDGES	238.12	0.045
NET LENGTH OF PROJECT	18,475.15	3.499
EXCEPTIONS	0.000	0.000
GROSS LENGTH OF PROJECT	18,475.15	3.499

KEY SHEET REVISIONS

DATE	DESCRIPTION

REFERENCE COPY

dfalk 4/11/2016 3:57:02 PM S:\50062305_Poinciana_Parkway\Design\roadway\KEYSRD04.dgn

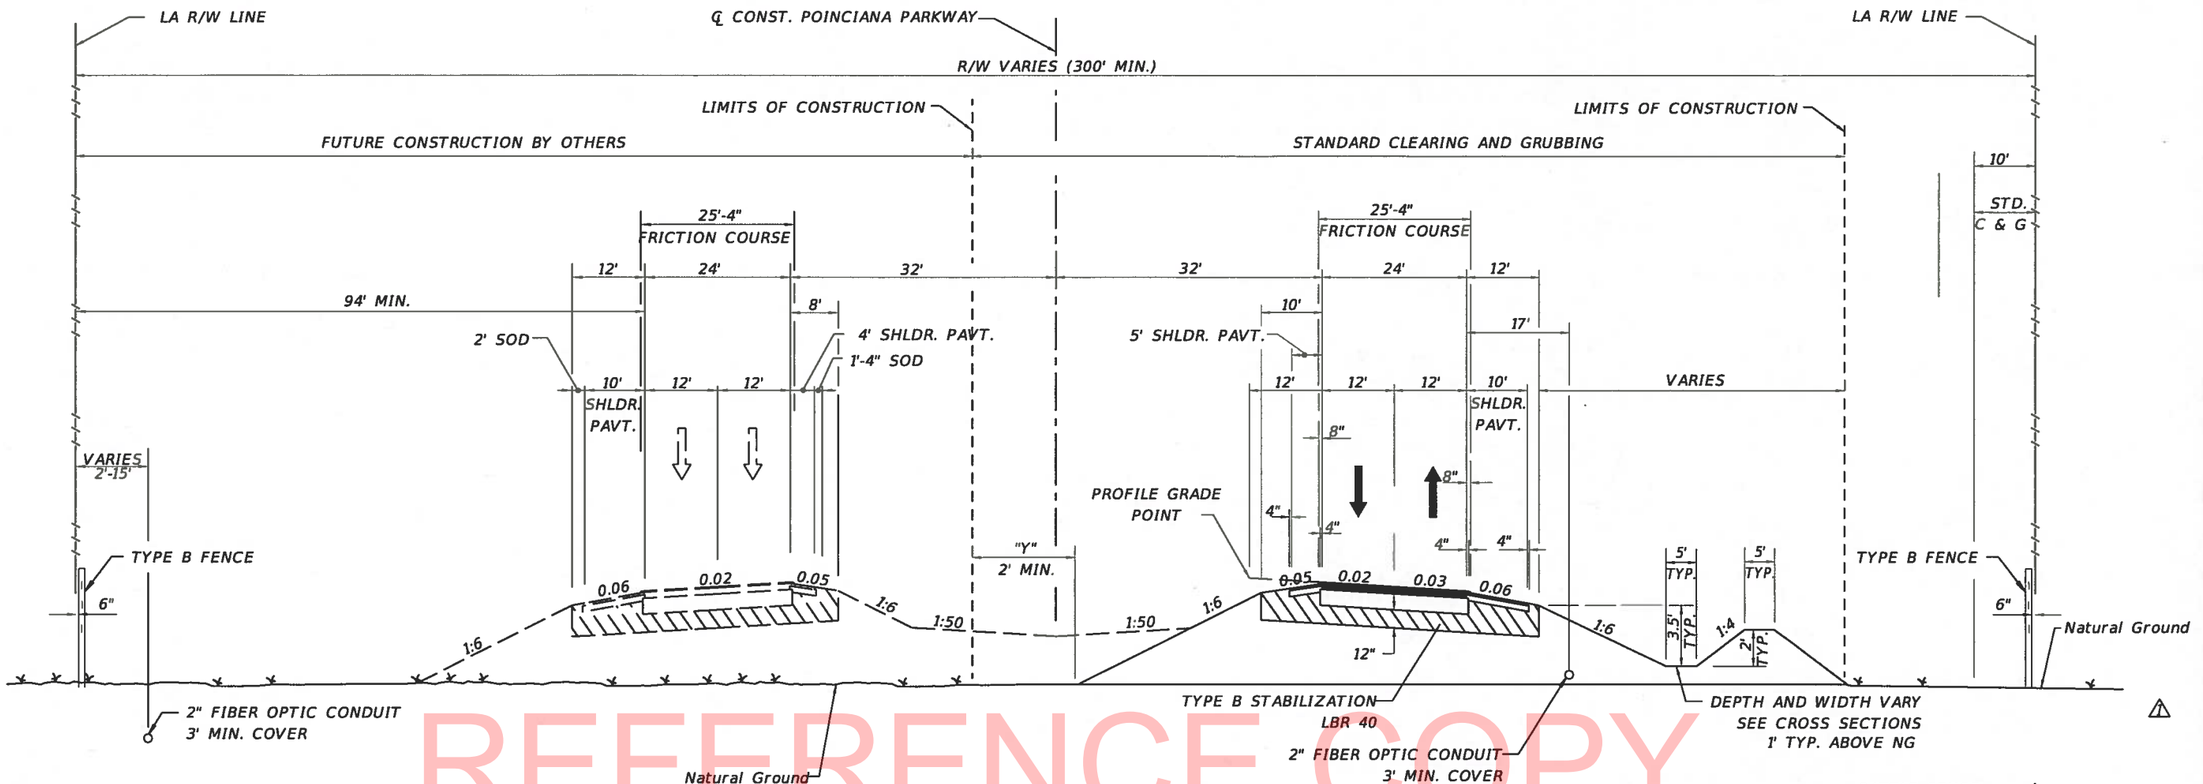

REFERENCE COPY

PAVEMENT DESIGN MAINLINE AND SHOULDERS
STA 544+50.00 TO STA 545+50.00

OPTIONAL BASE GROUP 11(7" TYPE B 12.5) WITH
TYPE SP STRUCTURAL COURSE (TRAFFIC C) (4" (TOP LIFT PG 76-22))
AND FRICTION COURSE FC-12.5 (1 1/2") (PG 76-22)

TYPICAL SECTION
POINCIANA PARKWAY
STA. 468+74.85 TO STA. 653+50.00

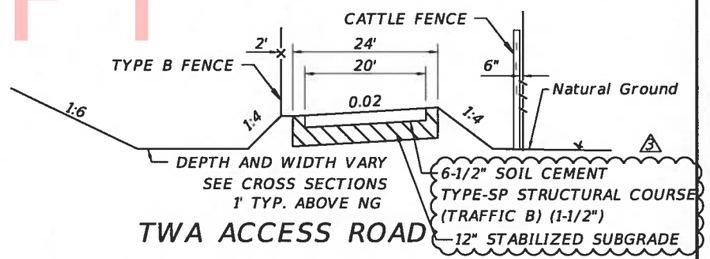

TWA ACCESS ROAD

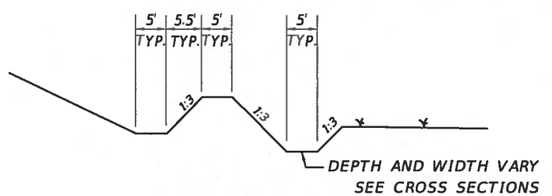

BYPASS DITCH RIGHT
STA. 465+00.00 TO STA. 498+50.00
BYPASS DITCH LEFT
STA. 5465+80.00 TO STA. 483+80.00
CANAL N
STA. 581+00.00 TO STA. 596+70.00

KEVIN EUGENE KNUDSEN
LICENSE
No. 41062
STATE OF FLORIDA
PROFESSIONAL ENGINEER
2/11/16

TRAFFIC DATA

CURRENT YEAR = 2013 AADT = N/A
ESTIMATED OPENING YEAR = 2015 AADT = 8,300
ESTIMATED DESIGN YEAR = 2035 AADT = 27,700
K = N/A% D = N/A% T = 3 % (24 HOUR)

DESIGN SPEED = 70 MPH
CLEARZONE = 36'

NEW CONSTRUCTION

10" OF LIMEROCK ~~OPTIONAL BASE GROUP 9~~ WITH
TYPE SP STRUCTURAL COURSE (TRAFFIC B) (2 1/2")
AND FRICTION COURSE FC-5 (3/4")

SHOULDER PAVEMENT DESIGN

4" OF LIMEROCK ~~OPTIONAL BASE GROUP 1~~ WITH
TYPE SP STRUCTURAL COURSE (TRAFFIC B) (1-1/2")

SEGMENT 4

REVISIONS			
DATE	DESCRIPTION	DATE	DESCRIPTION
10-2-15	1 ADDED ACCESS RD. & MODIFIED DITCHES		
12-21-15	2 REVISED ACCESS ROAD PAVT. DESIGN		

KEVIN E. KNUDSEN, P.E.
P.E. LICENSE NUMBER 41062
DEWBERRY | BOWYER-SINGLETON
520 SOUTH MAGNOLIA AVENUE
ORLANDO, FL 32801
CERTIFICATE OF AUTHORIZATION 8794

OSCEOLA COUNTY EXPRESSWAY AUTHORITY

ROAD NO.	COUNTY	FINANCIAL PROJECT ID
	OSCEOLA	

TYPICAL SECTION
POINCIANA PARKWAY

SHEET NO. 8

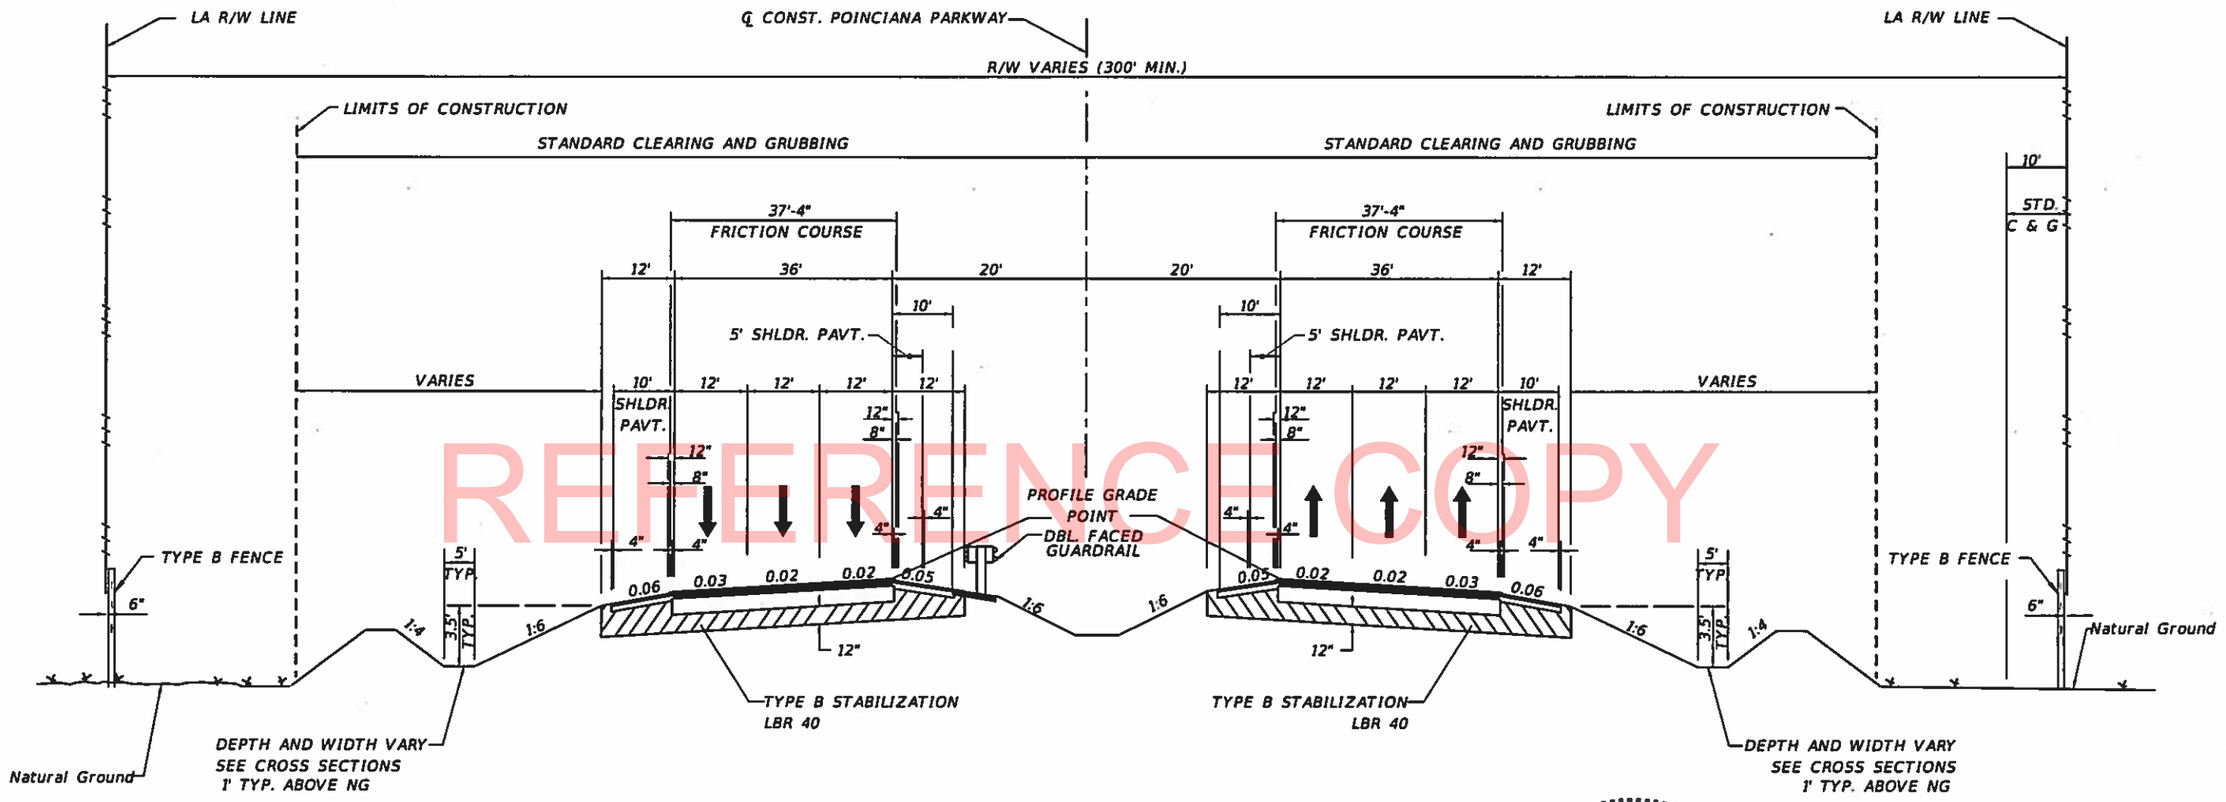

REFERENCE COPY

FUTURE 6 LANE TYPICAL SECTION
POINCIANA PARKWAY

INFORMATION ONLY

TRAFFIC DATA

CURRENT YEAR = 2013 AADT = N/A
ESTIMATED OPENING YEAR = 2015 AADT = 8,300
ESTIMATED DESIGN YEAR = 2035 AADT = 27,700
K = N/A% D = N/A% T = 3 % (24 HOUR)

DESIGN SPEED = 70 MPH
CLEARZONE = 36'

KEVIN EUGENE KNUDSEN ★ LICENSED ★ No. 41062 ★ STATE OF FLORIDA ★ PROFESSIONAL ENGINEER ★

SEGMENT 4

REVISIONS			
DATE	DESCRIPTION	DATE	DESCRIPTION

KEVIN E. KNUDSEN, P.E.
P.E. LICENSE NUMBER 41062
DEWBERRY | BOWYER-SINGLETON
520 SOUTH MAGNOLIA AVENUE
ORLANDO, FL 32801
CERTIFICATE OF AUTHORIZATION 8794

OSCEOLA COUNTY EXPRESSWAY AUTHORITY

ROAD NO.	COUNTY	FINANCIAL PROJECT ID
	OSCEOLA	

TYPICAL SECTION POINCIANA PARKWAY

SHEET NO. 9

psaind 4/27/2015 10:40:47 AM S:\50062305_Poinciana_Parkway\Design\roadway\typsrd04.dgn

APPENDIX B


REFERENCE COPY

1018 Thomasville Road
Suite 200-C
Tallahassee, FL 32303
850-224-8207
850-681-9364 fax
www.fnai.org

Florida Natural Areas Inventory

Biodiversity Matrix Query Results

UNOFFICIAL REPORT

Created 8/17/2017

(Contact the FNAI Data Services Coordinator at 850.224.8207 for information on an official Standard Data Report)

NOTE: The Biodiversity Matrix includes only rare species and natural communities tracked by FNAI.

Report for 10 Matrix Units: 40680 , 41049 , 41050 , 41051 , 41052 , 41419 , 41420 , 41421 , 41422 , 41423

 

REFERENCE COPY

Descriptions

DOCUMENTED - There is a documented occurrence in the FNAI database of the species or community within this Matrix Unit.

DOCUMENTED-HISTORIC - There is a documented occurrence in the FNAI database of the species or community within this Matrix Unit; however the occurrence has not been observed/reported within the last twenty years.

LIKELY - The species or community is *known* to occur in this vicinity, and is considered likely within this Matrix Unit because:

1. documented occurrence overlaps this and adjacent Matrix Units, but the documentation isn't precise enough to indicate which of those Units the species or community is actually located in; *or*
2. there is a documented occurrence in the vicinity and there is suitable habitat for that species or community within this Matrix Unit.

POTENTIAL - This Matrix Unit lies within the known or predicted range of the species or community based on expert knowledge and environmental variables such as climate, soils, topography, and landcover.

Matrix Unit ID: 40680

0 **Documented** Elements Found

0 **Documented-Historic** Elements Found

1 **Likely** Element Found

Scientific and Common Names	Global Rank	State Rank	Federal Status	State Listing
Mesic flatwoods	G4	S4	N	N

Matrix Unit ID: 41049
0 **Documented** Elements Found

0 **Documented-Historic** Elements Found

1 **Likely** Element Found

Scientific and Common Names	Global Rank	State Rank	Federal Status	State Listing
Mesic flatwoods	G4	S4	N	N

Matrix Unit ID: 41050
0 **Documented** Elements Found

0 **Documented-Historic** Elements Found

1 **Likely** Element Found

Scientific and Common Names	Global Rank	State Rank	Federal Status	State Listing
Mesic flatwoods	G4	S4	N	N

Matrix Unit ID: 41051
0 **Documented** Elements Found

REFERENCE COPY

0 **Documented-Historic** Elements Found

1 **Likely** Element Found

Scientific and Common Names	Global Rank	State Rank	Federal Status	State Listing
Mesic flatwoods	G4	S4	N	N

Matrix Unit ID: 41052
0 **Documented** Elements Found

0 **Documented-Historic** Elements Found

0 **Likely** Elements Found

Matrix Unit ID: 41419
0 **Documented** Elements Found

0 **Documented-Historic** Elements Found

0 **Likely** Elements Found

Matrix Unit ID: 41420
0 **Documented** Elements Found

0 **Documented-Historic** Elements Found

1 **Likely** Element Found

Scientific and Common Names	Global Rank	State Rank	Federal Status	State Listing
Mycteria americana Wood Stork	G4	S2	LT	FT

Matrix Unit ID: 41421

0 **Documented** Elements Found

0 **Documented-Historic** Elements Found

1 **Likely** Element Found

Scientific and Common Names	Global Rank	State Rank	Federal Status	State Listing
Mycteria americana Wood Stork	G4	S2	LT	FT

Matrix Unit ID: 41422

0 **Documented** Elements Found

0 **Documented-Historic** Elements Found

2 **Likely** Elements Found

Scientific and Common Names	Global Rank	State Rank	Federal Status	State Listing
Mycteria americana Wood Stork	G4	S2	LT	FT
Sandhill upland lake	G3	S2	N	N

REFERENCE COPY

Matrix Unit ID: 41423

0 **Documented** Elements Found

0 **Documented-Historic** Elements Found

2 **Likely** Elements Found

Scientific and Common Names	Global Rank	State Rank	Federal Status	State Listing
Mycteria americana Wood Stork	G4	S2	LT	FT
Sandhill upland lake	G3	S2	N	N

Matrix Unit IDs: 40680 , 41049 , 41050 , 41051 , 41052 , 41419 , 41420 , 41421 , 41422 , 41423

52 **Potential** Elements Common to Any of the 10 Matrix Units

Scientific and Common Names	Global Rank	State Rank	Federal Status	State Listing
Arnoglossum diversifolium Variable-leaved Indian-plantain	G2	S2	N	T
Athene cunicularia floridana Florida Burrowing Owl	G4T3	S3	N	SSC
Bonamia grandiflora Florida Bonamia	G3	S3	LT	E
Calamintha ashei Ashe's Savory	G3	S3	N	T
	G2G3	S2S3	N	T

Calopogon multiflorus Many-flowered Grass-pink				
Carex chapmanii Chapman's Sedge	G3	S3	N	T
Centrosema arenicola Sand Butterfly Pea	G2Q	S2	N	E
Chionanthus pygmaeus Pygmy Fringe Tree	G2G3	S2S3	LE	E
Clitoria fragrans Scrub Pigeon-wing	G3	S3	LT	E
Coelorachis tuberculosa Piedmont Jointgrass	G3	S3	N	T
Conradina brevifolia Short-leaved Rosemary	G2Q	S2	LE	E
Corynorhinus rafinesquii Rafinesque's Big-eared Bat	G3G4	S2	N	N
Drymarchon couperi Eastern Indigo Snake	G3	S3	LT	FT
Eriogonum longifolium var. gnaphalifolium Scrub Buckwheat	G4T3	S3	LT	E
Gopherus polyphemus Gopher Tortoise	G3	S3	C	ST
Grus canadensis pratensis Florida Sandhill Crane	G5T2T3	S2S3	N	ST
Gymnopogon chapmanianus Chapman's Skeletongrass	G3	S3	N	N
Hartwrightia floridana Hartwrightia	G2	S2	N	T
Heterodon simus Southern Hognose Snake	G2	S2	N	N
Illicium parviflorum Star Anise	G2	S2	N	E
Lechea cernua Nodding Pinweed	G3	S3	N	T
Liatris ohlingerae Florida Blazing Star	G2	S2	LE	E
Lithobates capito Gopher Frog	G3	S3	N	SSC
Litsea aestivalis Pondspice	G3?	S2	N	E
Lupinus aridorum Scrub Lupine	G1	S1	LE	E
Matelea floridana Florida Spiny-pod	G2	S2	N	E
Mustela frenata peninsulae Florida Long-tailed Weasel	G5T3	S3	N	N
Nemastylis floridana Celestial Lily	G2	S2	N	E
Neofiber alleni Round-tailed Muskrat	G3	S3	N	N
Nolina atopocarpa Florida Beargrass	G3	S3	N	T
Nolina brittoniana Britton's Beargrass	G3	S3	LE	E
Notophthalmus perstriatus Striped Newt	G2G3	S2	C	N
Panicum abscissum Cutthroat Grass	G3	S3	N	E
Paronychia chartacea ssp. chartacea Paper-like Nailwort	G3T3	S3	LT	E
	G3	S3	N	N

REFERENCE COPY

Peucaea aestivalis Bachman's Sparrow				
Picoides borealis Red-cockaded Woodpecker	G3	S2	LE	FE
Pituophis melanoleucus mugitus Florida Pine Snake	G4T3	S3	N	SSC
Plestiodon egregius lividus Blue-tailed Mole Skink	G5T2	S2	LT	FT
Podomys floridanus Florida Mouse	G3	S3	N	SSC
Polygala lewtonii Lewton's Polygala	G2G3	S2S3	LE	E
Polygonella basiramia Florida Jointweed	G3	S3	LE	E
Polygonella myriophylla Small's Jointweed	G3	S3	LE	E
Prunus geniculata Scrub Plum	G3	S3	LE	E
Pteroglossaspis ecristata Giant Orchid	G2G3	S2	N	T
Puma concolor coryi Florida Panther	G5T1	S1	LE	FE
Rostrhamus sociabilis Snail Kite	G4G5	S2	LE	N
Salix floridana Florida Willow	G2	S2	N	E
Sceloporus woodi Florida Scrub Lizard	G2G3	S2S3	N	N
Sciurus niger shermani Sherman's Fox Squirrel	G5T3	S3	N	SSC
Ursus americanus floridanus Florida Black Bear	G5T2	S2	N	N
Warea amplexifolia Clasping Warea	G1	S1	LE	E
Warea carteri Carter's Warea	G3	S3	LE	E

REFERENCE COPY

Disclaimer

The data maintained by the Florida Natural Areas Inventory represent the single most comprehensive source of information available on the locations of rare species and other significant ecological resources statewide. However, the data are not always based on comprehensive or site-specific field surveys. Therefore, this information should not be regarded as a final statement on the biological resources of the site being considered, nor should it be substituted for on-site surveys. FNAI shall not be held liable for the accuracy and completeness of these data, or opinions or conclusions drawn from these data. FNAI is not inviting reliance on these data. Inventory data are designed for the purposes of conservation planning and scientific research and are not intended for use as the primary criteria for regulatory decisions.

Unofficial Report

These results are considered unofficial. FNAI offers a Standard Data Request option for those needing certifiable data.

APPENDIX C


REFERENCE COPY

IPaC **U.S. Fish & Wildlife Service**

IPaC resource list

This report is an automatically generated list of species and other resources such as critical habitat (collectively referred to as *trust resources*) under the U.S. Fish and Wildlife Service's (USFWS) jurisdiction that are known or expected to be on or near the project area referenced below. The list may also include trust resources that occur outside of the project area, but that could potentially be directly or indirectly affected by activities in the project area. However, determining the likelihood and extent of effects a project may have on trust resources typically requires gathering additional site-specific (e.g., vegetation/species surveys) and project-specific (e.g., magnitude and timing of proposed activities) information.

Below is a summary of the project information you provided and contact information for the USFWS office(s) with jurisdiction in the defined project area. Please read the introduction to each section that follows (Endangered Species, Migratory Birds, USFWS Facilities, and NWI Wetlands) for additional information applicable to the trust resources addressed in that section.

REFERENCE COPY
Not for consultation

Location

Osceola and Polk counties, Florida

Local office

South Florida Ecological Services Field Office

(772) 562-3909
(772) 562-4288

1339 20th Street
Vero Beach, FL 32960-3559

http://fws.gov/verobeach

REFERENCE COPY
Not for consultation

Endangered species

This resource list is for informational purposes only and does not constitute an analysis of project level impacts.

The primary information used to generate this list is the known or expected range of each species. Additional areas of influence (AOI) for species are also considered. An AOI includes areas outside of the species range if the species could be indirectly affected by activities in that area (e.g., placing a dam upstream of a fish population, even if that fish does not occur at the dam site, may indirectly impact the species by reducing or eliminating water flow downstream). Because species can move, and site conditions can change, the species on this list are not guaranteed to be found on or near the project area. To fully determine any potential effects to species, additional site-specific and project-specific information is often required.

Section 7 of the Endangered Species Act **requires** Federal agencies to "request of the Secretary information whether any species which is listed or proposed to be listed may be present in the area of such proposed action" for any project that is conducted, permitted, funded, or licensed by any Federal agency. A letter from the local office and a species list which fulfills this requirement can **only** be obtained by requesting an official species list from either the Regulatory Review section in IPaC (see directions below) or from the local field office directly.

REFERENCE COPY
Not for consultation

For project evaluations that require USFWS concurrence/review, please return to the IPaC website and request an official species list by doing the following:

1. Draw the project location and click CONTINUE.
2. Click DEFINE PROJECT.
3. Log in (if directed to do so).
4. Provide a name and description for your project.
5. Click REQUEST SPECIES LIST.

Listed species

[1] are managed by the Ecological Services Program of the U.S. Fish and Wildlife Service.

1. Species listed under the Endangered Species Act are threatened or endangered; IPaC also shows species that are candidates, or proposed, for listing. See the listing status page for more information.

The following species are potentially affected by activities in this location:

Mammals

NAME	STATUS
Florida Bonneted Bat Eumops floridanus No critical habitat has been designated for this species. https://ecos.fws.gov/ecp/species/8630	Endangered
Florida Panther Puma (=Felis) concolor coryi No critical habitat has been designated for this species. https://ecos.fws.gov/ecp/species/1763	Endangered
Puma (=mountain Lion) Puma (=Felis) concolor (all subsp. except coryi) No critical habitat has been designated for this species. https://ecos.fws.gov/ecp/species/6049	SAT

Birds

NAME	STATUS
Audubon's Crested Caracara Polyborus plancus audubonii No critical habitat has been designated for this species. https://ecos.fws.gov/ecp/species/8250	Threatened
Everglade Snail Kite Rostrhamus sociabilis plumbeus There is a **final** critical habitat designated for this species. Your location is outside the designated critical habitat. https://ecos.fws.gov/ecp/species/7713	Endangered
Florida Grasshopper Sparrow Ammodramus savannarum floridanus No critical habitat has been designated for this species. https://ecos.fws.gov/ecp/species/32	Endangered
Florida Scrub-jay Aphelocoma coerulescens No critical habitat has been designated for this species. https://ecos.fws.gov/ecp/species/6174	Threatened

REFERENCE COPY
Not for consultation

Ivory-billed Woodpecker Campephilus principalis — Endangered
No critical habitat has been designated for this species.
https://ecos.fws.gov/ecp/species/8230

Red-cockaded Woodpecker Picoides borealis — Endangered
No critical habitat has been designated for this species.
https://ecos.fws.gov/ecp/species/7614

Whooping Crane Grus americana — EXPN
No critical habitat has been designated for this species.
https://ecos.fws.gov/ecp/species/758

Wood Stork Mycteria americana — Threatened
No critical habitat has been designated for this species.
https://ecos.fws.gov/ecp/species/8477

Reptiles

NAME	STATUS

American Alligator Alligator mississippiensis — SAT
No critical habitat has been designated for this species.
https://ecos.fws.gov/ecp/species/776

Bluetail Mole Skink Eumeces egregius lividus — Threatened
No critical habitat has been designated for this species.
https://ecos.fws.gov/ecp/species/2203

Eastern Indigo Snake Drymarchon corais couperi — Threatened
No critical habitat has been designated for this species.
https://ecos.fws.gov/ecp/species/646

Sand Skink Neoseps reynoldsi — Threatened
No critical habitat has been designated for this species.
https://ecos.fws.gov/ecp/species/4094

REFERENCE COPY
Not for consultation

Flowering Plants

NAME	STATUS
Avon Park Harebells Crotalaria avonensis No critical habitat has been designated for this species. https://ecos.fws.gov/ecp/species/7093	Endangered
Britton's Beargrass Nolina brittoniana No critical habitat has been designated for this species. https://ecos.fws.gov/ecp/species/4460	Endangered
Carter's Mustard Warea carteri No critical habitat has been designated for this species. https://ecos.fws.gov/ecp/species/5583	Endangered
Florida Bonamia Bonamia grandiflora No critical habitat has been designated for this species. https://ecos.fws.gov/ecp/species/2230	Threatened
Florida Ziziphus Ziziphus celata No critical habitat has been designated for this species. https://ecos.fws.gov/ecp/species/2950	Endangered
Highlands Scrub Hypericum Hypericum cumulicola No critical habitat has been designated for this species. https://ecos.fws.gov/ecp/species/2940	Endangered
Lewton's Polygala Polygala lewtonii No critical habitat has been designated for this species. https://ecos.fws.gov/ecp/species/6688	Endangered
Papery Whitlow-wort Paronychia chartacea No critical habitat has been designated for this species. https://ecos.fws.gov/ecp/species/1465	Threatened
Pigeon Wings Clitoria fragrans No critical habitat has been designated for this species. https://ecos.fws.gov/ecp/species/991	Threatened

REFERENCE COPY
Not for consultation

Pygmy Fringe-tree Chionanthus pygmaeus — Endangered
No critical habitat has been designated for this species.
https://ecos.fws.gov/ecp/species/1084

Sandlace Polygonella myriophylla — Endangered
No critical habitat has been designated for this species.
https://ecos.fws.gov/ecp/species/5745

Scrub Blazingstar Liatris ohlingerae — Endangered
No critical habitat has been designated for this species.
https://ecos.fws.gov/ecp/species/864

Scrub Buckwheat Eriogonum longifolium var. gnaphalifolium — Threatened
No critical habitat has been designated for this species.
https://ecos.fws.gov/ecp/species/5940

Scrub Lupine Lupinus aridorum — Endangered
No critical habitat has been designated for this species.
https://ecos.fws.gov/ecp/species/736

REFERENCE COPY
Not for consultation

Scrub Mint Dicerandra frutescens — Endangered
No critical habitat has been designated for this species.
https://ecos.fws.gov/ecp/species/799

Scrub Plum Prunus geniculata — Endangered
No critical habitat has been designated for this species.
https://ecos.fws.gov/ecp/species/2238

Short-leaved Rosemary Conradina brevifolia — Endangered
No critical habitat has been designated for this species.
https://ecos.fws.gov/ecp/species/2929

Wide-leaf Warea Warea amplexifolia — Endangered
No critical habitat has been designated for this species.
https://ecos.fws.gov/ecp/species/412

Wireweed Polygonella basiramia No critical habitat has been designated for this species. https://ecos.fws.gov/ecp/species/1718	Endangered

Lichens

NAME	STATUS
Florida Perforate Cladonia Cladonia perforata No critical habitat has been designated for this species. https://ecos.fws.gov/ecp/species/7516	Endangered

Critical habitats

Potential effects to critical habitat(s) in this location must be analyzed along with the endangered species themselves.

THERE ARE NO CRITICAL HABITATS AT THIS LOCATION.

REFERENCE COPY
Not for consultation

Migratory birds

Certain birds are protected under the Migratory Bird Treaty Act

[1] and the Bald and Golden Eagle Protection Act[2].

Any activity that results in the take (to harass, harm, pursue, hunt, shoot, wound, kill, trap, capture, or collect, or to attempt to engage in any such conduct) of migratory birds or eagles is prohibited unless authorized by the U.S. Fish and Wildlife Service

[3]. There are no provisions for allowing the take of migratory birds that are unintentionally killed or injured.

Any person or organization who plans or conducts activities that may result in the take of migratory birds is responsible for complying with the appropriate regulations and implementing appropriate conservation measures.

1. The Migratory Birds Treaty Act of 1918.
2. The Bald and Golden Eagle Protection Act of 1940.
3. 50 C.F.R. Sec. 10.12 and 16 U.S.C. Sec. 668(a)

Additional information can be found using the following links:

- Birds of Conservation Concern http://www.fws.gov/birds/management/managed-species/birds-of-conservation-concern.php
- Conservation measures for birds http://www.fws.gov/birds/management/project-assessment-tools-and-guidance/conservation-measures.php
- Year-round bird occurrence data http://www.birdscanada.org/birdmon/default/datasummaries.jsp

The migratory birds species listed below are species of particular conservation concern (e.g. Birds of Conservation Concern) that may be potentially affected by activities in this location. It is not a list of every bird species you may find in this location, nor a guarantee that all of the bird species on this list will be found on or near this location. Although it is important to try to avoid and minimize impacts to all birds, special attention should be made to avoid and minimize impacts to birds of priority concern. To view available data on other bird species that may occur in your project area, please visit the AKN Histogram Tools and Other Bird Data Resources. To fully determine any potential effects to species, additional site-specific and project-specific information is often required.

REFERENCE COPY
Not for consultation

NAME	SEASON(S)
American Bittern Botaurus lentiginosus https://ecos.fws.gov/ecp/species/6582	Wintering
American Kestrel Falco sparverius paulus	Year-round
American Oystercatcher Haematopus palliatus https://ecos.fws.gov/ecp/species/8935	Year-round
Bachman's Sparrow Aimophila aestivalis https://ecos.fws.gov/ecp/species/6177	Year-round
Bald Eagle Haliaeetus leucocephalus https://ecos.fws.gov/ecp/species/1626	Year-round
Black Rail Laterallus jamaicensis https://ecos.fws.gov/ecp/species/7717	Breeding

Brown-headed Nuthatch *Sitta pusilla*	Year-round
Chuck-will's-widow *Caprimulgus carolinensis*	Year-round
Common Ground-dove *Columbina passerina exigua*	Year-round
Henslow's Sparrow *Ammodramus henslowii* https://ecos.fws.gov/ecp/species/3941	Wintering
Least Bittern *Ixobrychus exilis* https://ecos.fws.gov/ecp/species/6175	Year-round
Lesser Yellowlegs *Tringa flavipes* https://ecos.fws.gov/ecp/species/9679	Wintering
Limpkin *Aramus guarauna*	Year-round
Loggerhead Shrike *Lanius ludovicianus* https://ecos.fws.gov/ecp/species/8833	Year-round
Peregrine Falcon *Falco peregrinus* https://ecos.fws.gov/ecp/species/8831	Wintering
Prairie Warbler *Dendroica discolor*	Wintering
Prothonotary Warbler *Protonotaria citrea*	Breeding
Red-headed Woodpecker *Melanerpes erythrocephalus*	Year-round
Rusty Blackbird *Euphagus carolinus*	Wintering
Short-eared Owl *Asio flammeus* https://ecos.fws.gov/ecp/species/9295	Wintering

REFERENCE COPY
Not for consultation

Short-tailed Hawk Buteo brachyurus https://ecos.fws.gov/ecp/species/8742	Breeding
Smooth-billed Ani Crotophaga ani https://ecos.fws.gov/ecp/species/1754	Year-round
Swainson's Warbler Limnothlypis swainsonii	Migrating
Swallow-tailed Kite Elanoides forficatus https://ecos.fws.gov/ecp/species/8938	Breeding
Worm Eating Warbler Helmitheros vermivorum	Migrating
Yellow Rail Coturnicops noveboracensis https://ecos.fws.gov/ecp/species/9476	Wintering

What does IPaC use to generate the list of migratory bird species potentially occurring in my specified location?

REFERENCE COPY

Landbirds:

Migratory birds that are displayed on the IPaC species list are based on ranges in the latest edition of the National Geographic Guide, Birds of North America (6th Edition, 2011 by Jon L. Dunn, and Jonathan Alderfer). Although these ranges are coarse in nature, a number of U.S. Fish and Wildlife Service migratory bird biologists agree that these maps are some of the best range maps to date. These ranges were clipped to a specific Bird Conservation Region (BCR) or USFWS Region/Regions, if it was indicated in the 2008 list of Birds of Conservation Concern (BCC) that a species was a BCC species only in a particular Region/Regions. Additional modifications have been made to some ranges based on more local or refined range information and/or information provided by U.S. Fish and Wildlife Service biologists with species expertise. All migratory birds that show in areas on land in IPaC are those that appear in the 2008 Birds of Conservation Concern report.

Not for consultation

Atlantic Seabirds:

Ranges in IPaC for birds off the Atlantic coast are derived from species distribution models developed by the National Oceanic and Atmospheric Association (NOAA) National Centers for Coastal Ocean Science (NCCOS) using the best available seabird survey data for the offshore Atlantic Coastal region to date. NOAANCCOS assisted USFWS in developing seasonal species ranges from their models for specific use in IPaC. Some of these birds are not BCC species but were of interest for inclusion because they may occur in high abundance off the coast at different times throughout the year, which potentially makes them more susceptible to certain types of development and activities taking place in that area. For more refined details about the abundance

and richness of bird species within your project area off the Atlantic Coast, see the Northeast Ocean Data Portal. The Portal also offers data and information about other types of taxa that may be helpful in your project review.

About the NOAANCCOS models: the models were developed as part of the NOAANCCOS project: Integrative Statistical Modeling and Predictive Mapping of Marine Bird Distributions and Abundance on the Atlantic Outer Continental Shelf. The models resulting from this project are being used in a number of decision-support/mapping products in order to help guide decision-making on activities off the Atlantic Coast with the goal of reducing impacts to migratory birds. One such product is the Northeast Ocean Data Portal, which can be used to explore details about the relative occurrence and abundance of bird species in a particular area off the Atlantic Coast.

All migratory bird range maps within IPaC are continuously being updated as new and better information becomes available.

Can I get additional information about the levels of occurrence in my project area of specific birds or groups of birds listed in IPaC?

Landbirds:

The Avian Knowledge Network (AKN) provides a tool currently called the "Histogram Tool", which draws from the data within the AKN (latest,survey, point count, citizen science datasets) to create a view of relative abundance of species within a particular location over the course of the year. The results of the tool depict the frequency of detection of a species in survey events, averaged between multiple datasets within AKN in a particular week of the year. You may access the histogram tools through the Migratory Bird Programs AKN Histogram Tools webpage.

REFERENCE COPY
Not for consultation

The tool is currently available for 4 regions (California, Northeast U.S., Southeast U.S. and Midwest), which encompasses the following 32 states: Alabama, Arkansas, California, Connecticut, Delaware, Florida, Georgia, Illinois, Indiana, Iowa, Kentucky, Louisiana, Maine, Maryland, Massachusetts, Michigan, Minnesota, Mississippi, Missouri, New Hampshire, New Jersey, New York, North, Carolina, Ohio, Pennsylvania, Rhode Island, South Carolina, Tennessee, Vermont, Virginia, West Virginia, and Wisconsin.

In the near future, there are plans to expand this tool nationwide within the AKN, and allow the graphs produced to appear with the list of trust resources generated by IPaC, providing you with an additional level of detail about the level of occurrence of the species of particular concern potentially occurring in your project area throughout the course of the year.

Atlantic Seabirds:

For additional details about the relative occurrence and abundance of both individual bird species and groups of bird species within your project area off the Atlantic Coast, please visit the Northeast Ocean Data Portal. The Portal also offers data and information about other taxa besides birds that may be helpful to you in your project review. Alternately, you may download the bird model results files underlying the portal maps through the NOAANCCOS Integrative Statistical Modeling and Predictive Mapping of Marine Bird Distributions and Abundance on the Atlantic Outer Continental Shelf project webpage.

Facilities

Wildlife refuges

Any activity proposed on National Wildlife Refuge lands must undergo a 'Compatibility Determination' conducted by the Refuge. Please contact the individual Refuges to discuss any questions or concerns.

THERE ARE NO REFUGES AT THIS LOCATION.

Fish hatcheries

THERE ARE NO FISH HATCHERIES AT THIS LOCATION.

REFERENCE COPY
Not for consultation

Wetlands in the National Wetlands Inventory

Impacts to NWI wetlands and other aquatic habitats may be subject to regulation under Section 404 of the Clean Water Act, or other State/Federal statutes.

For more information please contact the Regulatory Program of the local U.S. Army Corps of Engineers District.

WETLAND INFORMATION IS NOT AVAILABLE AT THIS TIME
This can happen when the National Wetlands Inventory (NWI) map service is unavailable, or for very large projects that intersect many wetland areas. Try again, or visit the NWI map to view wetlands at this location.

Data limitations

The Service's objective of mapping wetlands and deepwater habitats is to produce reconnaissance level information on the location, type and size of these resources. The maps are prepared from the analysis of high altitude imagery. Wetlands are identified based on vegetation, visible

hydrology and geography. A margin of error is inherent in the use of imagery; thus, detailed on-the-ground inspection of any particular site may result in revision of the wetland boundaries or classification established through image analysis.

The accuracy of image interpretation depends on the quality of the imagery, the experience of the image analysts, the amount and quality of the collateral data and the amount of ground truth verification work conducted. Metadata should be consulted to determine the date of the source imagery used and any mapping problems.

Wetlands or other mapped features may have changed since the date of the imagery or field work. There may be occasional differences in polygon boundaries or classifications between the information depicted on the map and the actual conditions on site.

Data exclusions

Certain wetland habitats are excluded from the National mapping program because of the limitations of aerial imagery as the primary data source used to detect wetlands. These habitats include seagrasses or submerged aquatic vegetation that are found in the intertidal and subtidal zones of estuaries and nearshore coastal waters. Some deepwater reef communities (coral or tuberficid worm reefs) have also been excluded from the inventory. These habitats, because of their depth, go undetected by aerial imagery.

Data precautions

REFERENCE COPY

Federal, state, and local regulatory agencies with jurisdiction over wetlands may define and describe wetlands in a different manner than that used in this inventory. There is no attempt, in either the design or products of this inventory, to define the limits of proprietary jurisdiction of any Federal, state, or local government or to establish the geographical scope of the regulatory programs of government agencies. Persons intending to engage in activities involving modifications within or adjacent to wetland areas should seek the advice of appropriate federal, state, or local agencies concerning specified agency regulatory programs and proprietary jurisdictions that may affect such activities.

Not for consultation

APPENDIX D


REFERENCE COPY

DESKTOP ANALYSIS FOR THE
CONCEPT, FEASIBILITY & MOBILITY STUDY
POINCIANA PARKWAY EXTENSION/I-4 CONNECTOR
OSCEOLA AND POLK COUNTIES, FLORIDA






REFERENCE COPY

POINCIANA PARKWAY EXTENSION/I-4 CONNECTOR STUDY AREA—PREVIOUS SURVEYS



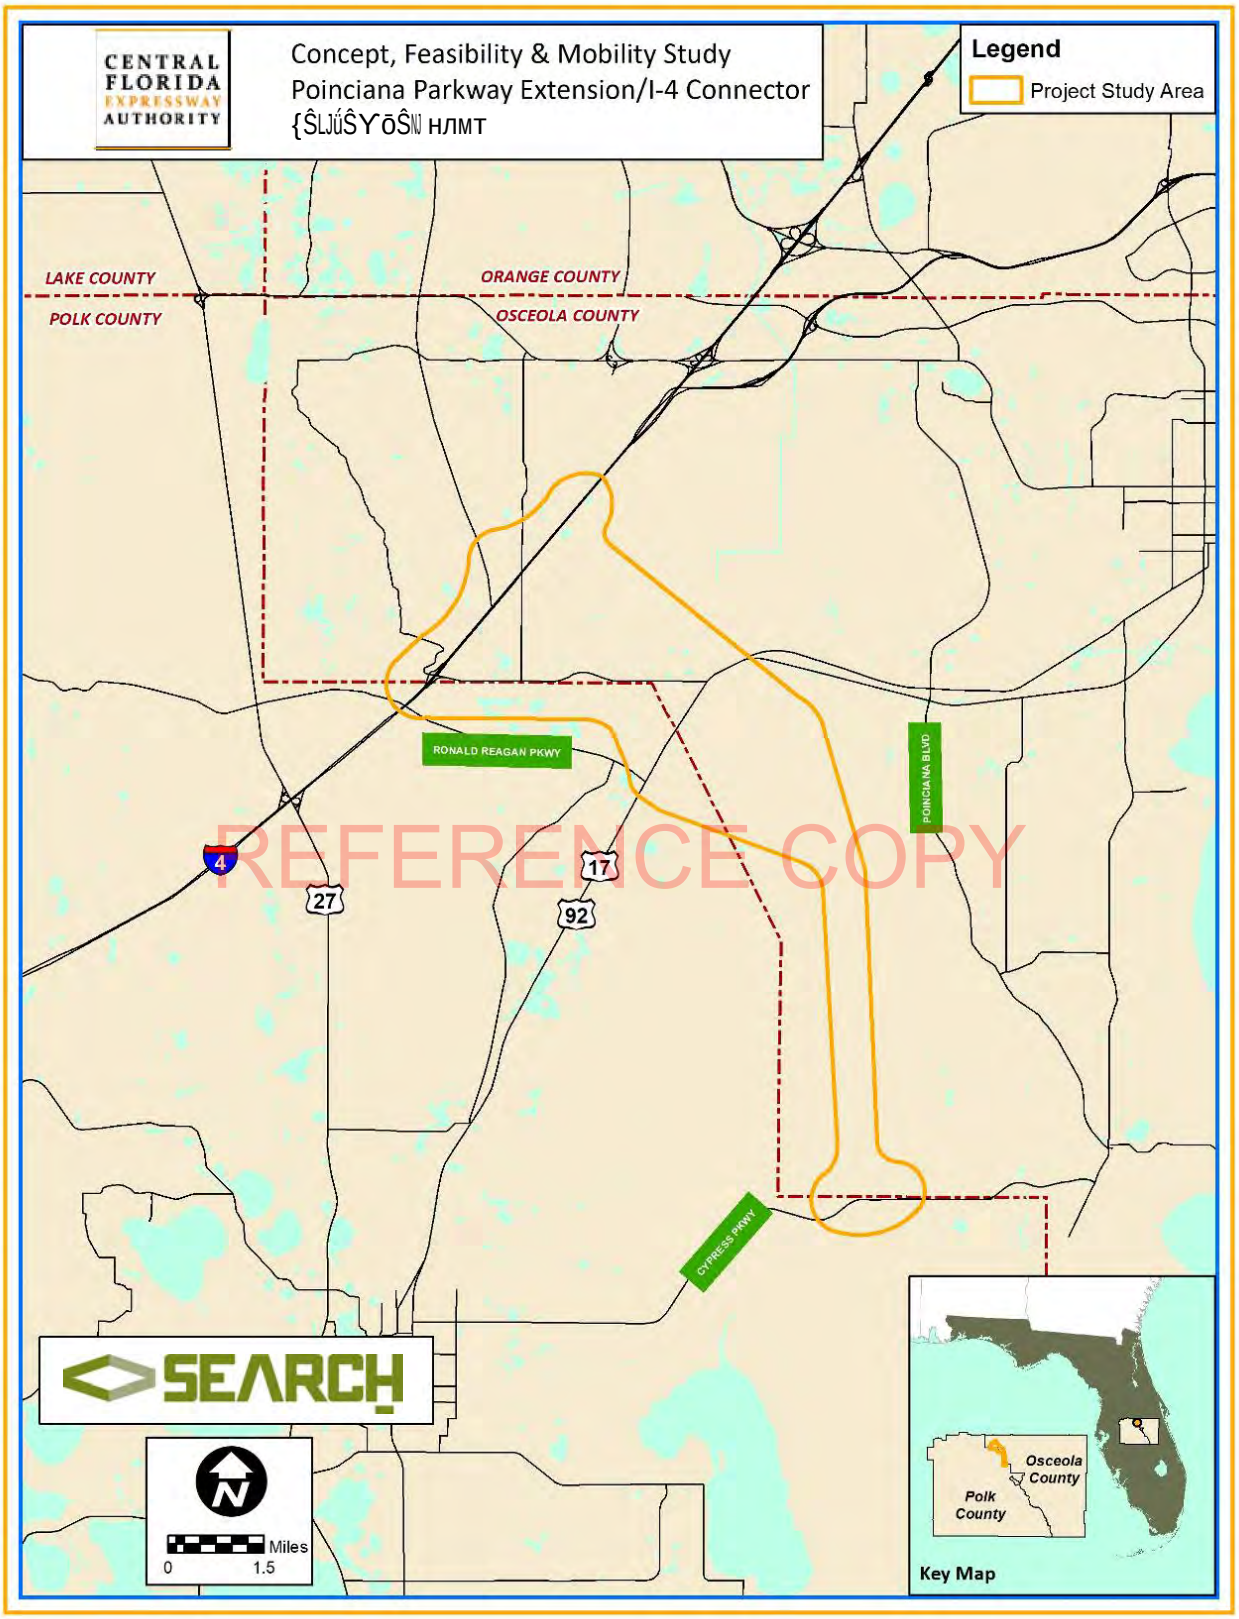

Figure 1. Location of the Study Area for the Poinciana Parkway Extension/I-4 Connector Desktop Analysis in Osceola and Polk Counties, Florida.

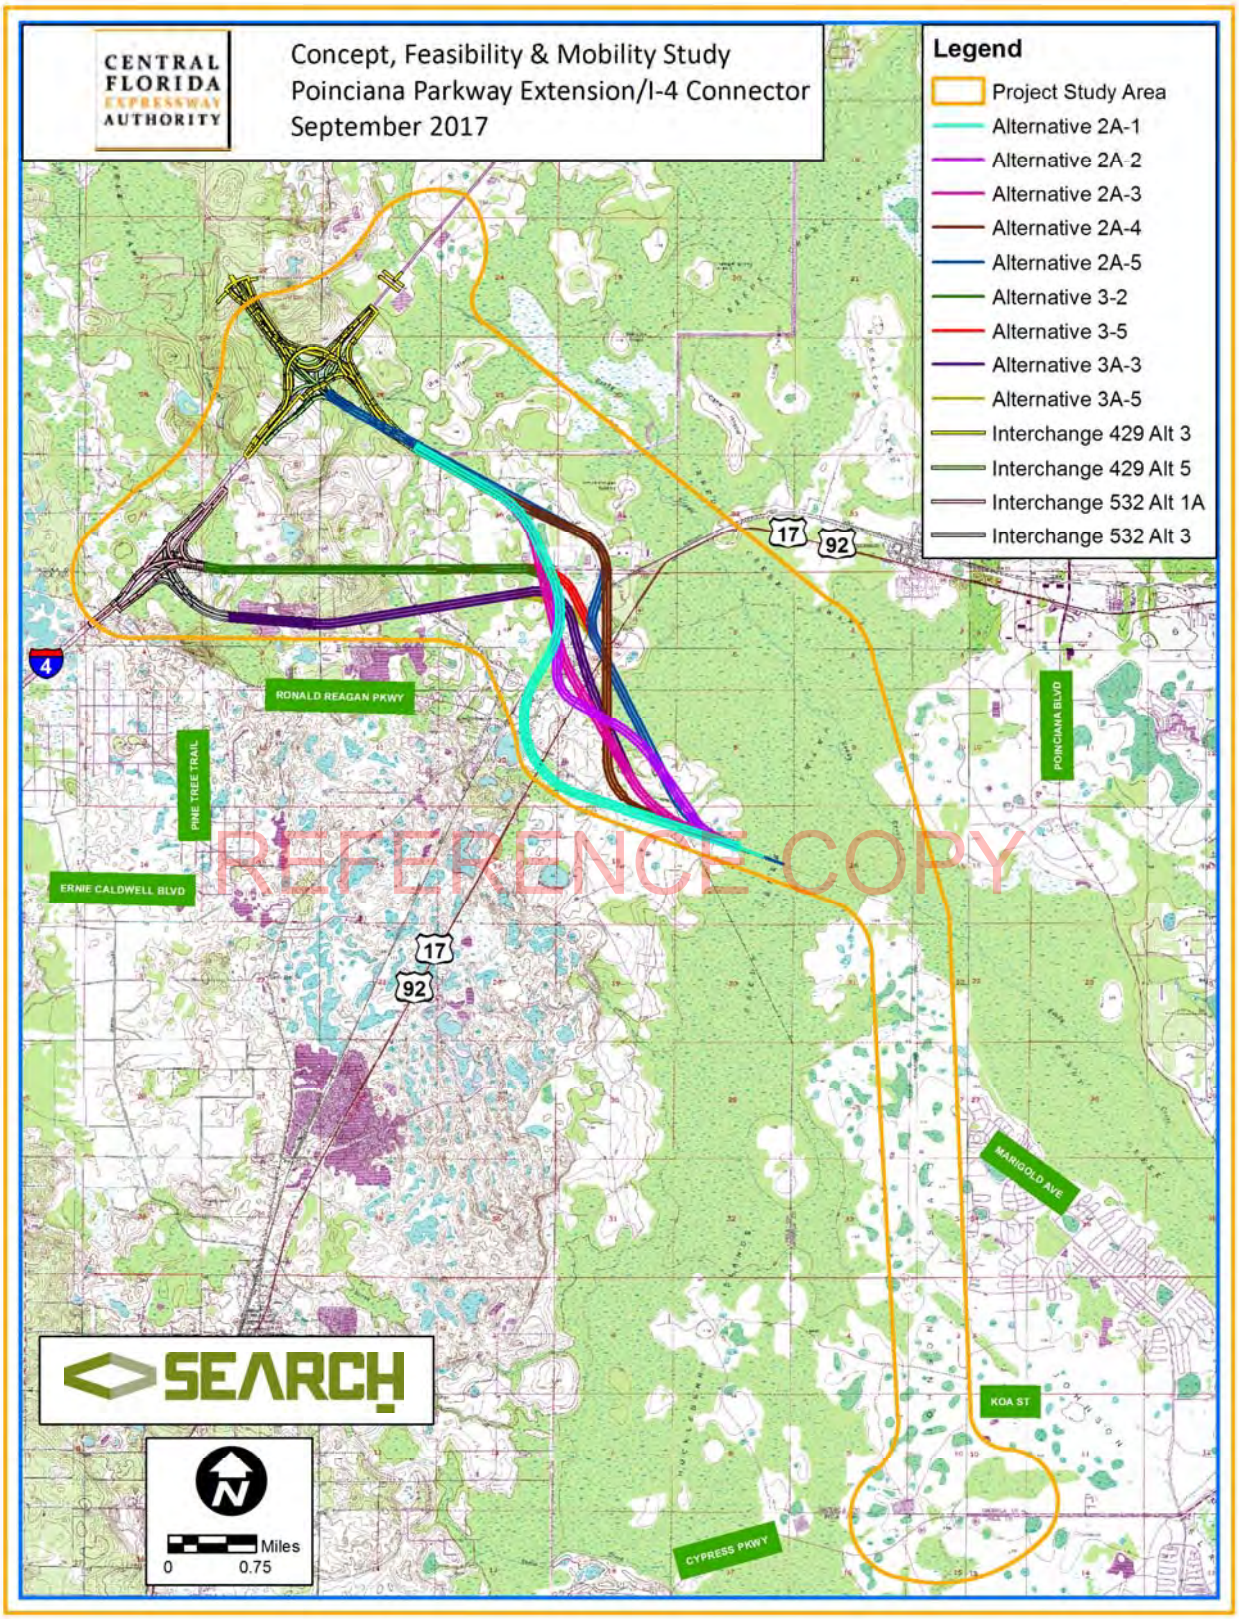

Figure 2. Nine roadway and four interchange alignment alternatives within the Poinciana Parkway Extension/I-4 Study Area.

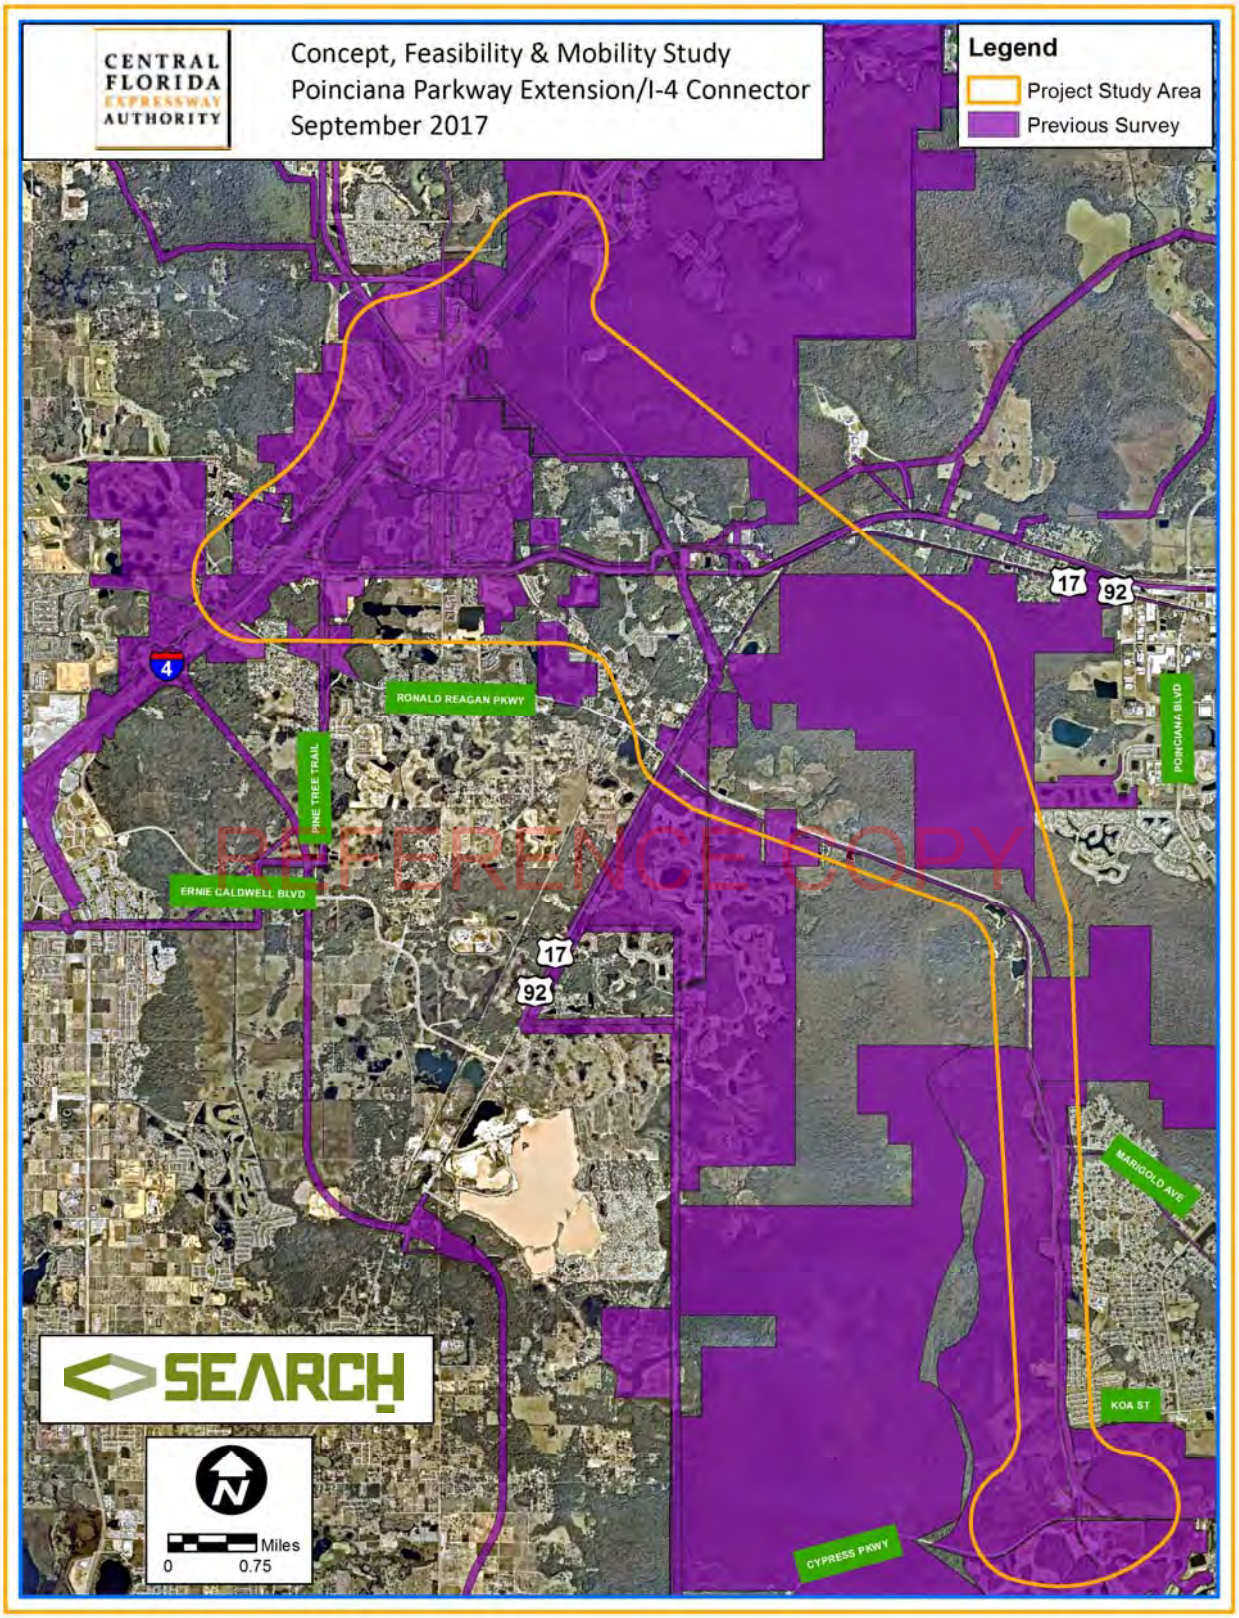

Figure 3. Previous cultural resource surveys intersecting the Poinciana Parkway Extension/I-4 Poinciana Connector Study Area. Source: FMSF (7/2017); KHA (2017).

POINCIANA PARKWAY EXTENSION/I-4 CONNECTOR STUDY AREA—RECORDED RESOURCES





Table 1. FMSF Resources Intersecting the Roadway and Interchange Alignment Alternatives.

FMSF No.	Resource Name	Resource Type	SHPO Evaluation	Alternative Name

REFERENCE COPY

Table 1. FMSF Resources Intersecting the Roadway and Interchange Alignment Alternatives.

FMSF No.	Resource Name	Resource Type	SHPO Evaluation	Alternative Name

REFERENCE COPY

Table 1. FMSF Resources Intersecting the Roadway and Interchange Alignment Alternatives.

FMSF No.	Resource Name	Resource Type	SHPO Evaluation	Alternative Name

Yellow highlight indicates additional investigation is needed for the resource.

Alternative 2A-1 and the Kinney Harmon Road Cemetery (8PO01519)



POINCIANA PARKWAY EXTENSION/I-4 CONNECTOR STUDY AREA—UNRECORDED RESOURCES



REFERENCE COPY

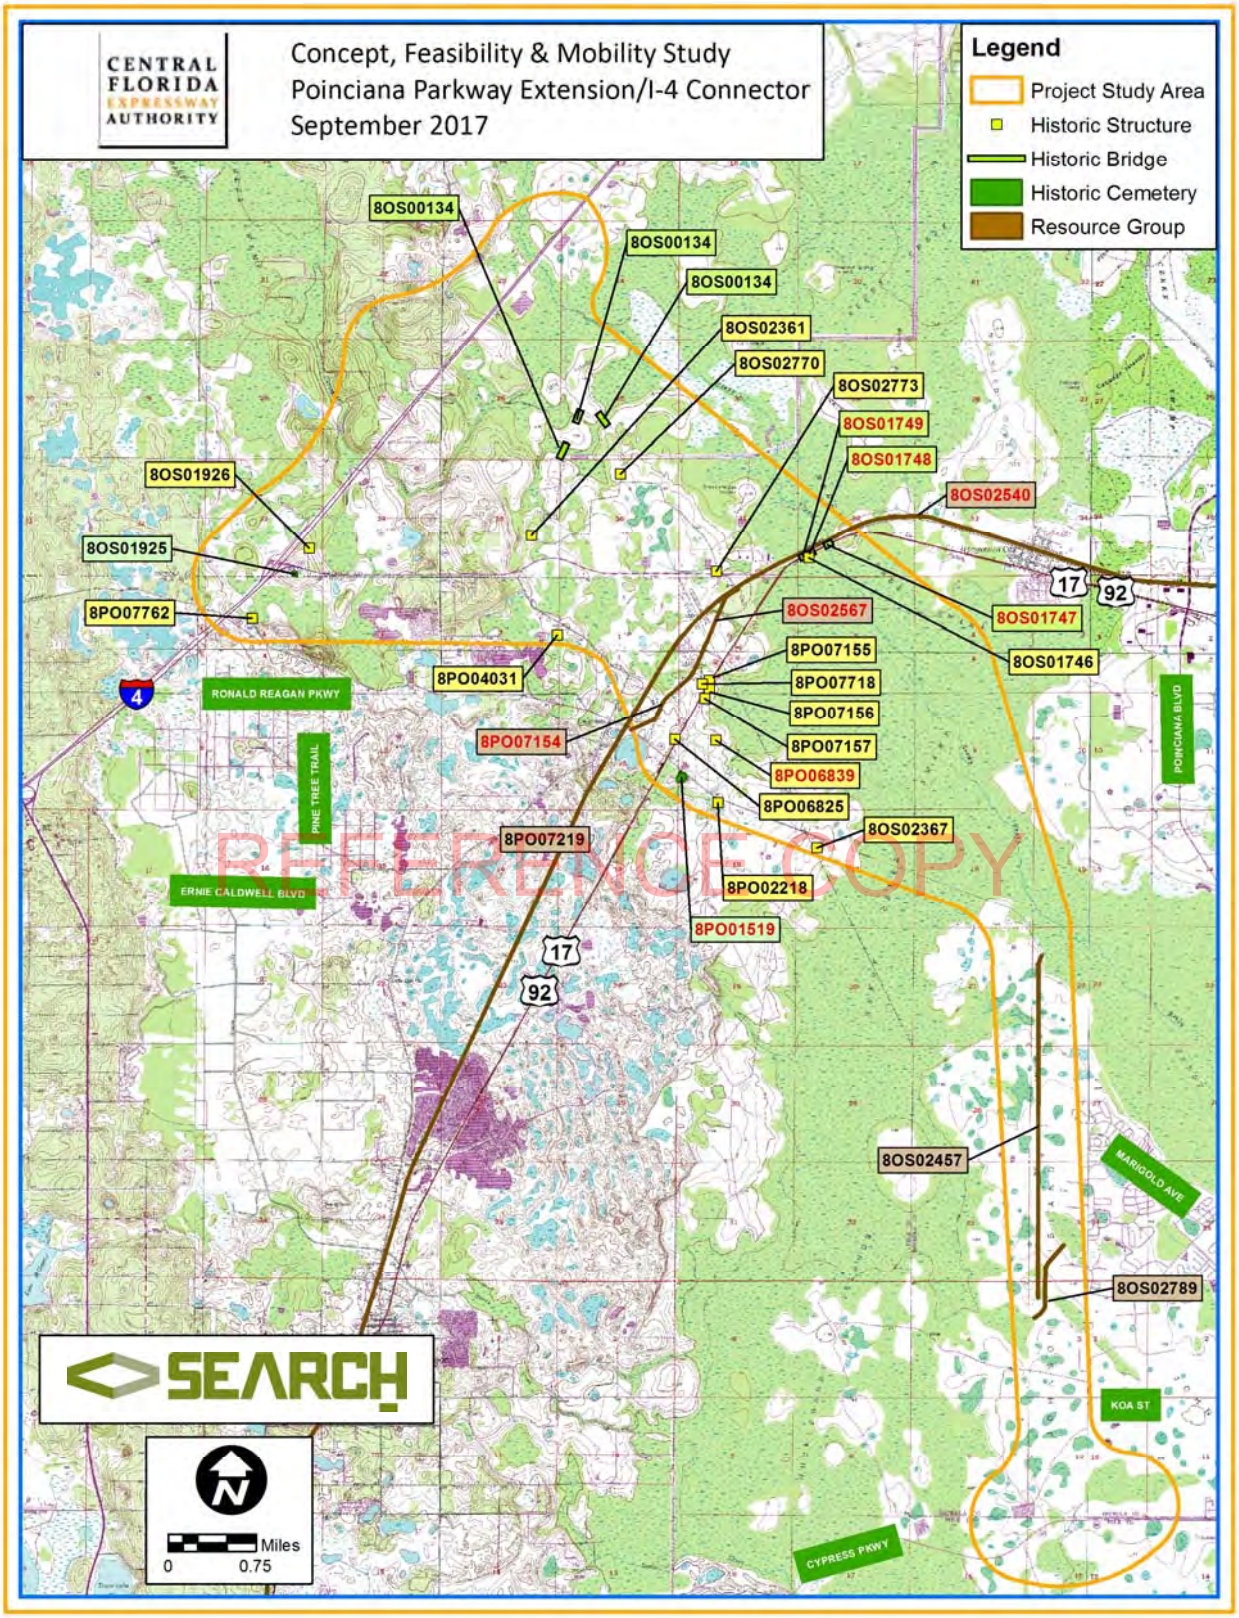

Figure 4. Previously recorded historic resources within the Poinciana Parkway Extension/I-4 Connector Study Area. Note: Red text labels indicate the resource is eligible for NRHP listing or needs evaluation by SHPO. Source: FMSF (7/2017); SEARCH (12/2016); KHA (2017).

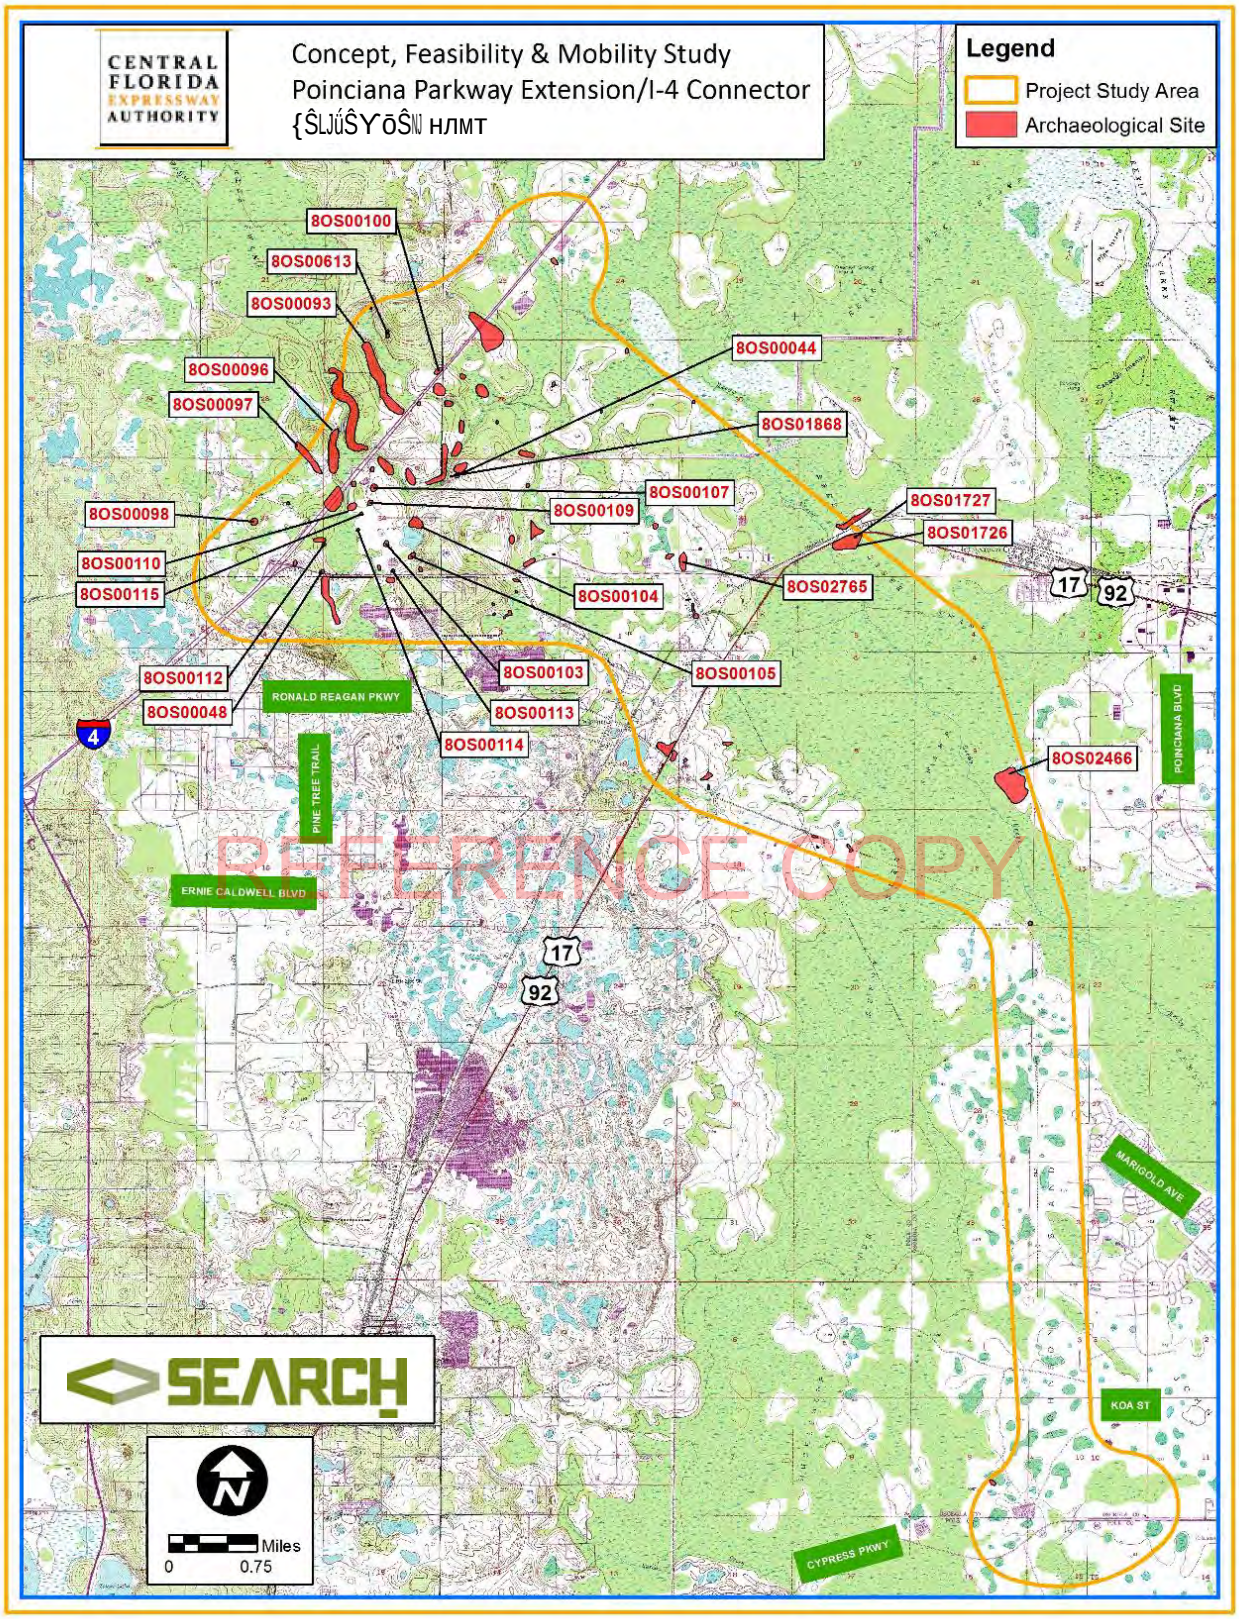

Figure 5. Previously recorded archaeological sites within the Poinciana Parkway Extension/I-4 Connector Study Area. Note: A label indicates a site is eligible for NRHP listing or needs evaluation by SHPO; Unlabeled sites are ineligible for NRHP. Source: FMSF (7/2017); KHA (2017).

Figure 6. Kinney Harmon Road Cemetery (8PO01519) boundary and recommended boundary in relation to the Poinciana Parkway Extension/I-4 Connector Alternative 2A-1.
Source: FMSF (7/2017); SEARCH (12/2016-3/2017); KHA (2017).






REFERENCE COPY

Table 2. Unrecorded Cultural Resources Intersecting the Roadway and Interchange Alignment Alternatives.

Alternative Name	County Property Appraiser Historic-Age Parcels	Other Potential Historic Resources	Total Unrecorded Resources

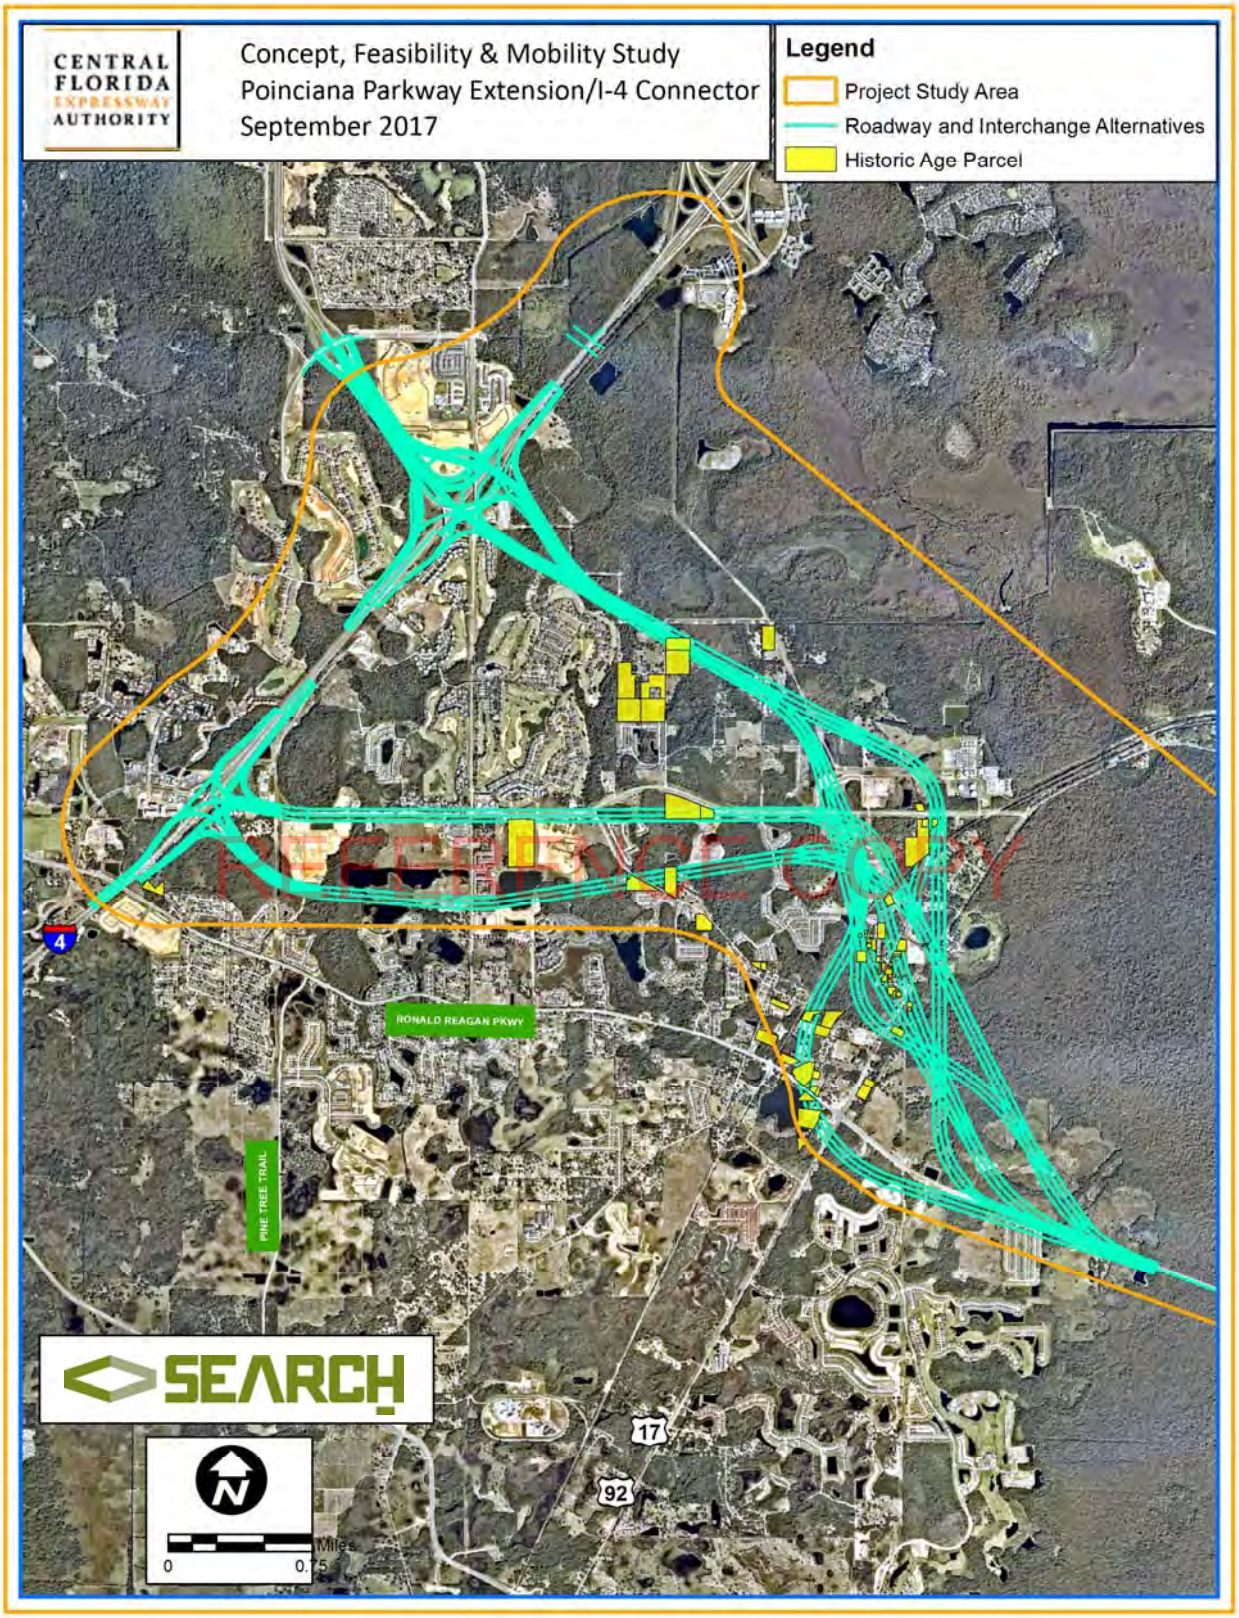

Figure 7. Historic age parcels shown in yellow that have not been previously recorded within the Poinciana Parkway Extension/I-4 Connector Roadways and Interchange Alignment Alternatives shown in aqua. Source: Osceola and Polk Counties Property Appraiser GIS Website (2014); KHA (2017).

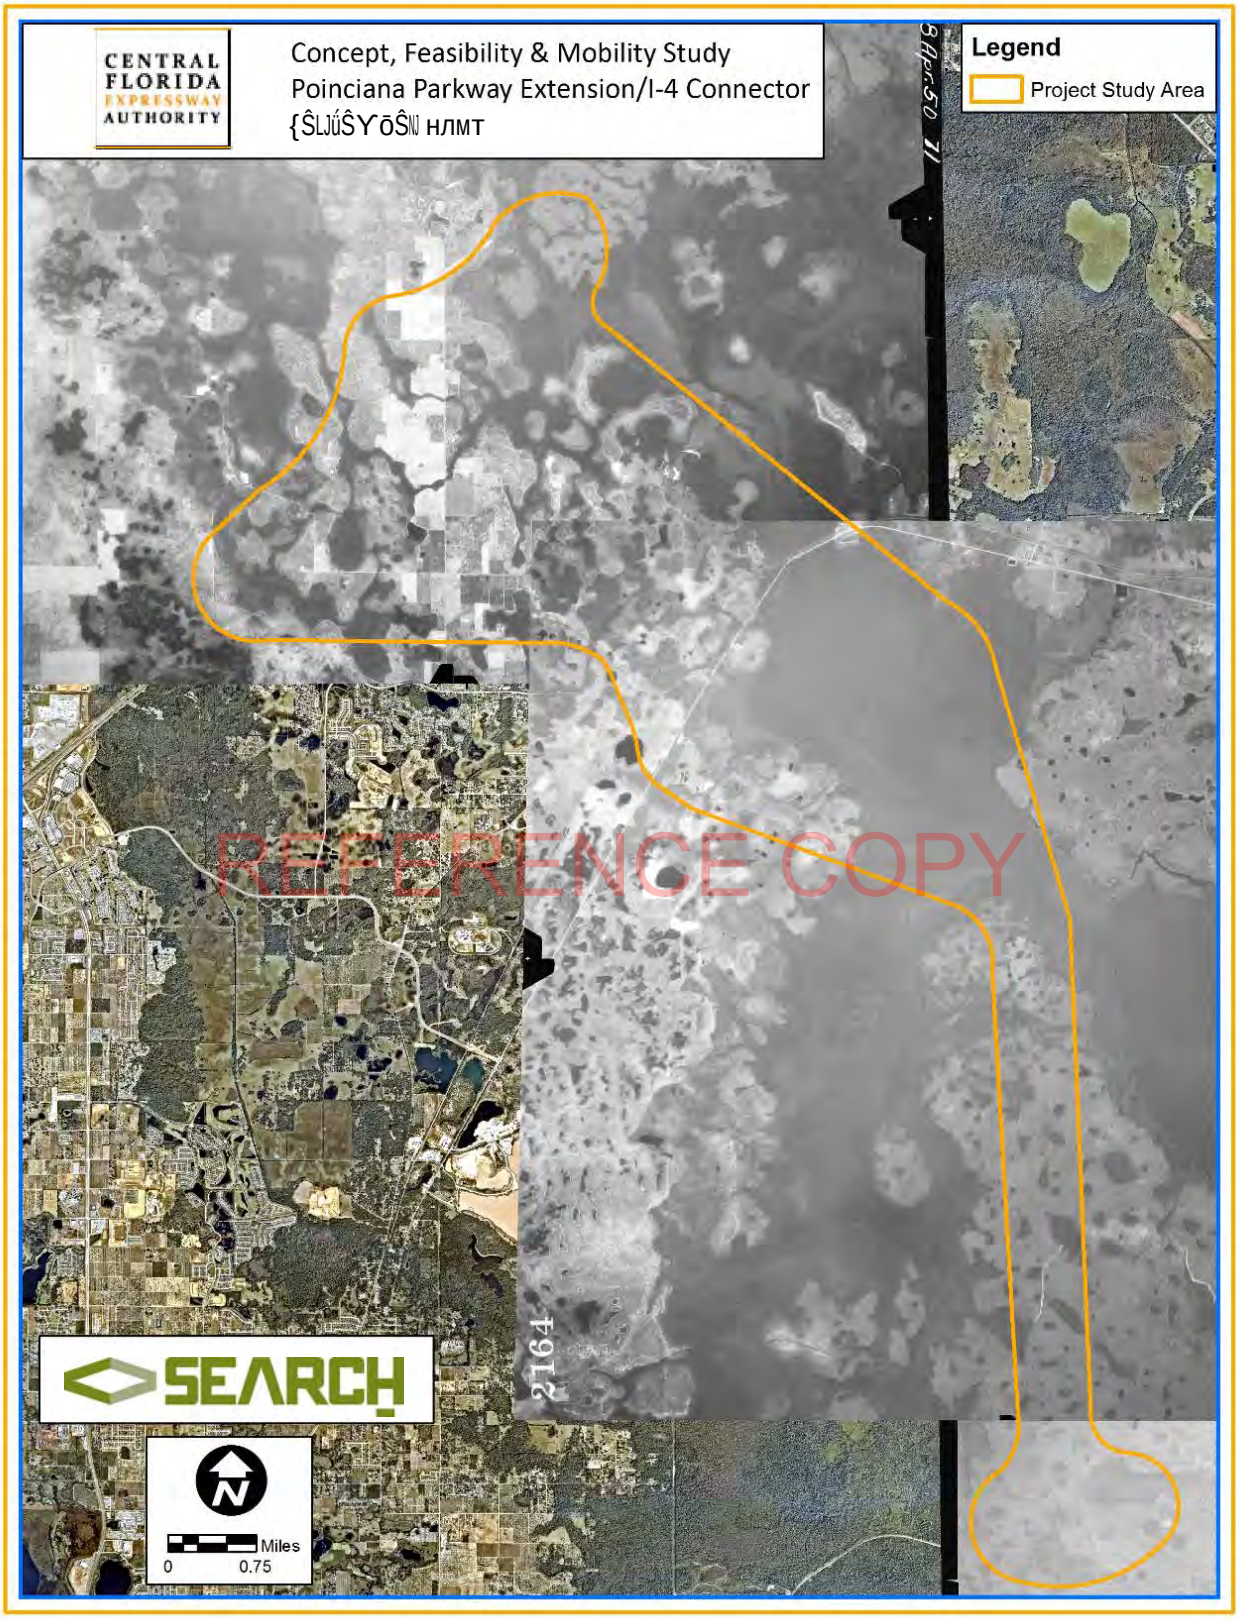

Figure 8. Aerial photographs from 1950 with Poinciana Parkway Extension/I-4 Connector Study Area in orange. Source: USGS (1950); KHA (2017).

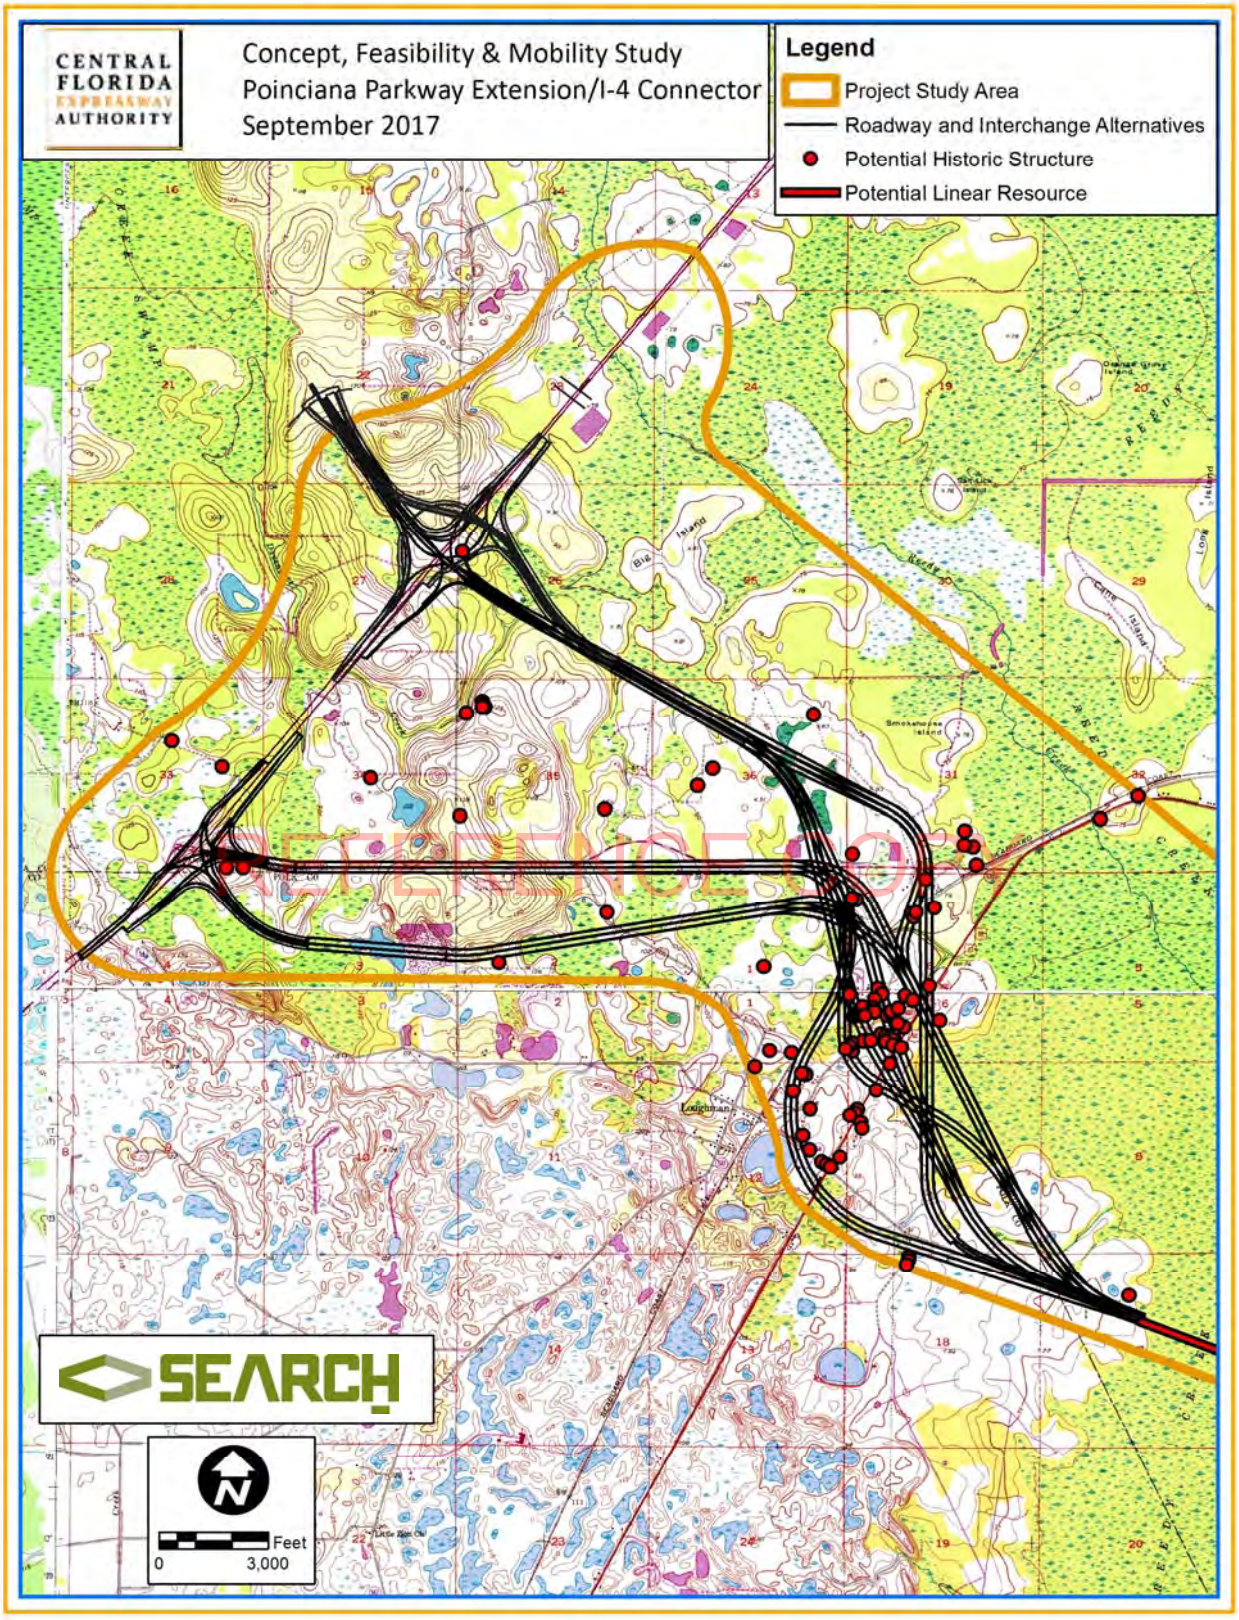

Figure 9. USGS quadrangle maps from the early 1970s with Poinciana Parkway Extension/I-4 Connector Roadways and Interchange Alignment Alternatives in black and potentially unrecorded resources in red. Source: USGS (1972, 1973); KHA (2017).

POINCIANA PARKWAY EXTENSION/I-4 CONNECTOR STUDY AREA — EVALUATION OF SOIL DRAINAGE

Table 3. Soil Drainage within the Poinciana Parkway Extension/I-4 Connector Study Area.

Soil Drainage	Acres	Percentage



REFERENCE COPY

RECOMMENDATIONS


Table 4. Poinciana Parkway Extension Alternatives Cultural Resources Matrix.

Alignment Name	Archaeological Sites (eligible or unevaluated)	Historic Resources (eligible or unevaluated)	Other Unrecorded Historic Resources

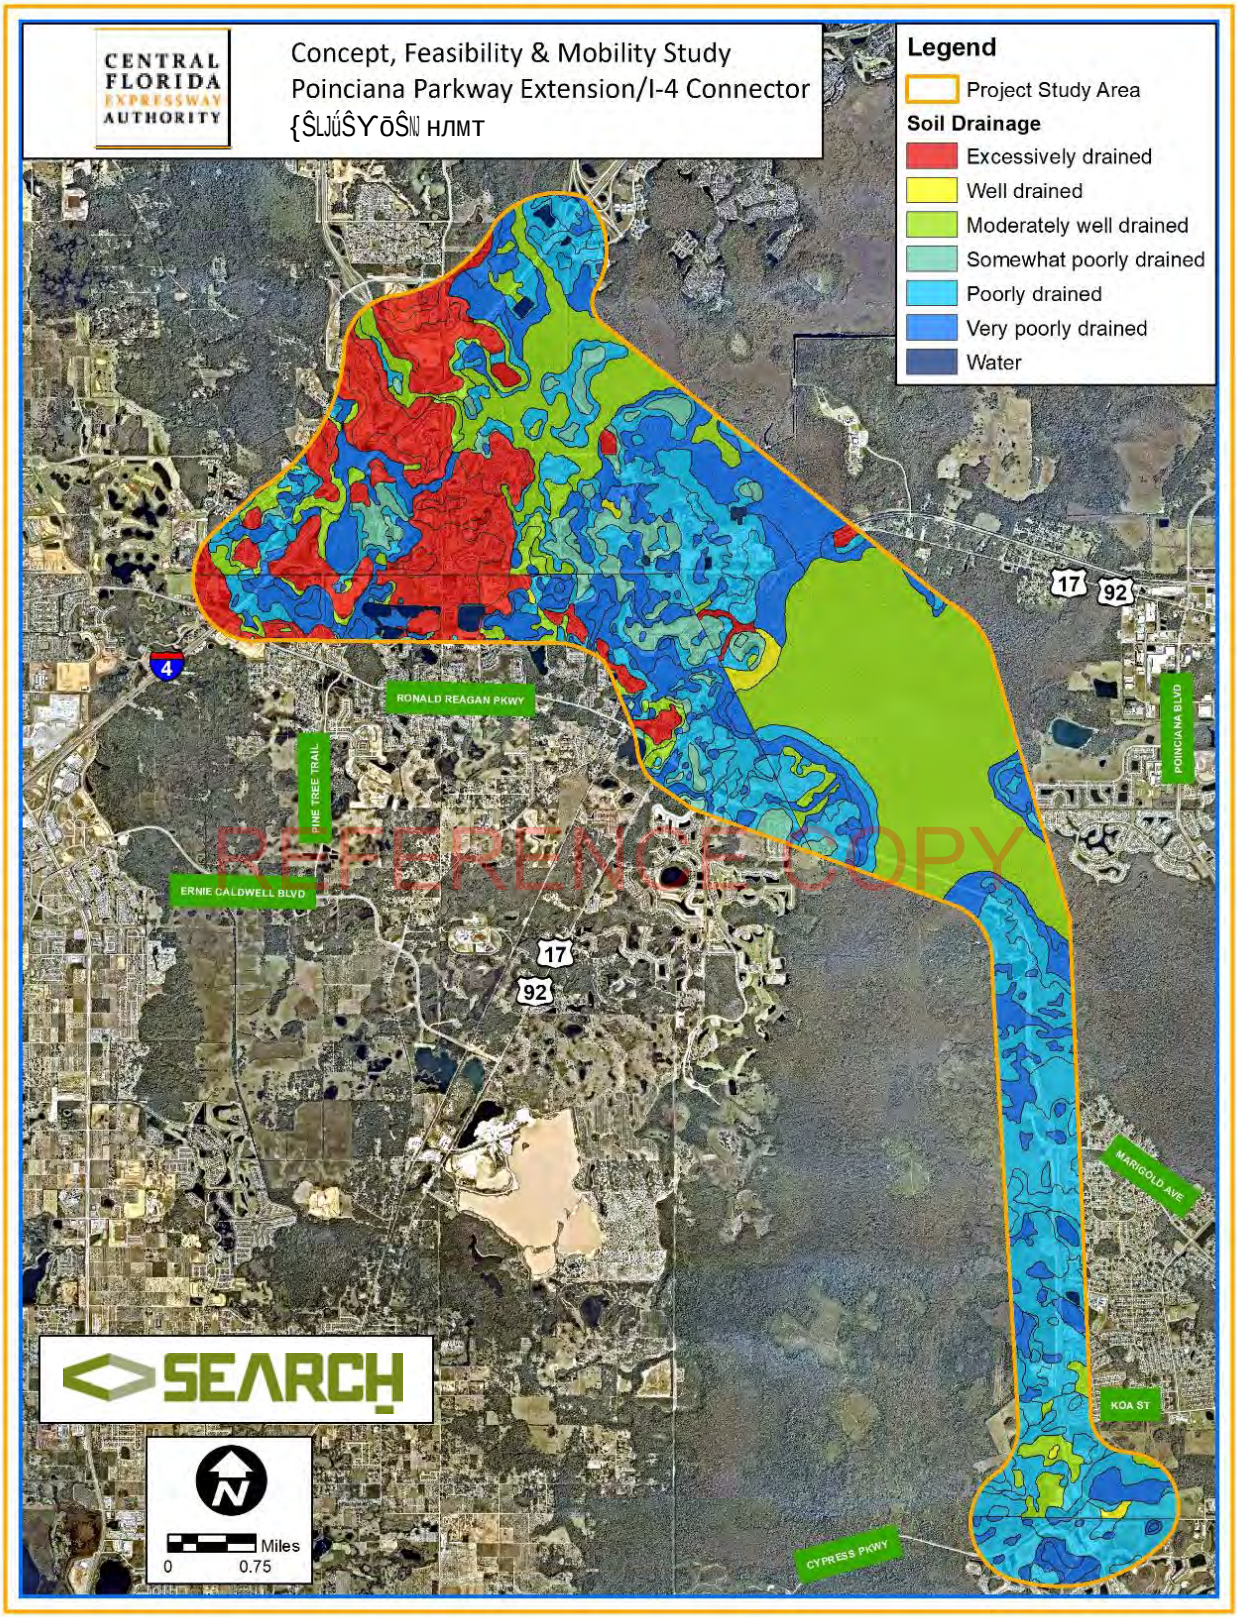

Figure 10. Soil drainage within the Poinciana Parkway Extension/I-4 Connector Study Area. Source: NRCS (2010); KHA (2017).








REFERENCE COPY

REFERENCES CITED



REFERENCE COPY

APPENDIX A

PREVIOUS CULTURAL RESOURCE SURVEYS WITHIN THE POINCIANA PARKWAY EXTENSION/I-4 CONNECTOR STUDY AREA

REFERENCE COPY

REFERENCE COPY

FMSF No.	Survey Title	Year	Reference

RETENTION COPY

FMSF No.	Survey Title	Year	Reference

REFERENCE COPY

FMSF No.	Survey Title	Year	Reference

REFERENCE COPY

FMSF No.	Survey Title	Year	Reference

REFERENCE COPY

APPENDIX B

PREVIOUSLY RECORDED CULTURAL RESOURCES WITHIN THE POINCIANA PARKWAY EXTENSION/I-4 CONNECTOR STUDY AREA

REFERENCE COPY

REFERENCE COPY

Historic Structures				
FMSF No.	**Name and/or Address**	**Year Built**	**Surveyor Evaluation**	**SHPO Evaluation**

Bridges				
FMSF No.	**Name and/or Number**	**Year Built**	**Condition**	**SHPO Evaluation**



REFERENCE COPY

Archaeological Sites				
FMSF No.	**Name**	**Primary Time Period**	**Surveyor Evaluation**	**SHPO Evaluation**

REFERENCE COPY

Archaeological Sites				
FMSF No.	**Name**	**Primary Time Period**	**Surveyor Evaluation**	**SHPO Evaluation**

REFERENCE COPY

Archaeological Sites				
FMSF No.	**Name**	**Primary Time Period**	**Surveyor Evaluation**	**SHPO Evaluation**

Yellow highlighted rows indicate NRHP eligibility or additional worked needed for evaluation needed.

REFERENCE COPY

APPENDIX E


REFERENCE COPY

Potential Contaminated Sites
Poinciana Parkway Extension / I-4 Connector
October 2017

Site #	Facility Name / Address / Permit or ID Numbers	Distance / Direction from Nearest Project Alternative	Facility Type / Potential Contamination Concern	Regulatory Status	Contamination Potential









REFERENCE COPY

Potential Contaminated Sites
Poinciana Parkway Extension / I-4 Connector
October 2017

Site #	Facility Name / Address / Permit or ID Numbers	Distance / Direction from Nearest Project Alternative	Facility Type / Potential Contamination Concern	Regulatory Status	Contamination Potential








REFERENCE COPY

Potential Contaminated Sites
Poinciana Parkway Extension / I-4 Connector
October 2017

Site #	Facility Name / Address / Permit or ID Numbers	Distance / Direction from Nearest Project Alternative	Facility Type / Potential Contamination Concern	Regulatory Status	Contamination Potential





REFERENCE COPY

Potential Contaminated Sites
Poinciana Parkway Extension / I-4 Connector
October 2017

Site #	Facility Name / Address / Permit or ID Numbers	Distance / Direction from Nearest Project Alternative	Facility Type / Potential Contamination Concern	Regulatory Status	Contamination Potential





REFERENCE COPY

Potential Contaminated Sites
Poinciana Parkway Extension / I-4 Connector
October 2017

Site #	Facility Name / Address / Permit or ID Numbers	Distance / Direction from Nearest Project Alternative	Facility Type / Potential Contamination Concern	Regulatory Status	Contamination Potential






REFERENCE COPY

APPENDIX F


REFERENCE COPY

REFERENCE COPY

REVISIONS			
DATE	DESCRIPTION	DATE	DESCRIPTION

CENTRAL FLORIDA EXPRESSWAY AUTHORITY

Concept, Feasability and Mobility Study
for the
Poinciana Parkway Extension / I-4 Connector

Poinciana Parkway Expansion

SHEET NO.

PPE-1

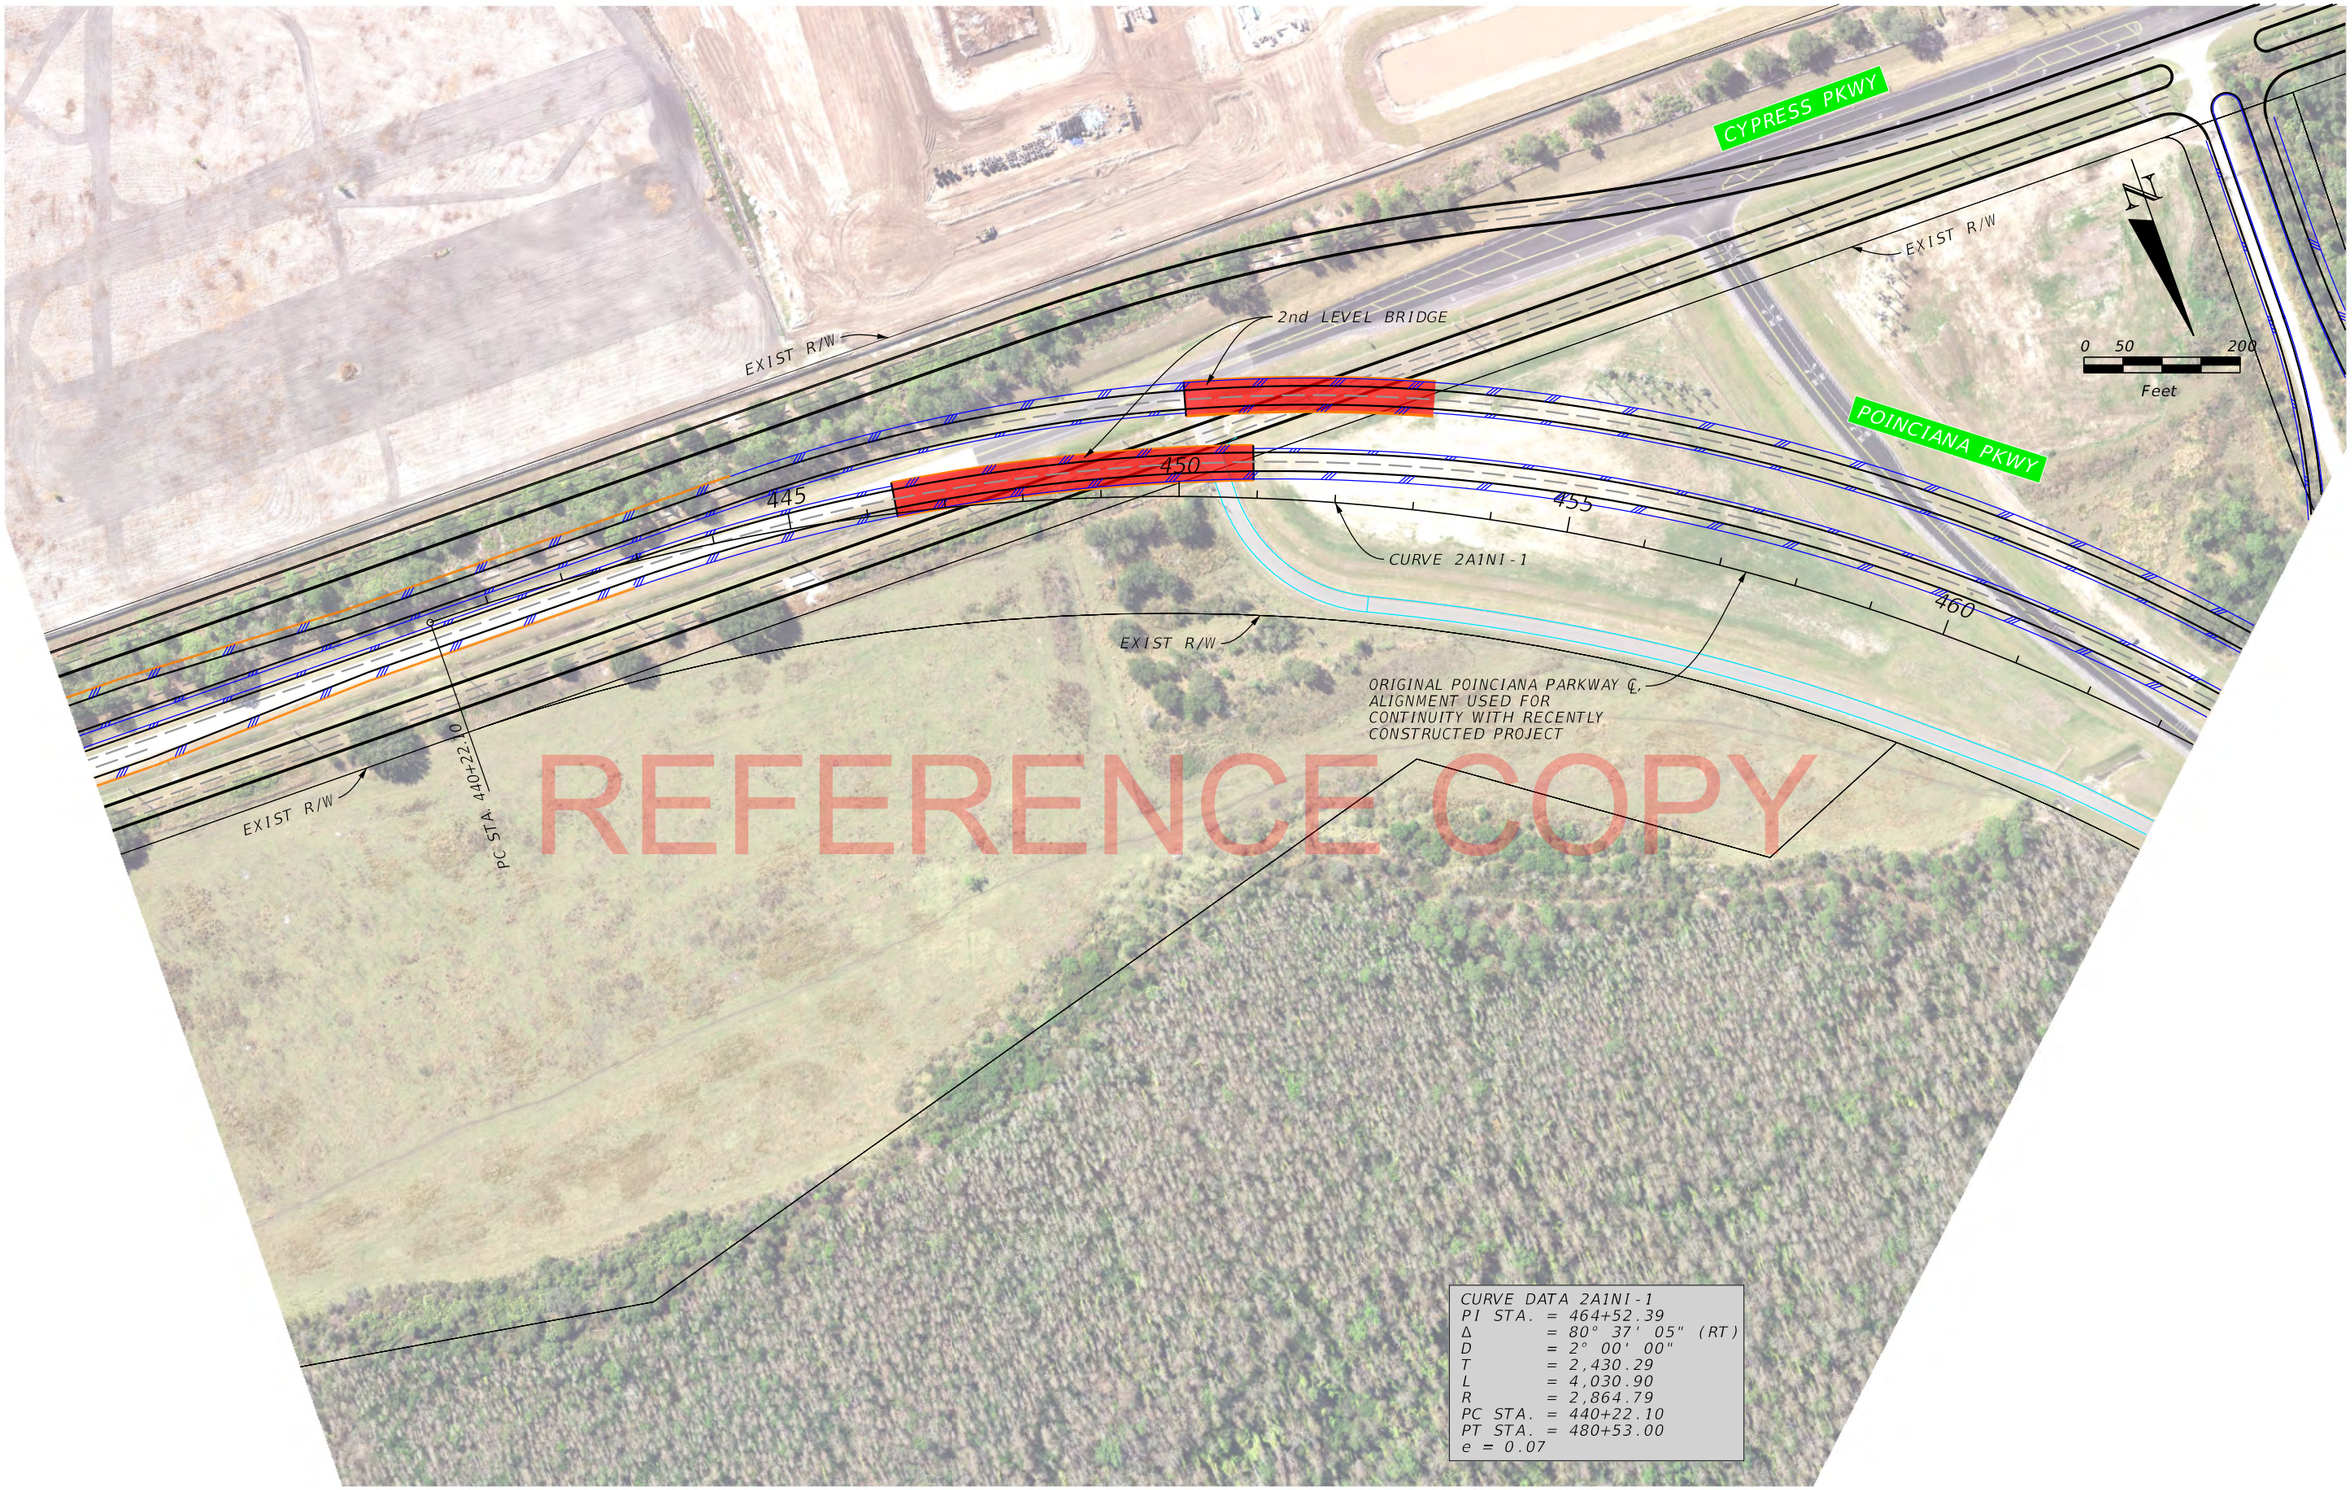

REFERENCE COPY

REVISIONS			
DATE	DESCRIPTION	DATE	DESCRIPTION

CENTRAL FLORIDA EXPRESSWAY AUTHORITY

Concept, Feasability and Mobility Study
for the
Poinciana Parkway Extension / I-4 Connector

Poinciana Parkway Expansion

SHEET NO.

PPE-2

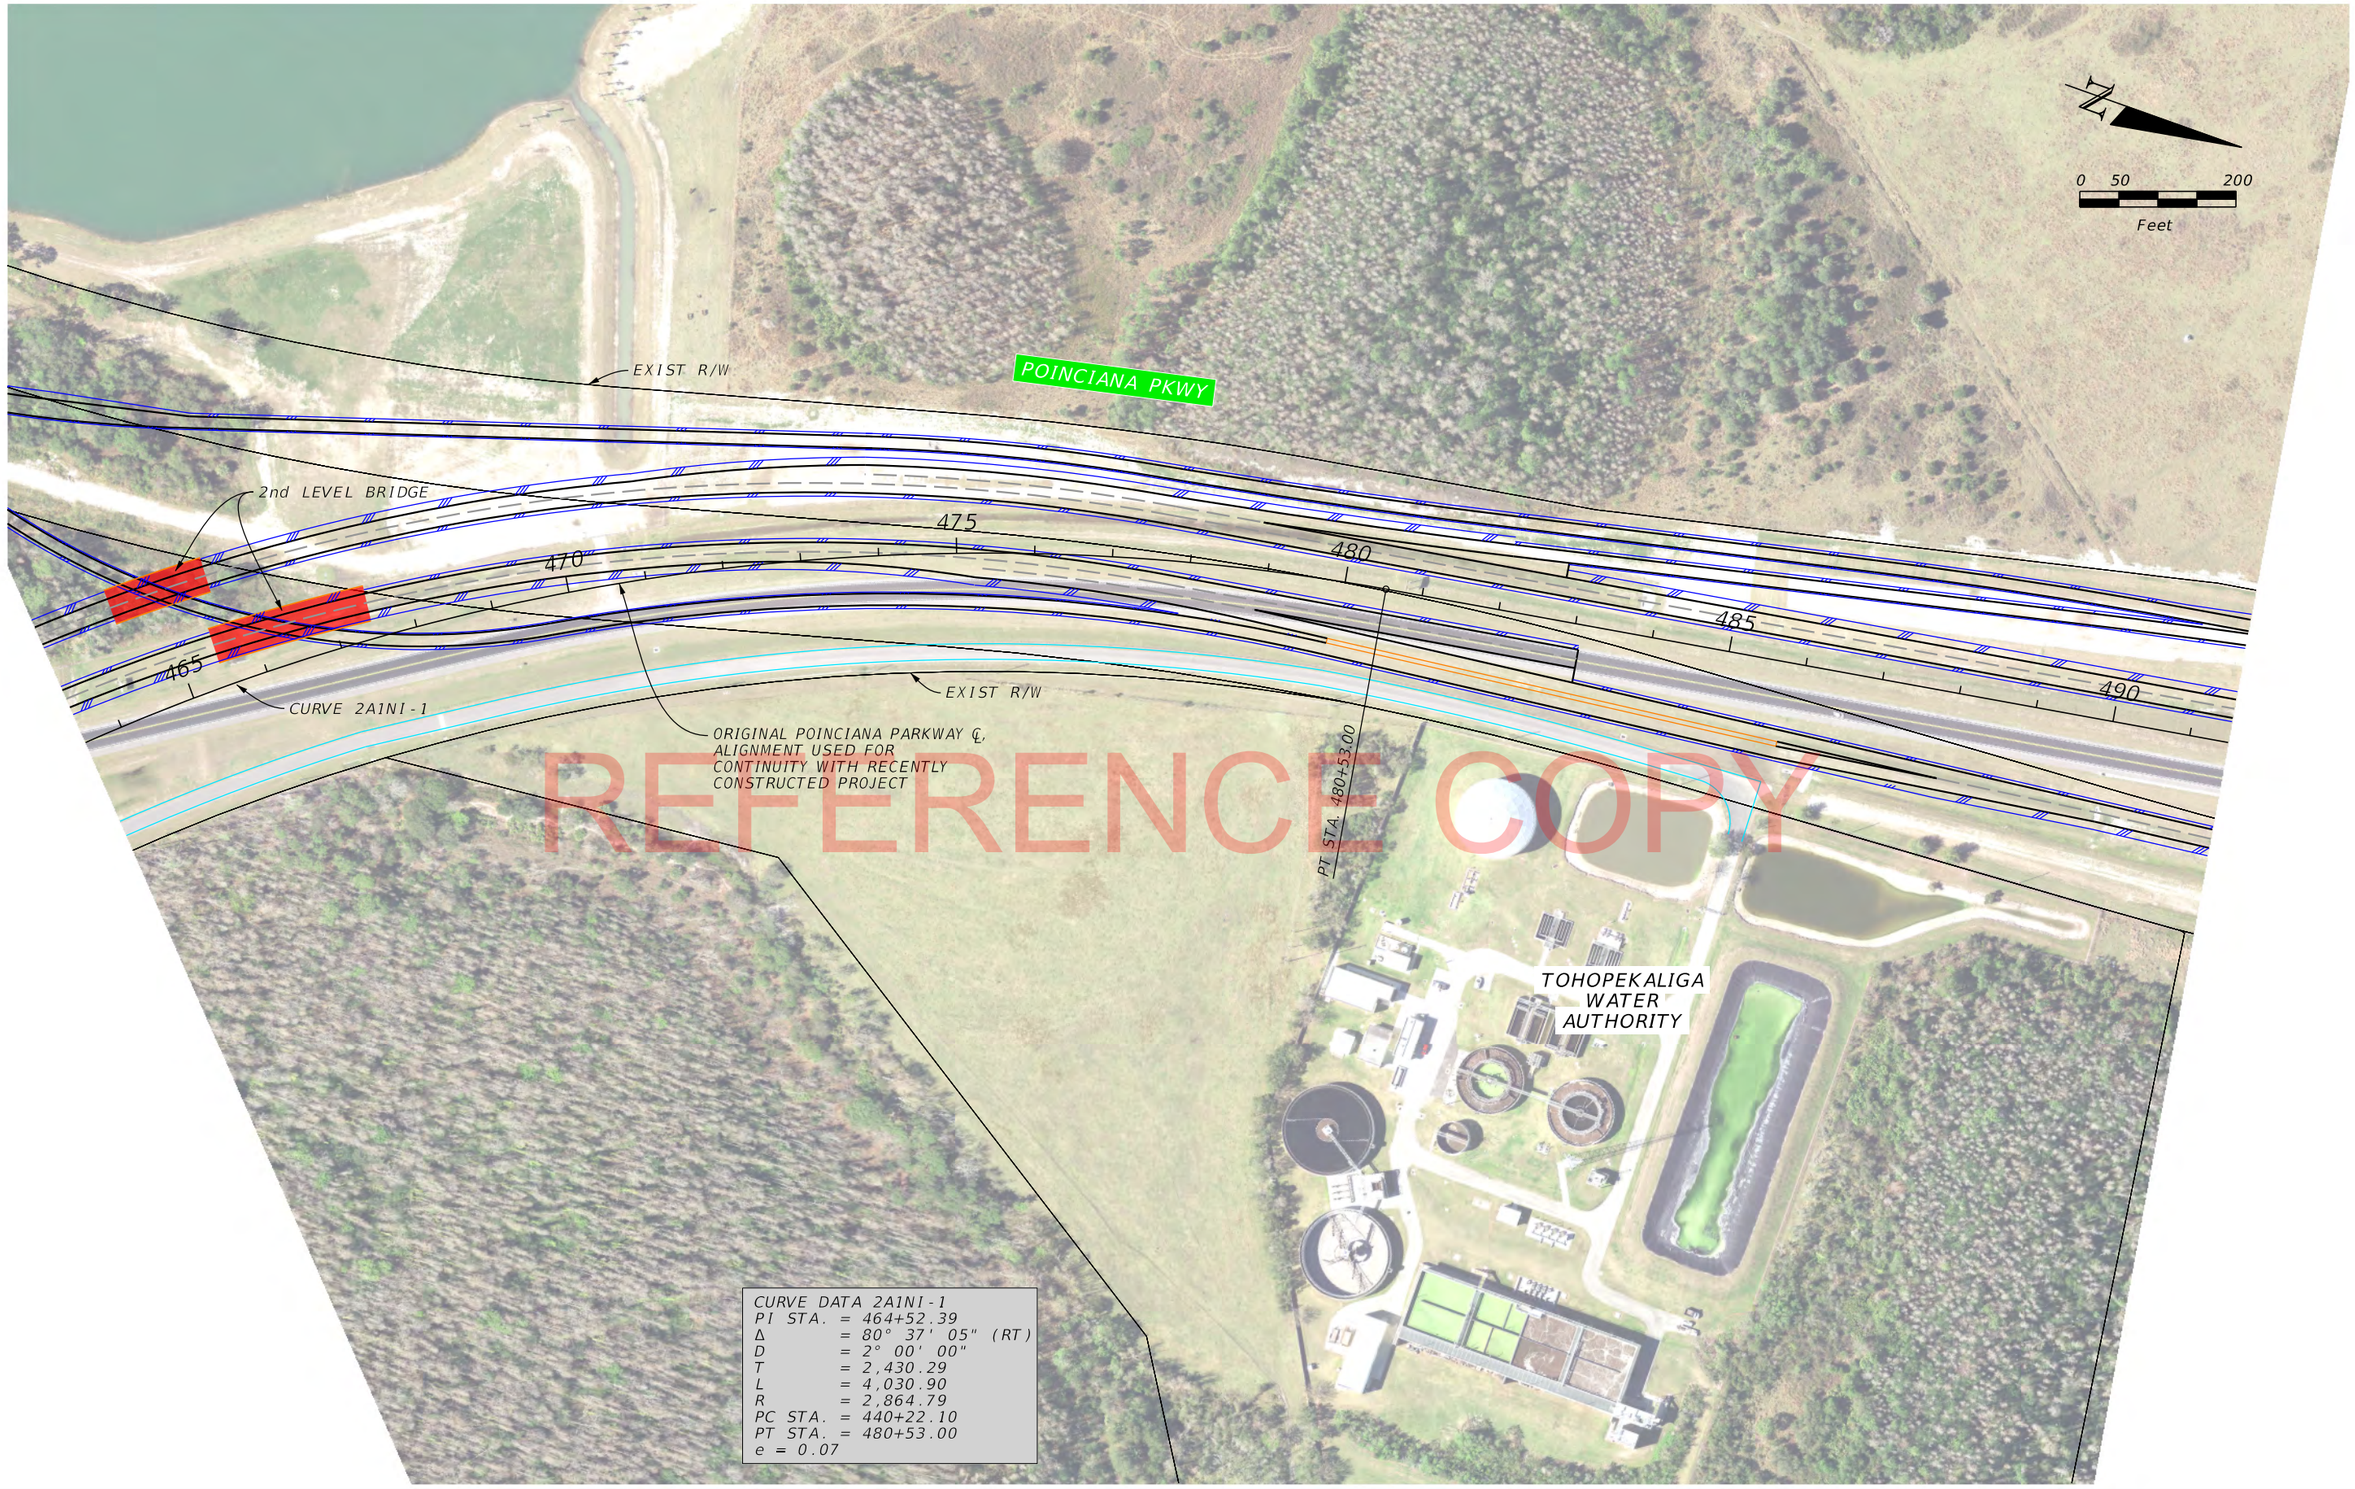

REFERENCE COPY

REVISIONS			
DATE	DESCRIPTION	DATE	DESCRIPTION

CENTRAL FLORIDA EXPRESSWAY AUTHORITY

Concept, Feasability and Mobility Study
for the
Poinciana Parkway Extension / I-4 Connector

Poinciana Parkway Expansion

SHEET NO.
PPE-3

REFERENCE COPY

REVISIONS			
DATE	DESCRIPTION	DATE	DESCRIPTION

CENTRAL FLORIDA EXPRESSWAY AUTHORITY

Concept, Feasability and Mobility Study
for the
Poinciana Parkway Extension / I-4 Connector

Poinciana Parkway Expansion

SHEET NO.

PPE-4

REFERENCE COPY

REVISIONS			
DATE	DESCRIPTION	DATE	DESCRIPTION

CENTRAL FLORIDA EXPRESSWAY AUTHORITY

Concept, Feasability and Mobility Study
for the
Poinciana Parkway Extension / I-4 Connector

Poinciana Parkway Expansion

SHEET NO.

PPE-5

REFERENCE COPY

REVISIONS			
DATE	DESCRIPTION	DATE	DESCRIPTION

CENTRAL FLORIDA EXPRESSWAY AUTHORITY

Concept, Feasability and Mobility Study
for the
Poinciana Parkway Extension / I-4 Connector

Poinciana Parkway Expansion

SHEET NO.

PPE-6

REFERENCE COPY

REVISIONS			
DATE	DESCRIPTION	DATE	DESCRIPTION

CENTRAL FLORIDA EXPRESSWAY AUTHORITY

Concept, Feasability and Mobility Study
for the
Poinciana Parkway Extension / I-4 Connector

Poinciana Parkway Expansion

SHEET NO.

PPE-7

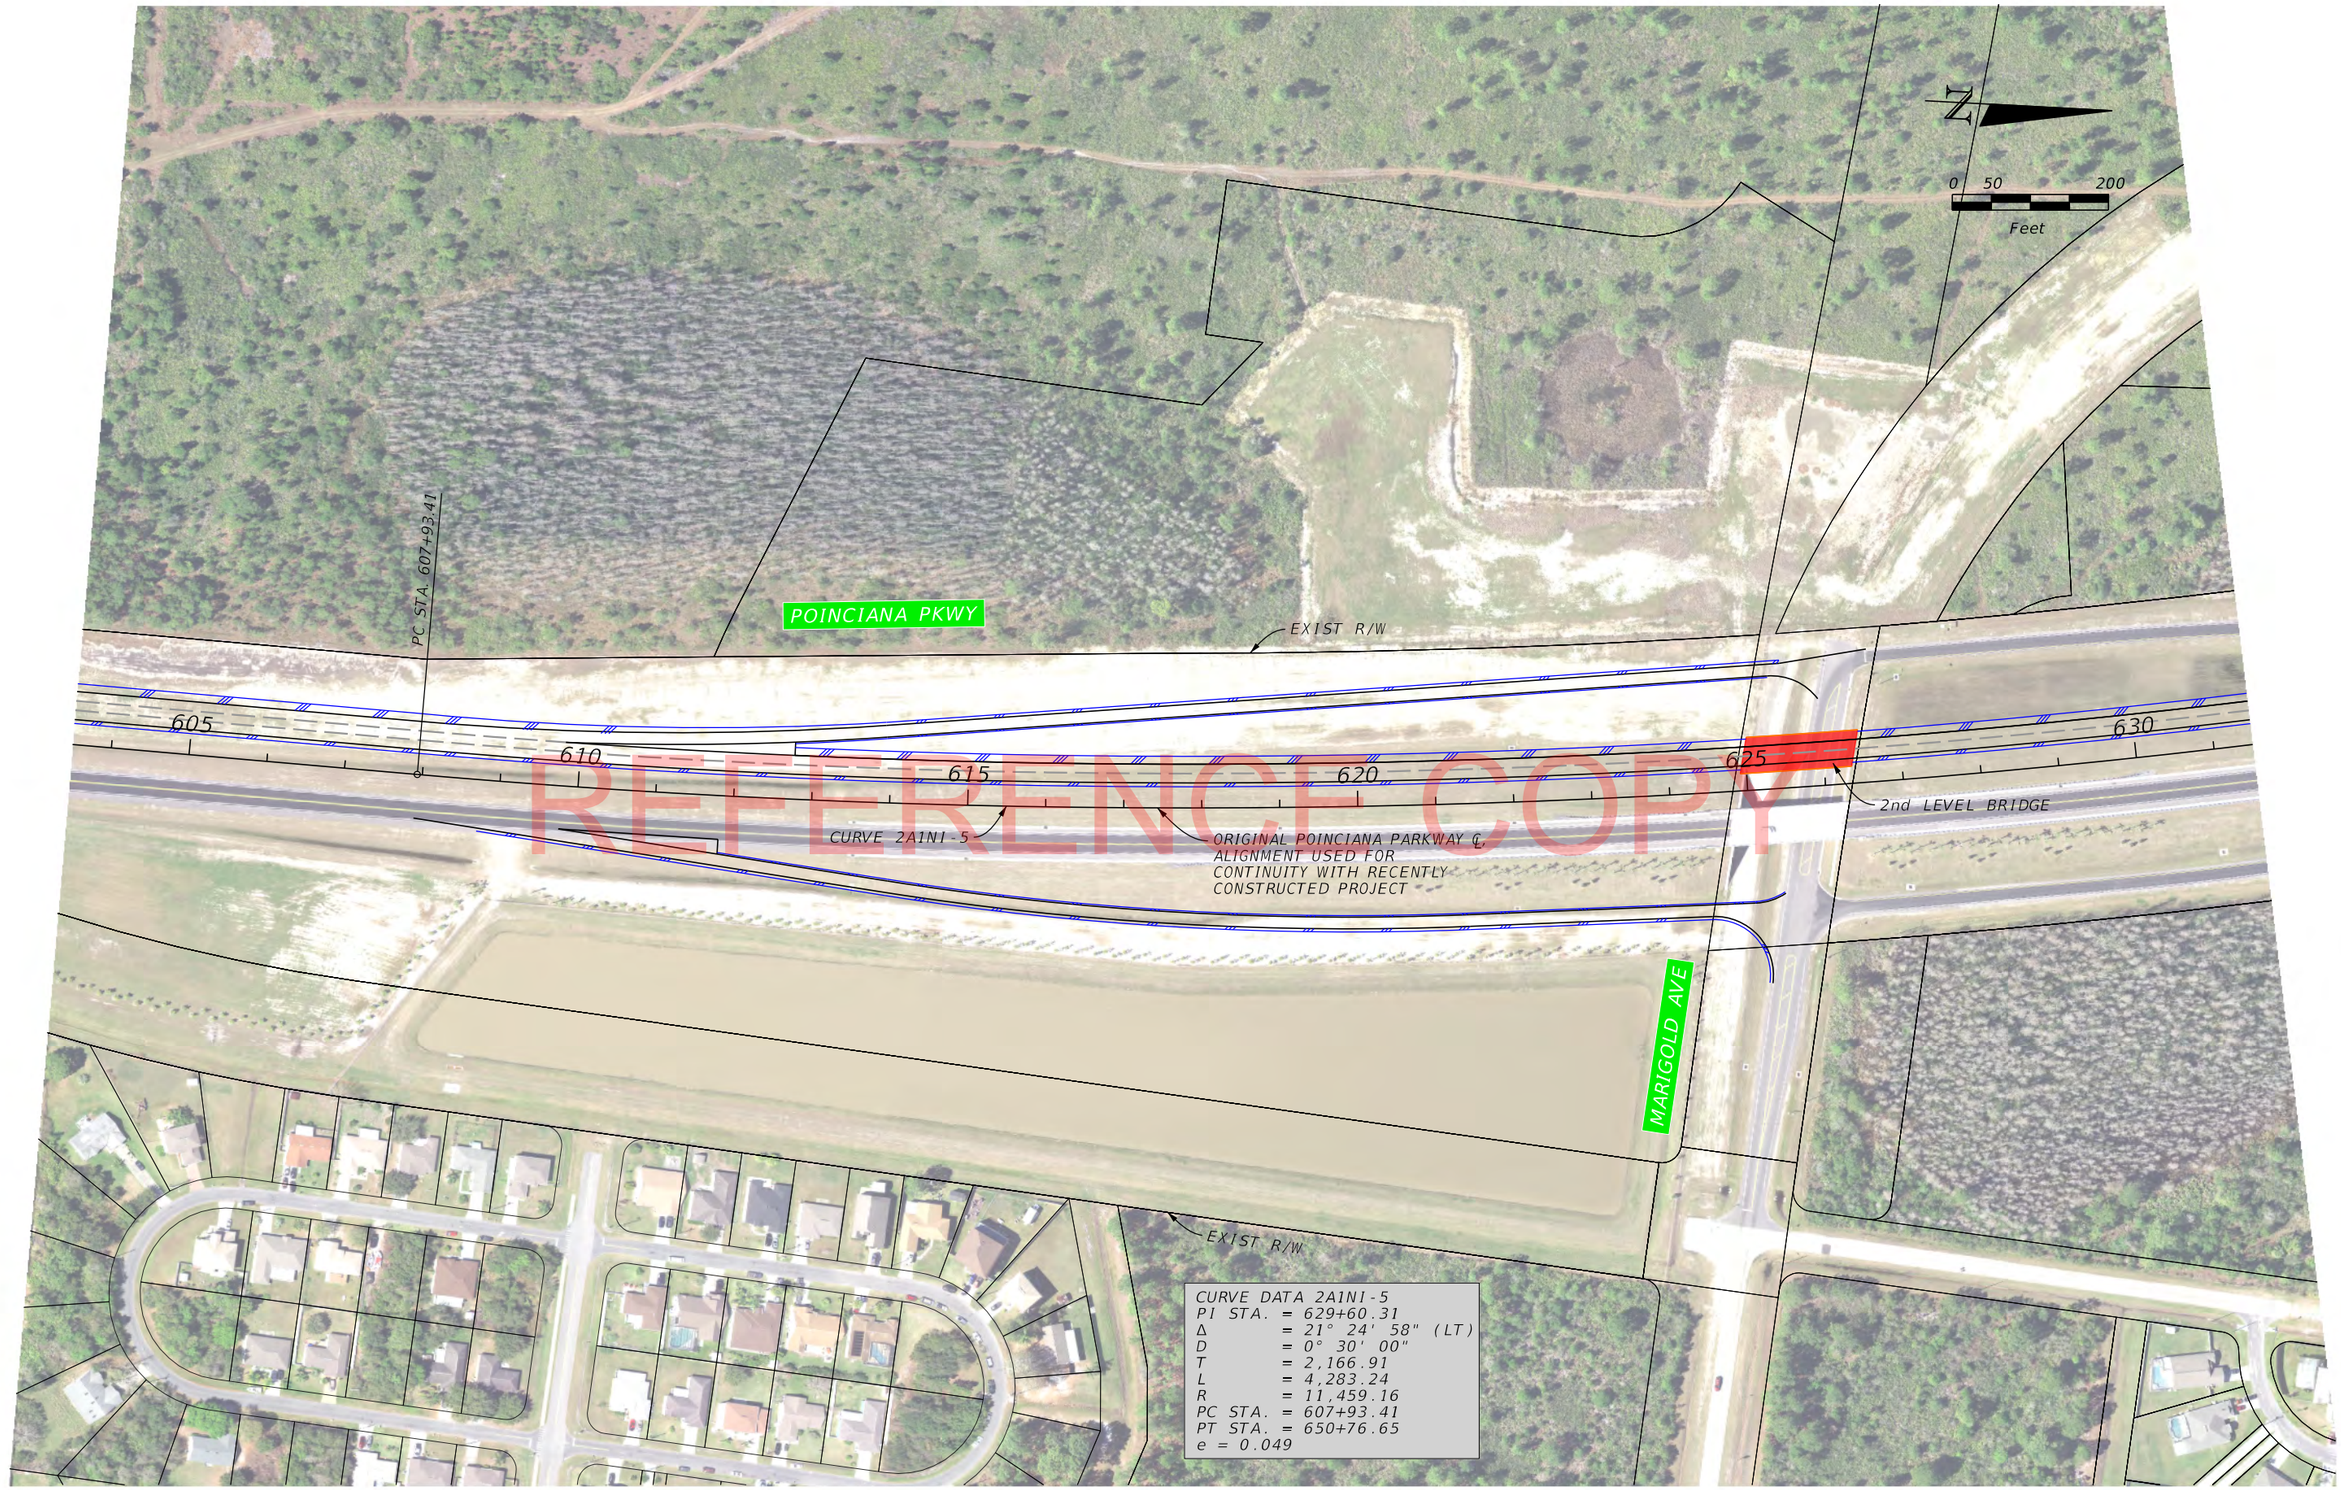

REFERENCE COPY

REVISIONS			
DATE	DESCRIPTION	DATE	DESCRIPTION

CENTRAL FLORIDA EXPRESSWAY AUTHORITY

Concept, Feasability and Mobility Study
for the
Poinciana Parkway Extension / I-4 Connector

Poinciana Parkway Expansion

SHEET NO.

PPE-8

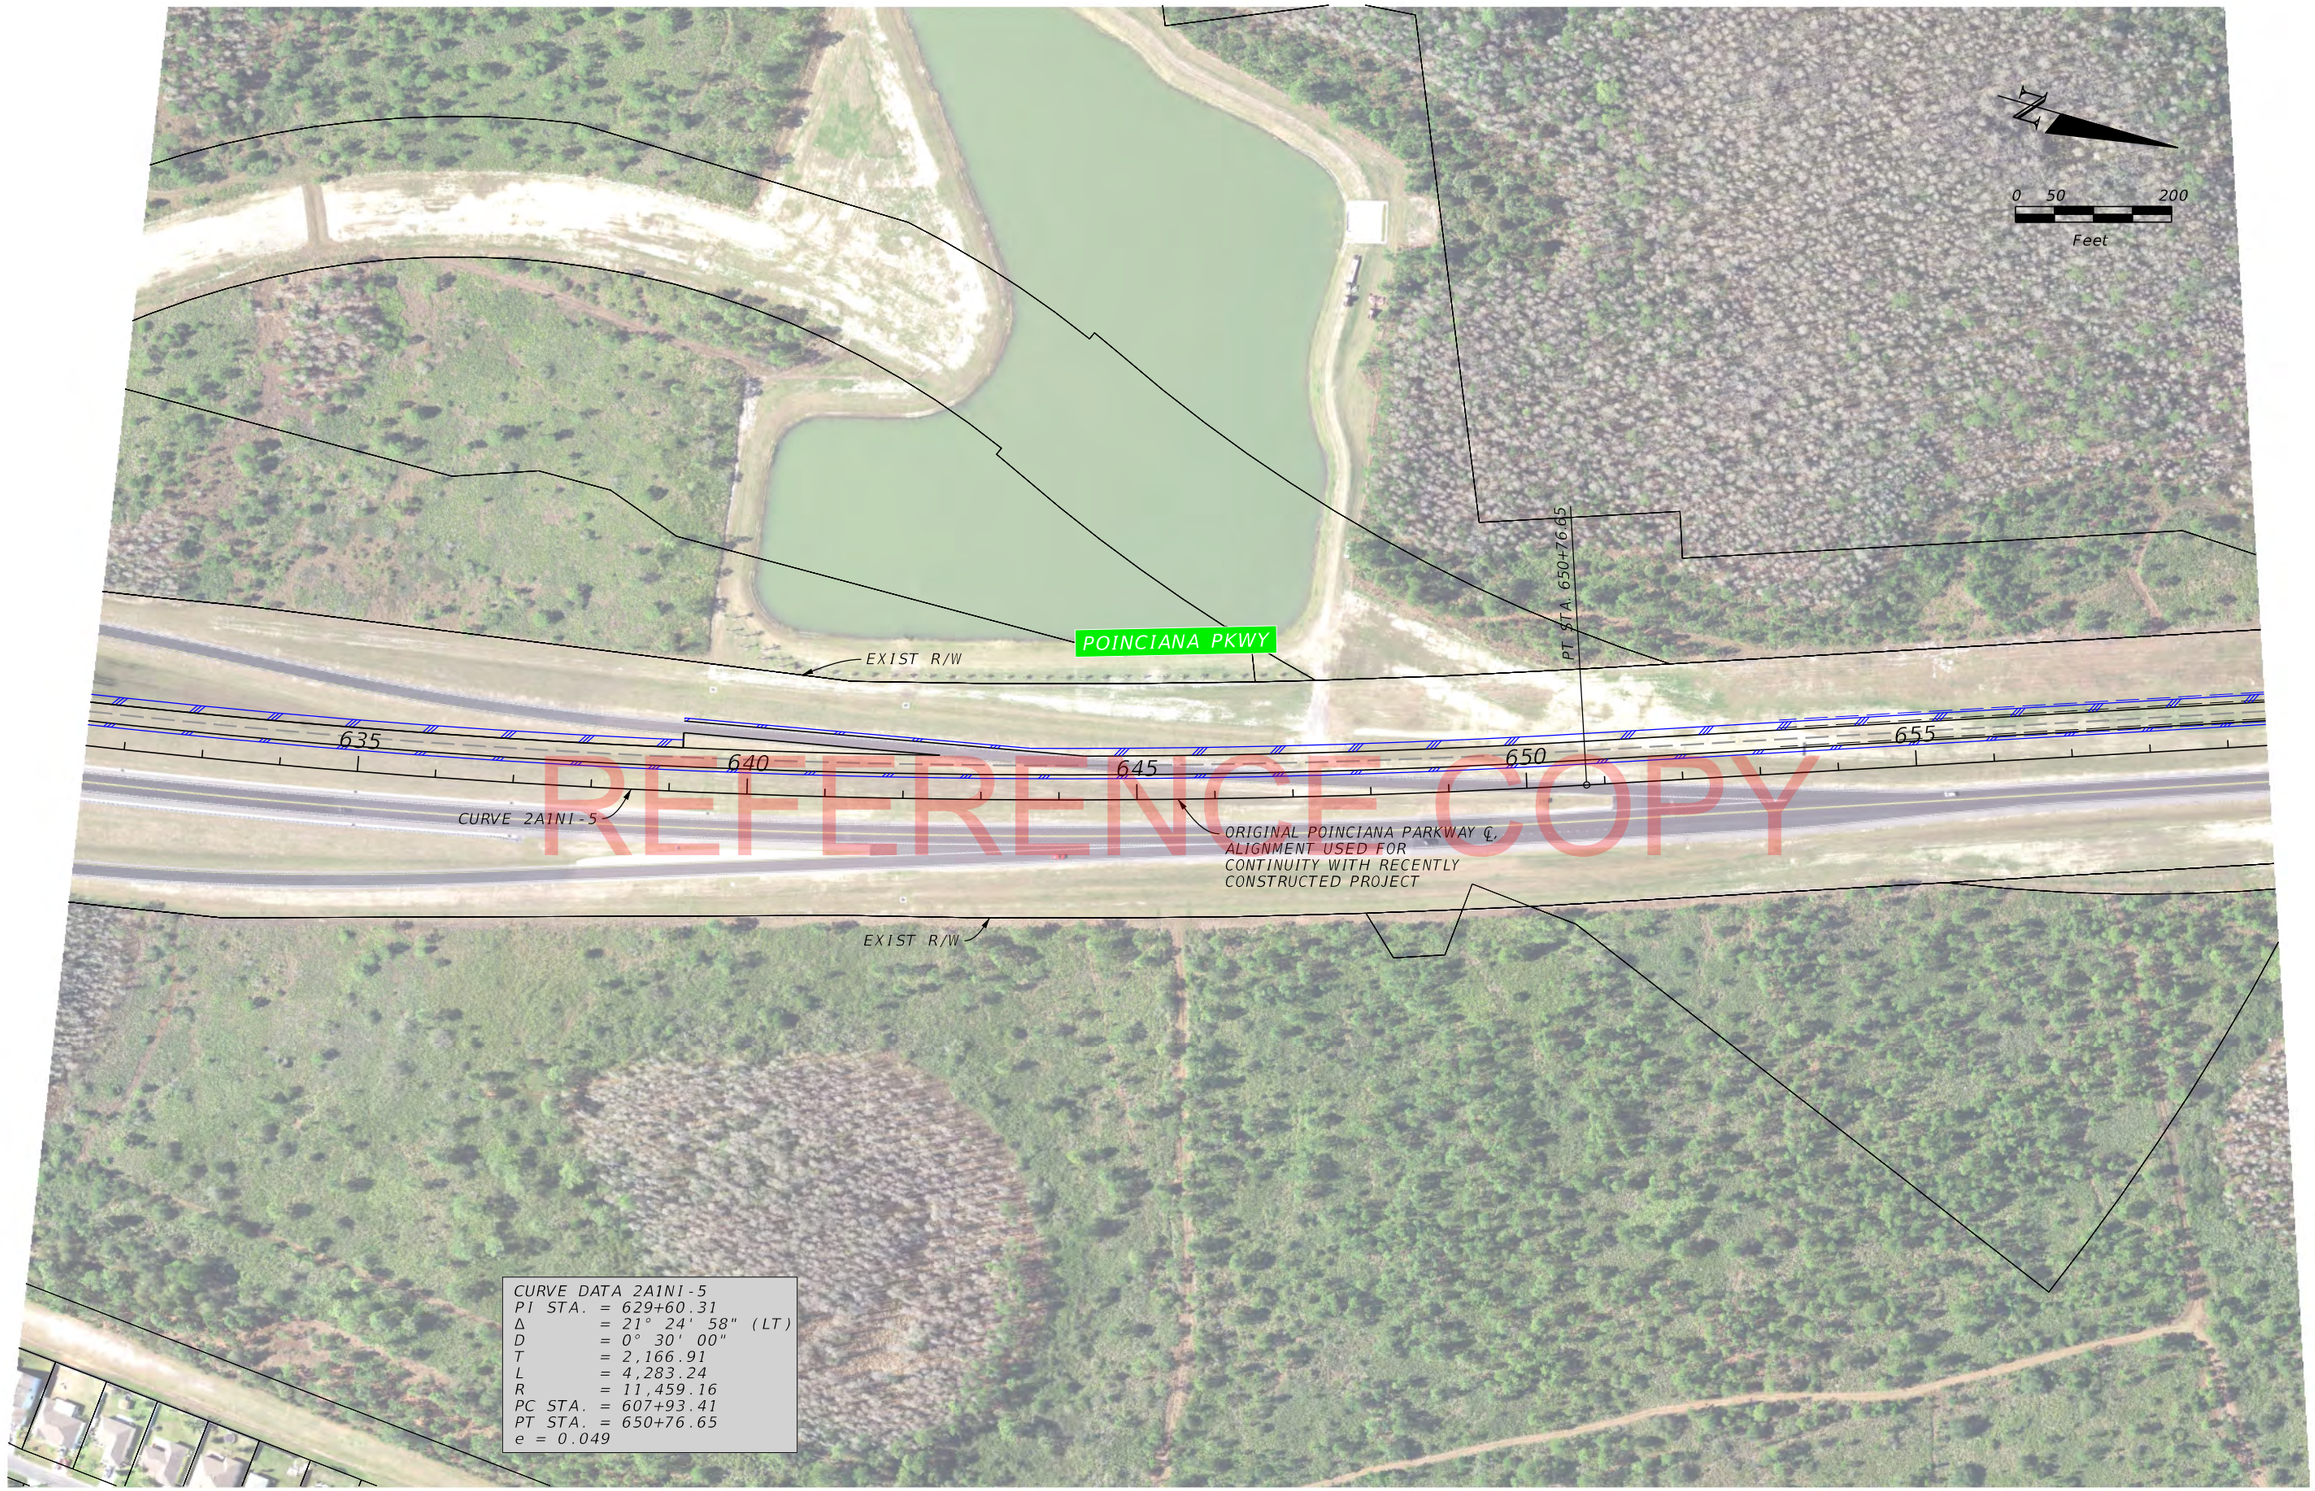

REFERENCE COPY

REVISIONS			
DATE	DESCRIPTION	DATE	DESCRIPTION

CENTRAL FLORIDA EXPRESSWAY AUTHORITY

Concept, Feasability and Mobility Study
for the
Poinciana Parkway Extension / I-4 Connector

Poinciana Parkway Expansion

SHEET NO.
PPE-9

REFERENCE COPY

REVISIONS			
DATE	DESCRIPTION	DATE	DESCRIPTION

CENTRAL FLORIDA EXPRESSWAY AUTHORITY

Concept, Feasability and Mobility Study
for the
Poinciana Parkway Extension / I-4 Connector

Poinciana Parkway Expansion

SHEET NO.
PPE-10

REFERENCE COPY

REVISIONS			
DATE	DESCRIPTION	DATE	DESCRIPTION

CENTRAL FLORIDA EXPRESSWAY AUTHORITY

Concept, Feasability and Mobility Study
for the
Poinciana Parkway Extension / I-4 Connector

Poinciana Parkway Expansion

SHEET NO.

PPE-11

REFERENCE COPY

REVISIONS			
DATE	DESCRIPTION	DATE	DESCRIPTION

CENTRAL FLORIDA EXPRESSWAY AUTHORITY

Concept, Feasability and Mobility Study
for the
Poinciana Parkway Extension / I-4 Connector

Poinciana Parkway Expansion

SHEET NO.

PPE-12

REFERENCE COPY

REVISIONS			
DATE	DESCRIPTION	DATE	DESCRIPTION

CENTRAL FLORIDA EXPRESSWAY AUTHORITY

Concept, Feasability and Mobility Study
for the
Poinciana Parkway Extension / I-4 Connector

Poinciana Parkway Expansion

SHEET NO.
PPE-13

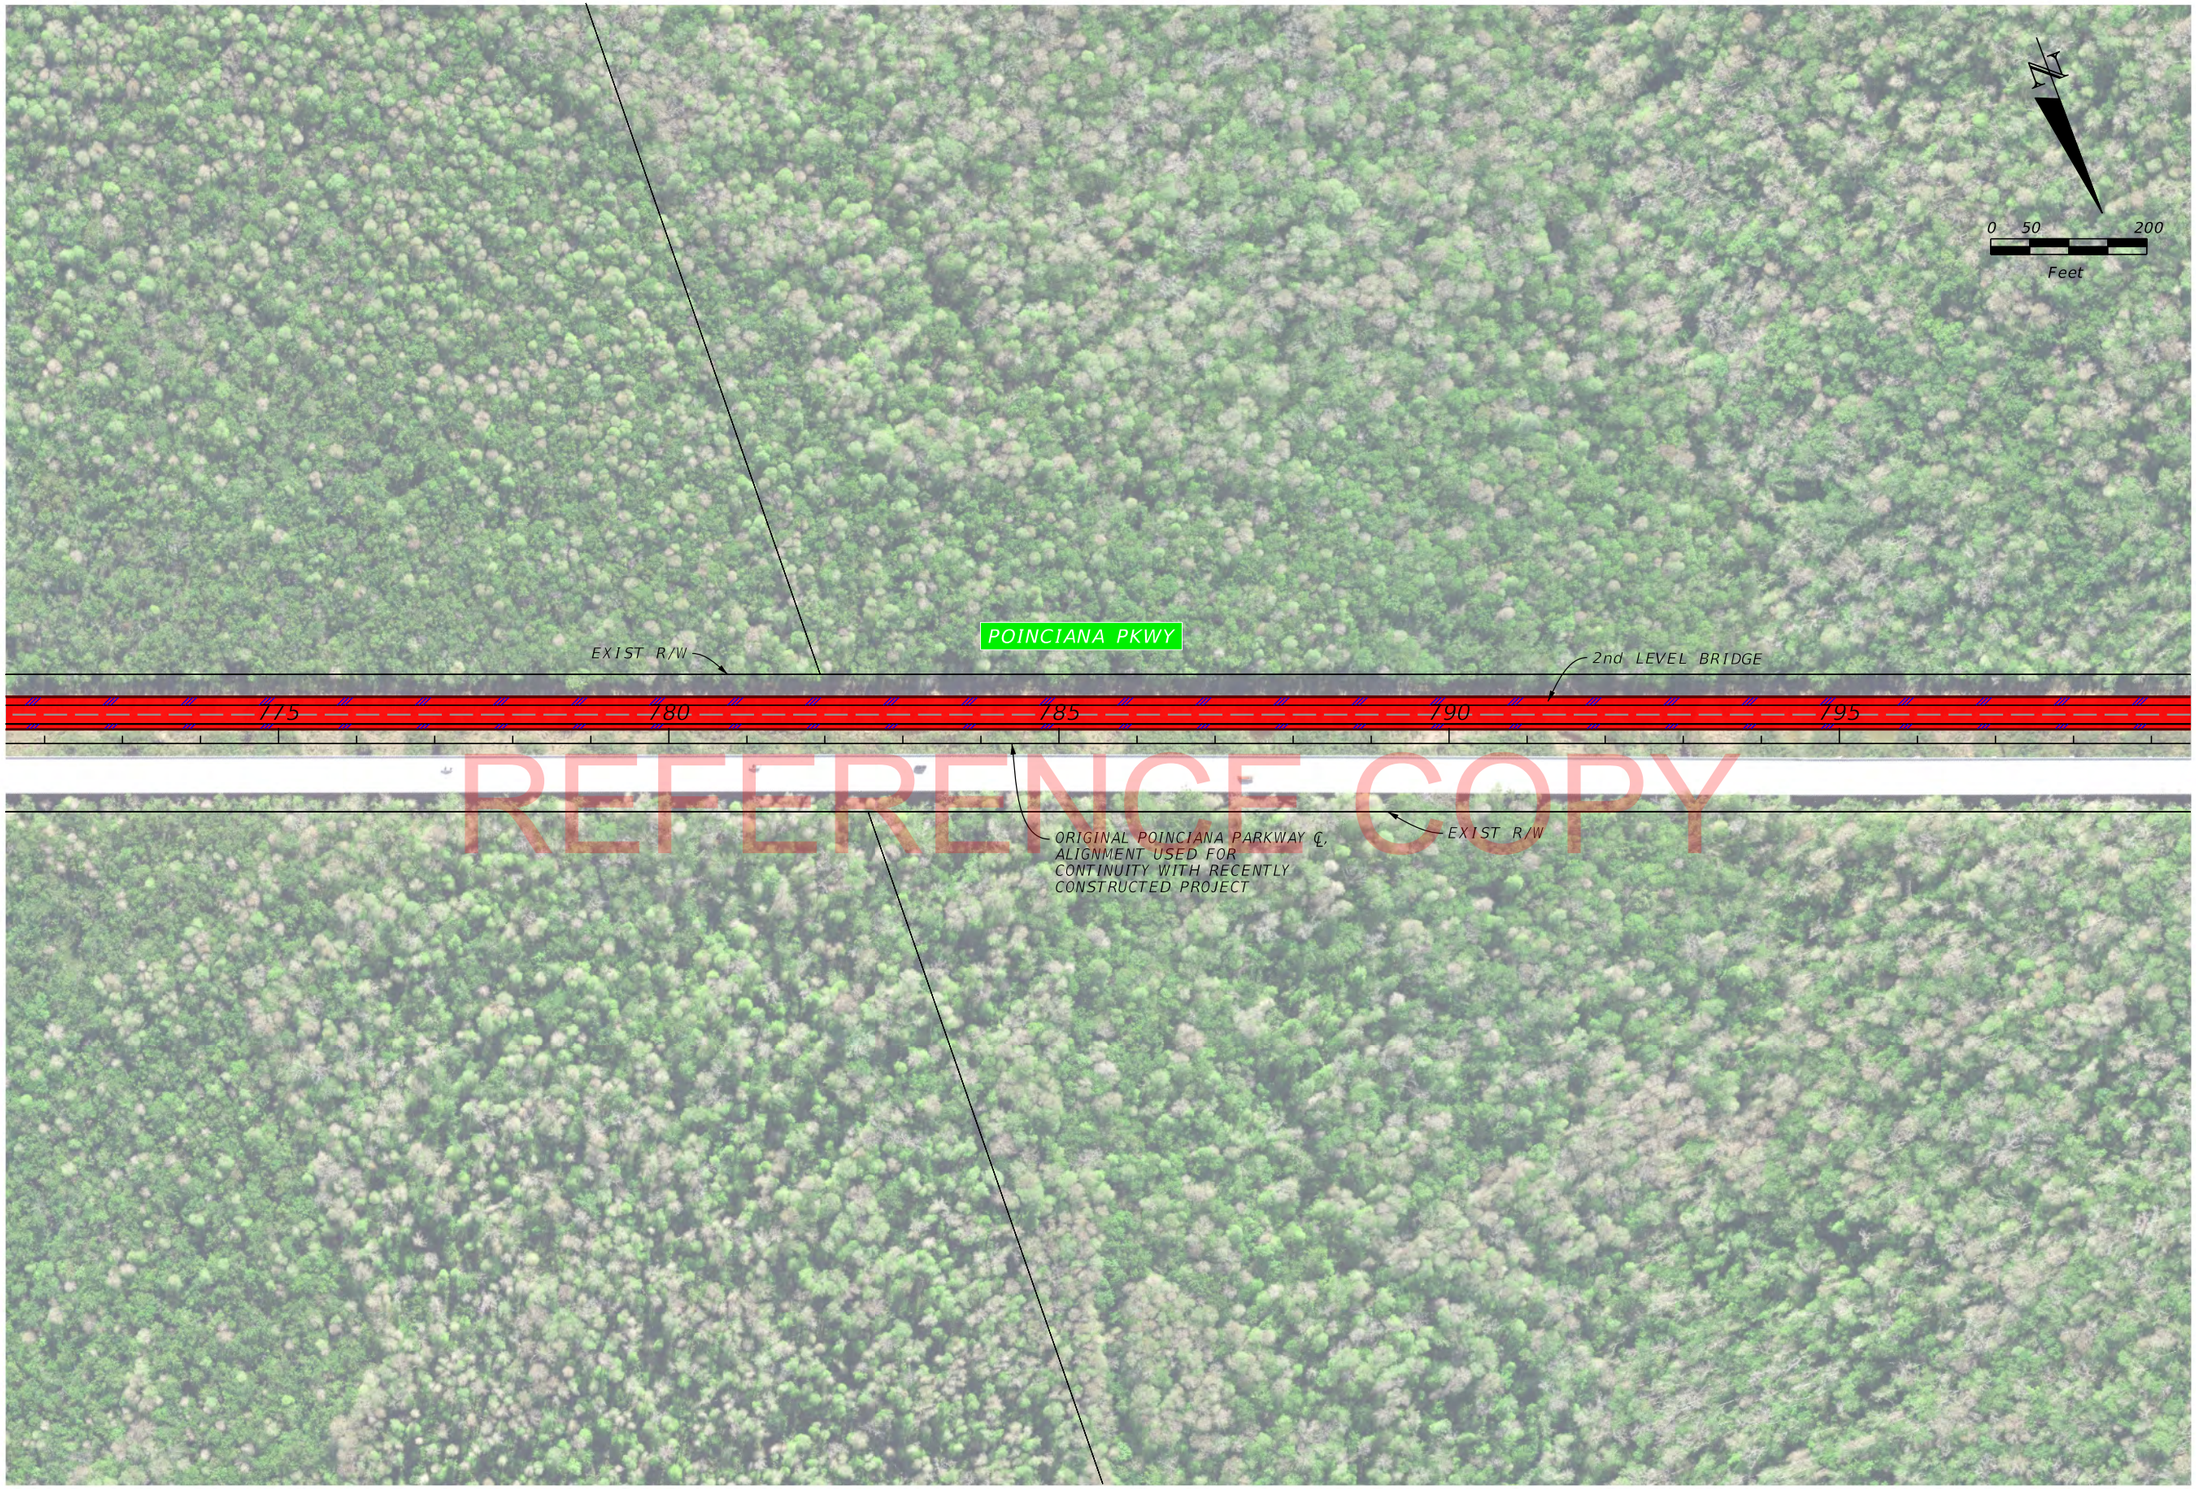

REFERENCE COPY

REVISIONS			
DATE	DESCRIPTION	DATE	DESCRIPTION

CENTRAL FLORIDA EXPRESSWAY AUTHORITY

Concept, Feasability and Mobility Study
for the
Poinciana Parkway Extension / I-4 Connector

Poinciana Parkway Expansion

SHEET NO.

PPE-14

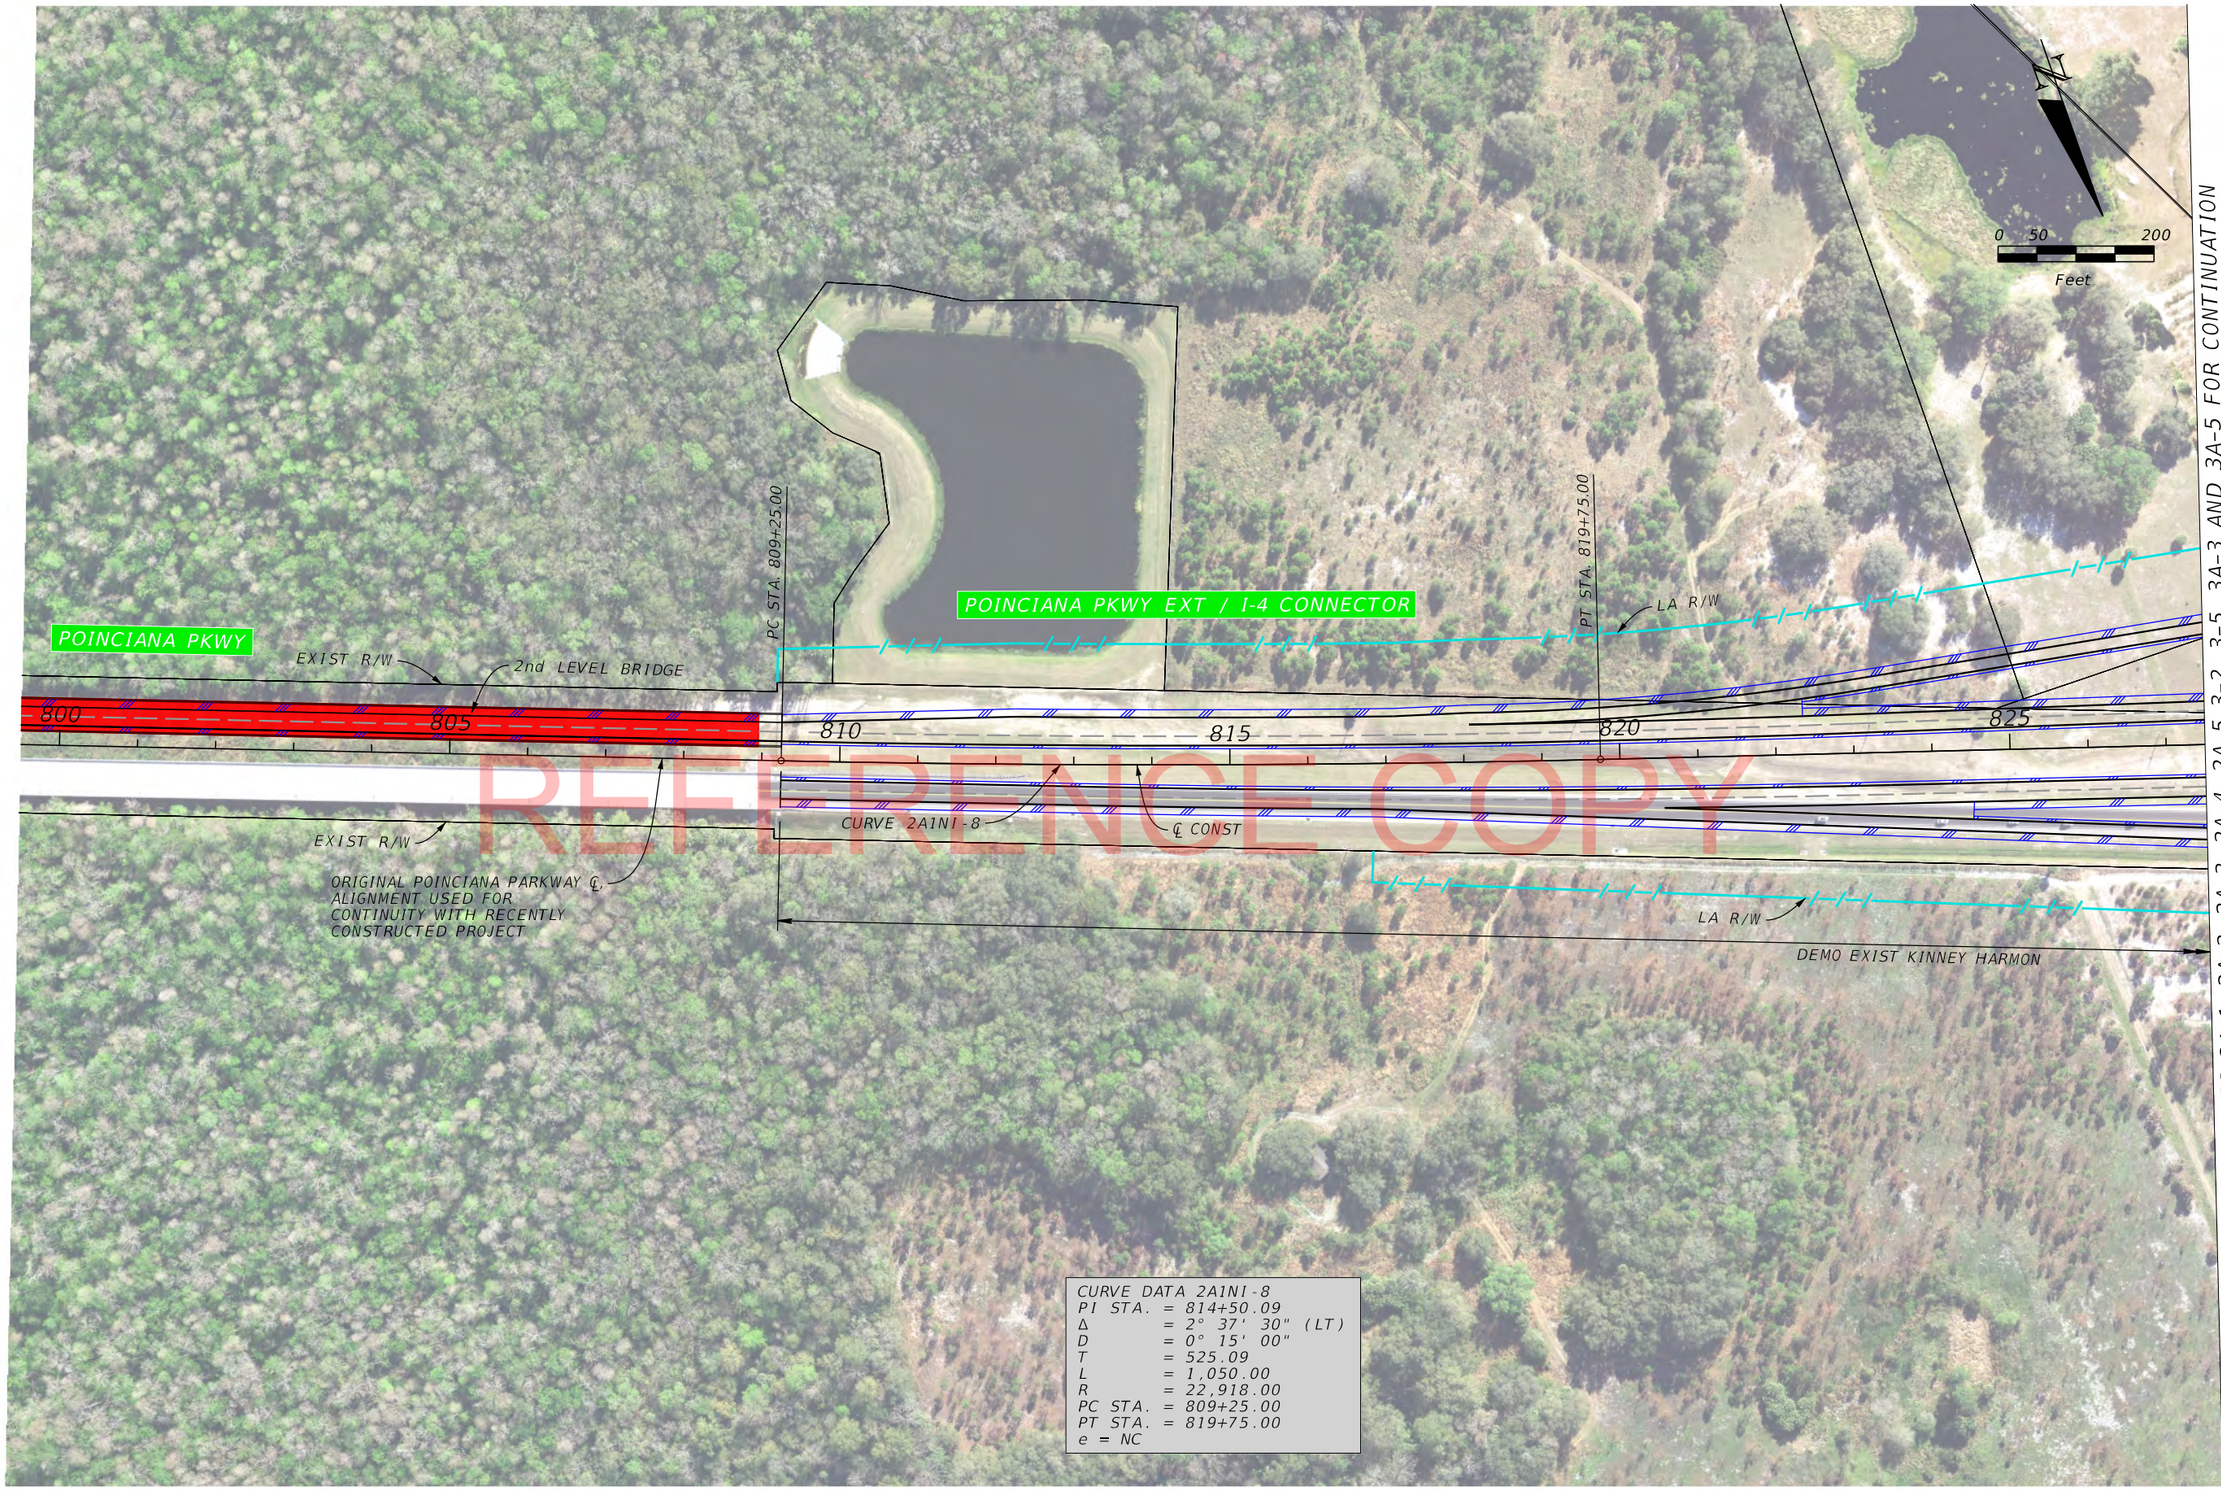

REFERENCE COPY

CURVE DATA 2A1NI-8
PI STA. = 814+50.09
Δ = 2° 37' 30" (LT)
D = 0° 15' 00"
T = 525.09
L = 1,050.00
R = 22,918.00
PC STA. = 809+25.00
PT STA. = 819+75.00
e = NC

REVISIONS			
DATE	DESCRIPTION	DATE	DESCRIPTION

CENTRAL FLORIDA EXPRESSWAY AUTHORITY

Concept, Feasability and Mobility Study
for the
Poinciana Parkway Extension / I-4 Connector

Poinciana Parkway Expansion

SHEET NO.
PPE-15

APPENDIX G


REFERENCE COPY

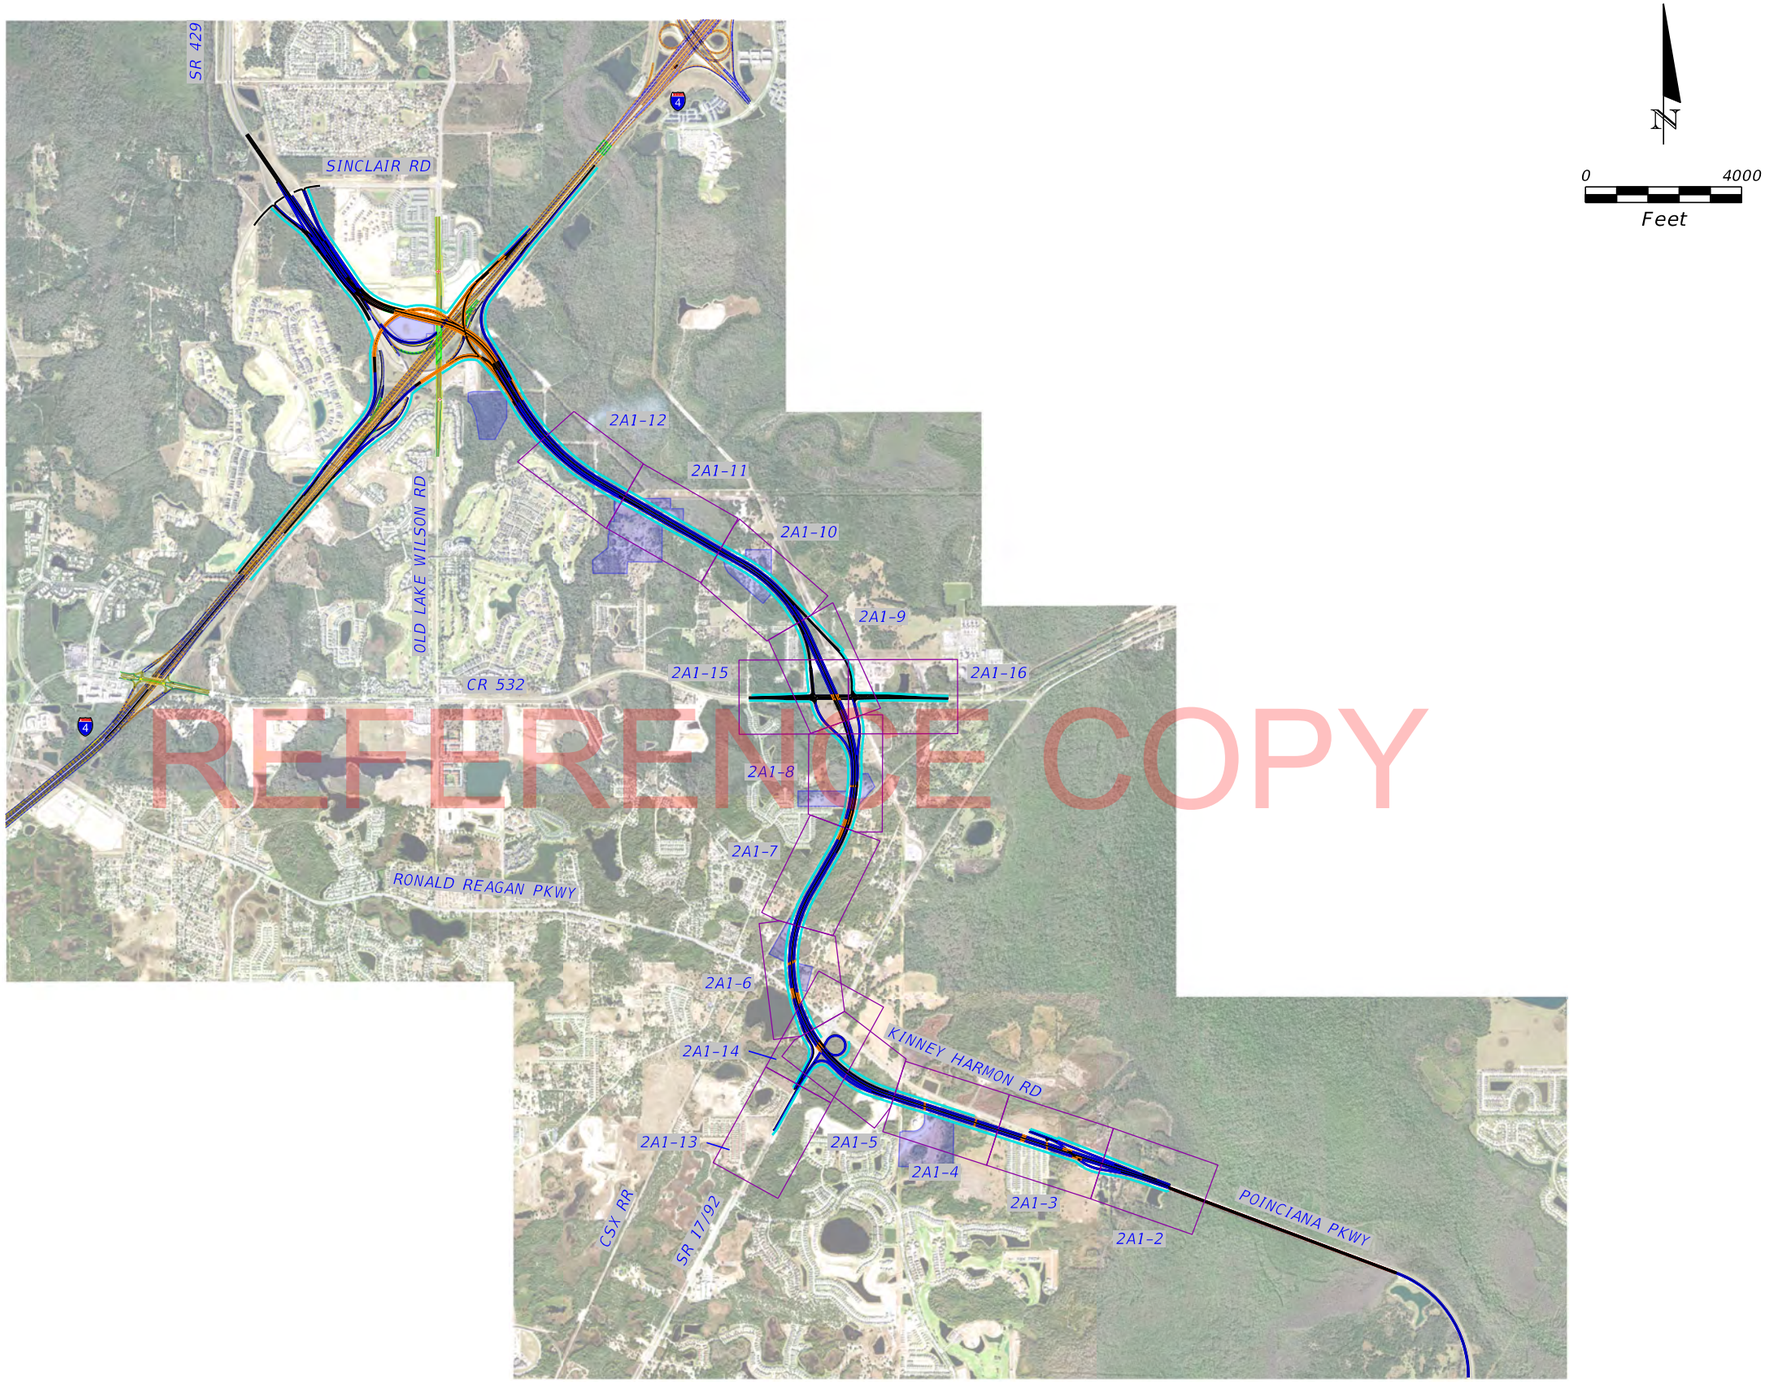

REFERENCE COPY

REVISIONS			
DATE	DESCRIPTION	DATE	DESCRIPTION

CENTRAL FLORIDA EXPRESSWAY AUTHORITY

Concept, Feasability and Mobility Study
for the
Poinciana Parkway Extension / I-4 Connector

Alternative 2A-1

SHEET NO.
2A1-1

Bill.Lemos 3/21/2018 7:08:06 AM K:\ORL_TPTO\149800000___I-4 Connector\200_Engineering\CADD\roadway\Roadway Alignments\plans\play2A_1.dgn

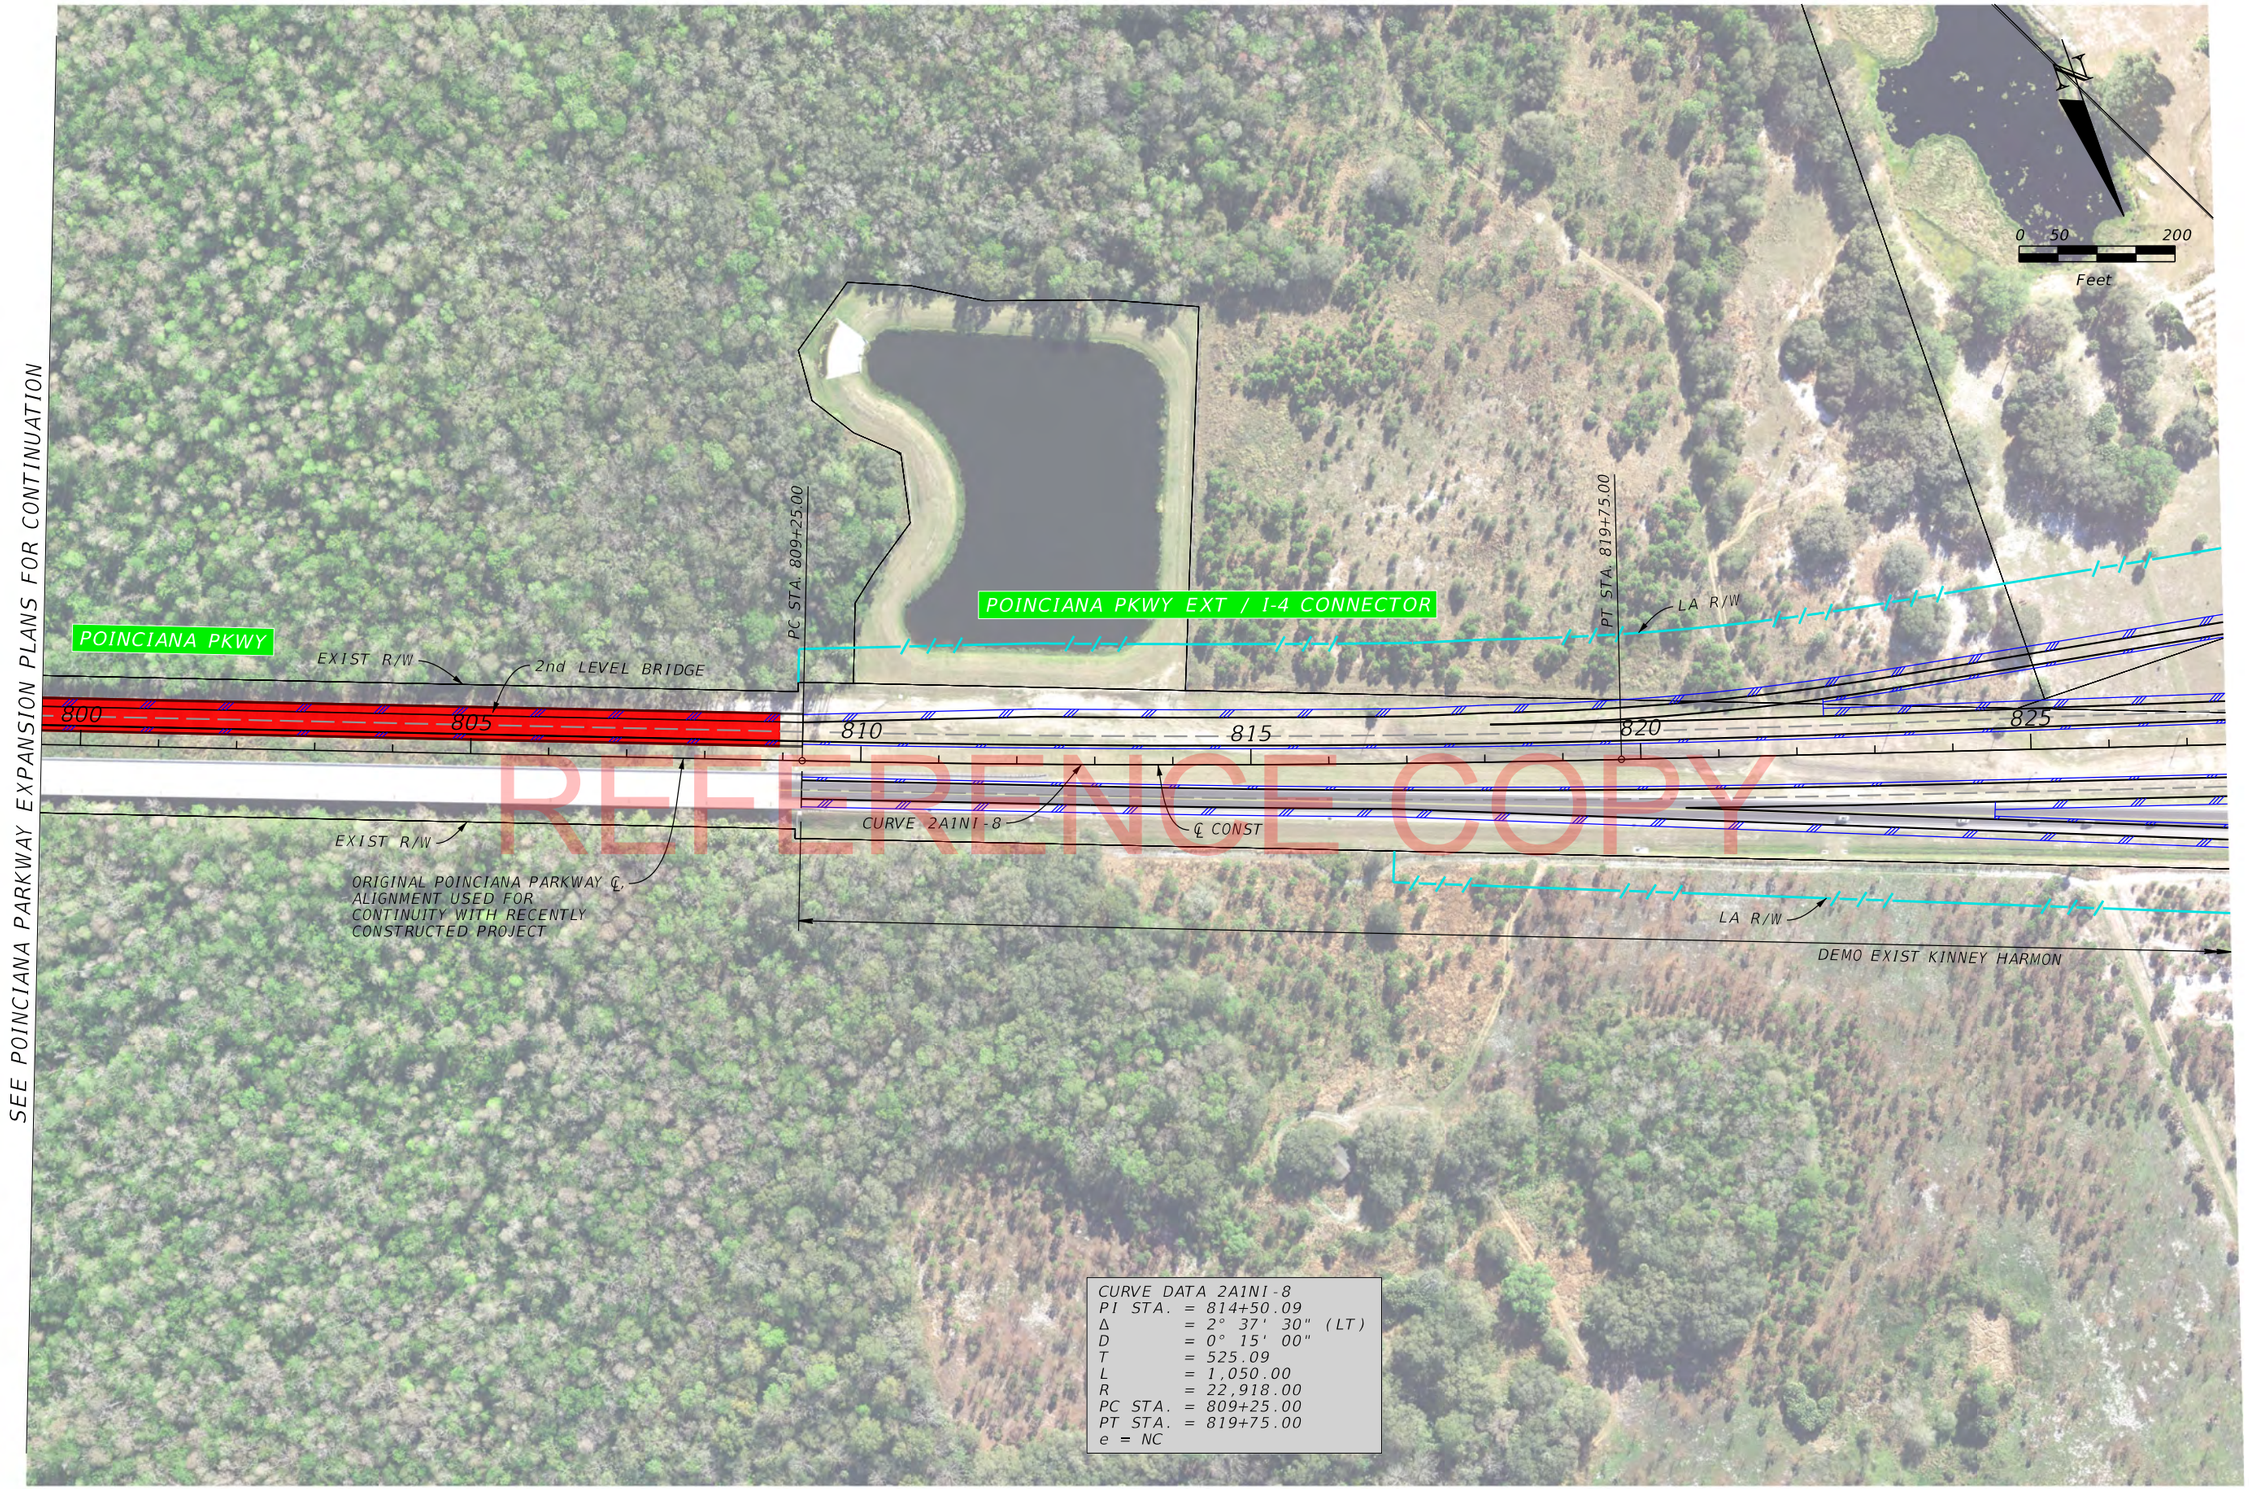

REFERENCE COPY

REVISIONS			
DATE	DESCRIPTION	DATE	DESCRIPTION

CENTRAL FLORIDA EXPRESSWAY AUTHORITY

Concept, Feasability and Mobility Study
for the
Poinciana Parkway Extension / I-4 Connector

Alternative 2A-1

SHEET NO.
2A1-2

Bill.Lemos 3/21/2018 7:08:53 AM K:\ORL_TPTO\149800000___I-4 Connector\200_Engineering\CADD\roadway\Roadway Alignments\plans\plan2A_1-14.dgn

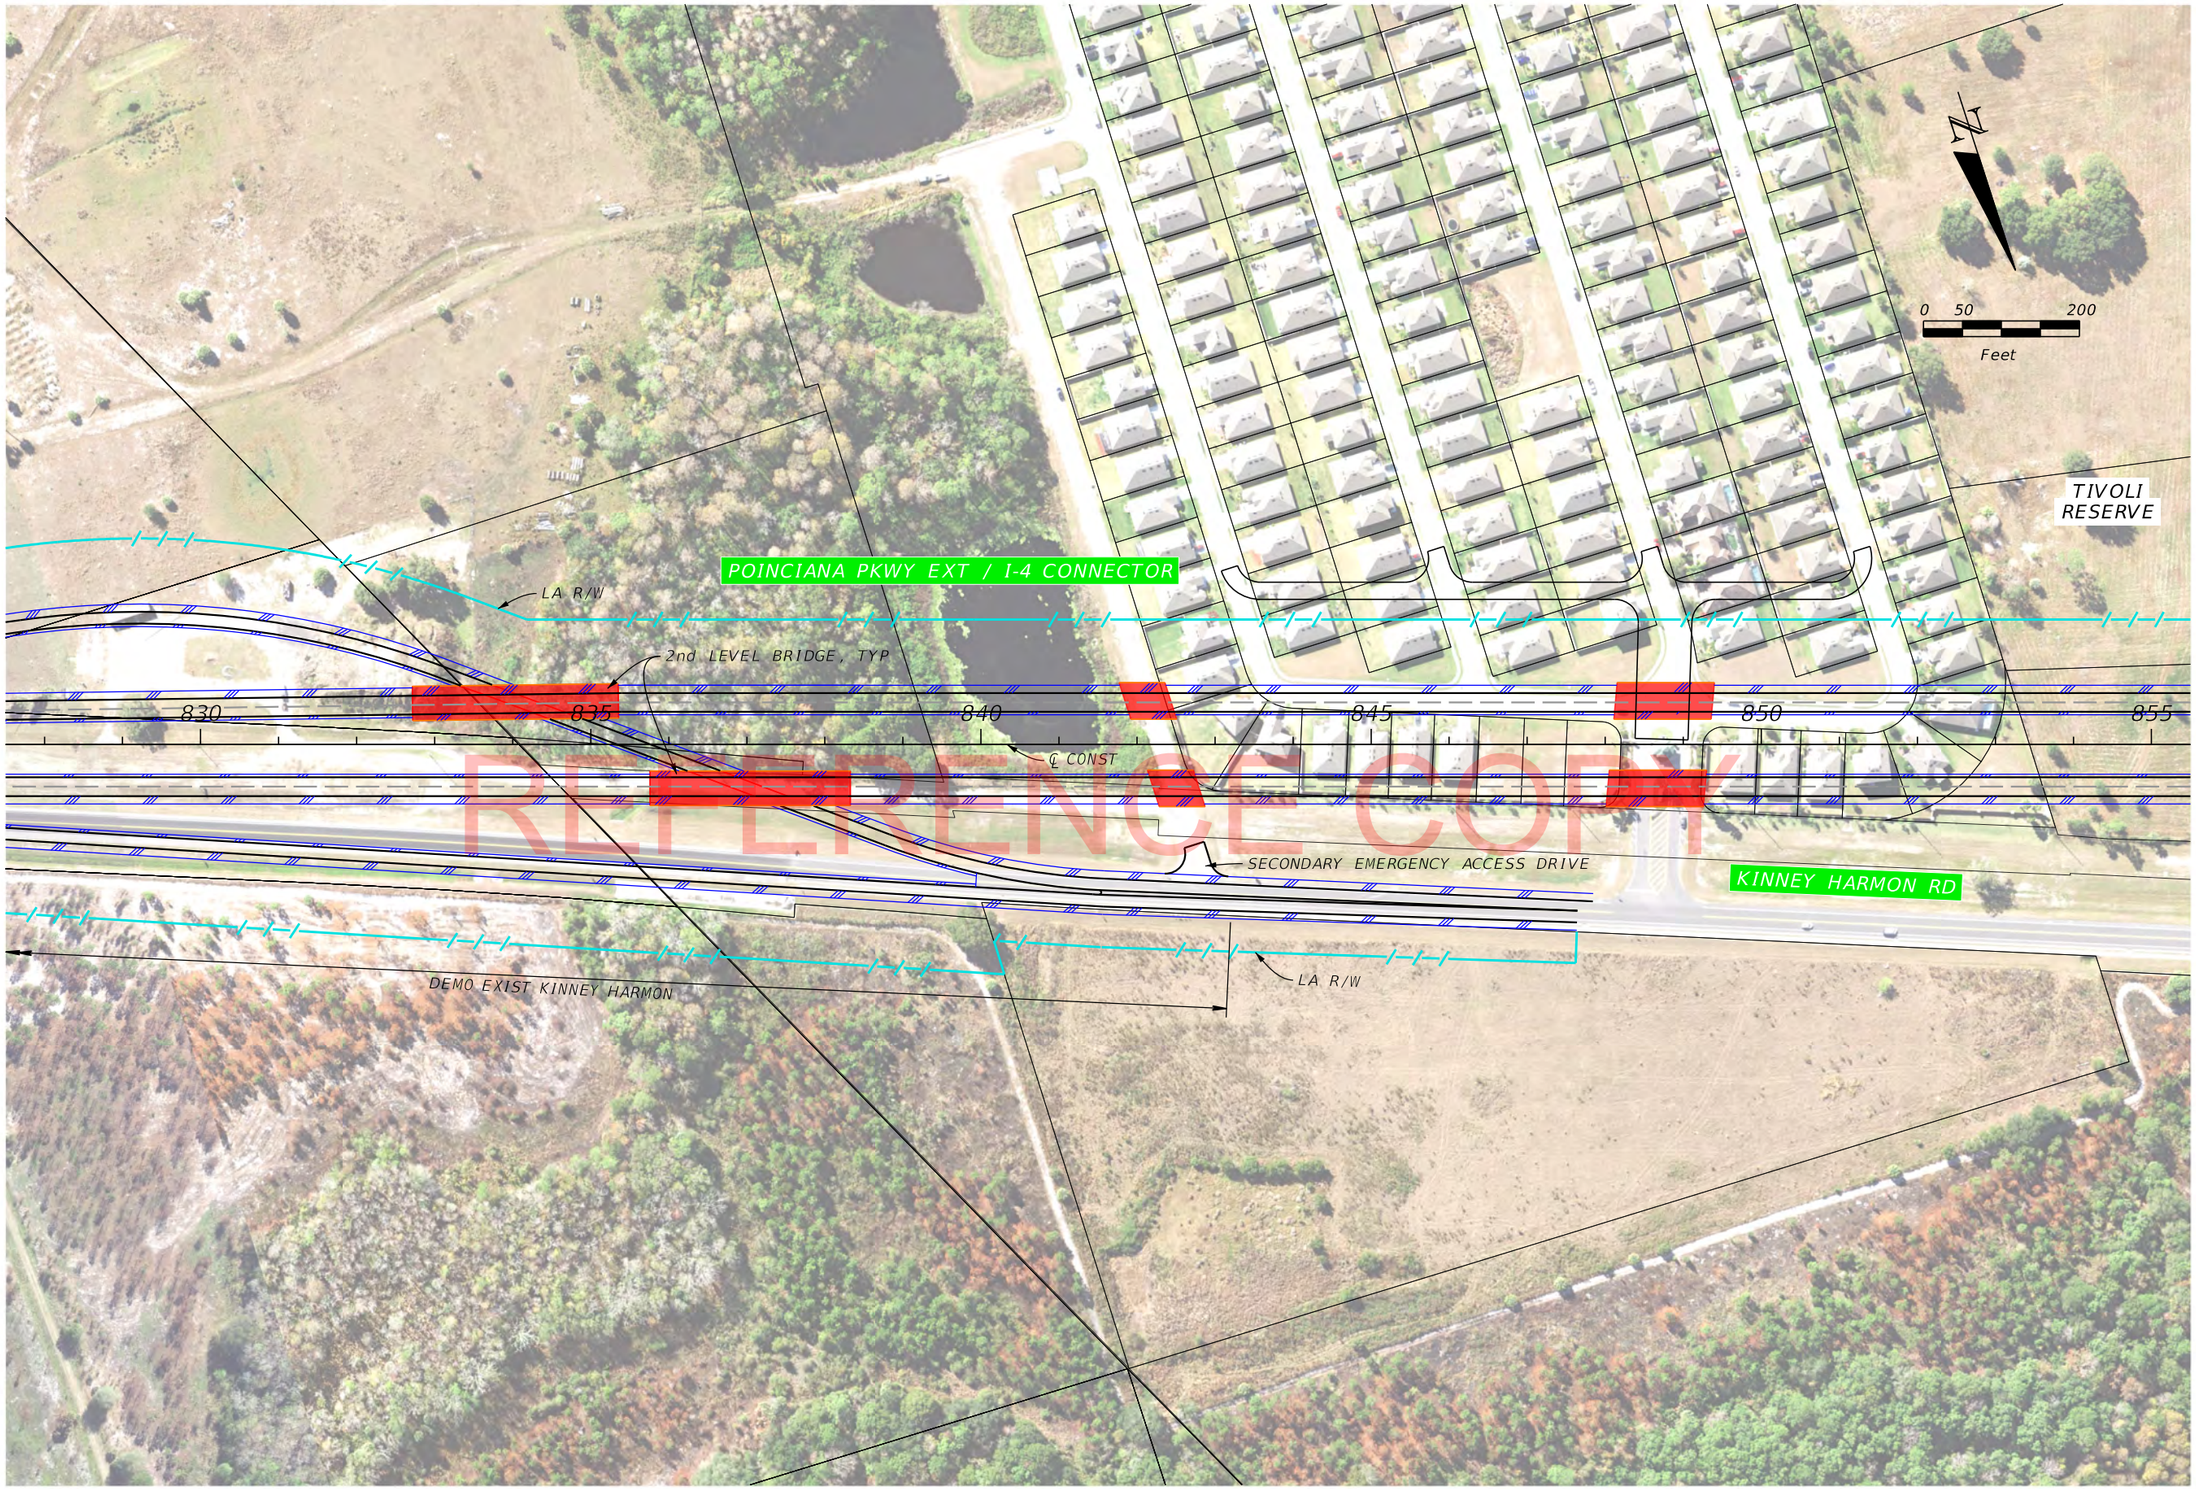

REFERENCE COPY

REVISIONS			
DATE	DESCRIPTION	DATE	DESCRIPTION

CENTRAL FLORIDA EXPRESSWAY AUTHORITY

Concept, Feasability and Mobility Study
for the
Poinciana Parkway Extension / I-4 Connector

Alternative 2A-1

SHEET NO.
2A1-3

Bill.Lemos 3/21/2018 7:10:12 AM K:\ORL_TPTO\149800000___I-4 Connector\200_Engineering\CADD\roadway\Roadway Alignments\plans\plan2A_1-15.dgn

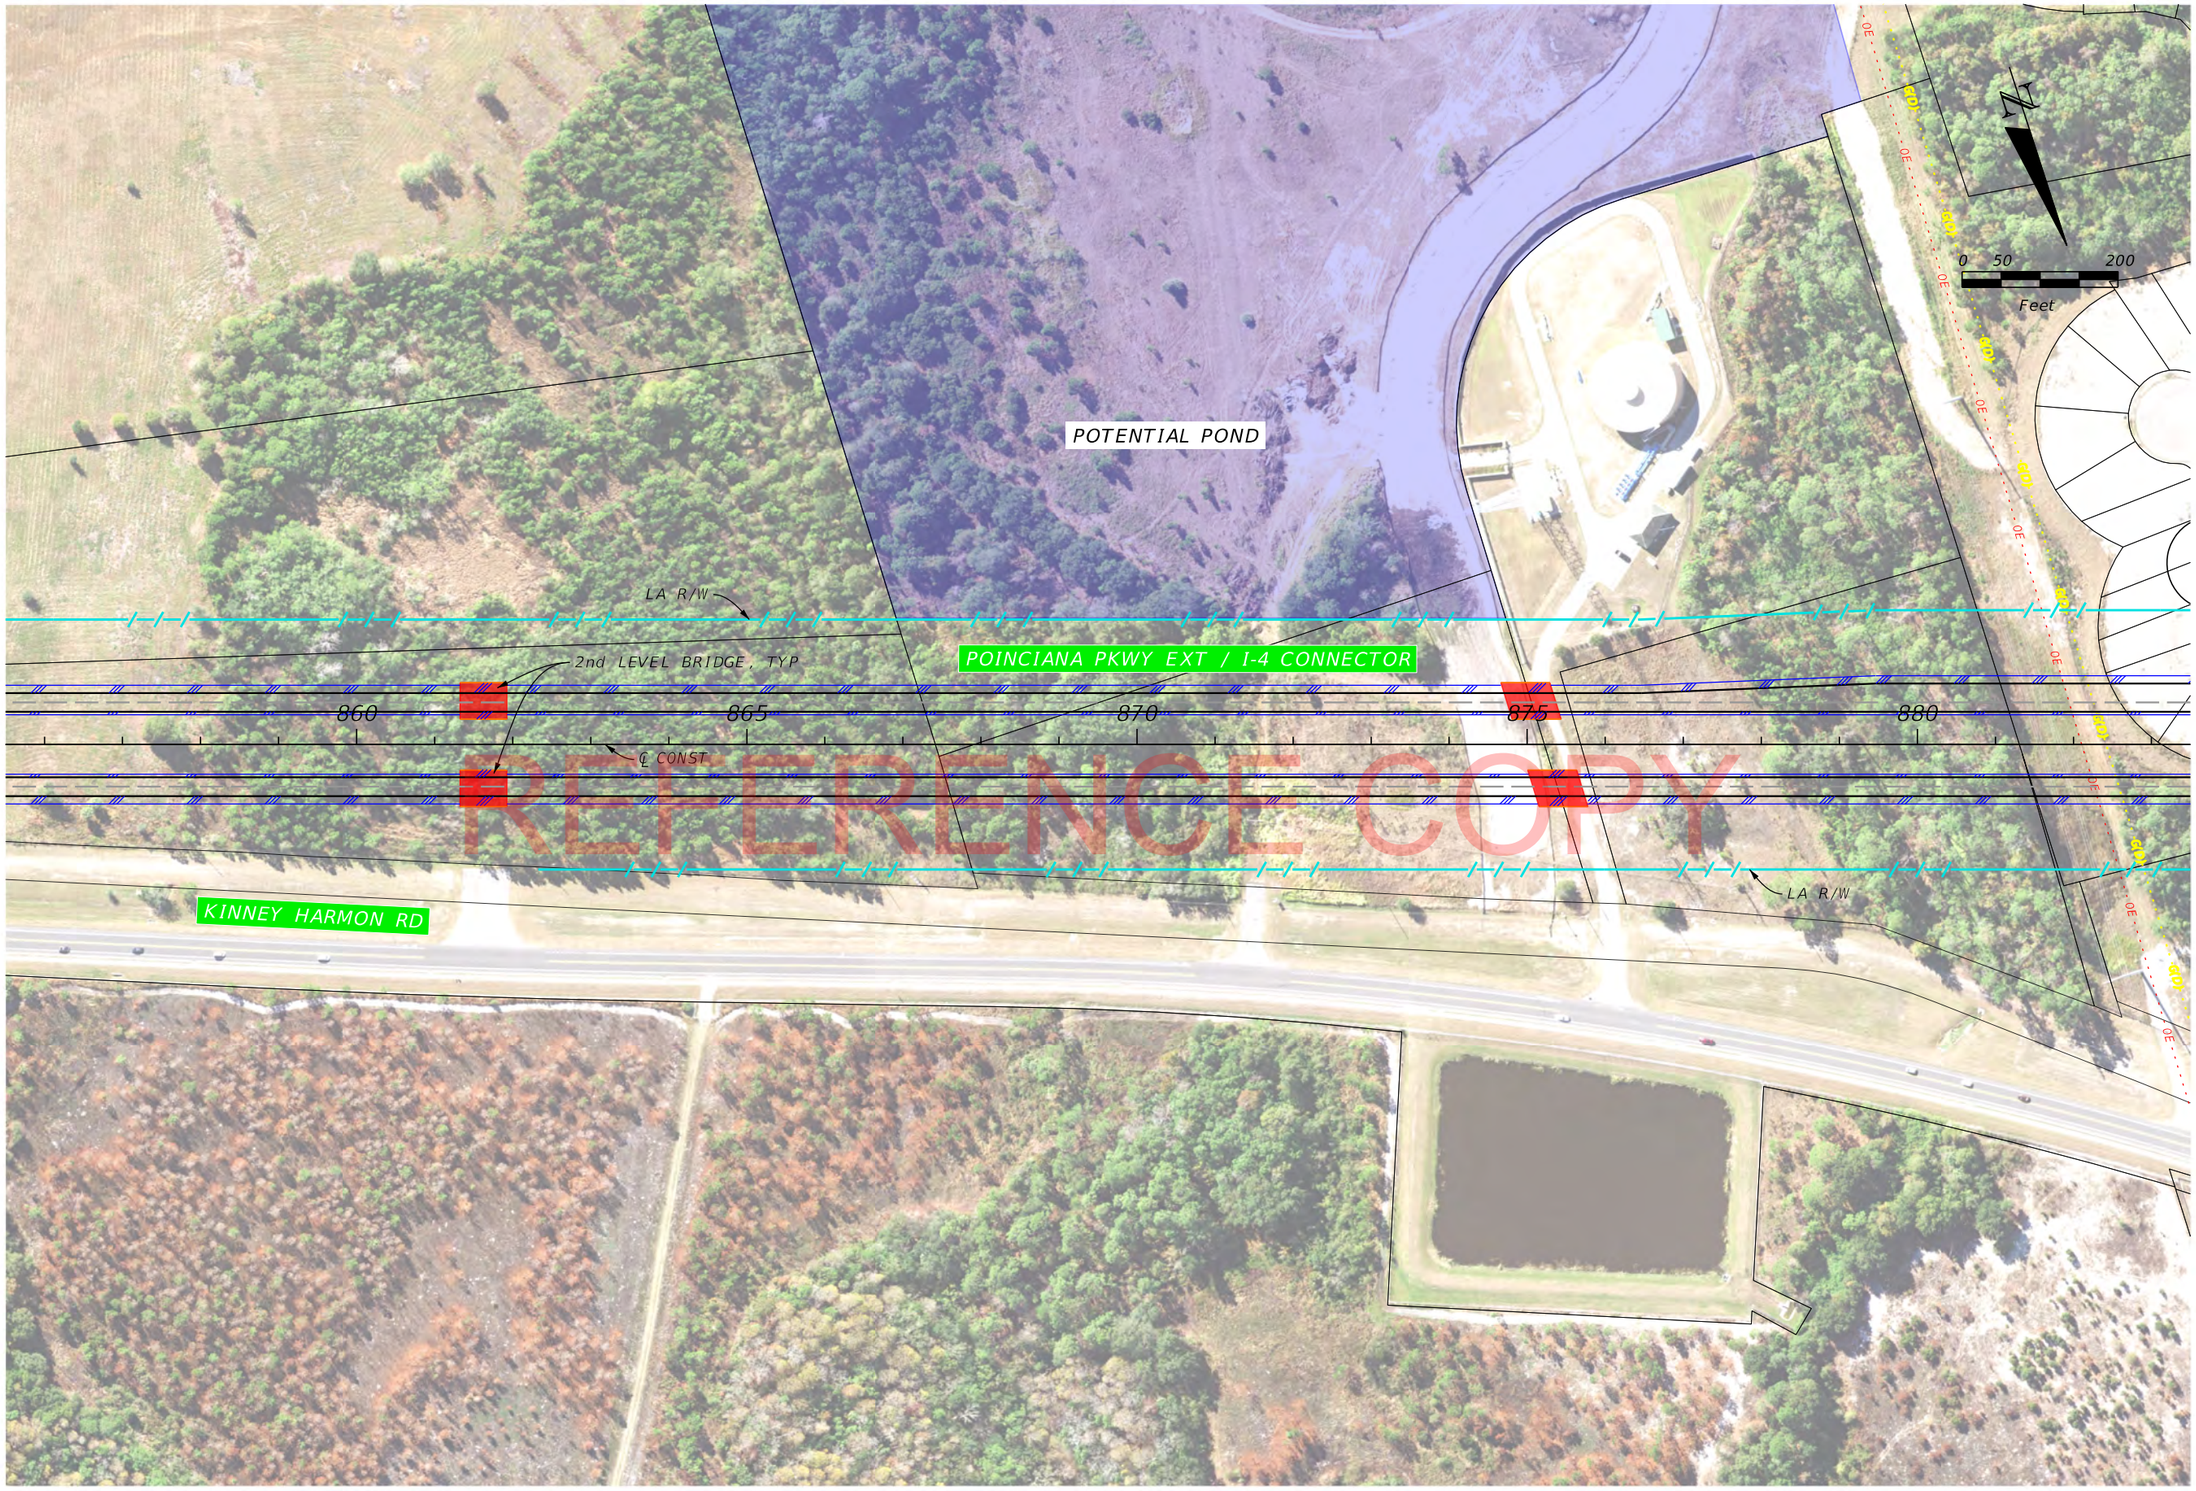

REFERENCE COPY

REVISIONS			
DATE	DESCRIPTION	DATE	DESCRIPTION

CENTRAL FLORIDA EXPRESSWAY AUTHORITY

Concept, Feasability and Mobility Study
for the
Poinciana Parkway Extension / I-4 Connector

Alternative 2A-1

SHEET NO.
2A1-4

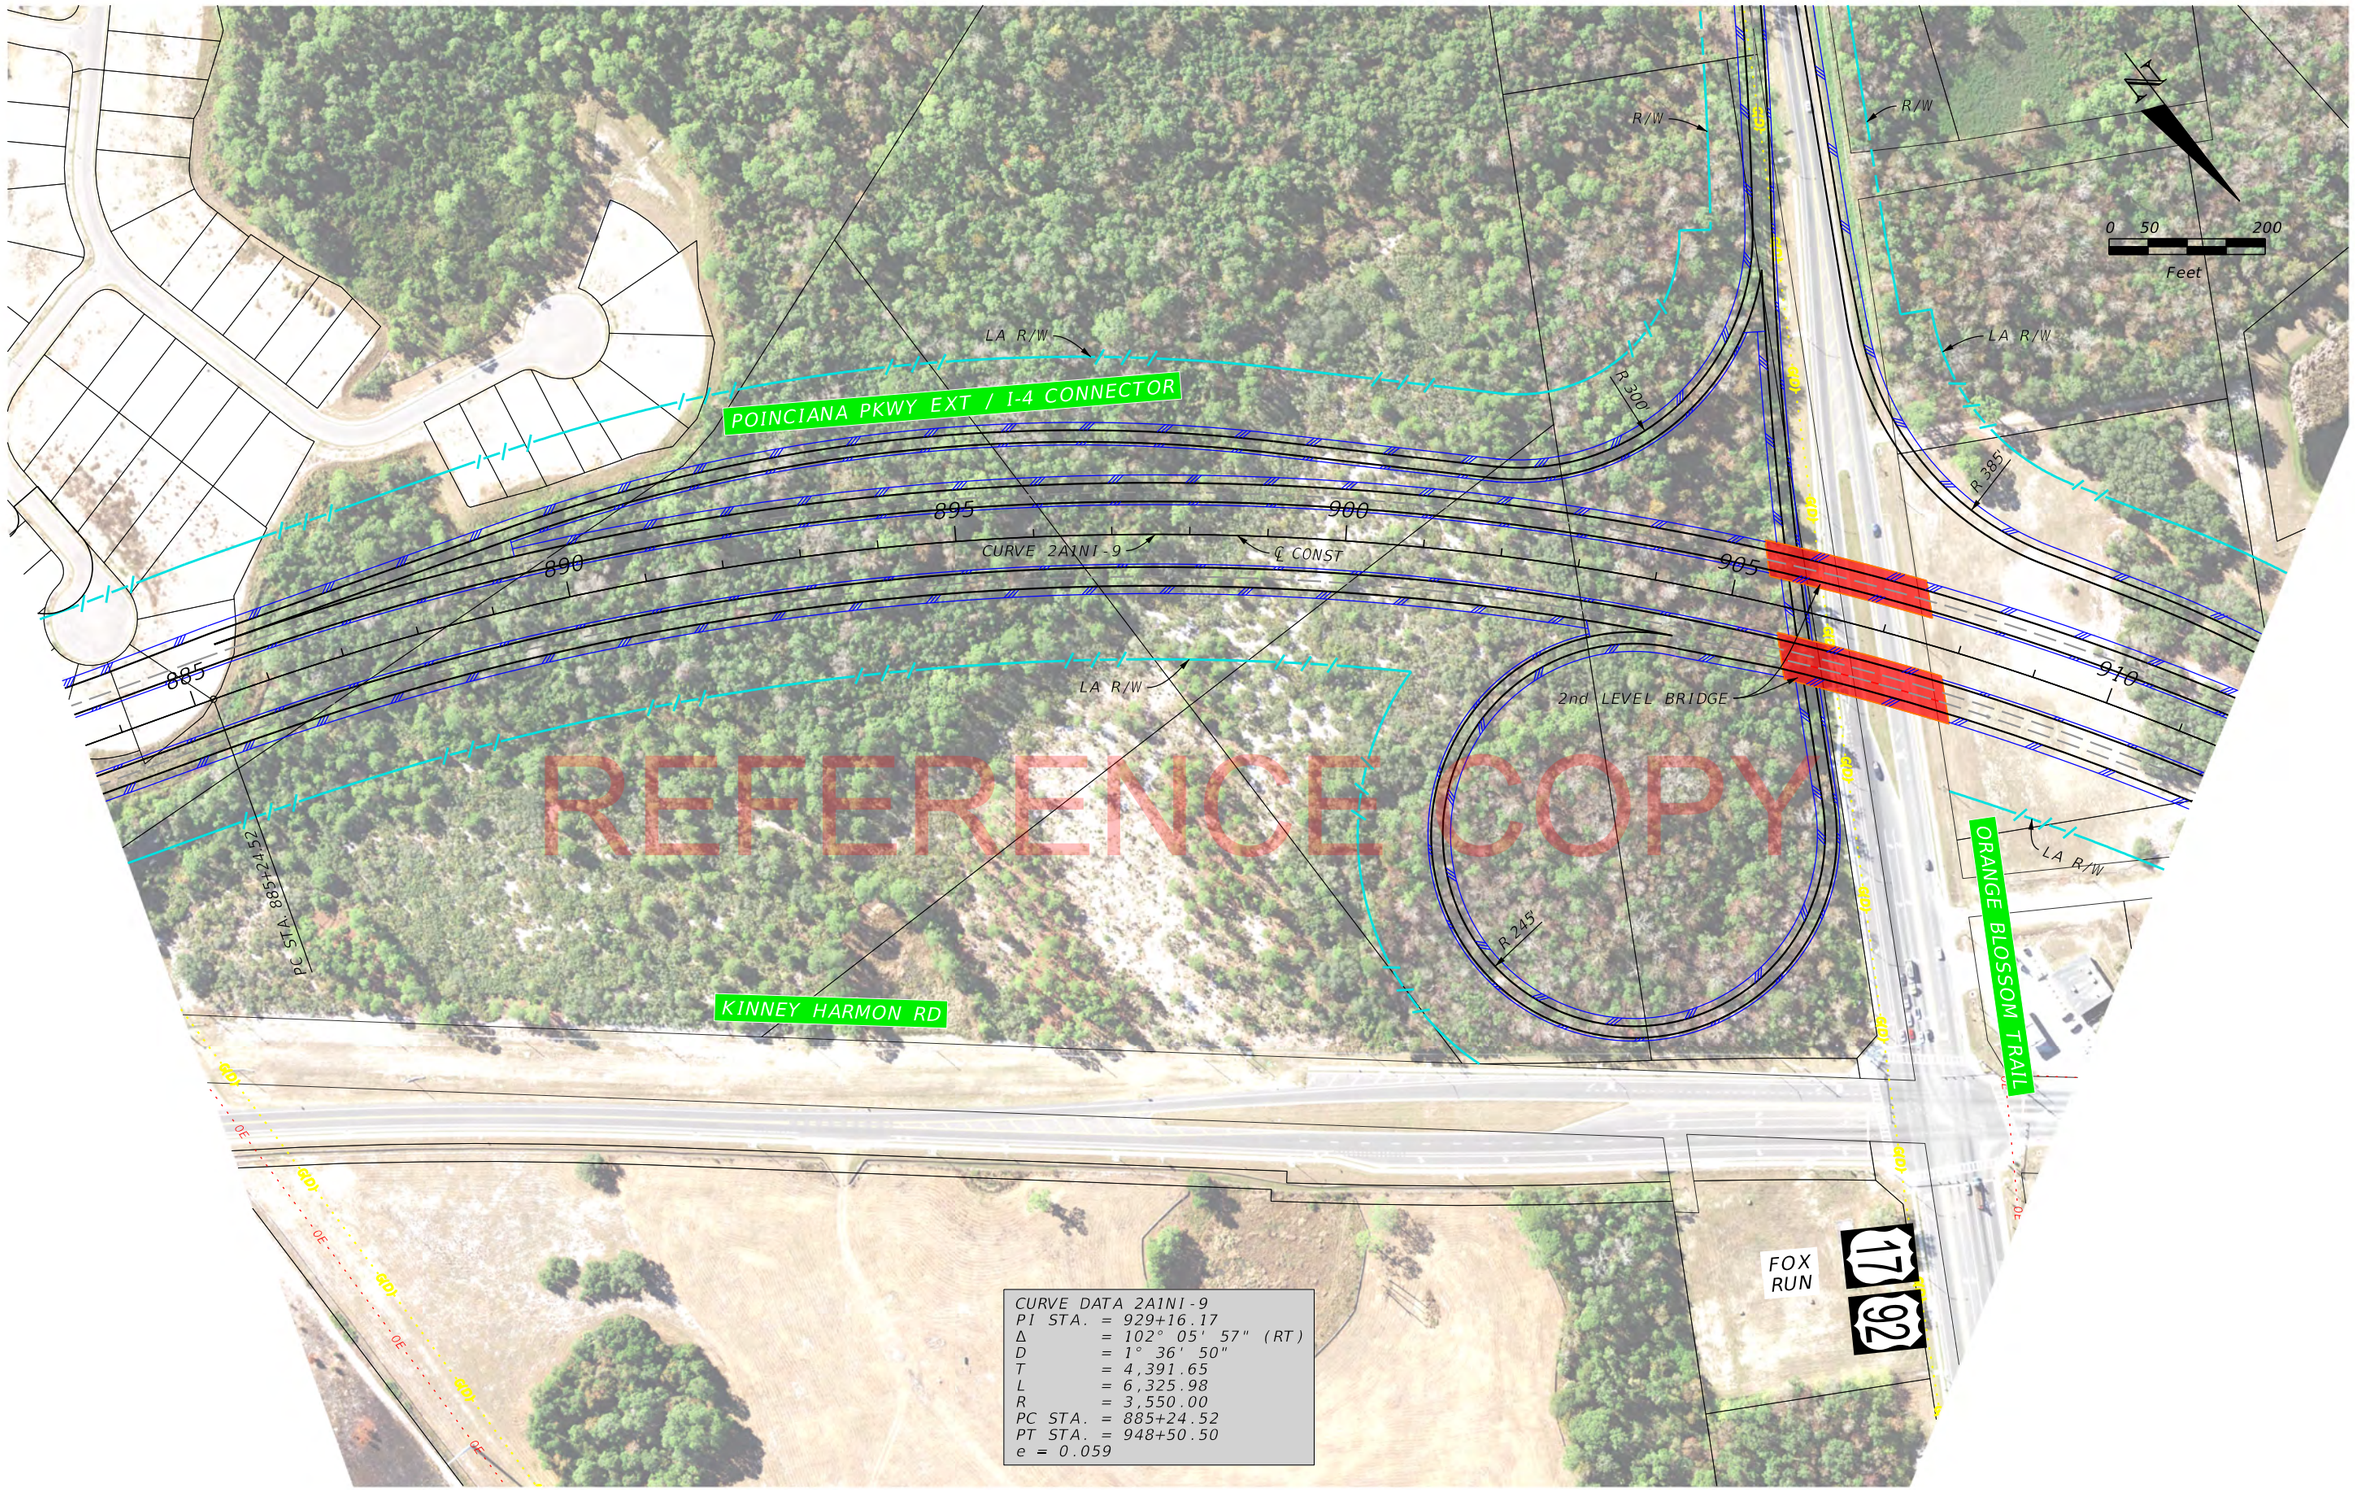

REFERENCE COPY

REVISIONS			
DATE	DESCRIPTION	DATE	DESCRIPTION

CENTRAL FLORIDA EXPRESSWAY AUTHORITY

Concept, Feasability and Mobility Study
for the
Poinciana Parkway Extension / I-4 Connector

Alternative 2A-1

SHEET NO.
2A1-5

Bill.Lemos 3/21/2018 7:12:41 AM K:\ORL_TPTO\149800000___I-4 Connector\200_Engineering\CADD\roadway\Roadway Alignments\plans\plan2A_1-17.dgn

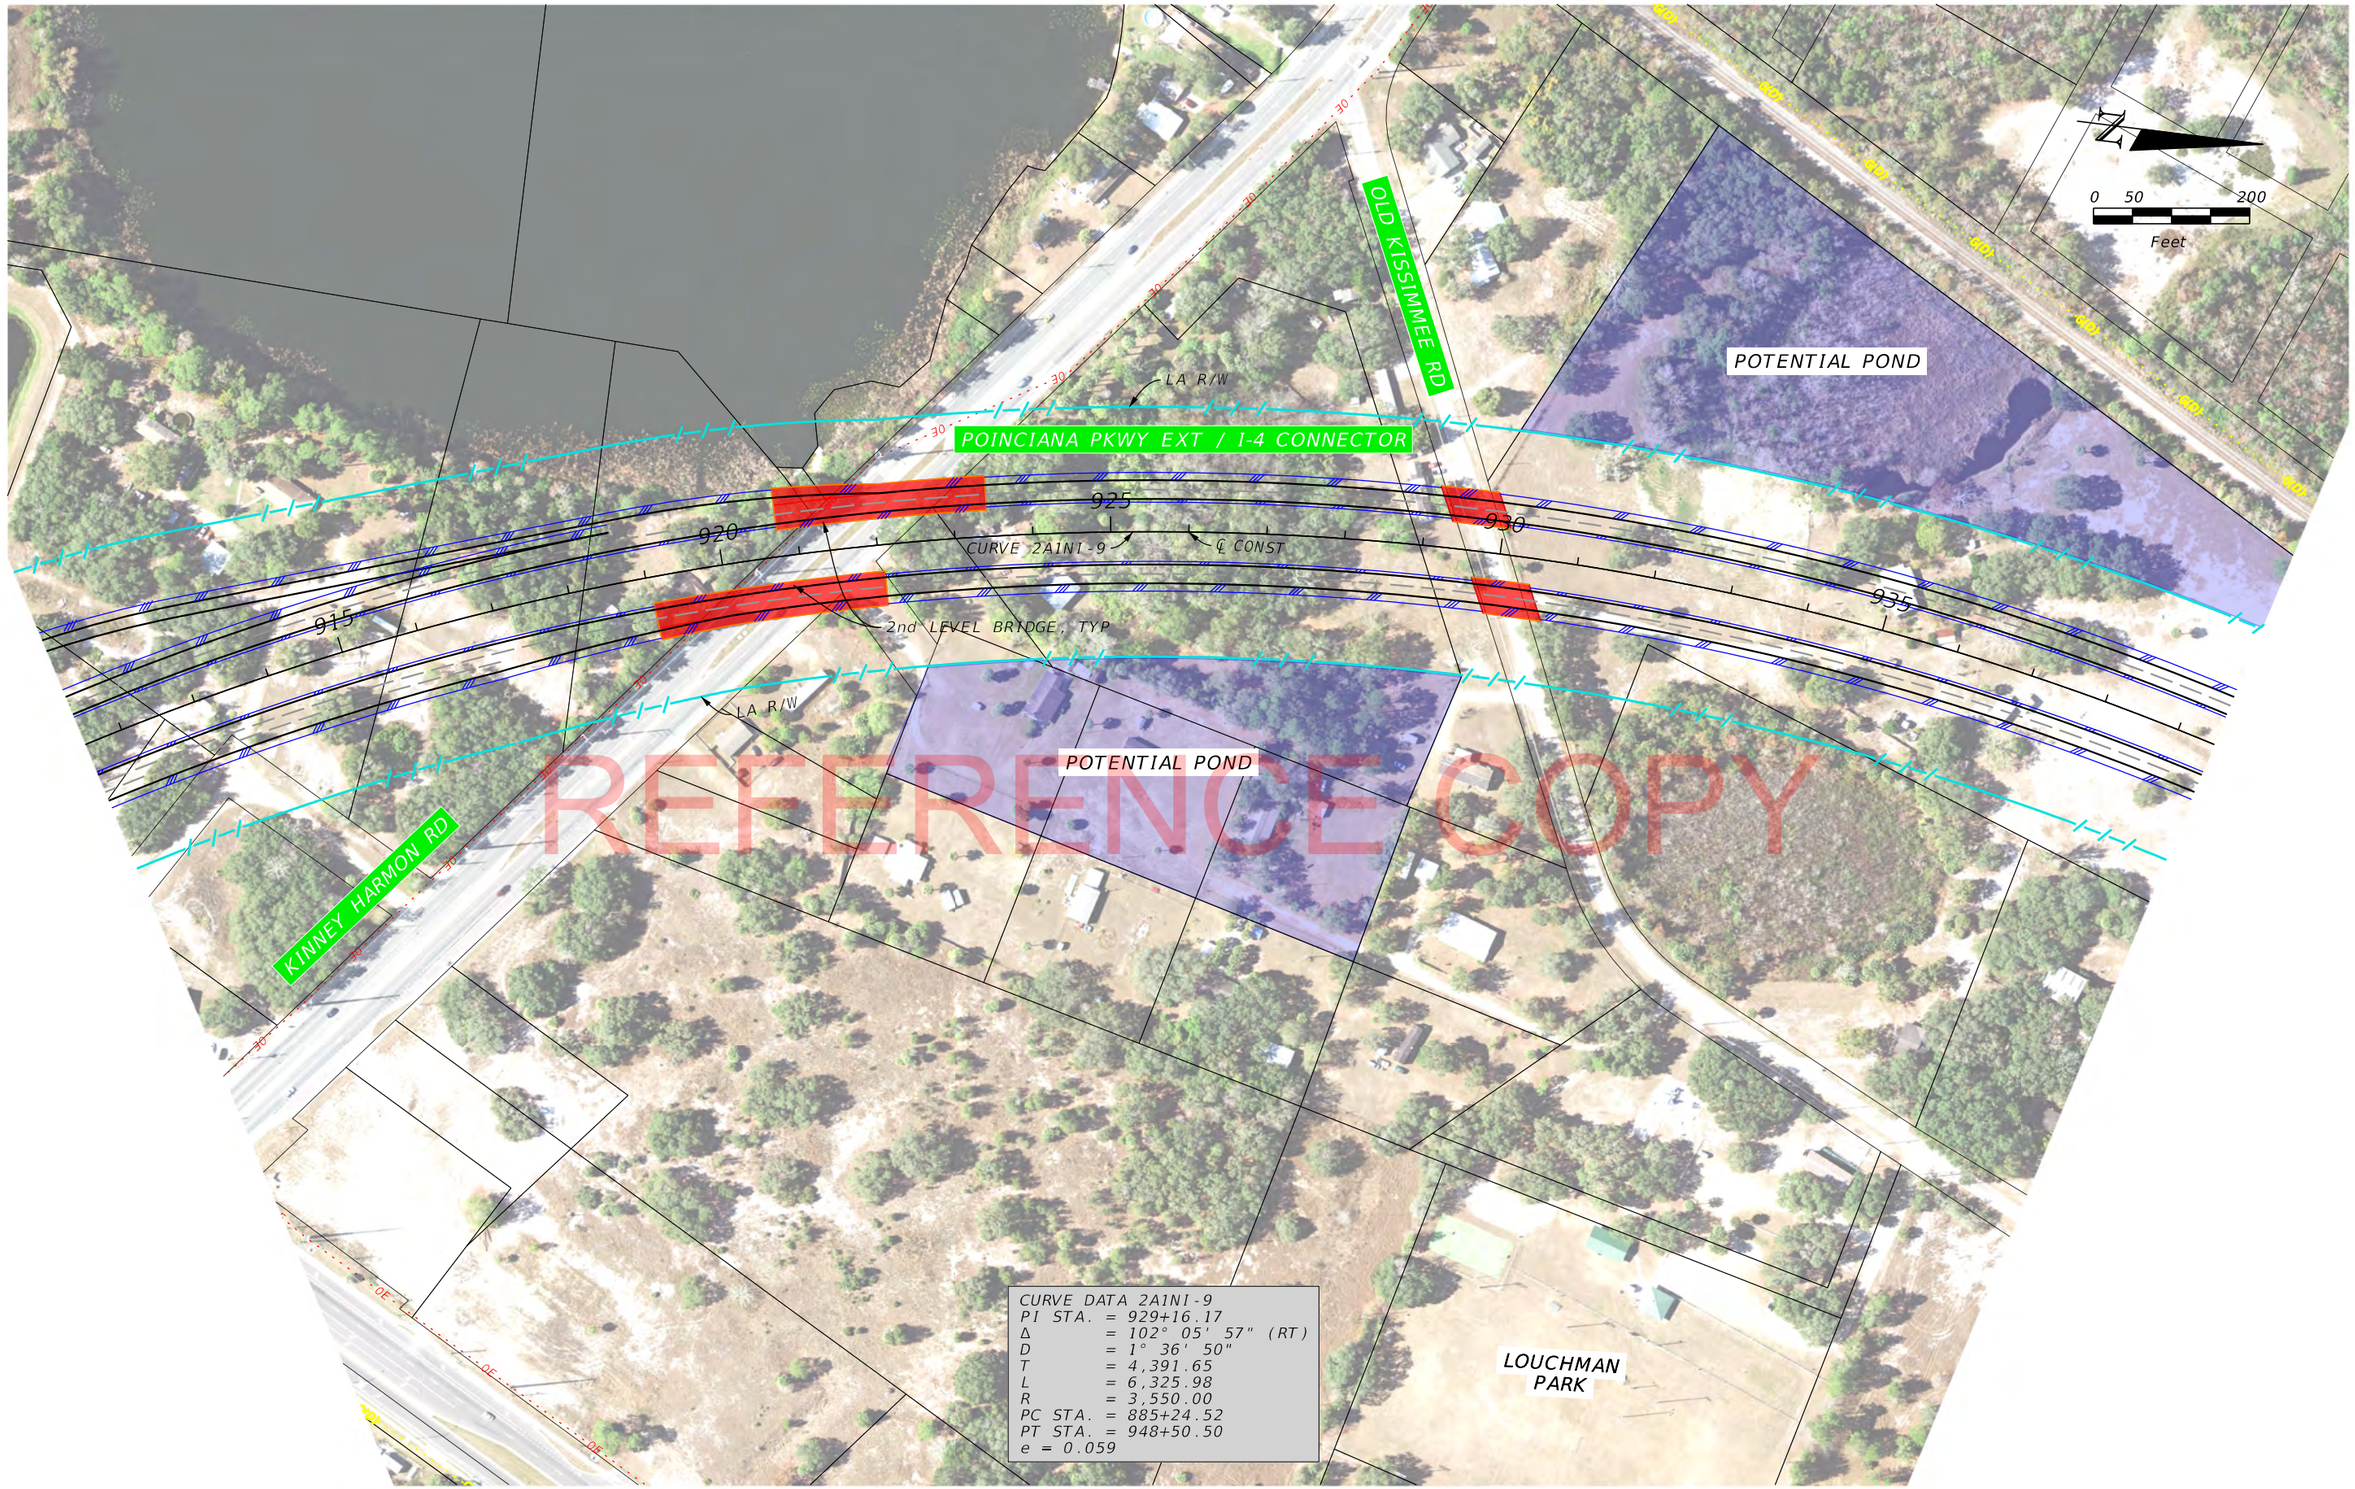

REFERENCE COPY

REVISIONS			
DATE	DESCRIPTION	DATE	DESCRIPTION

CENTRAL FLORIDA EXPRESSWAY AUTHORITY

Concept, Feasability and Mobility Study
for the
Poinciana Parkway Extension / I-4 Connector

Alternative 2A-1

SHEET NO.
2A1-6

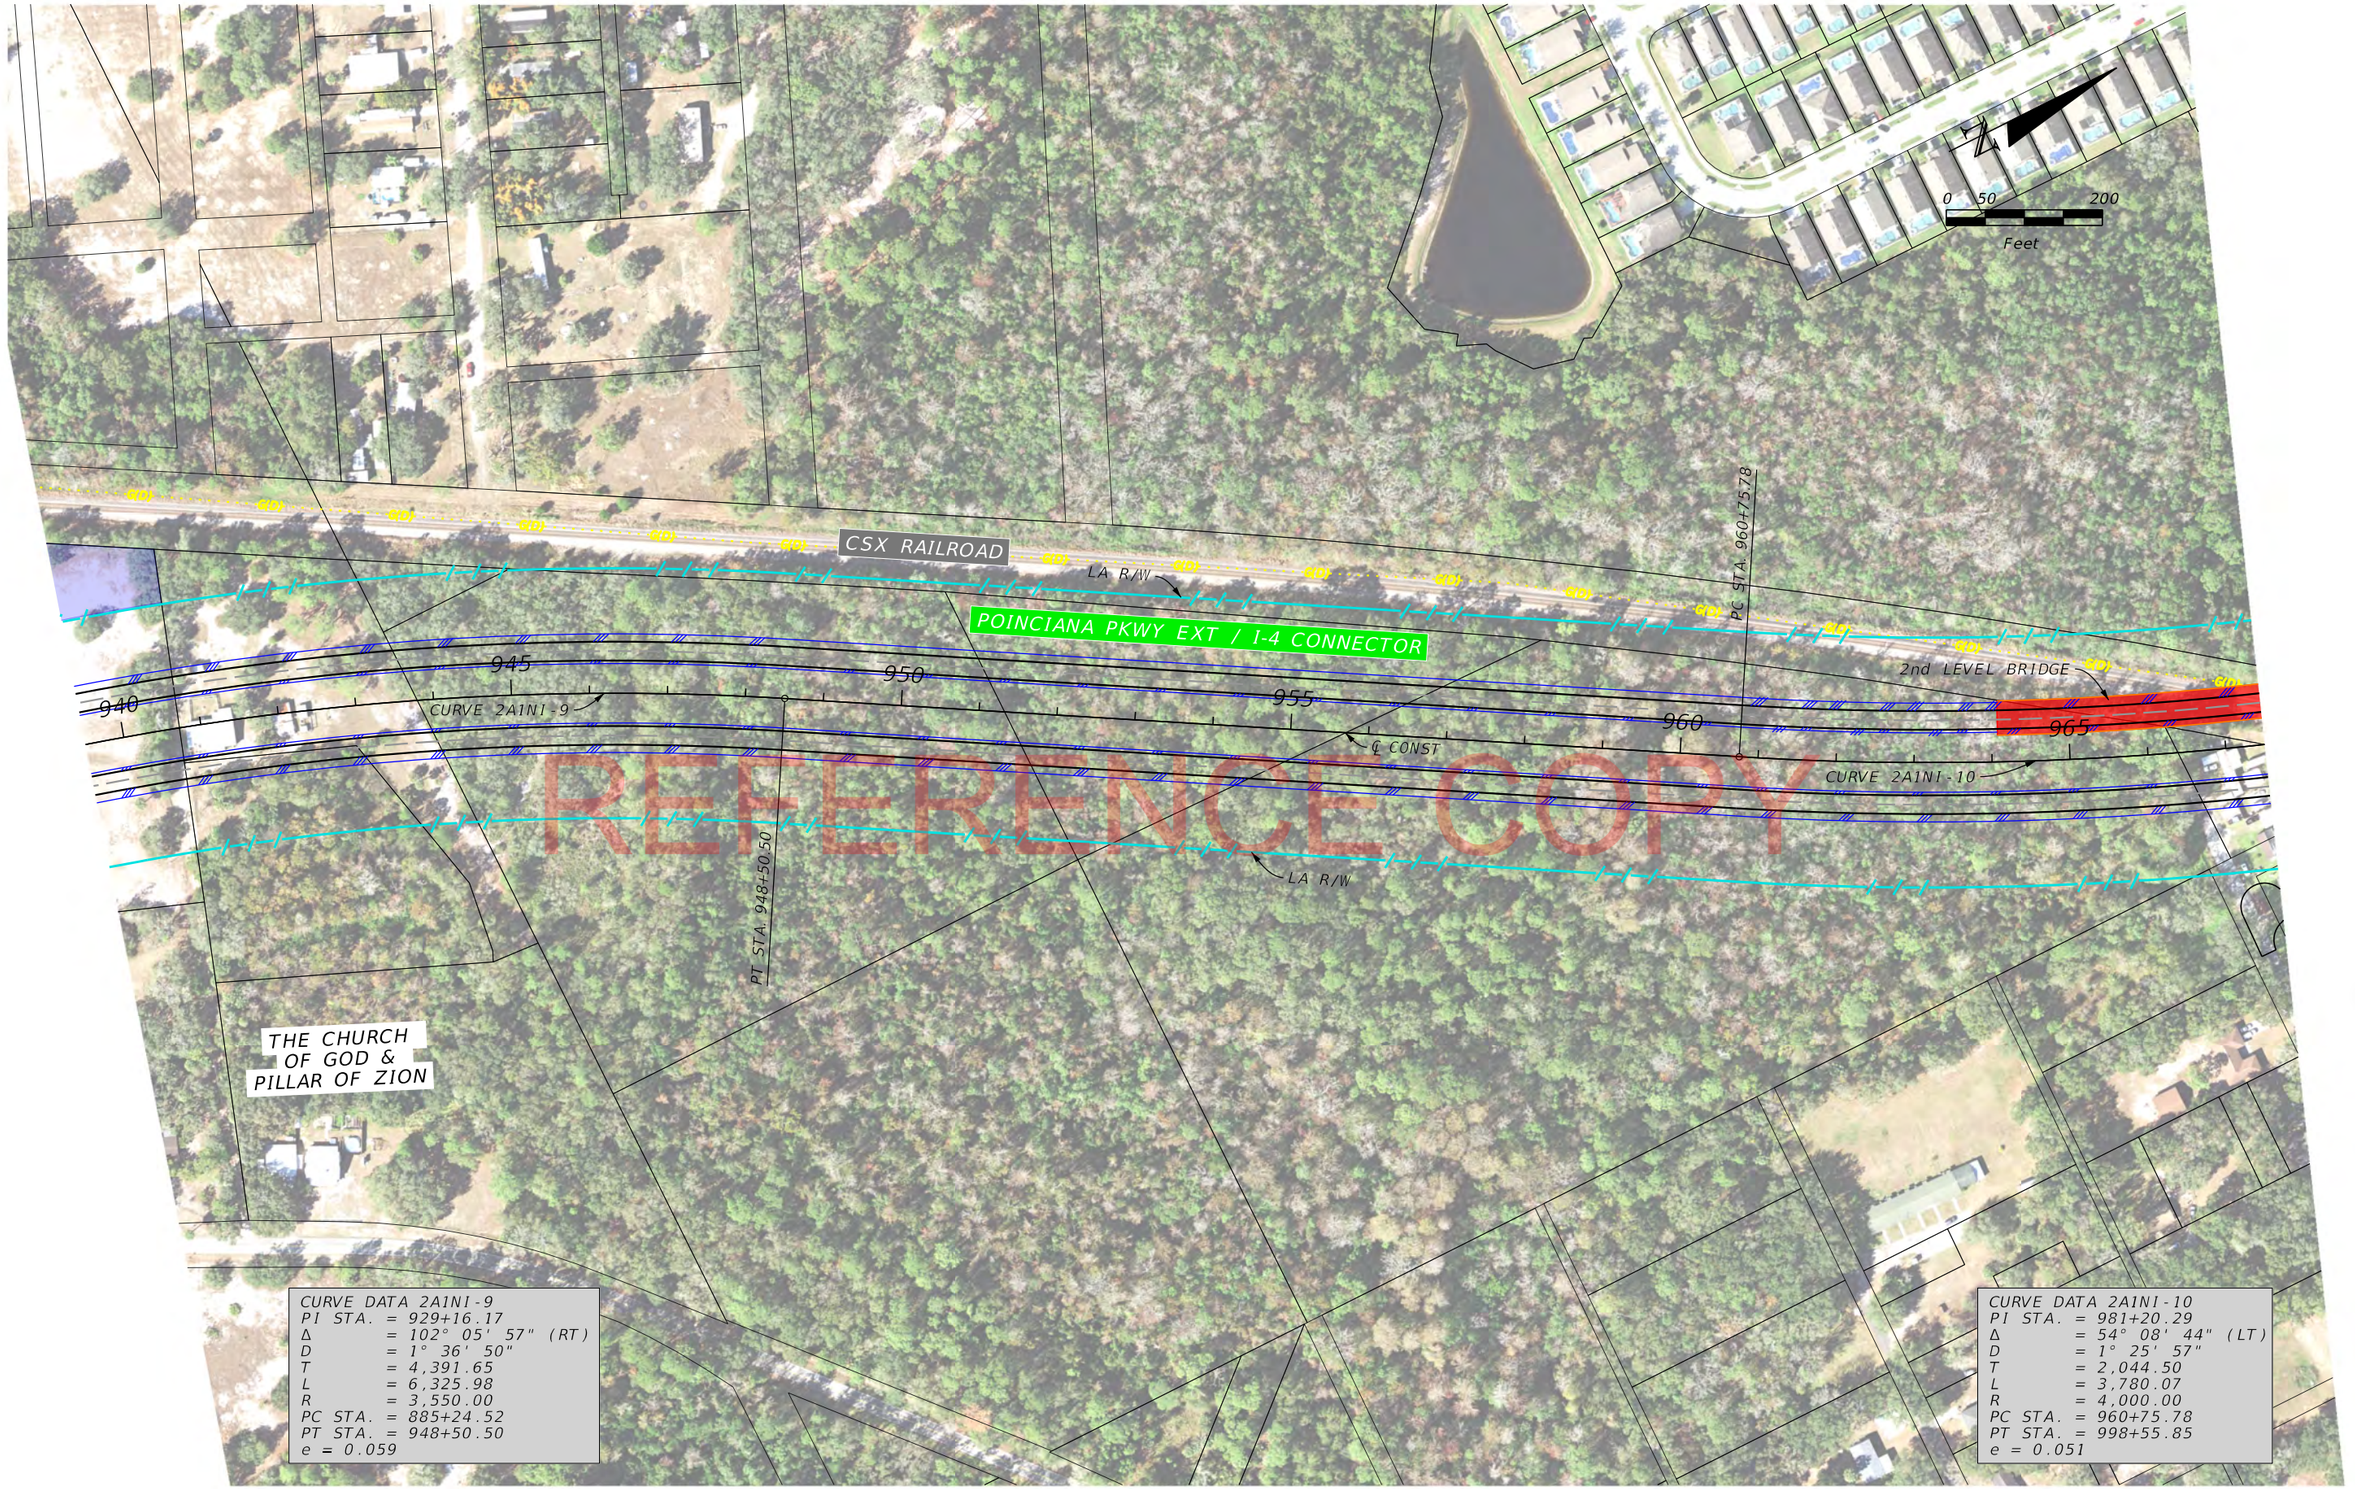

CURVE DATA 2A1NI-9
PI STA. = 929+16.17
Δ = 102° 05' 57" (RT)
D = 1° 36' 50"
T = 4,391.65
L = 6,325.98
R = 3,550.00
PC STA. = 885+24.52
PT STA. = 948+50.50
e = 0.059

CURVE DATA 2A1NI-10
PI STA. = 981+20.29
Δ = 54° 08' 44" (LT)
D = 1° 25' 57"
T = 2,044.50
L = 3,780.07
R = 4,000.00
PC STA. = 960+75.78
PT STA. = 998+55.85
e = 0.051

REVISIONS			
DATE	DESCRIPTION	DATE	DESCRIPTION

CENTRAL FLORIDA EXPRESSWAY AUTHORITY

Concept, Feasability and Mobility Study
for the
Poinciana Parkway Extension / I-4 Connector

Alternative 2A-1

SHEET NO.
2A1-7

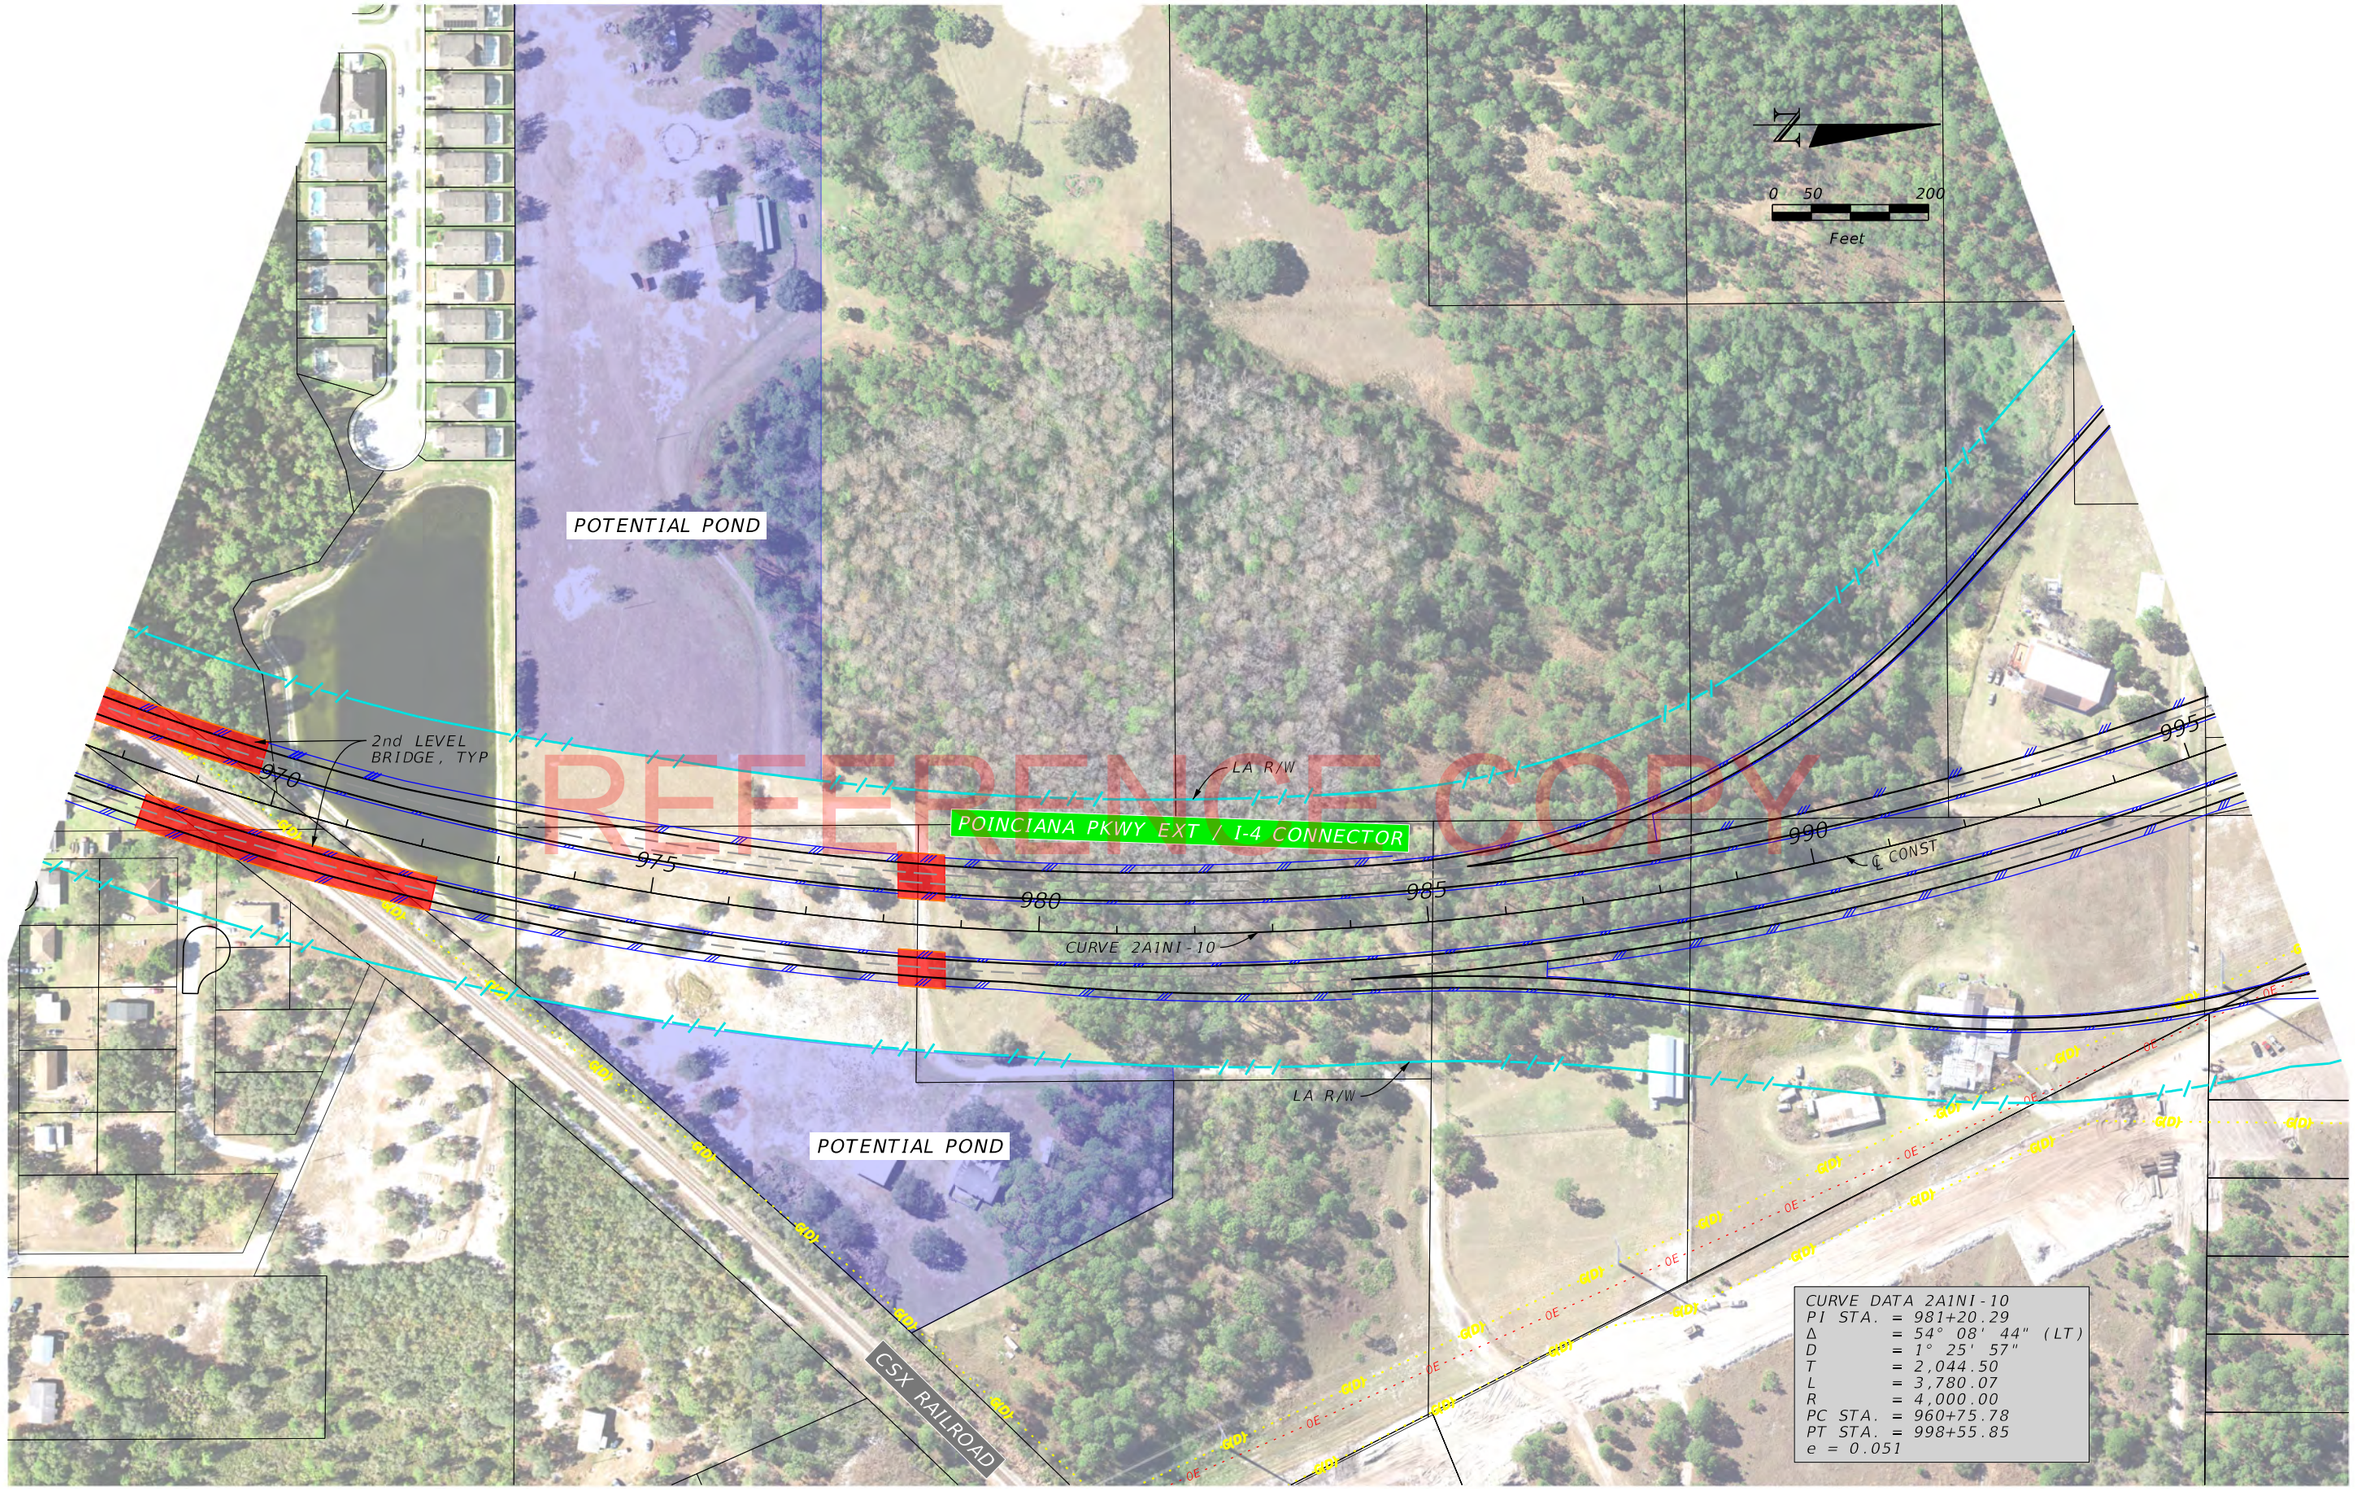

REFERENCE COPY

REVISIONS			
DATE	DESCRIPTION	DATE	DESCRIPTION

CENTRAL FLORIDA EXPRESSWAY AUTHORITY

Concept, Feasability and Mobility Study
for the
Poinciana Parkway Extension / I-4 Connector

Alternative 2A-1

SHEET NO.
2A1-8

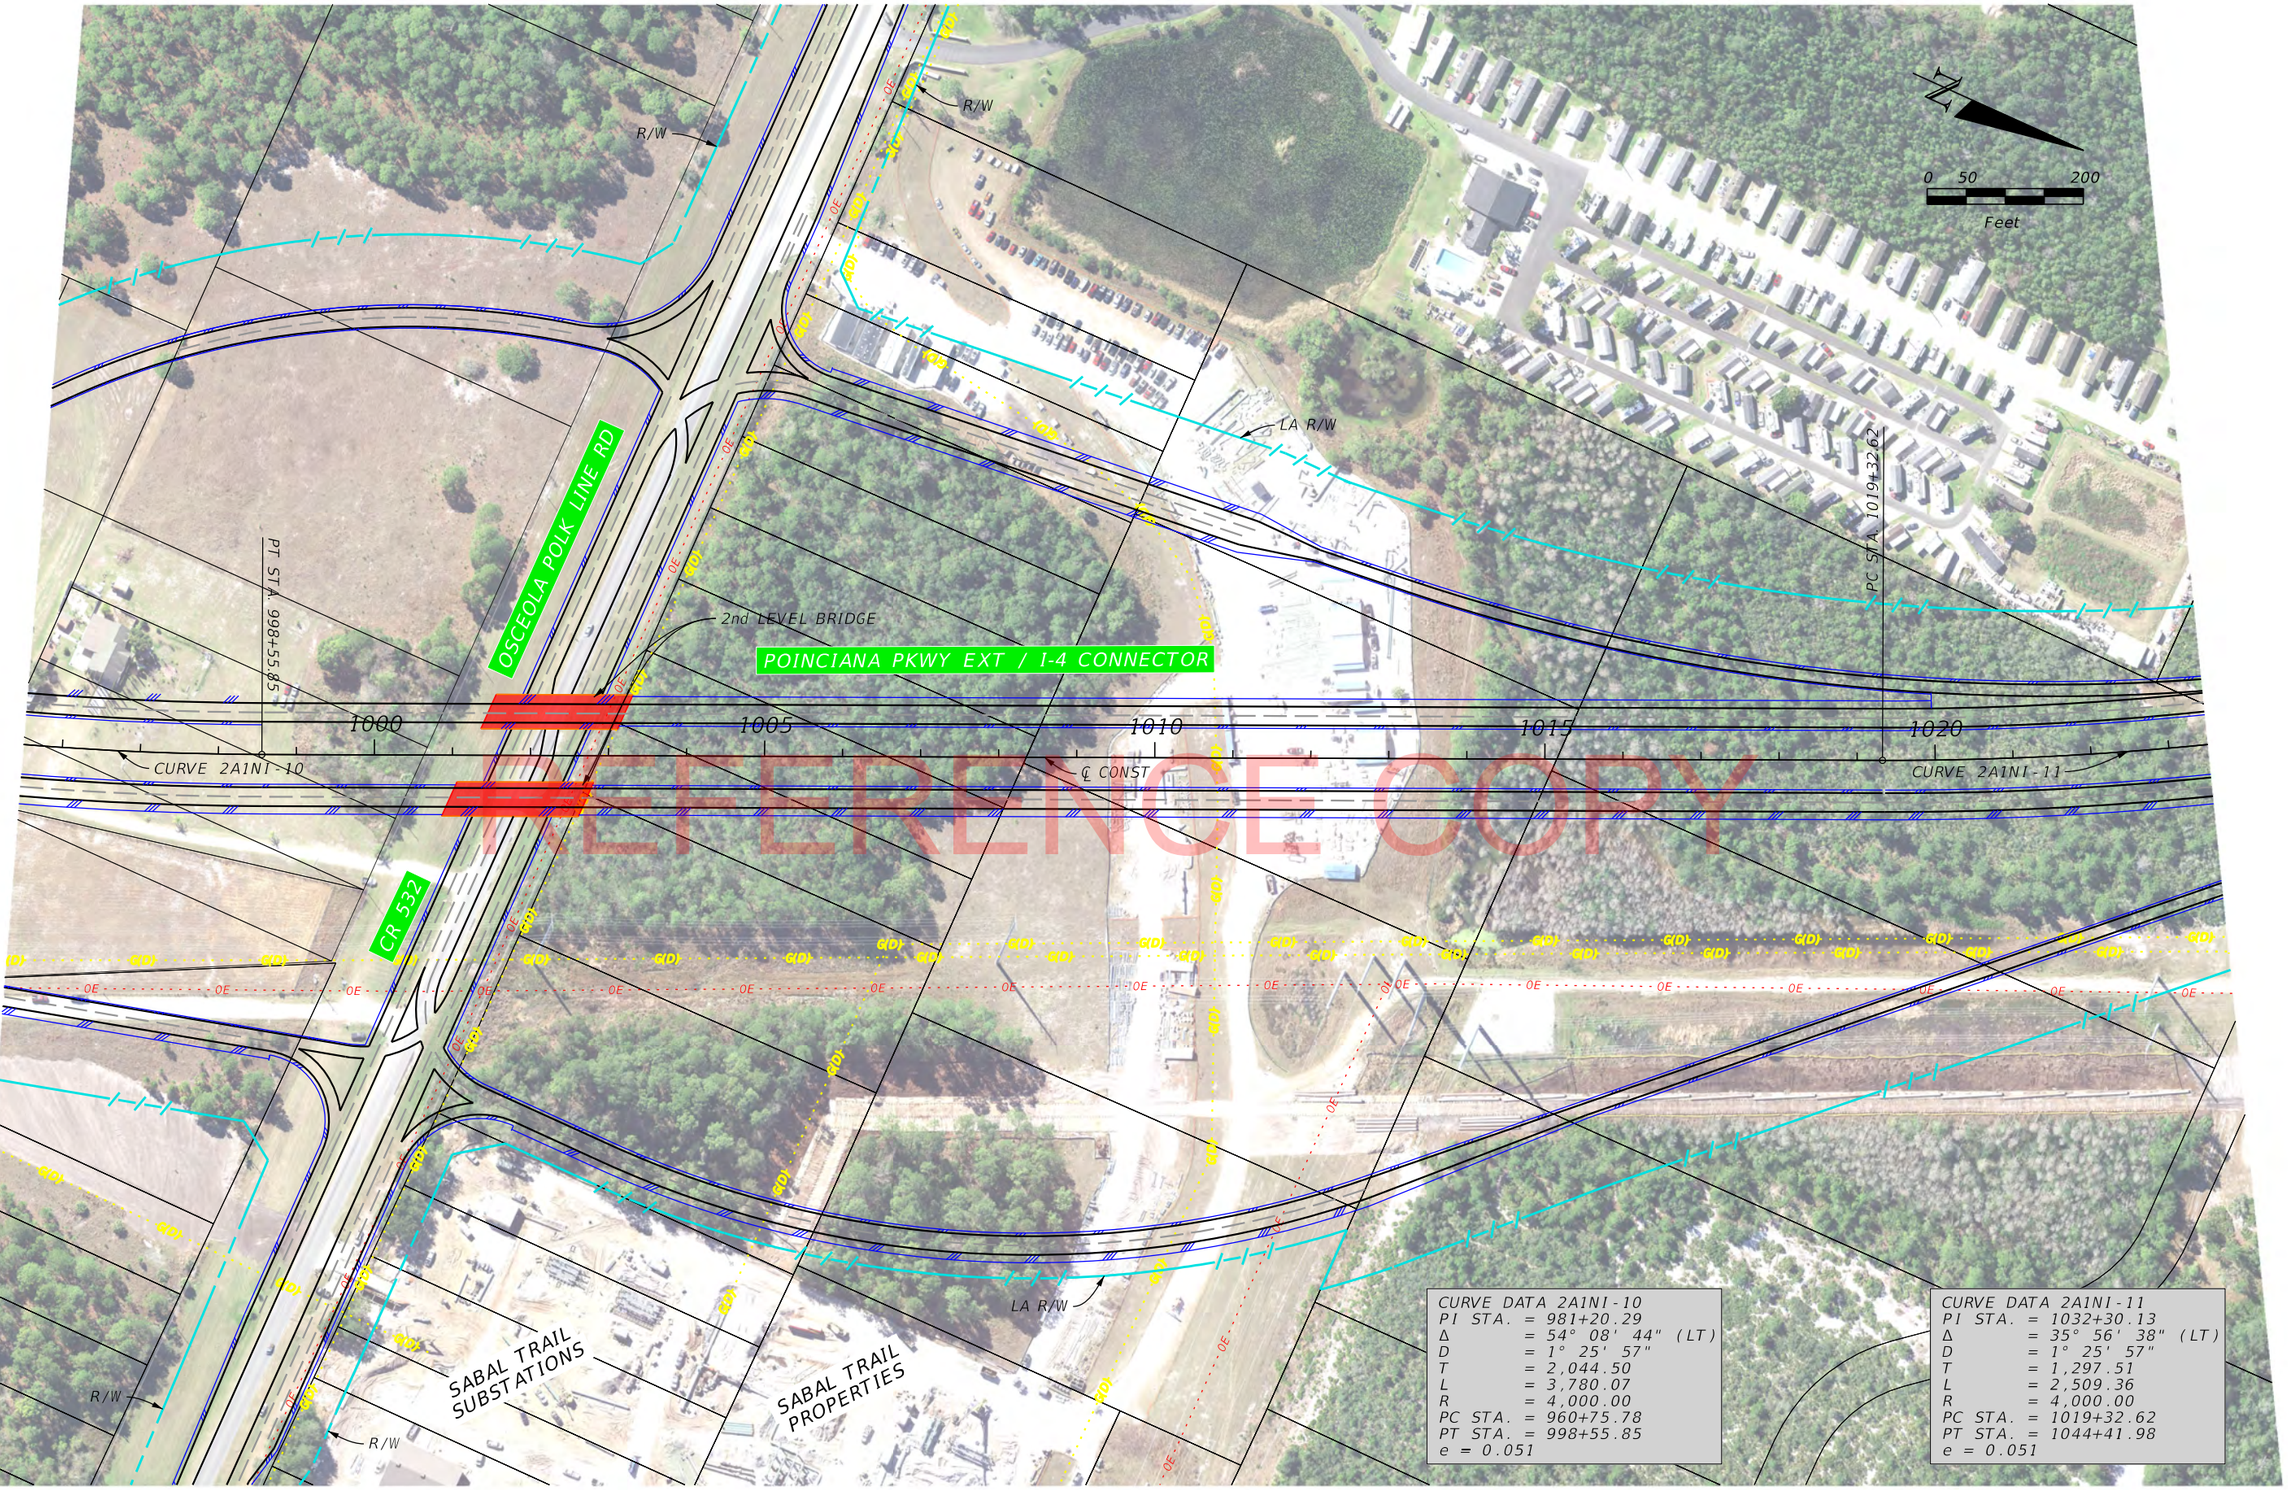

REFERENCE COPY

REVISIONS			
DATE	DESCRIPTION	DATE	DESCRIPTION

CENTRAL FLORIDA EXPRESSWAY AUTHORITY

Concept, Feasability and Mobility Study
for the
Poinciana Parkway Extension / I-4 Connector

Alternative 2A-1

SHEET NO.
2A1-9

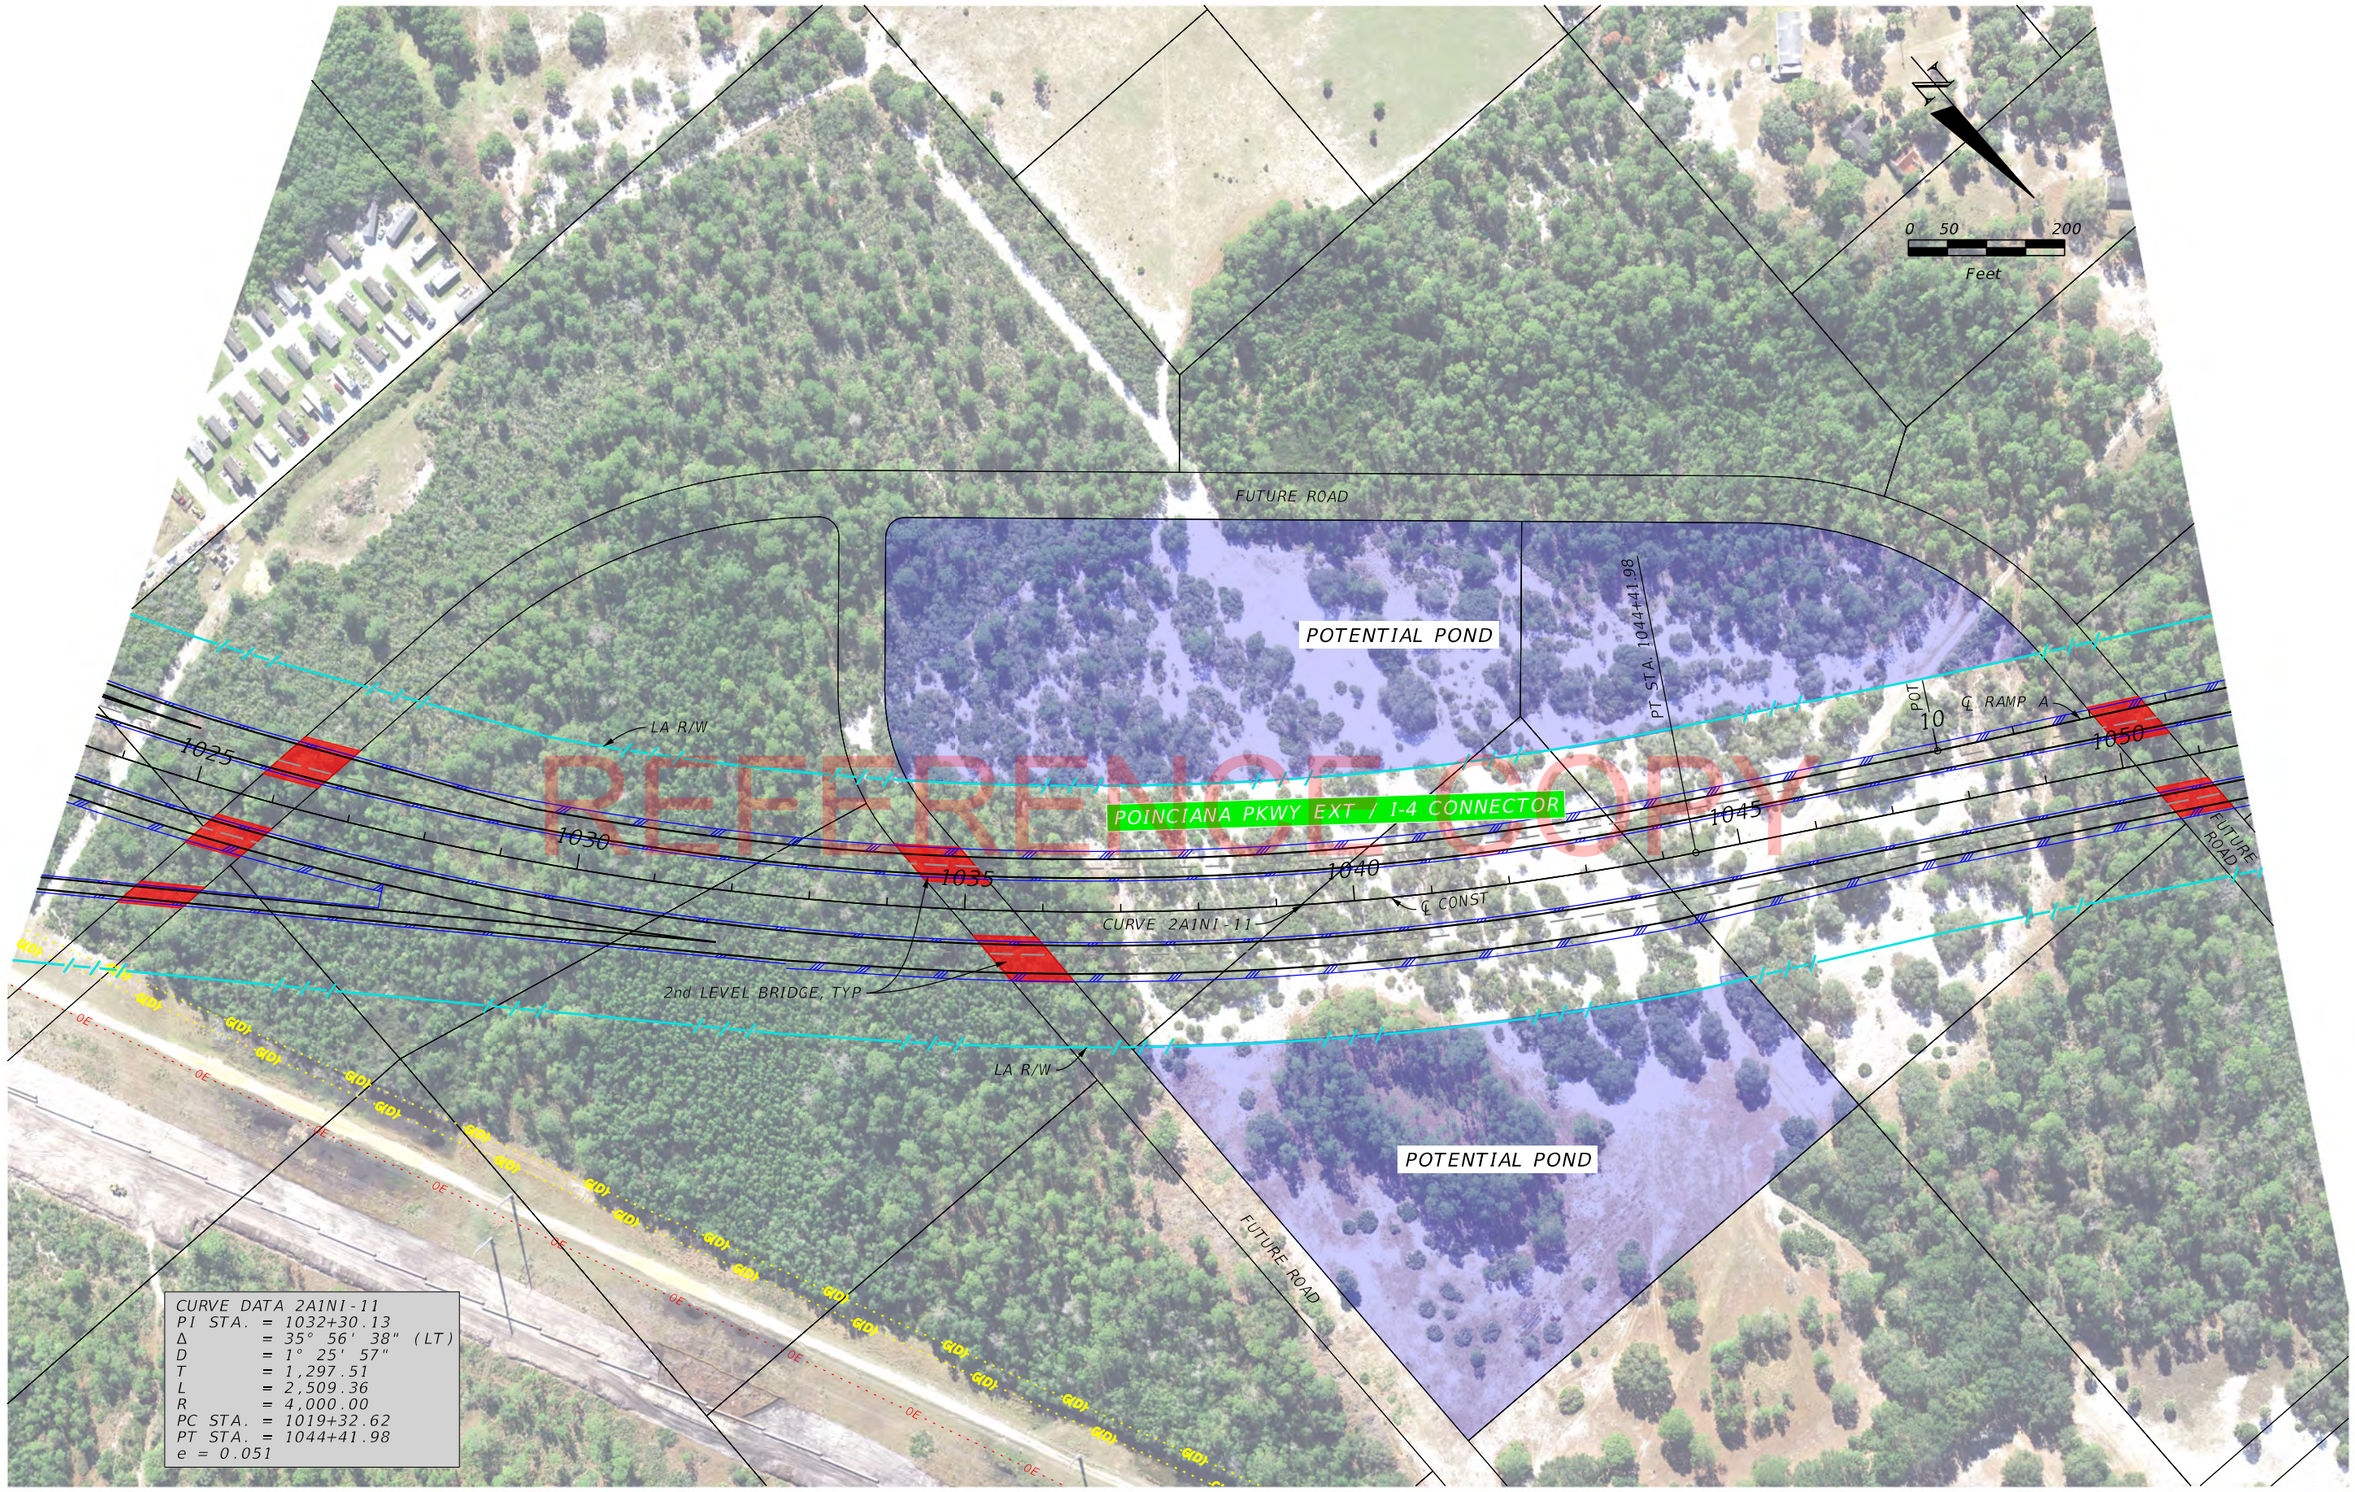

REFERENCE COPY

REVISIONS			
DATE	DESCRIPTION	DATE	DESCRIPTION

CENTRAL FLORIDA EXPRESSWAY AUTHORITY

Concept, Feasability and Mobility Study
for the
Poinciana Parkway Extension / I-4 Connector

Alternative 2A-1

SHEET NO.
2A1-10

Bill.Lemos 3/21/2018 7:18:59 AM K:\ORL_TPTO\149800000___I-4 Connector\200_Engineering\CADD\roadway\Roadway Alignments\plans\plan2A_1-22.dgn

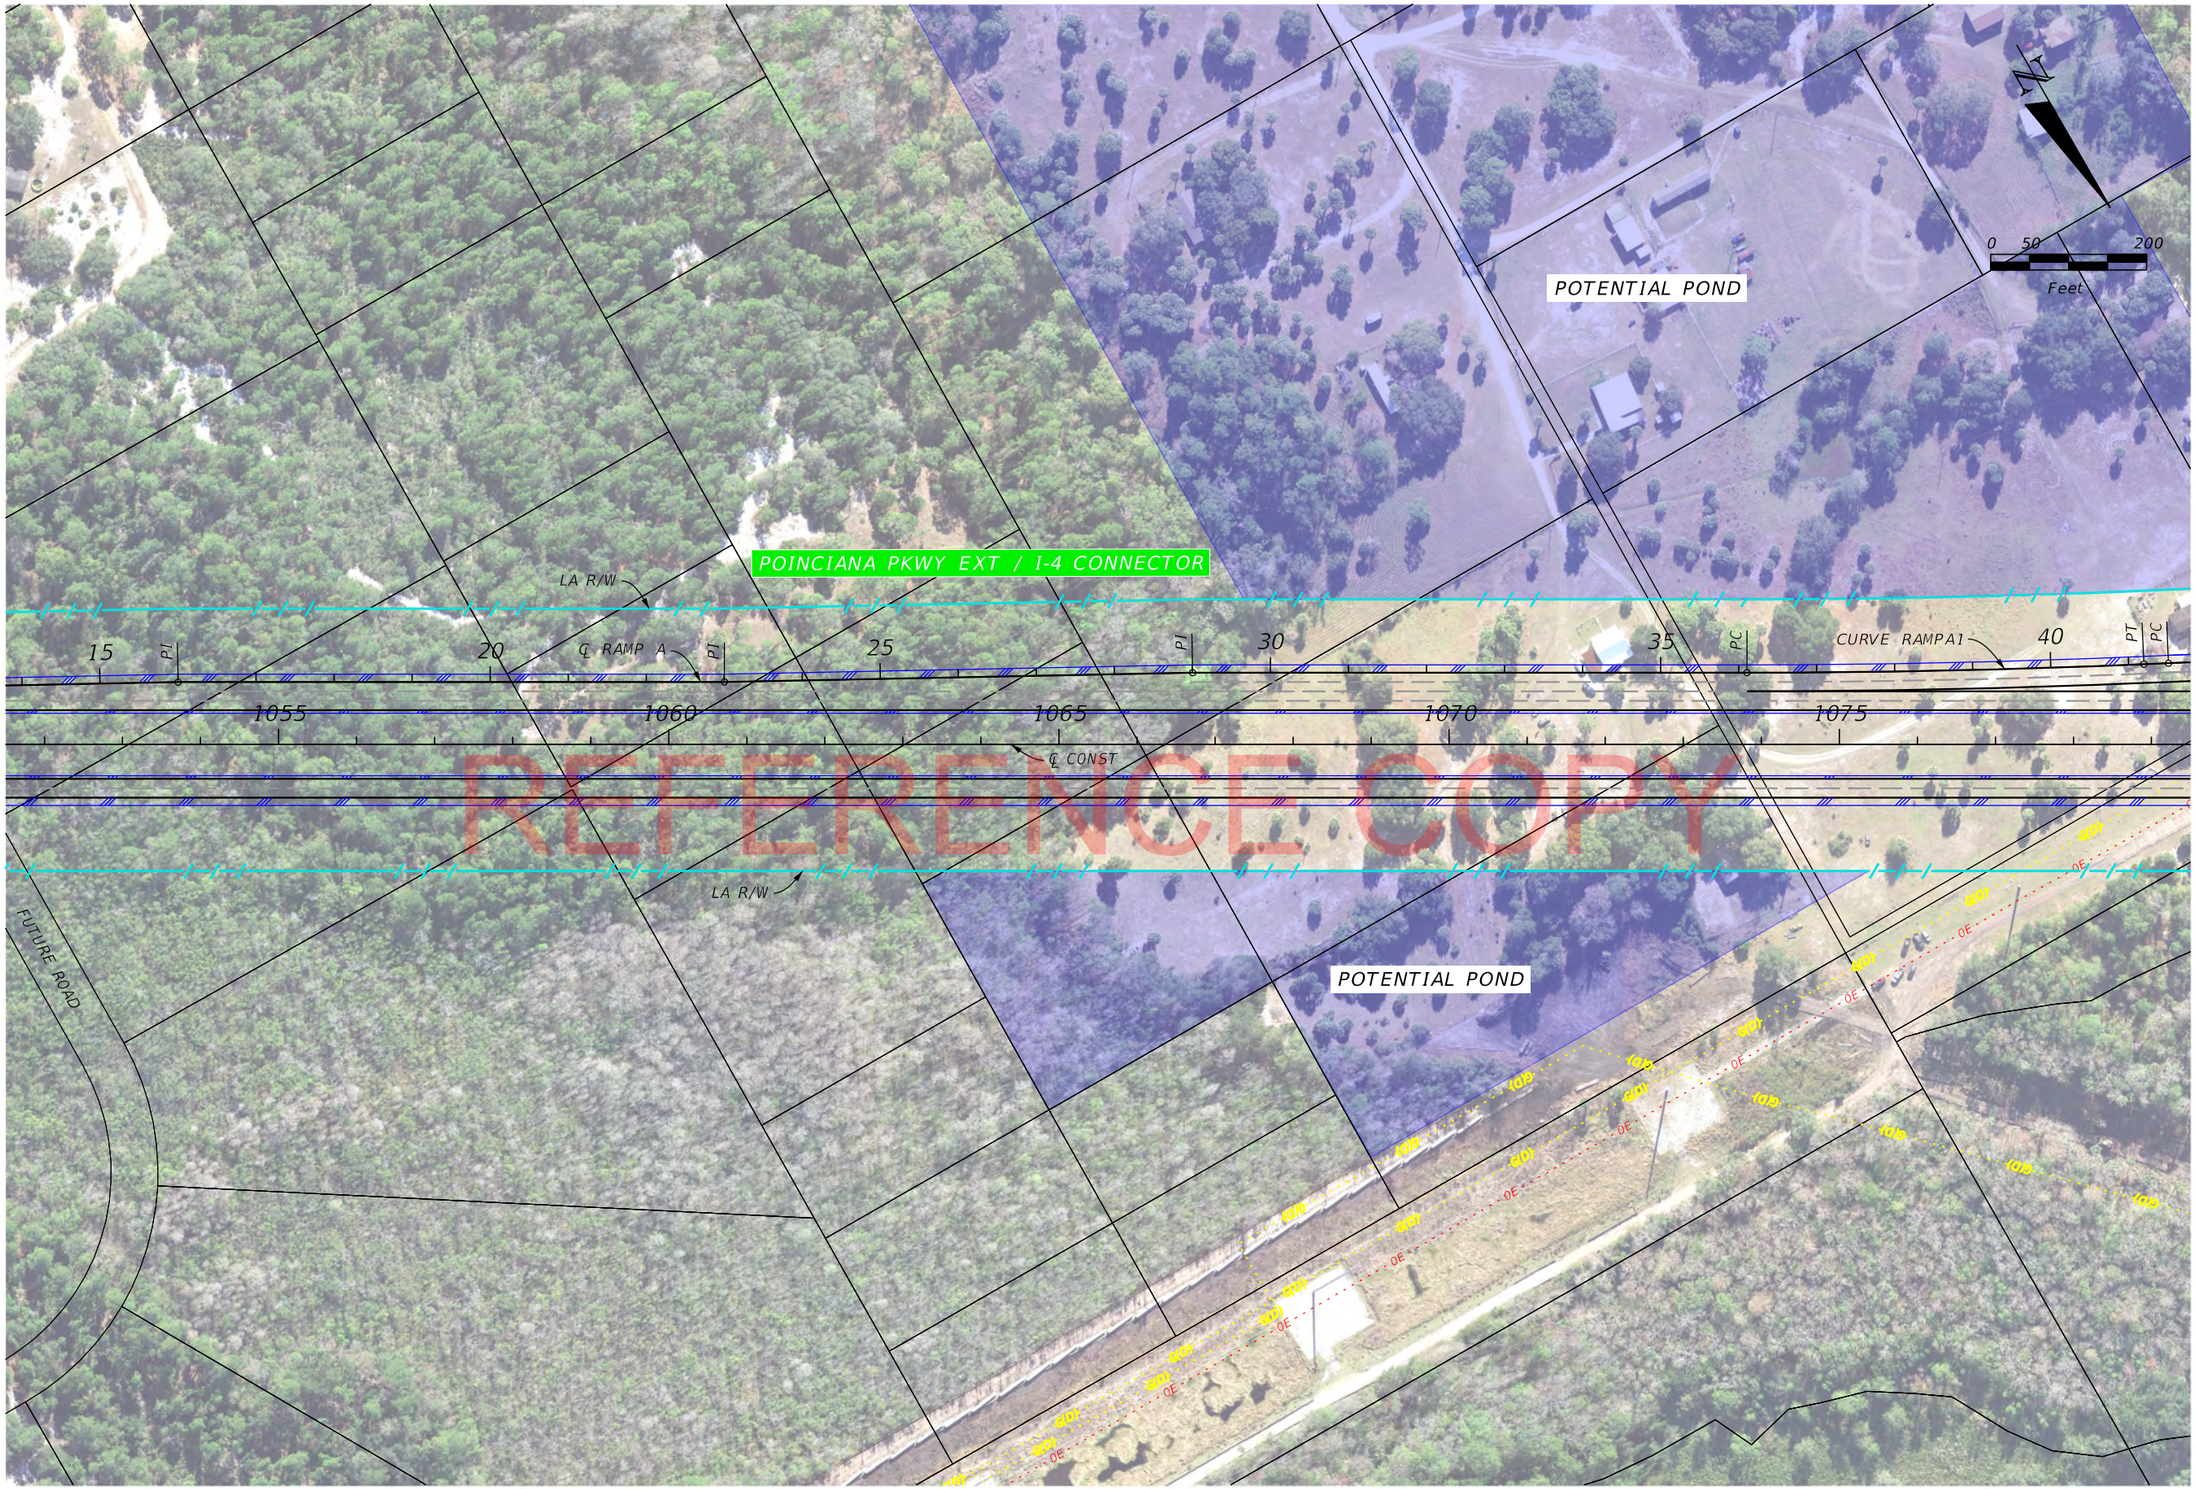
POINCIANA PKWY EXT / I-4 CONNECTOR
LA R/W
℄ RAMP A
PI
PI
PI
PC
PT
PC
CURVE RAMPA1
15
20
25
30
35
40
1055
1060
1065
1070
1075
℄ CONST
POTENTIAL POND
N
0 50 200
Feet
LA R/W
FUTURE ROAD
POTENTIAL POND
EOP
EOP
EOP

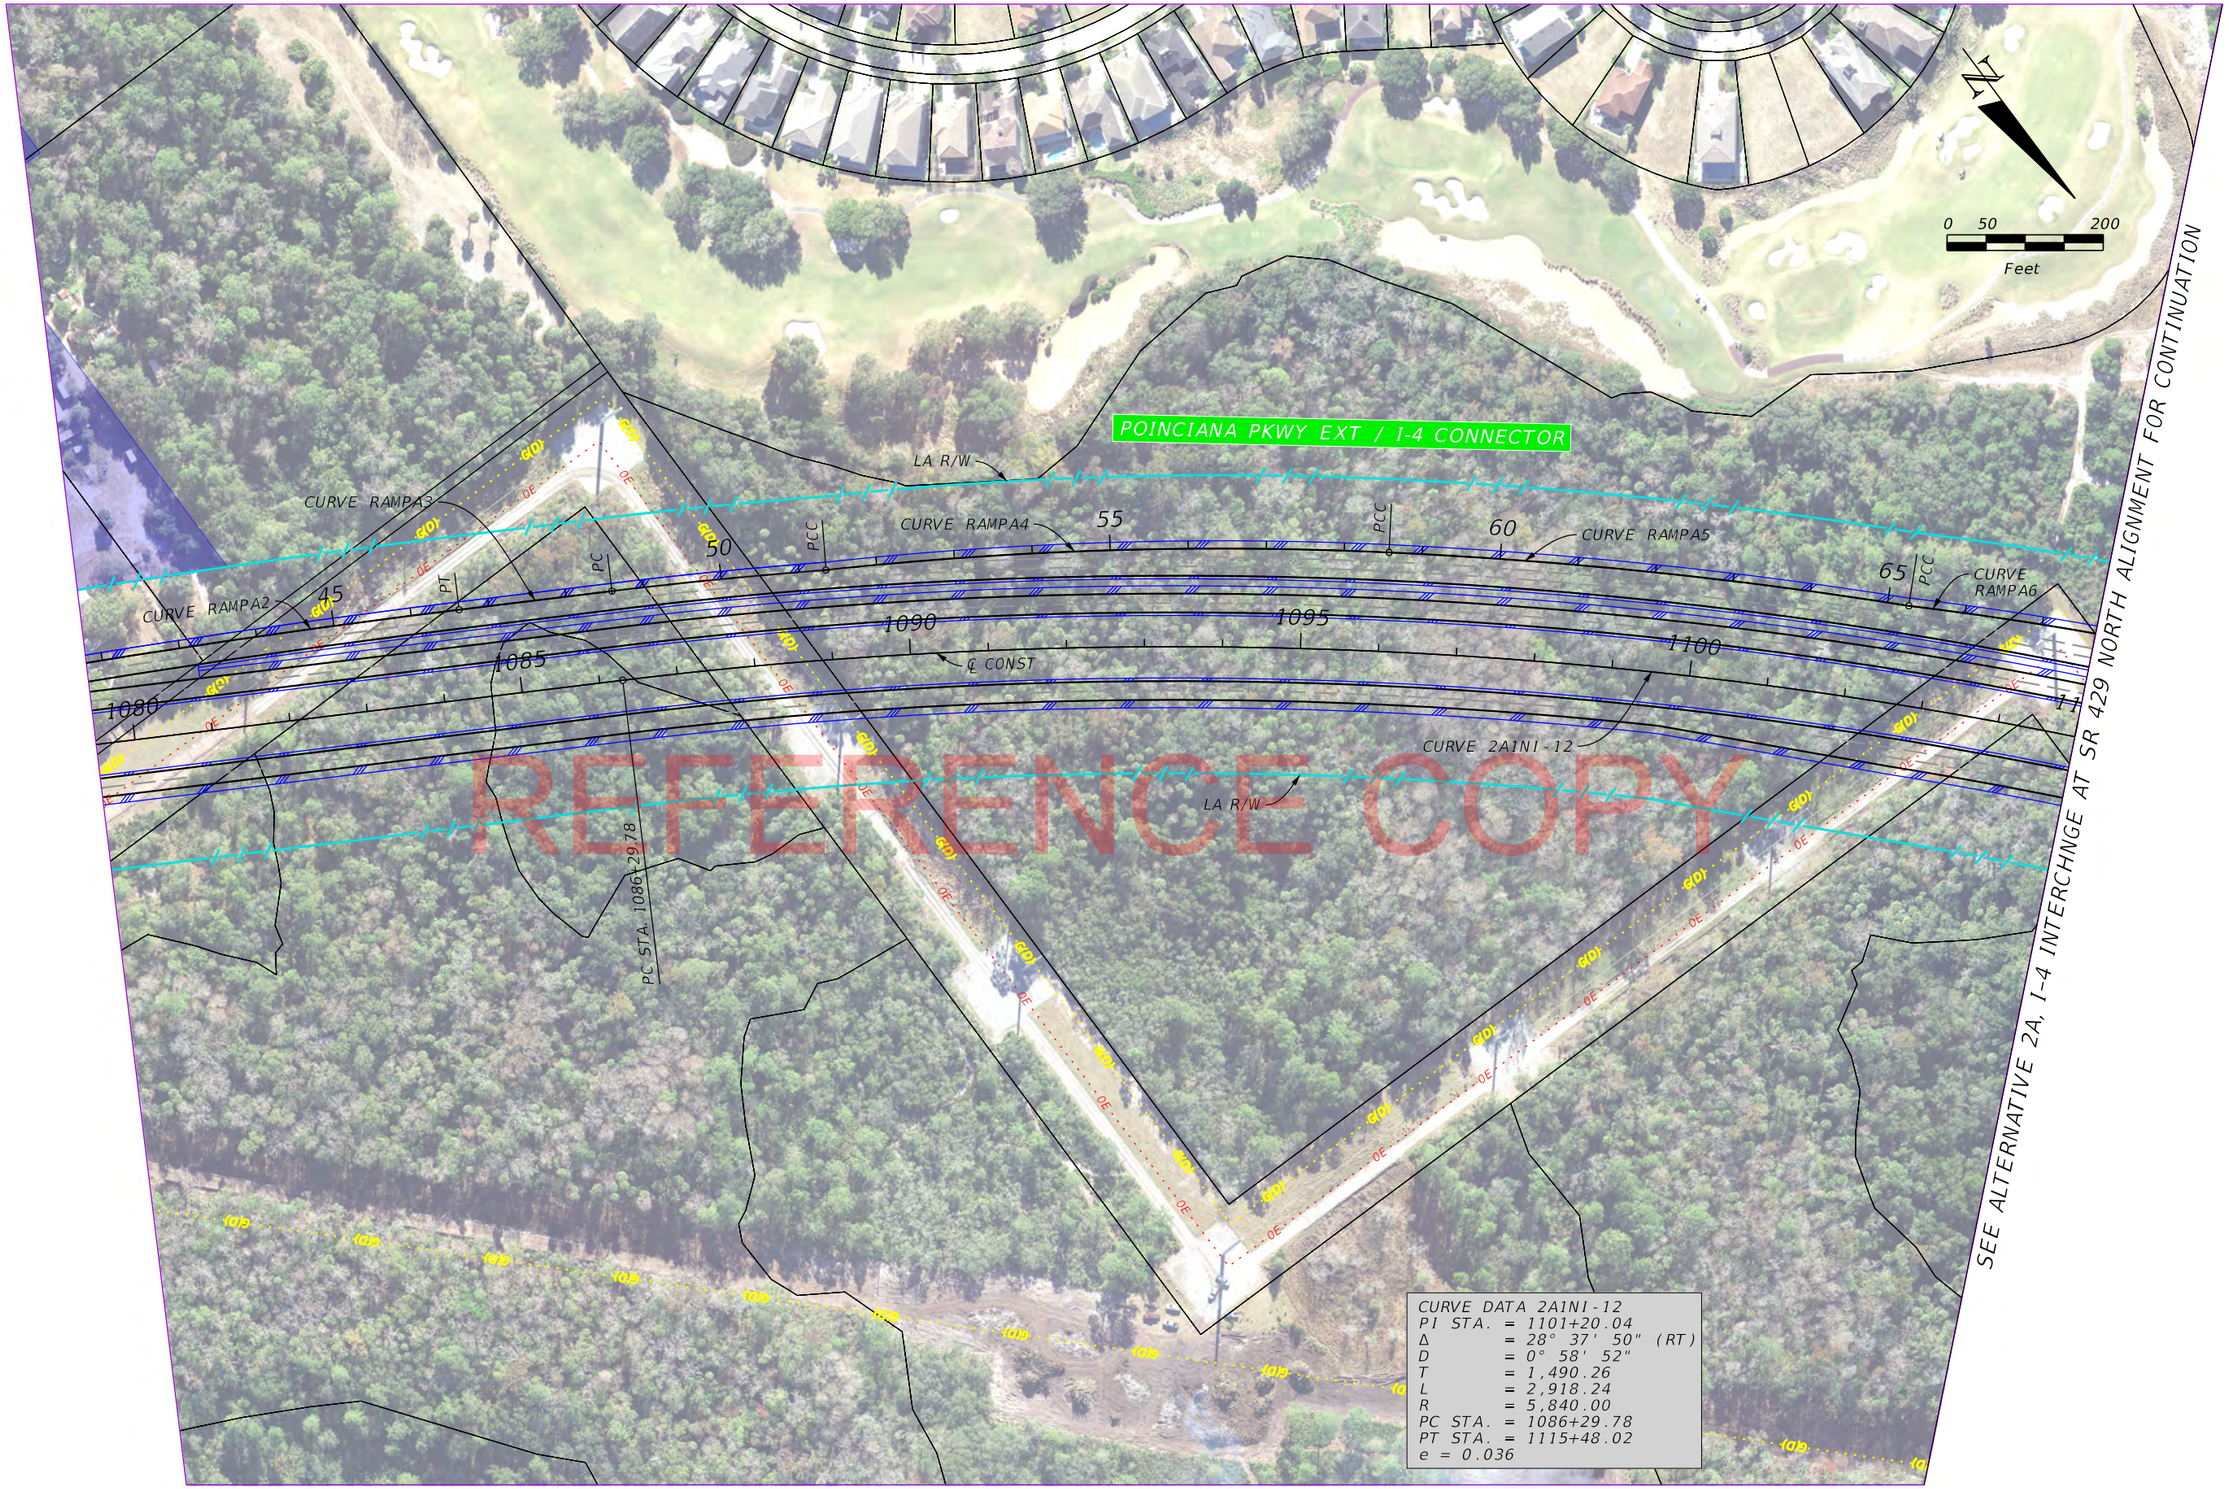

REVISIONS			
DATE	DESCRIPTION	DATE	DESCRIPTION

CENTRAL FLORIDA EXPRESSWAY AUTHORITY

Concept, Feasability and Mobility Study
for the
Poinciana Parkway Extension / I-4 Connector

Alternative 2A-1

SHEET NO.
2A1-12

Bill.Lemos 3/21/2018 7:21:26 AM K:\ORL_TPTO\149800000___I-4 Connector\200_Engineering\CADD\roadway\Roadway Alignments\plans\plan2A_1-24.dgn

REFERENCE COPY

REVISIONS			
DATE	DESCRIPTION	DATE	DESCRIPTION

CENTRAL FLORIDA EXPRESSWAY AUTHORITY

Concept, Feasability and Mobility Study
for the
Poinciana Parkway Extension / I-4 Connector

Alternative 2A-1

SHEET NO.
2A1-13

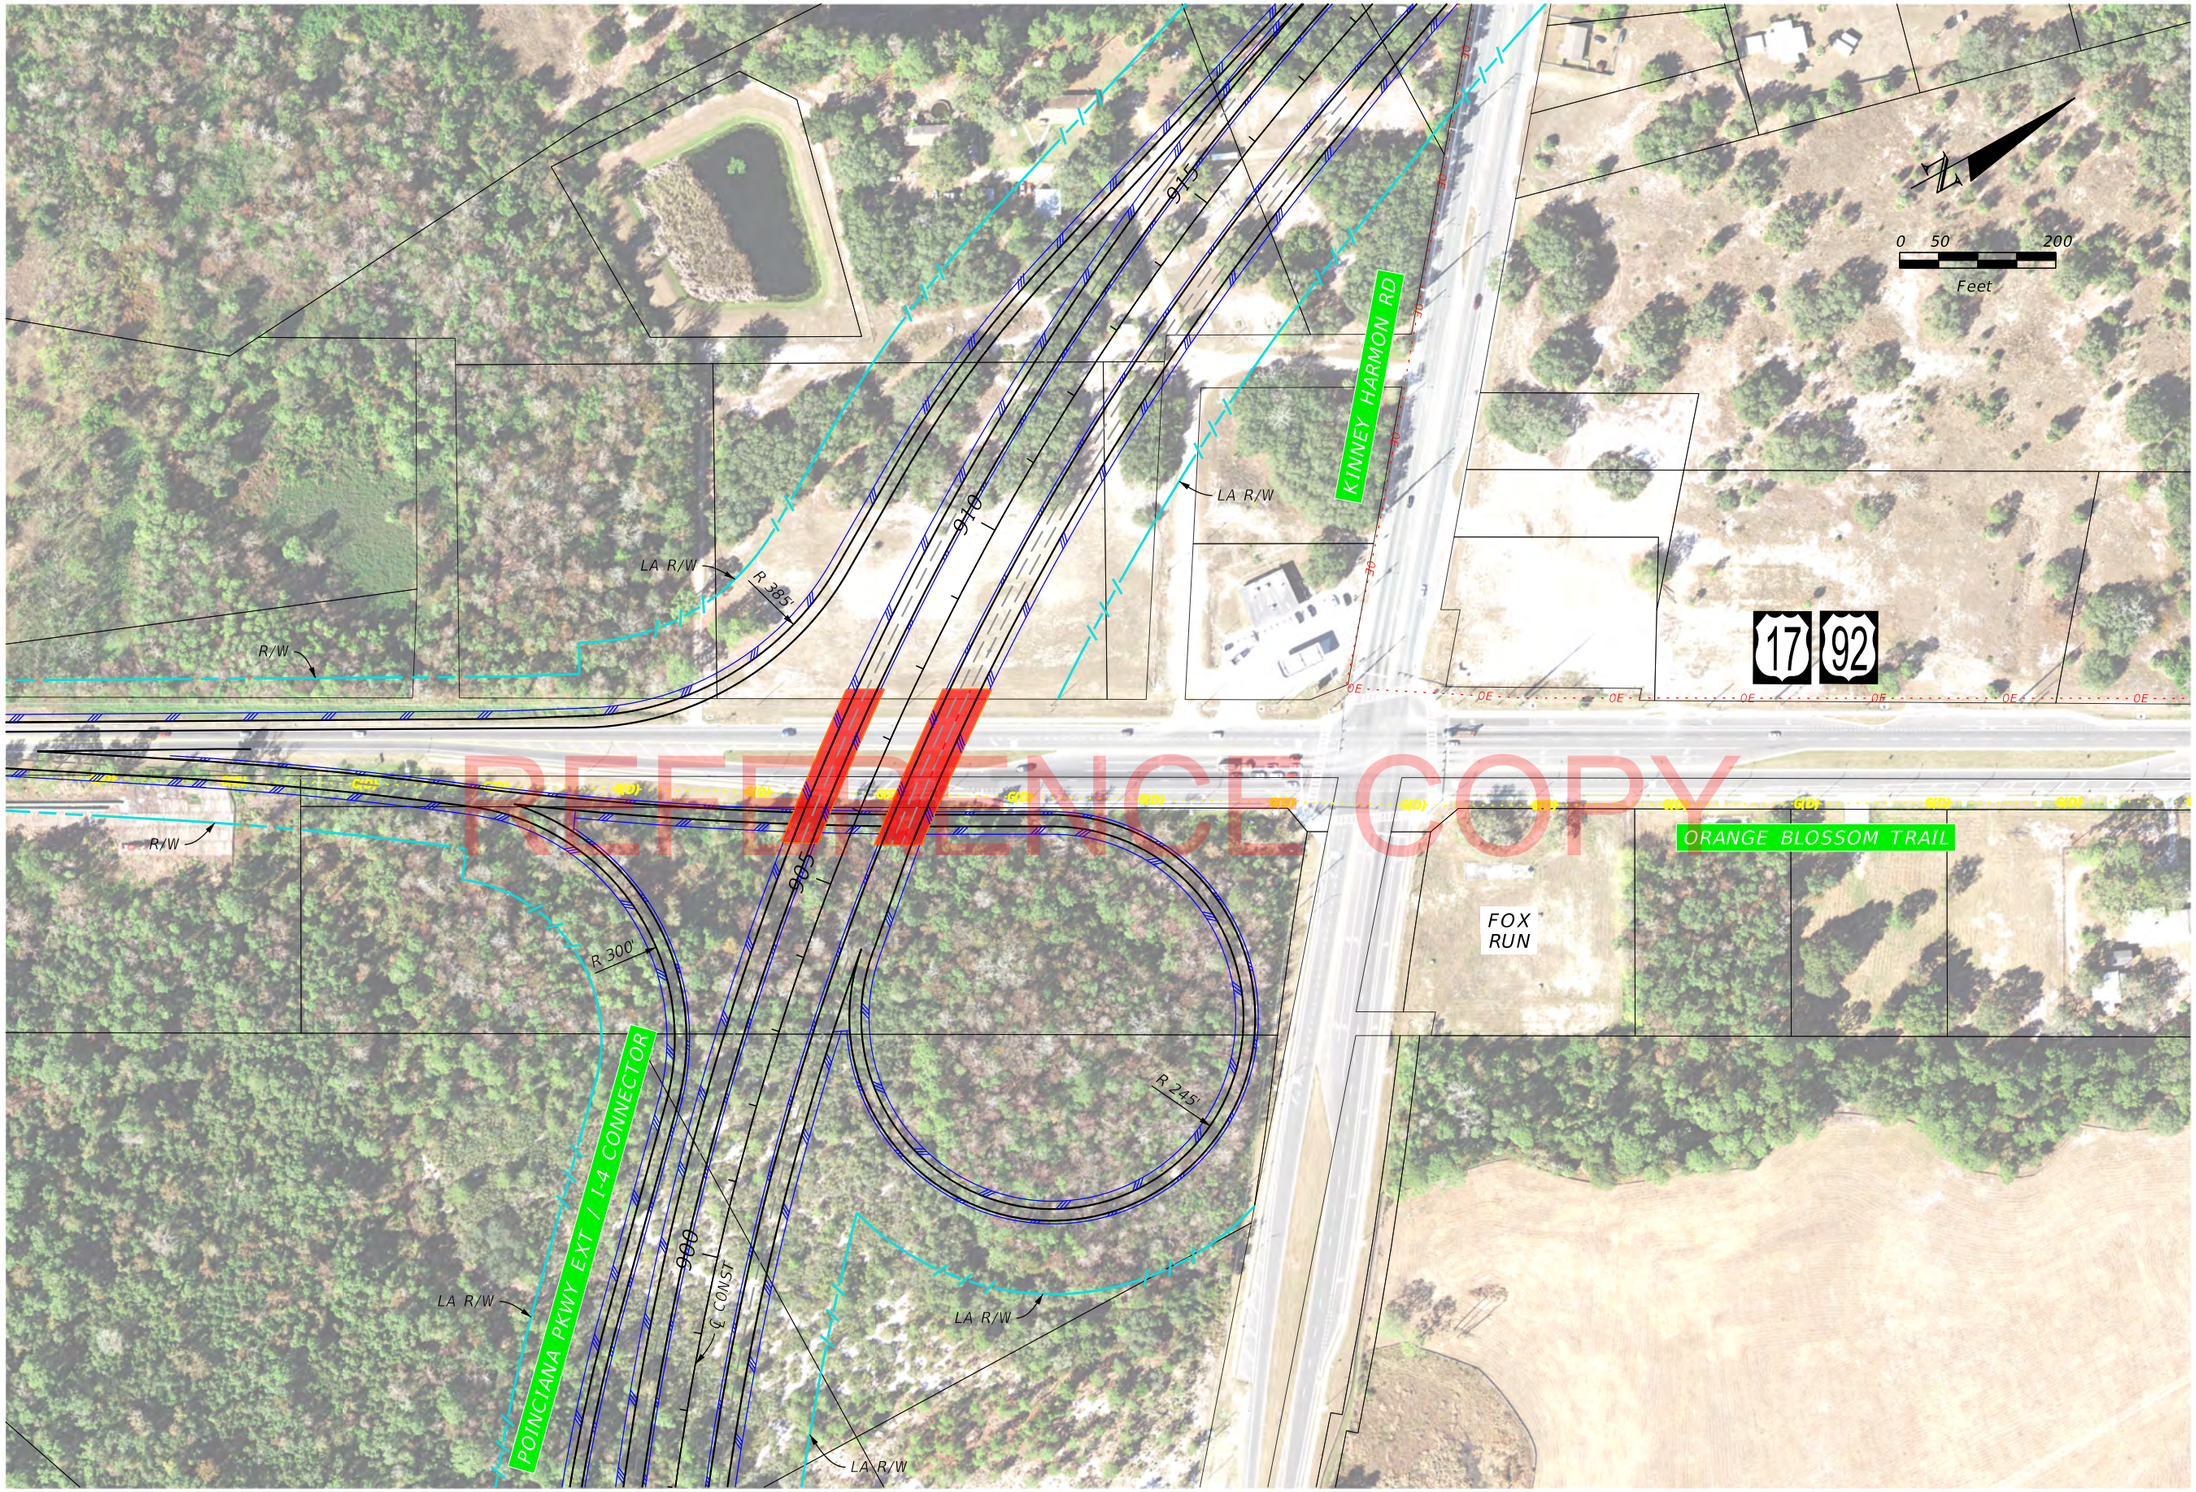

REFERENCE COPY

REVISIONS			
DATE	DESCRIPTION	DATE	DESCRIPTION

CENTRAL FLORIDA EXPRESSWAY AUTHORITY

Concept, Feasability and Mobility Study
for the
Poinciana Parkway Extension / I-4 Connector

Alternative 2A-1

SHEET NO.
2A1-14

Bill.Lemos 3/21/2018 7:23:34 AM K:\ORL_TPTO\149800000___I-4 Connector\200_Engineering\CADD\roadway\Roadway Alignments\plans\plan2A_1-26.dgn

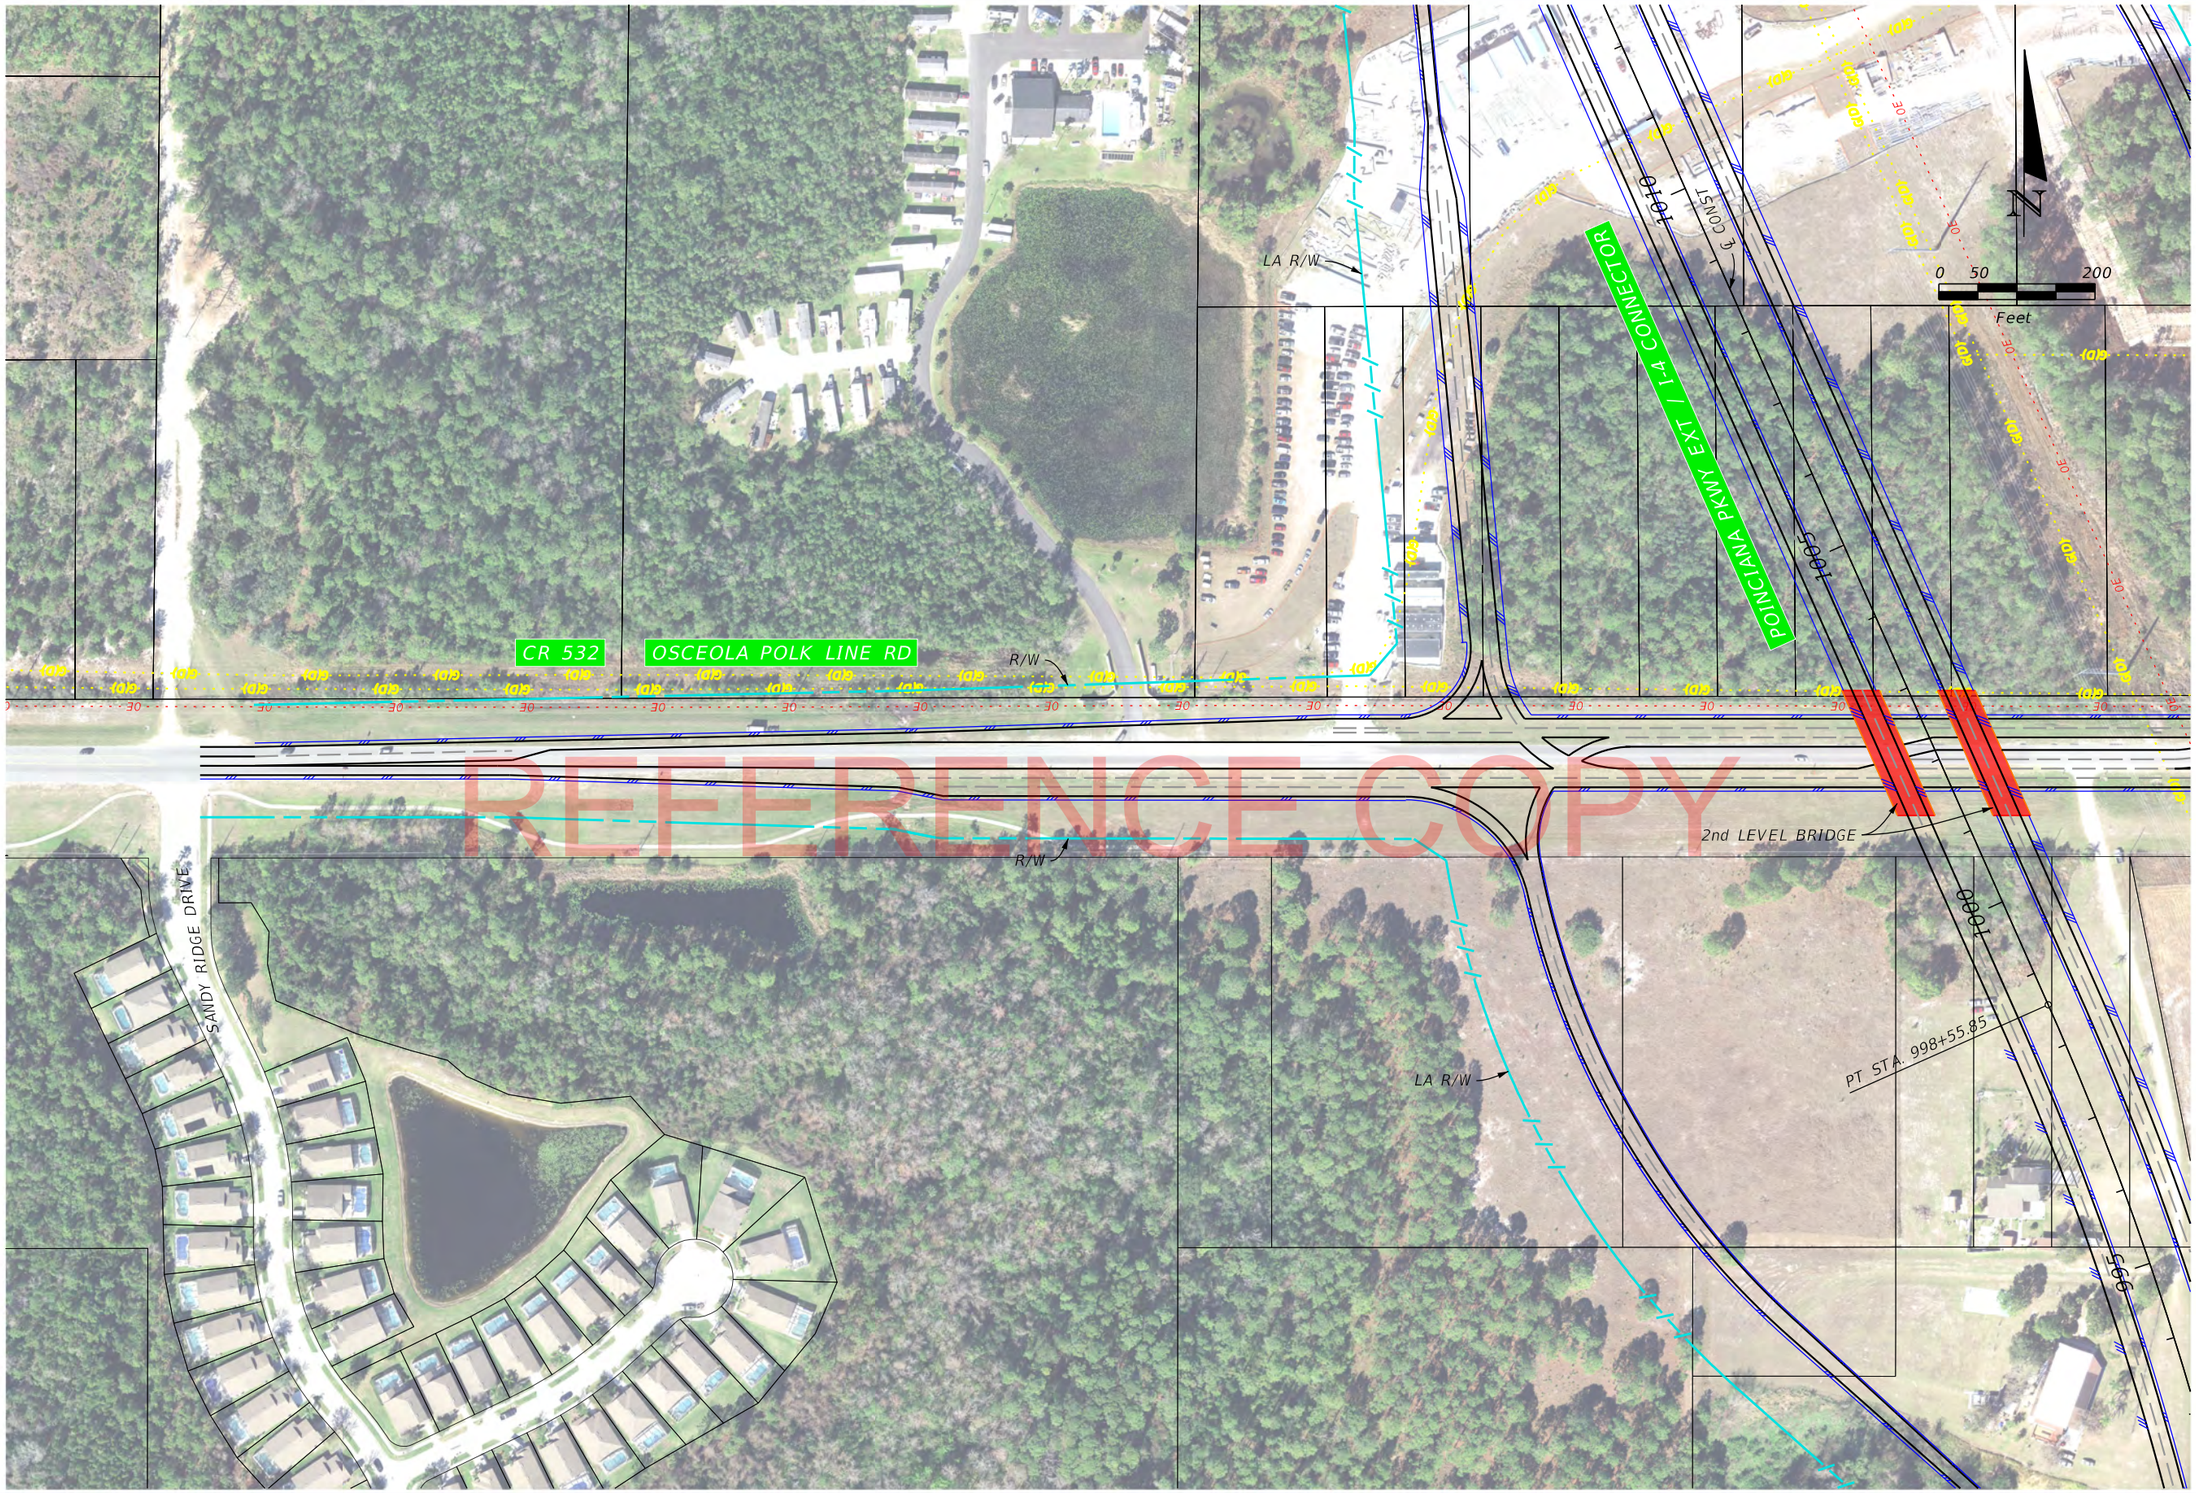

REFERENCE COPY

REVISIONS			
DATE	DESCRIPTION	DATE	DESCRIPTION

CENTRAL FLORIDA EXPRESSWAY AUTHORITY

Concept, Feasability and Mobility Study
for the
Poinciana Parkway Extension / I-4 Connector

Alternative 2A-1

SHEET NO.

2A1-15

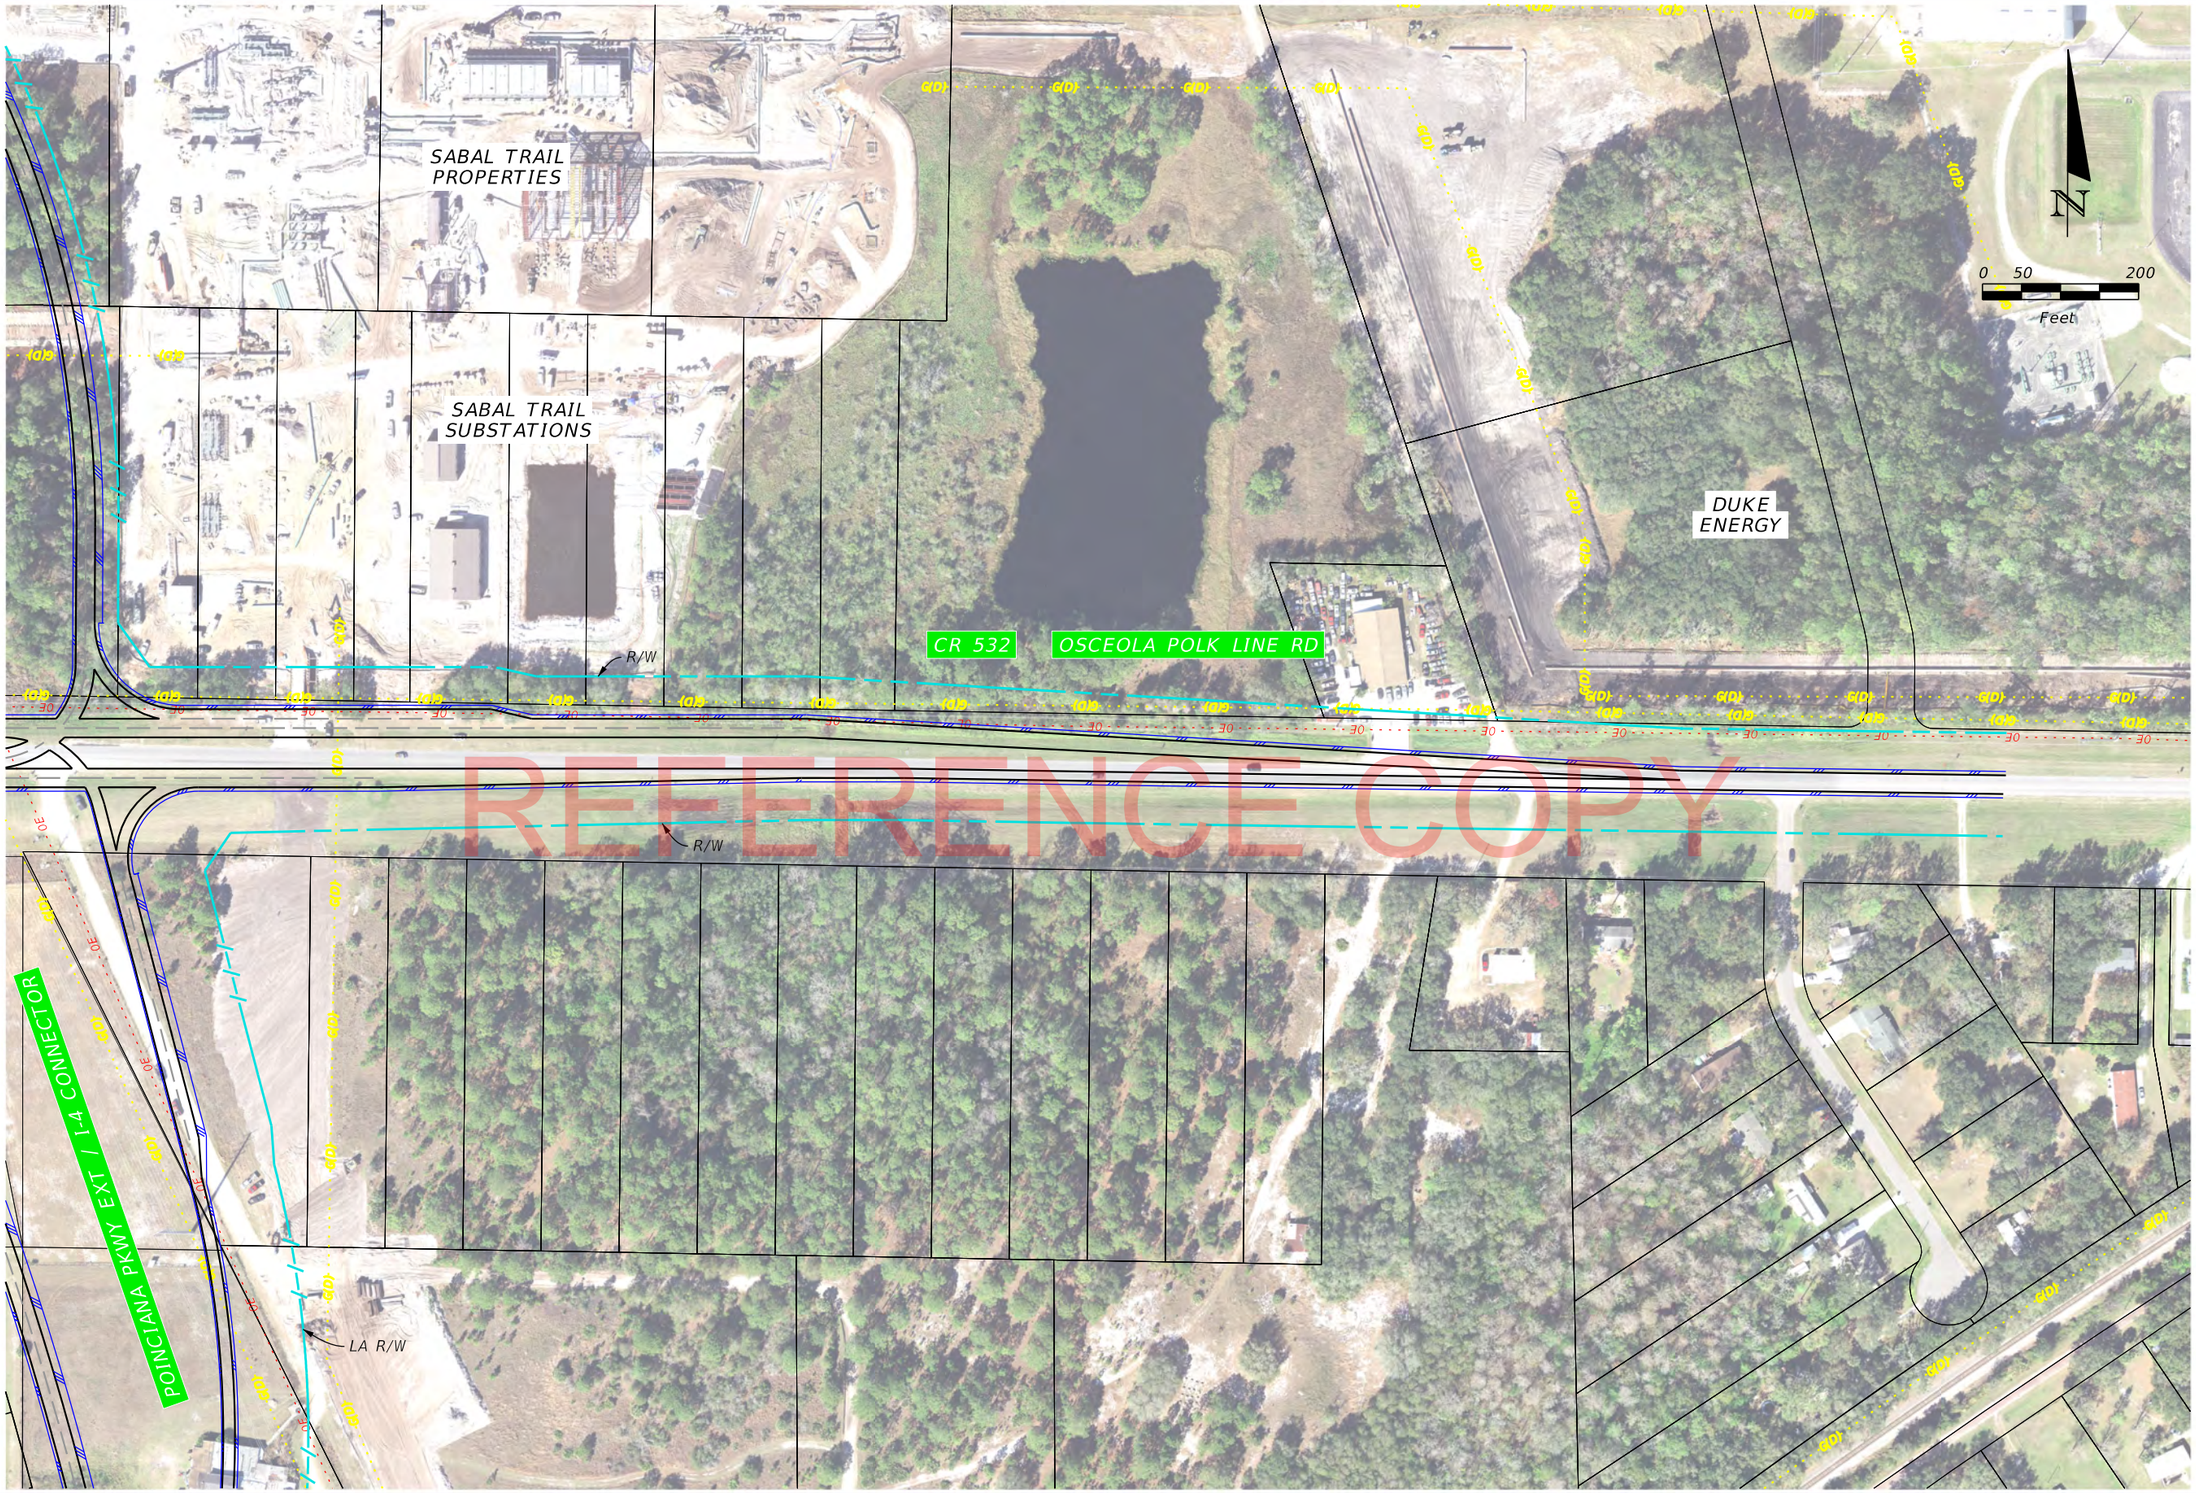

REFERENCE COPY

REVISIONS			
DATE	DESCRIPTION	DATE	DESCRIPTION

CENTRAL FLORIDA EXPRESSWAY AUTHORITY

Concept, Feasability and Mobility Study
for the
Poinciana Parkway Extension / I-4 Connector

Alternative 2A-1

SHEET NO.
2A1-16

Bill.Lemos 3/21/2018 7:24:54 AM K:\ORL_TPTO\149800000___I-4 Connector\200_Engineering\CADD\roadway\Roadway Alignments\plans\plan2A_1-28.dgn

APPENDIX H


REFERENCE COPY

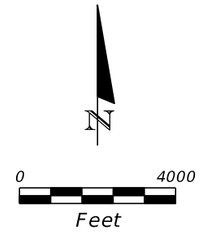

REFERENCE COPY

REVISIONS			
DATE	DESCRIPTION	DATE	DESCRIPTION

CENTRAL FLORIDA EXPRESSWAY AUTHORITY

Concept, Feasability and Mobility Study
for the
Poinciana Parkway Extension / I-4 Connector

Alternative 2A
I-4 Interchange at SR 429
North Alignment

SHEET NO.

NA-1

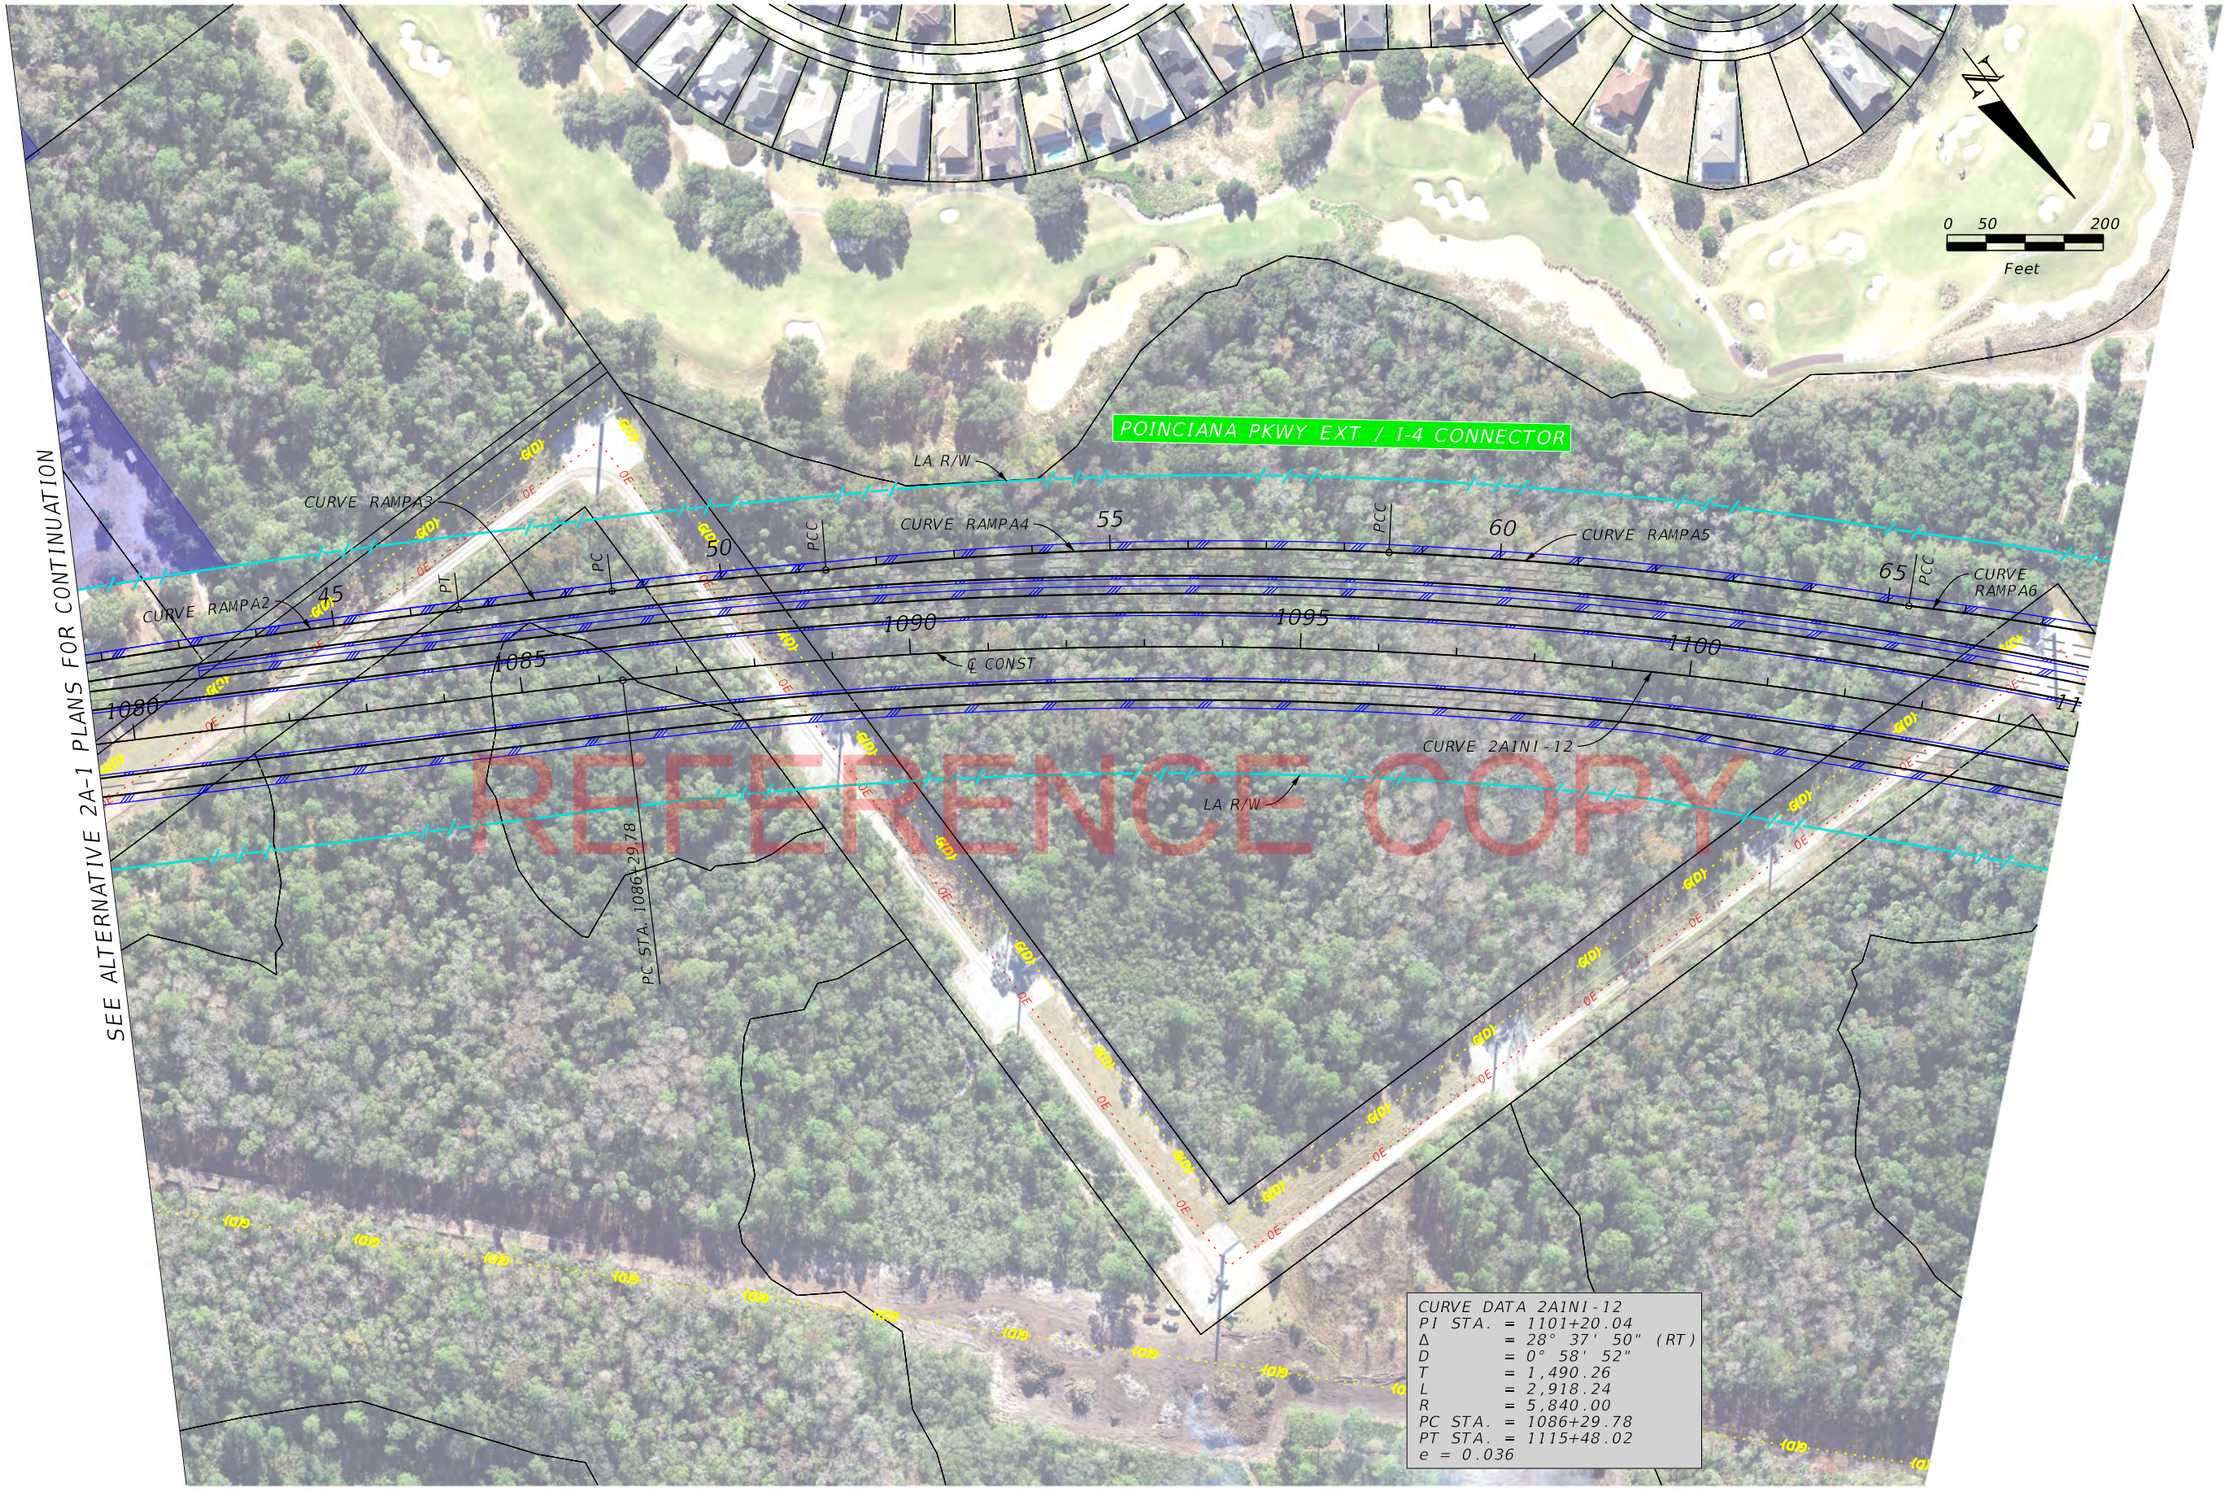

REFERENCE COPY

REVISIONS			
DATE	DESCRIPTION	DATE	DESCRIPTION

CENTRAL FLORIDA EXPRESSWAY AUTHORITY

Concept, Feasability and Mobility Study
for the
Poinciana Parkway Extension / I-4 Connector

Alternative 2A
I-4 Interchange at SR 429
North Alignment

SHEET NO.
NA-2

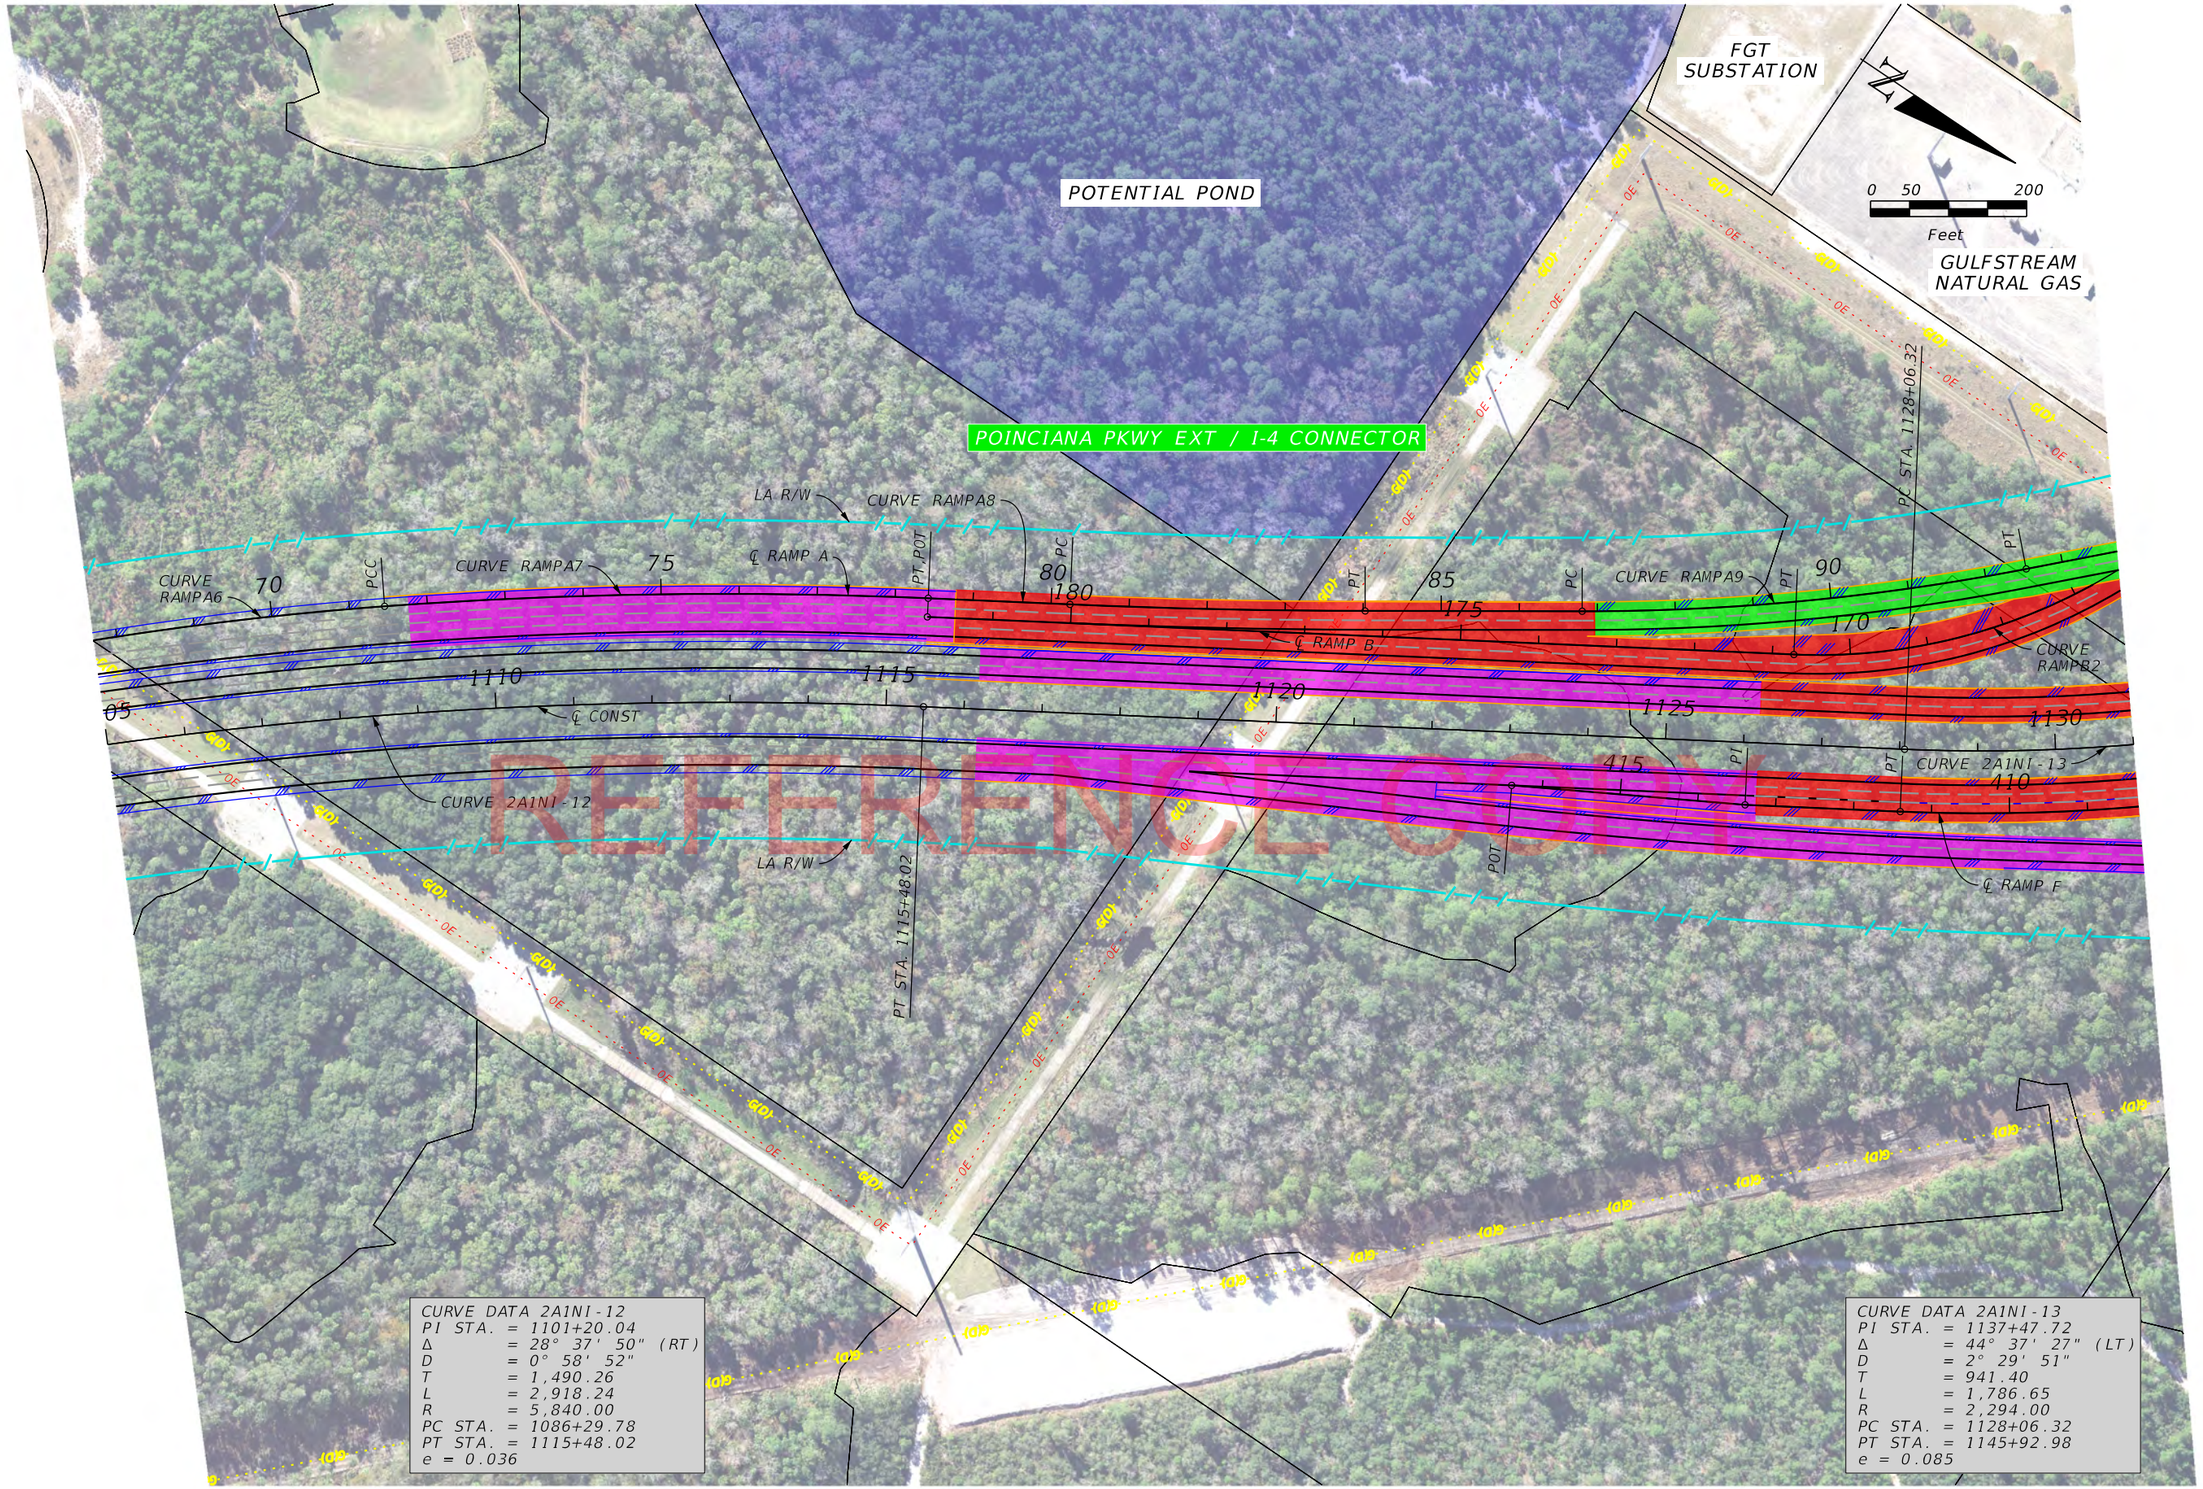

REVISIONS			
DATE	DESCRIPTION	DATE	DESCRIPTION

CENTRAL FLORIDA EXPRESSWAY AUTHORITY

Concept, Feasability and Mobility Study
for the
Poinciana Parkway Extension / I-4 Connector

Alternative 2A
I-4 Interchange at SR 429
North Alignment

SHEET NO.
NA-3

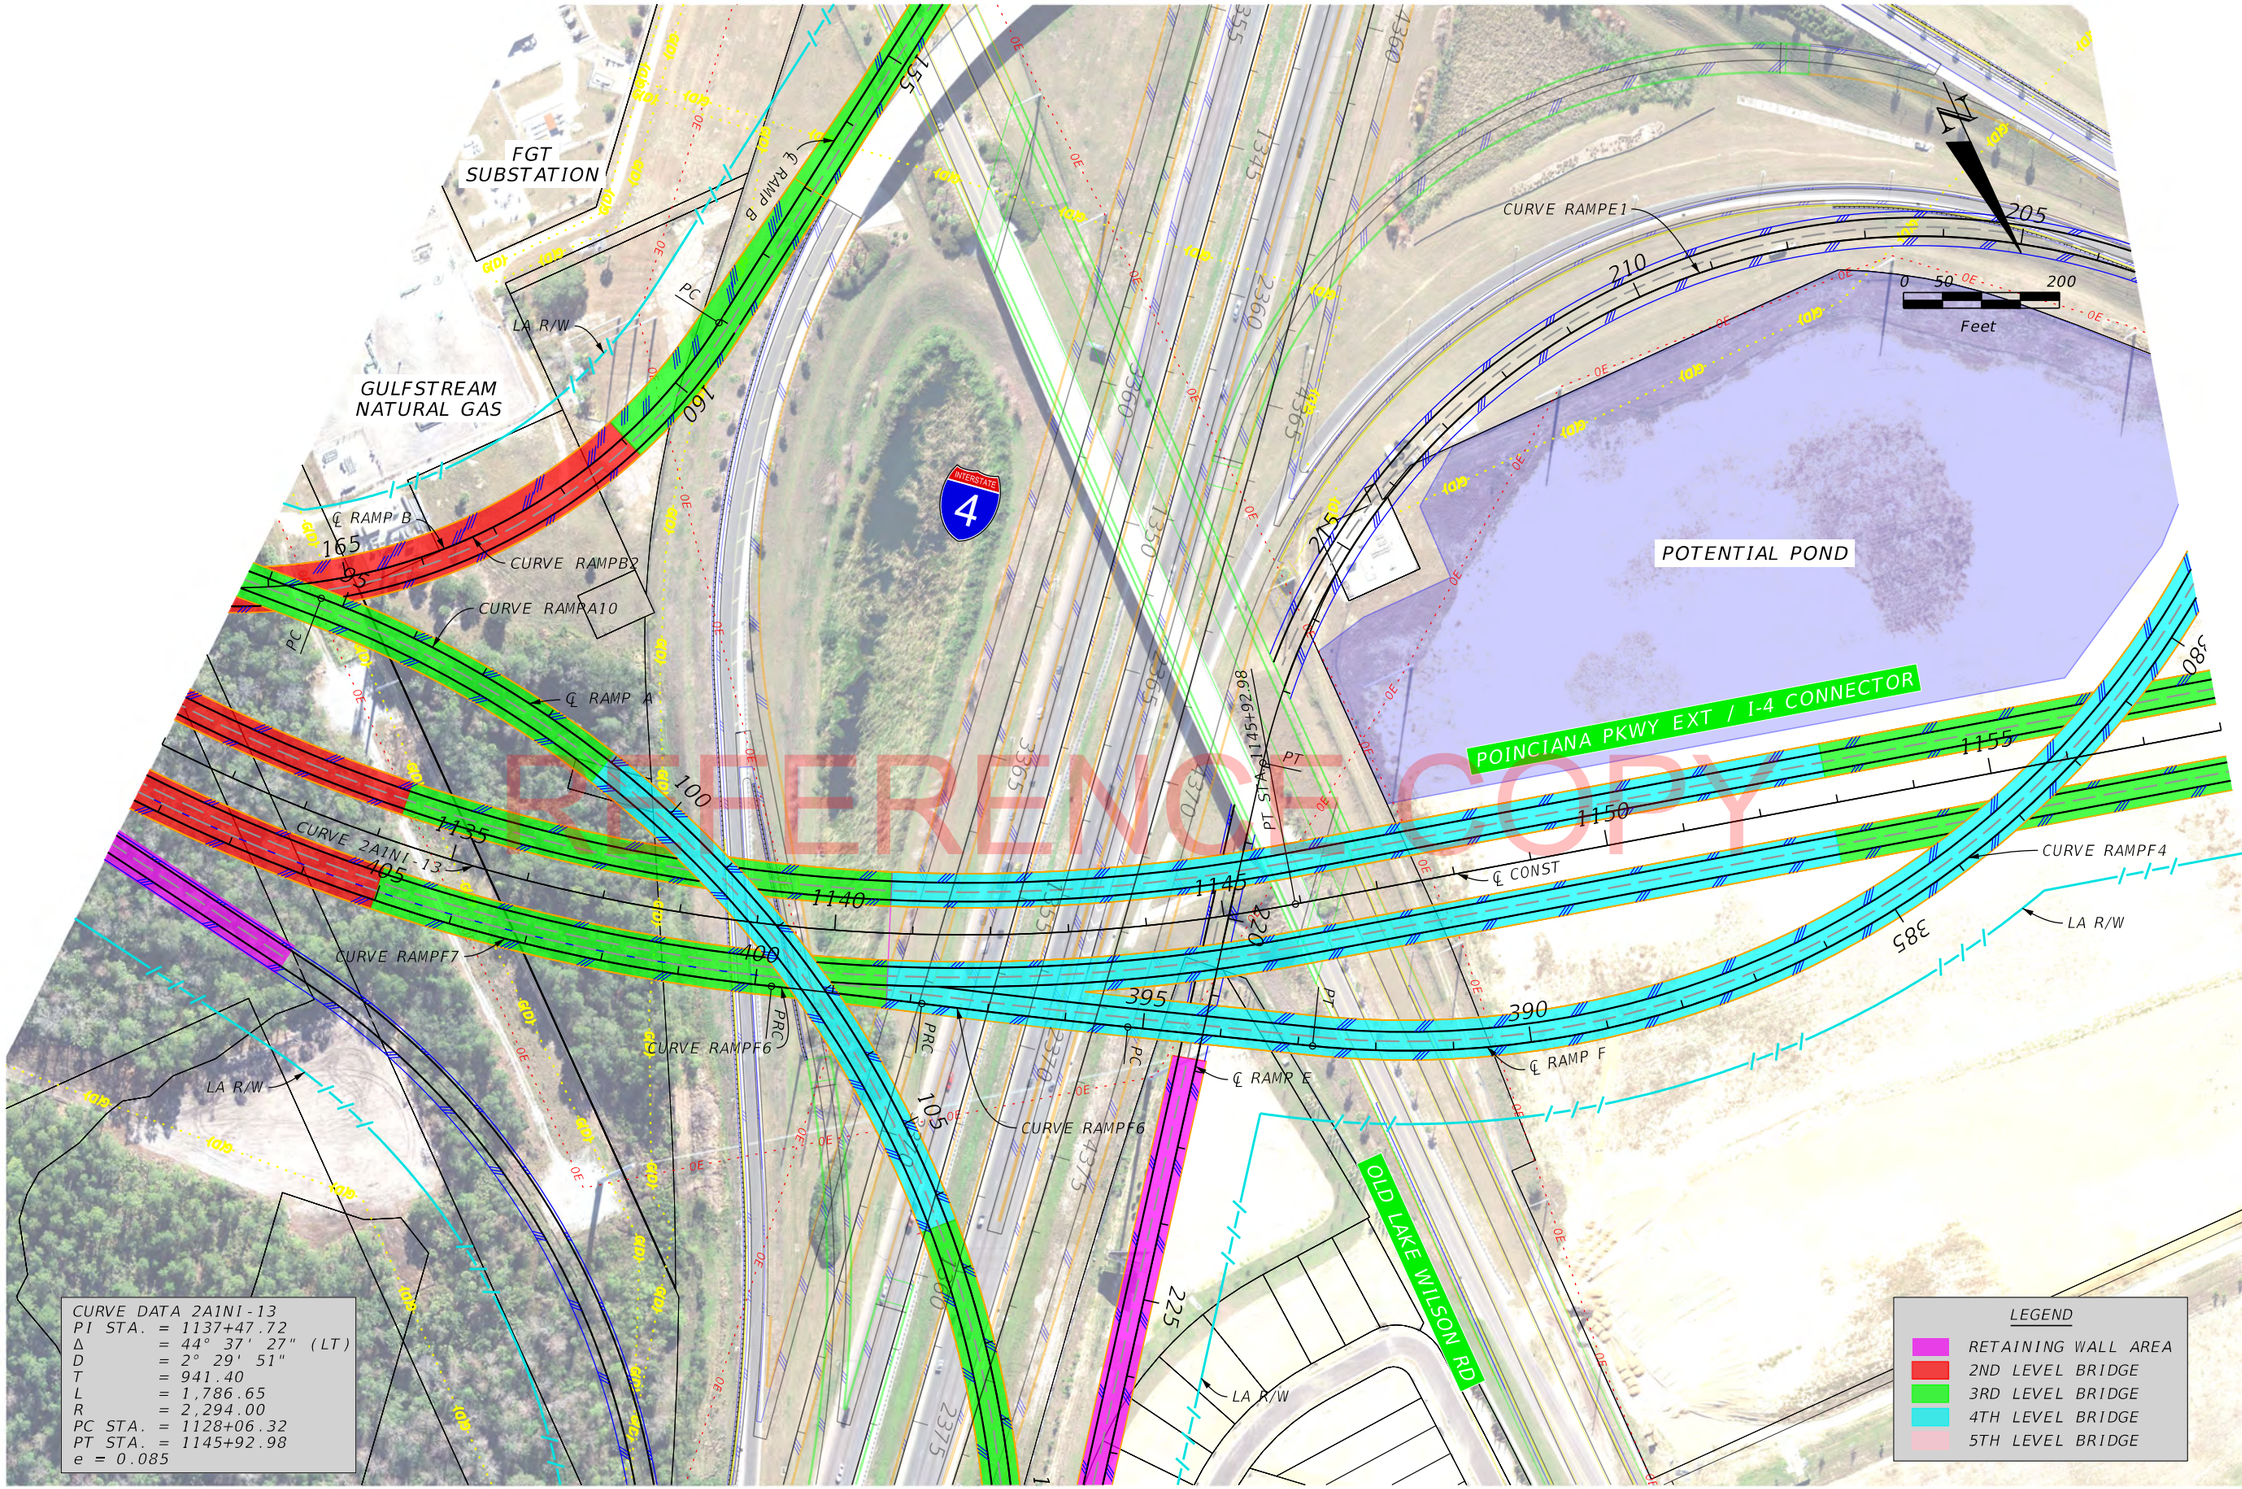

REFERENCE COPY

REVISIONS			
DATE	DESCRIPTION	DATE	DESCRIPTION

CENTRAL FLORIDA EXPRESSWAY AUTHORITY

Concept, Feasability and Mobility Study
for the
Poinciana Parkway Extension / I-4 Connector

Alternative 2A
I-4 Interchange at SR 429
North Alignment

SHEET NO.
NA-4

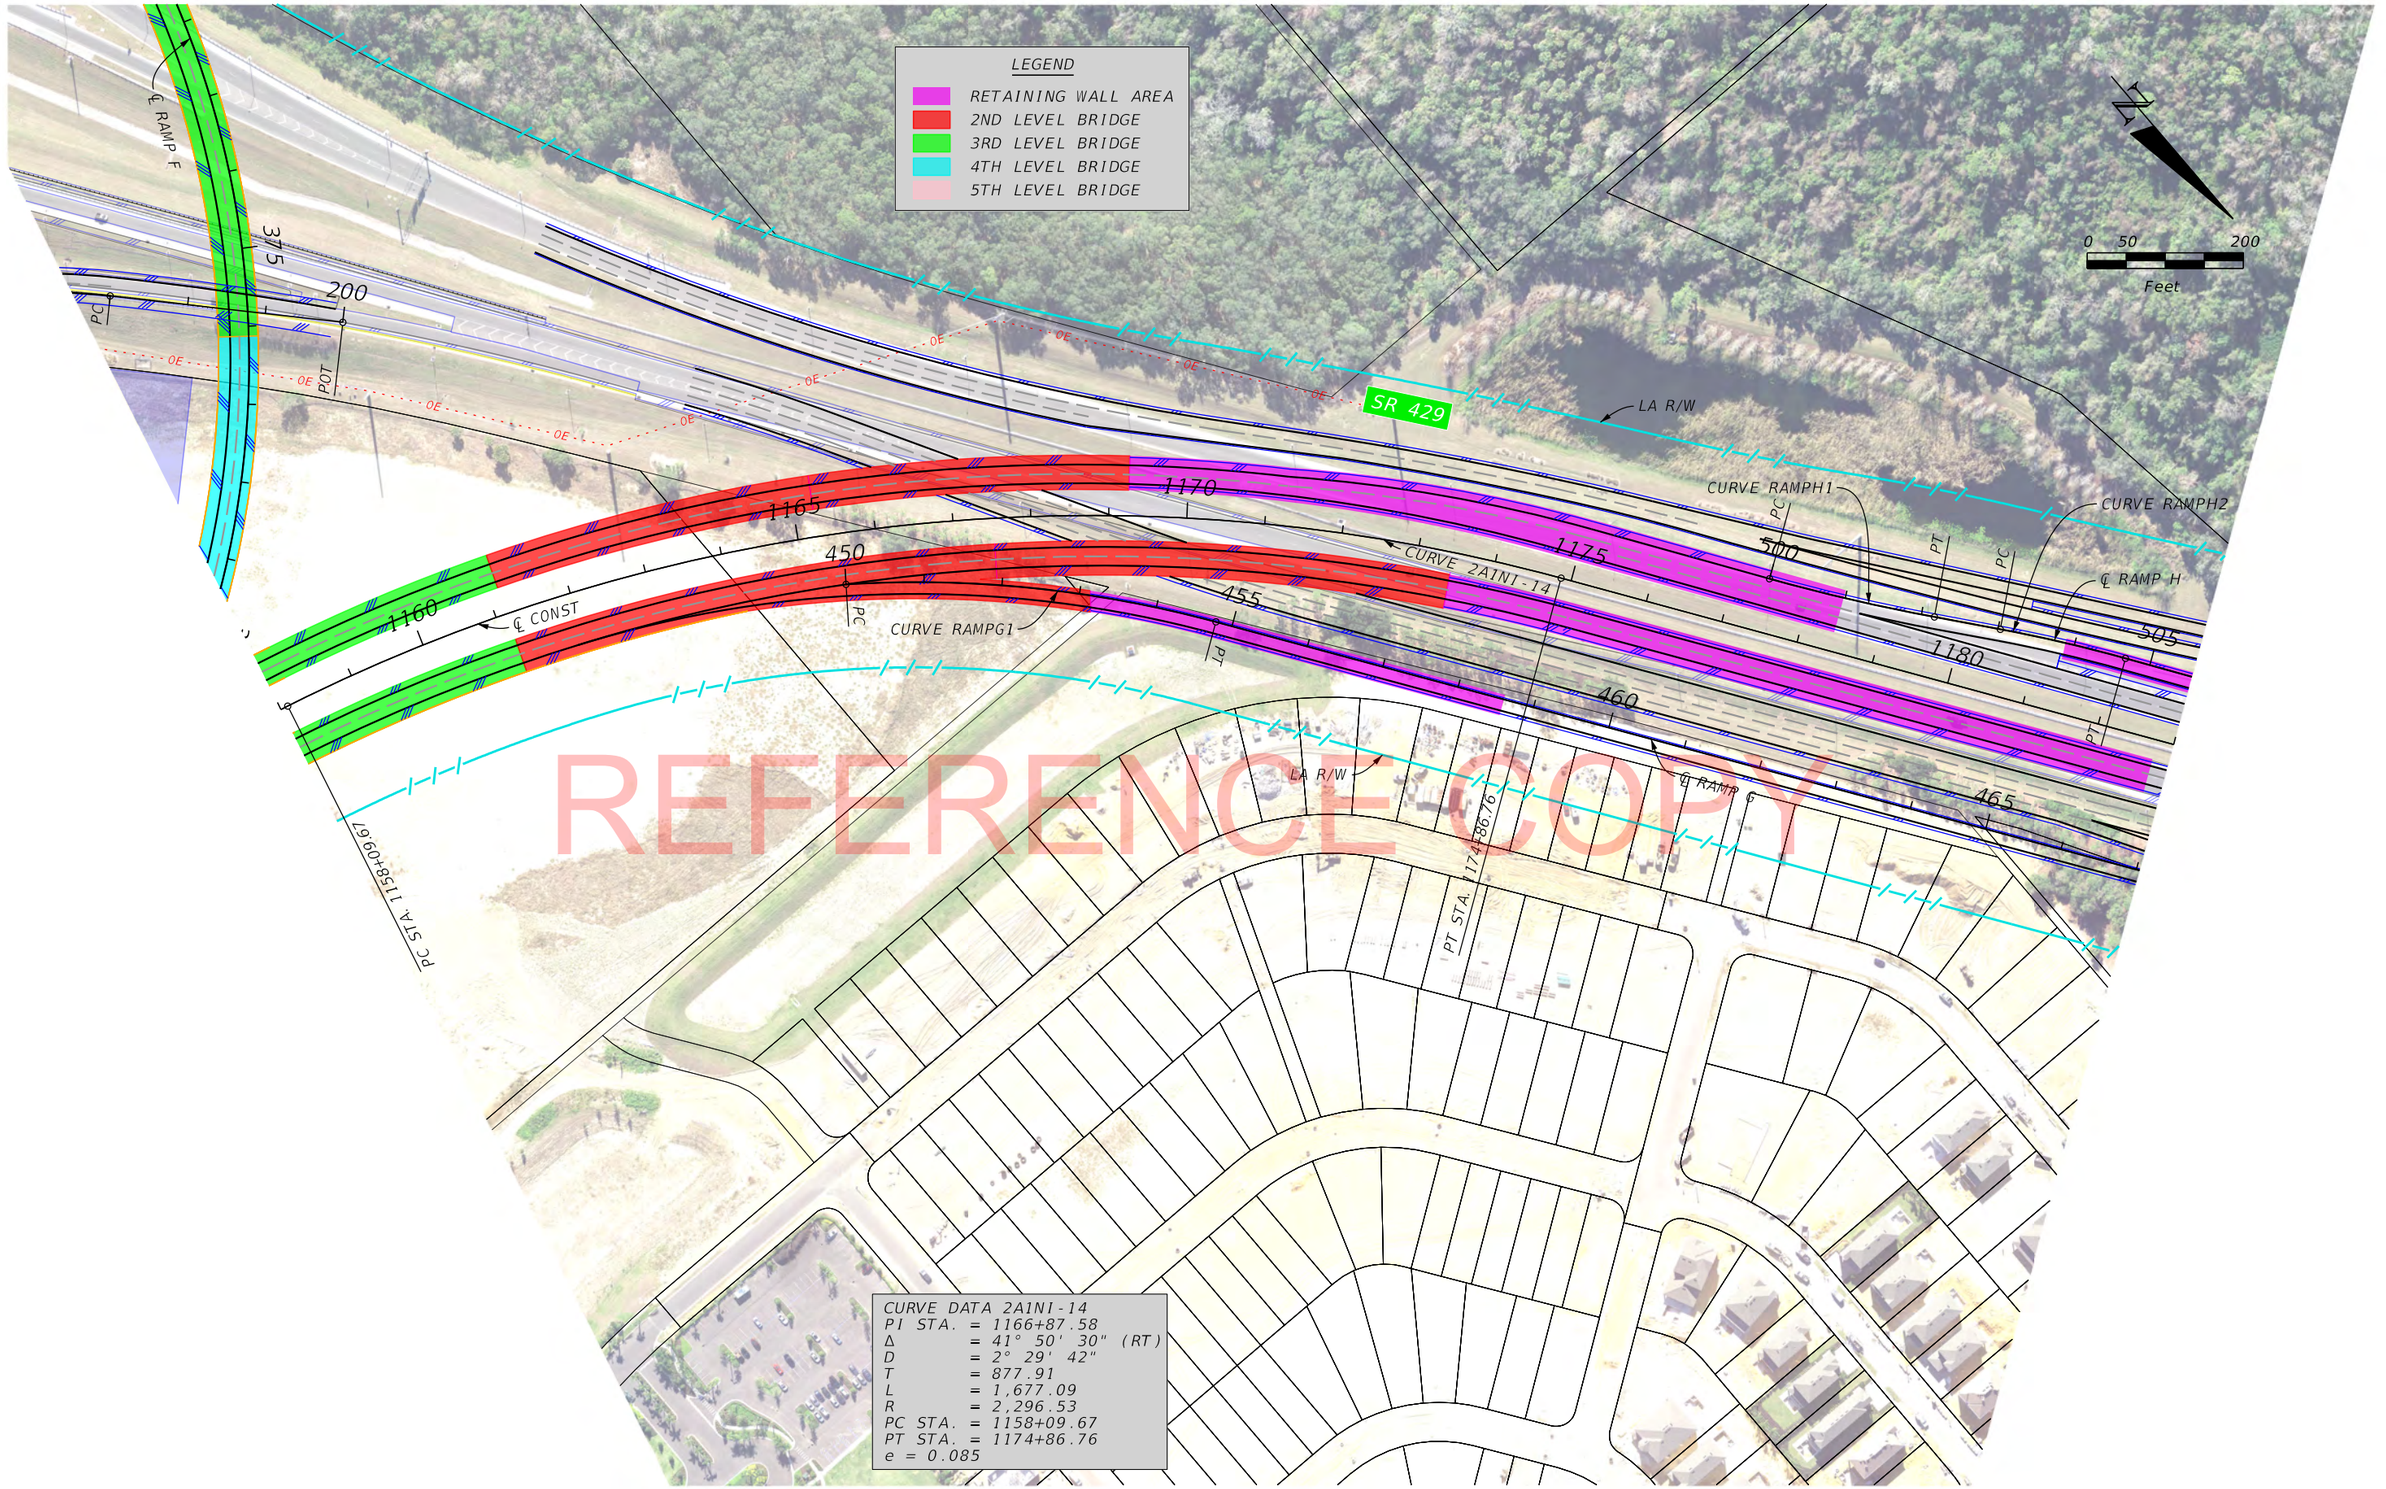

REFERENCE COPY

REVISIONS			
DATE	DESCRIPTION	DATE	DESCRIPTION

CENTRAL FLORIDA EXPRESSWAY AUTHORITY

Concept, Feasability and Mobility Study
for the
Poinciana Parkway Extension / I-4 Connector

Alternative 2A
I-4 Interchange at SR 429
North Alignment

SHEET NO.

NA-5

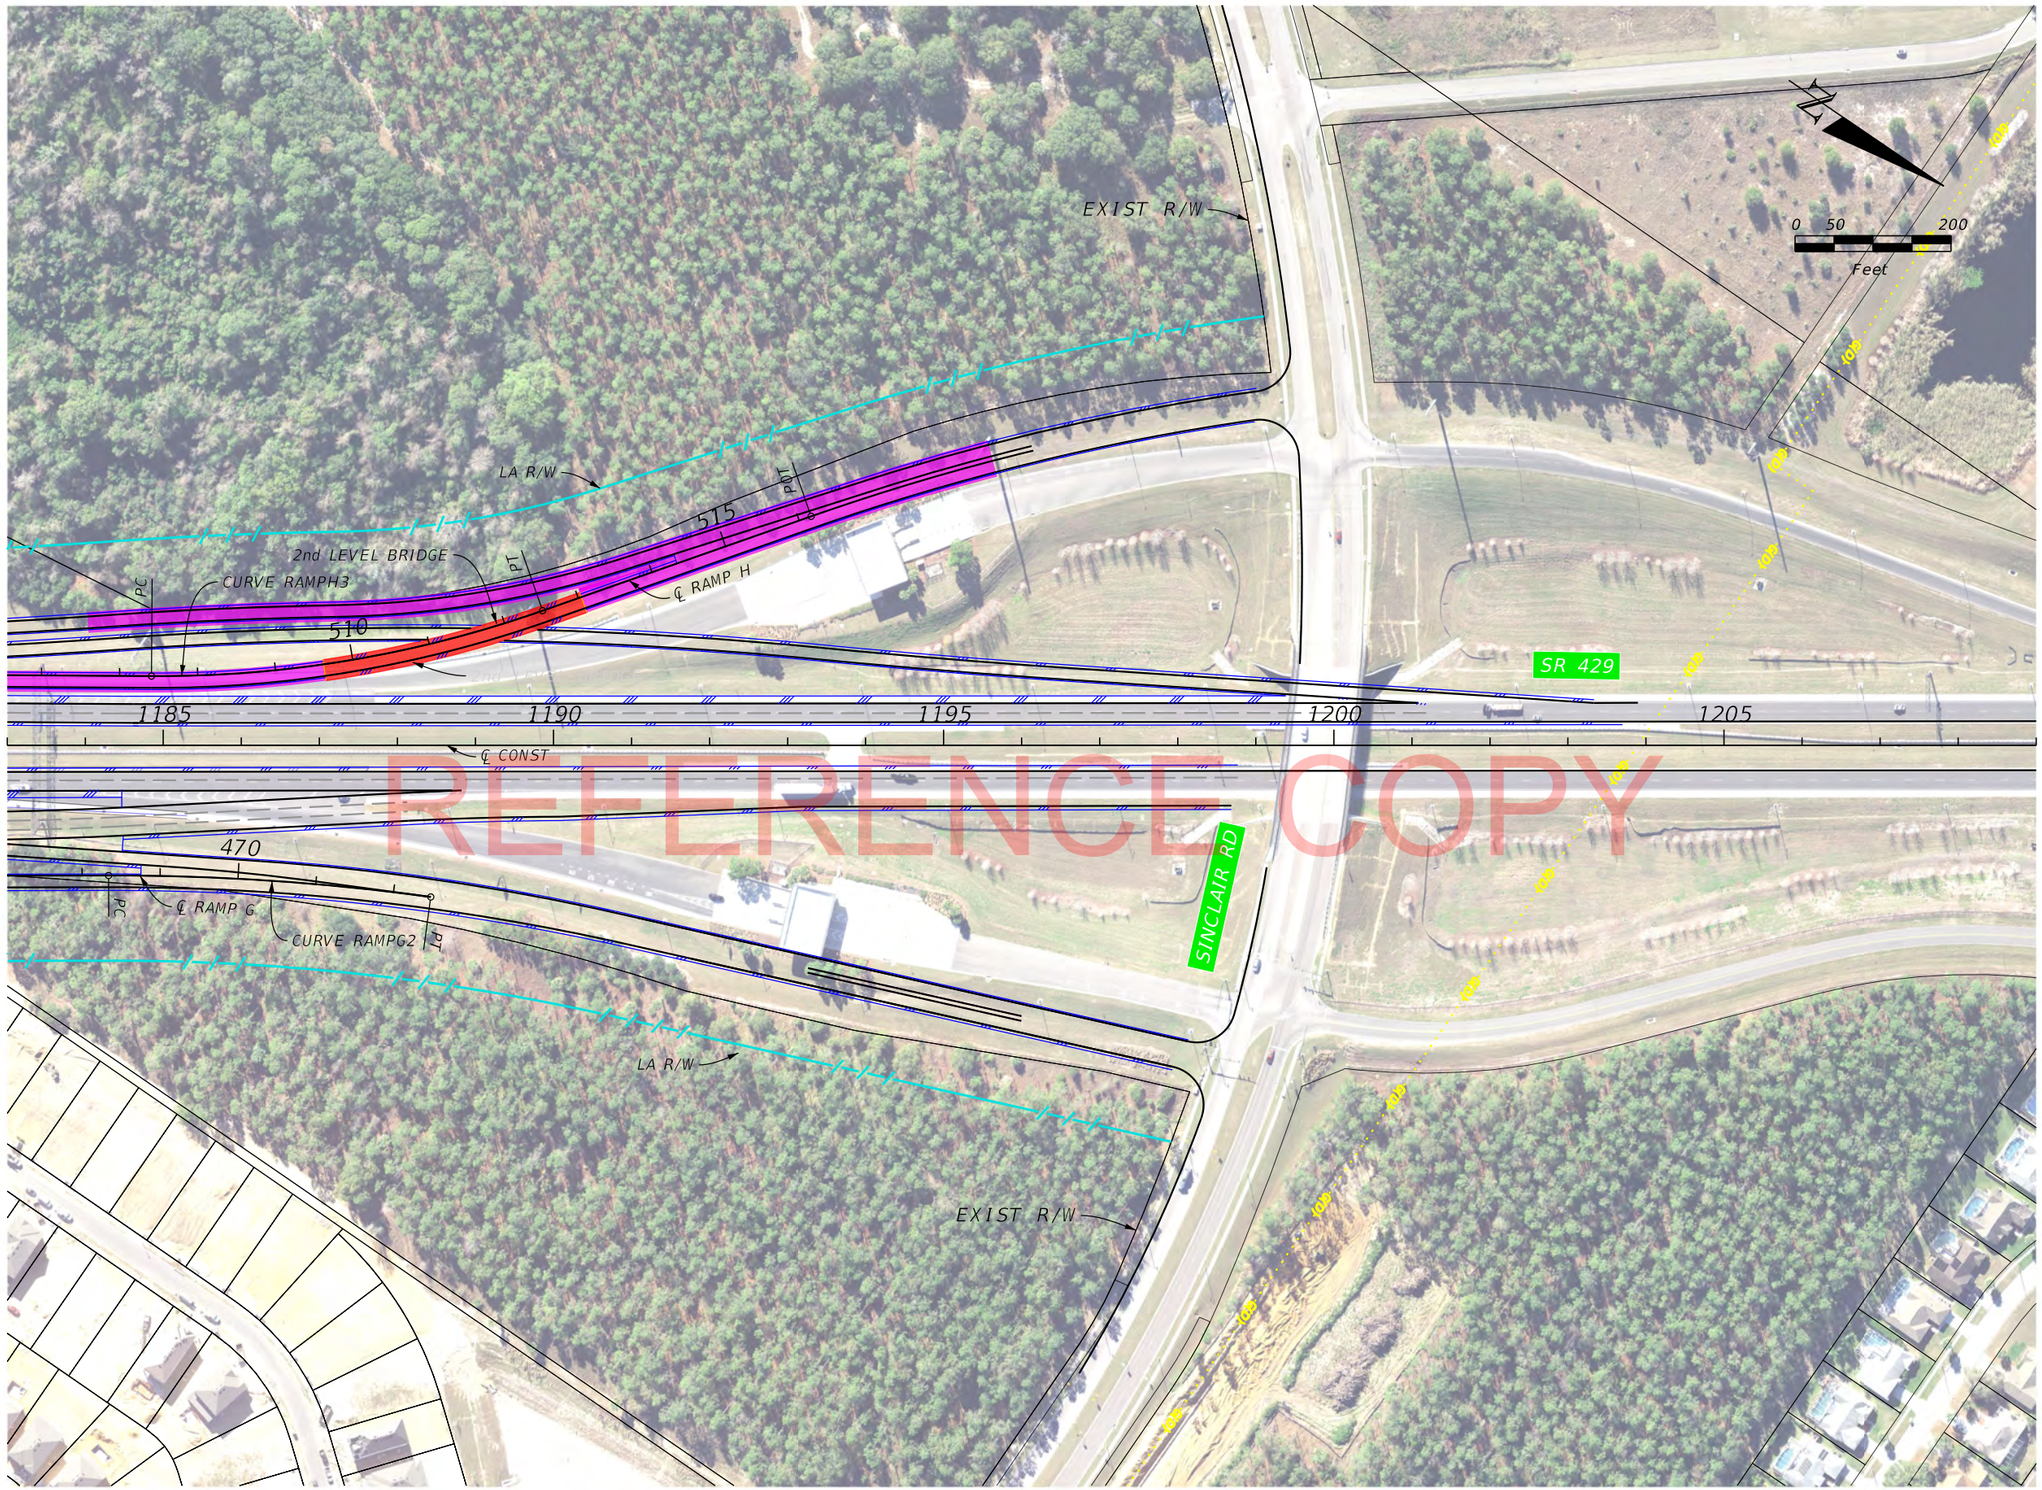

REFERENCE COPY

REVISIONS			
DATE	DESCRIPTION	DATE	DESCRIPTION

CENTRAL FLORIDA EXPRESSWAY AUTHORITY

Concept, Feasability and Mobility Study
for the
Poinciana Parkway Extension / I-4 Connector

Alternative 2A
I-4 Interchange at SR 429
North Alignment

SHEET NO.
NA-6

REFERENCE COPY

REVISIONS			
DATE	DESCRIPTION	DATE	DESCRIPTION

CENTRAL FLORIDA EXPRESSWAY AUTHORITY

Concept, Feasability and Mobility Study
for the
Poinciana Parkway Extension / I-4 Connector

Alternative 2A
I-4 Interchange at SR 429
North Alignment

SHEET NO.
NA-7

Bill.Lemos 3/21/2018 4:20:34 PM K:\ORL_TPTO\149800000___I-4 Connector\200_Engineering\CADD\roadway\Roadway Alignments\plans\plan2A_NI-29.dgn

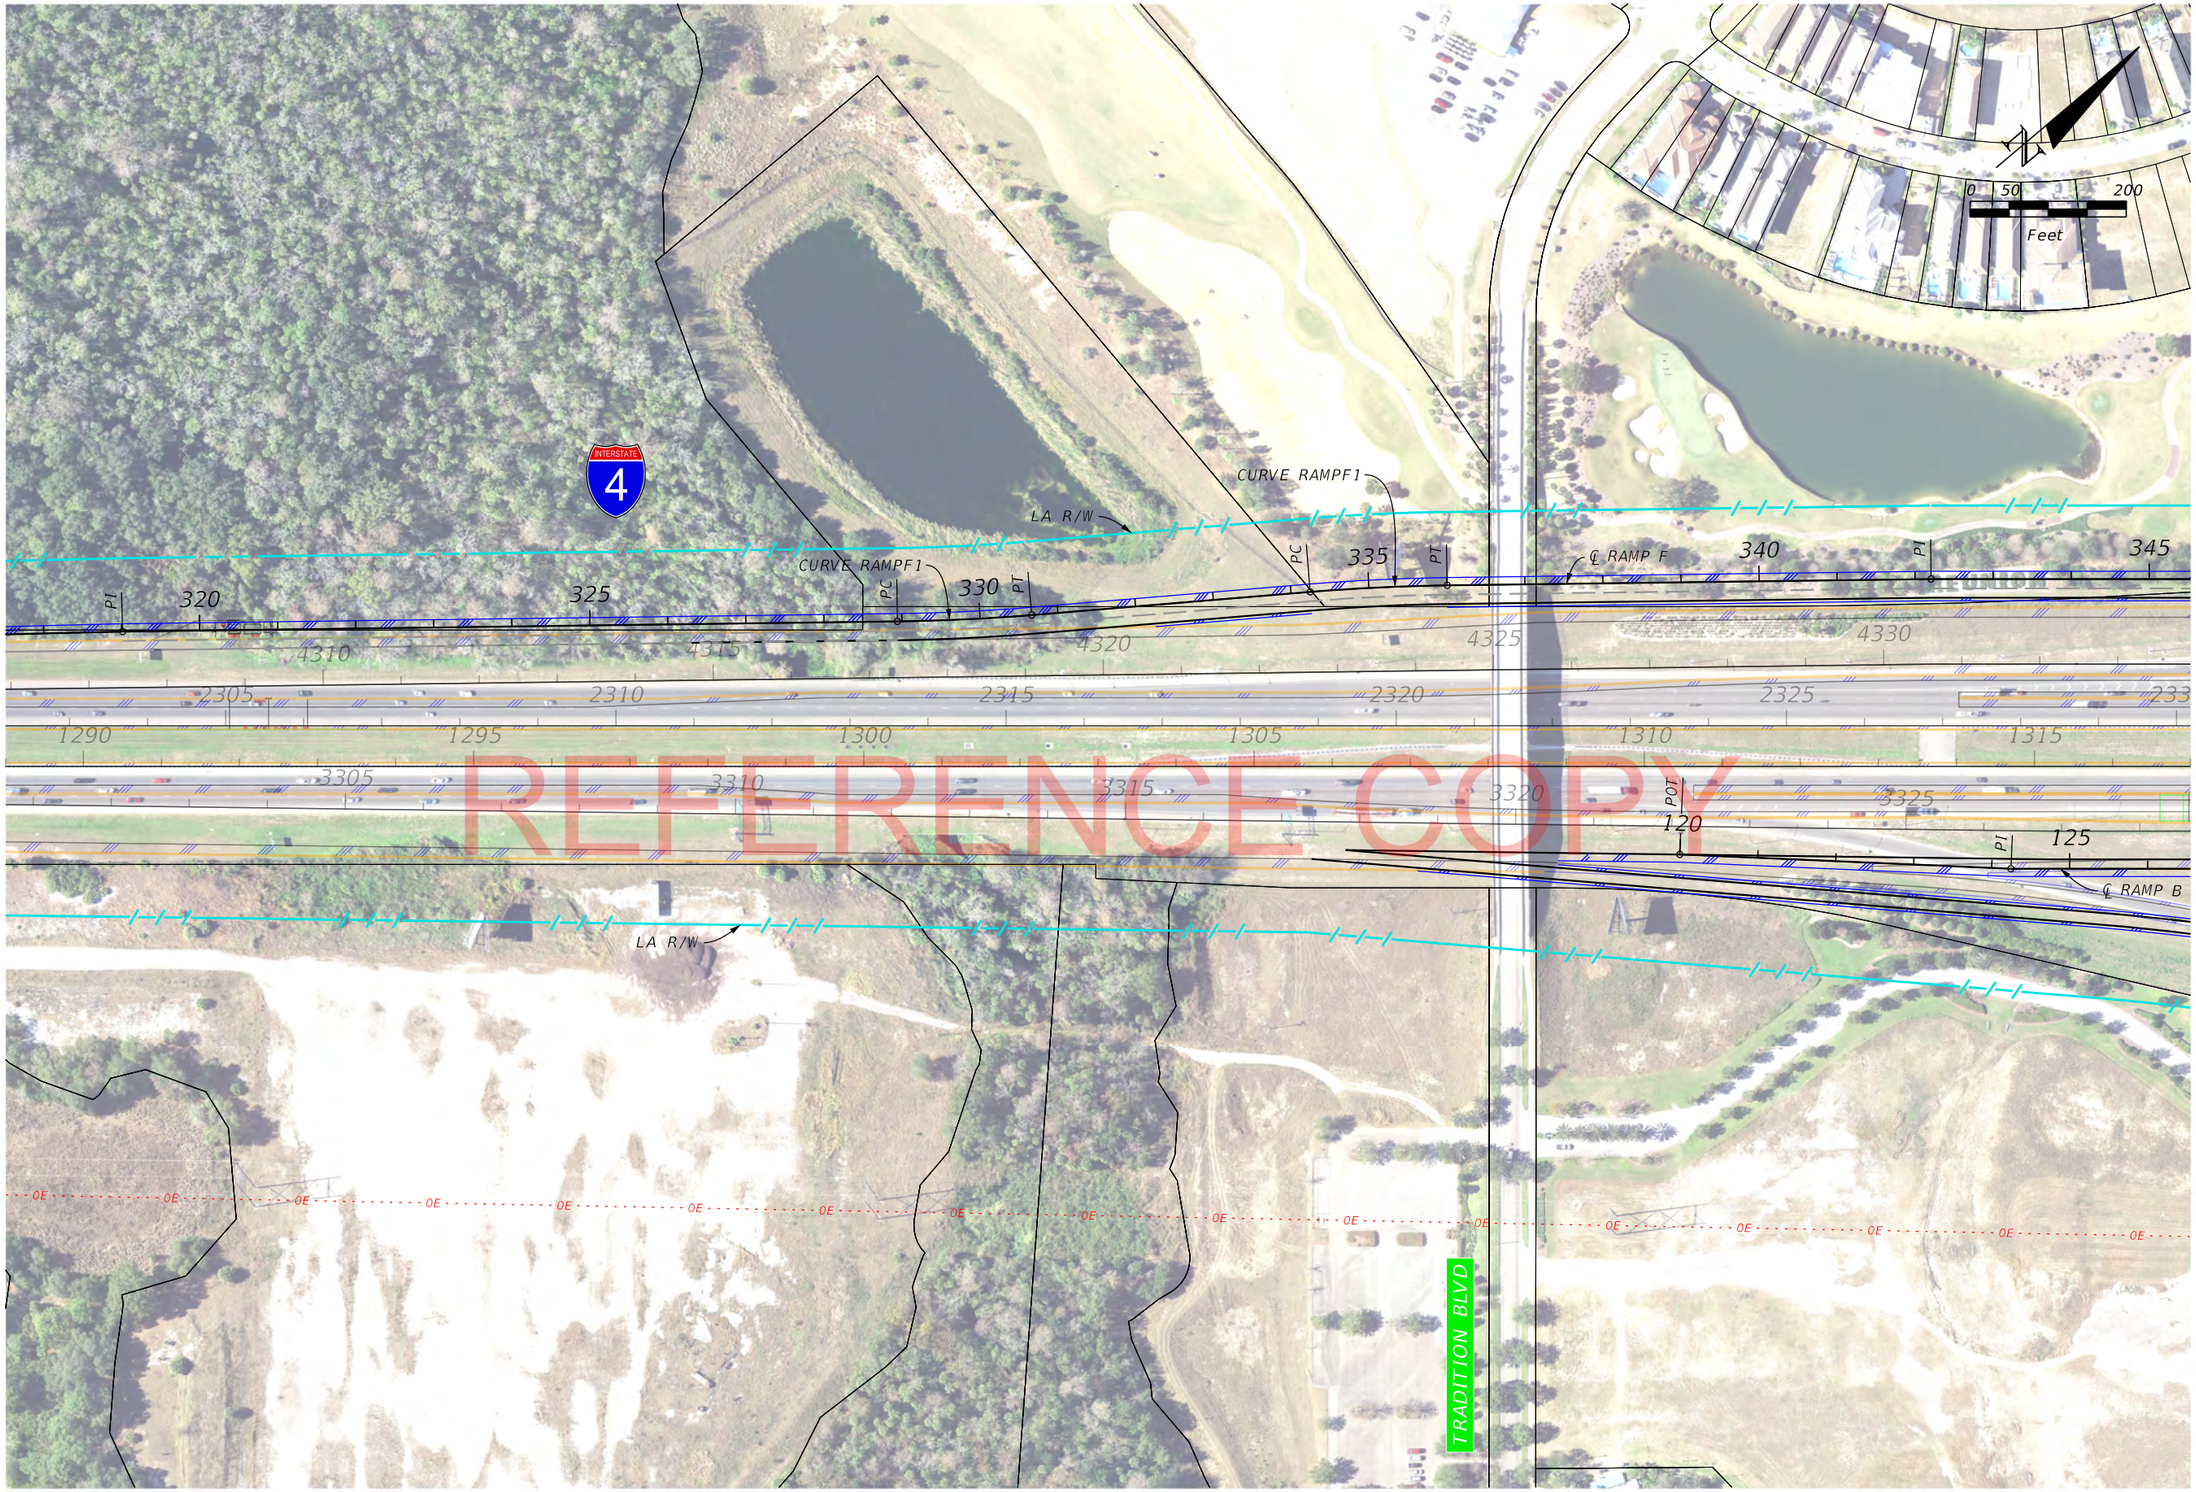

REFERENCE COPY

REVISIONS			
DATE	DESCRIPTION	DATE	DESCRIPTION

CENTRAL FLORIDA EXPRESSWAY AUTHORITY

Concept, Feasability and Mobility Study
for the
Poinciana Parkway Extension / I-4 Connector

Alternative 2A
I-4 Interchange at SR 429
North Alignment

SHEET NO.
NA-8

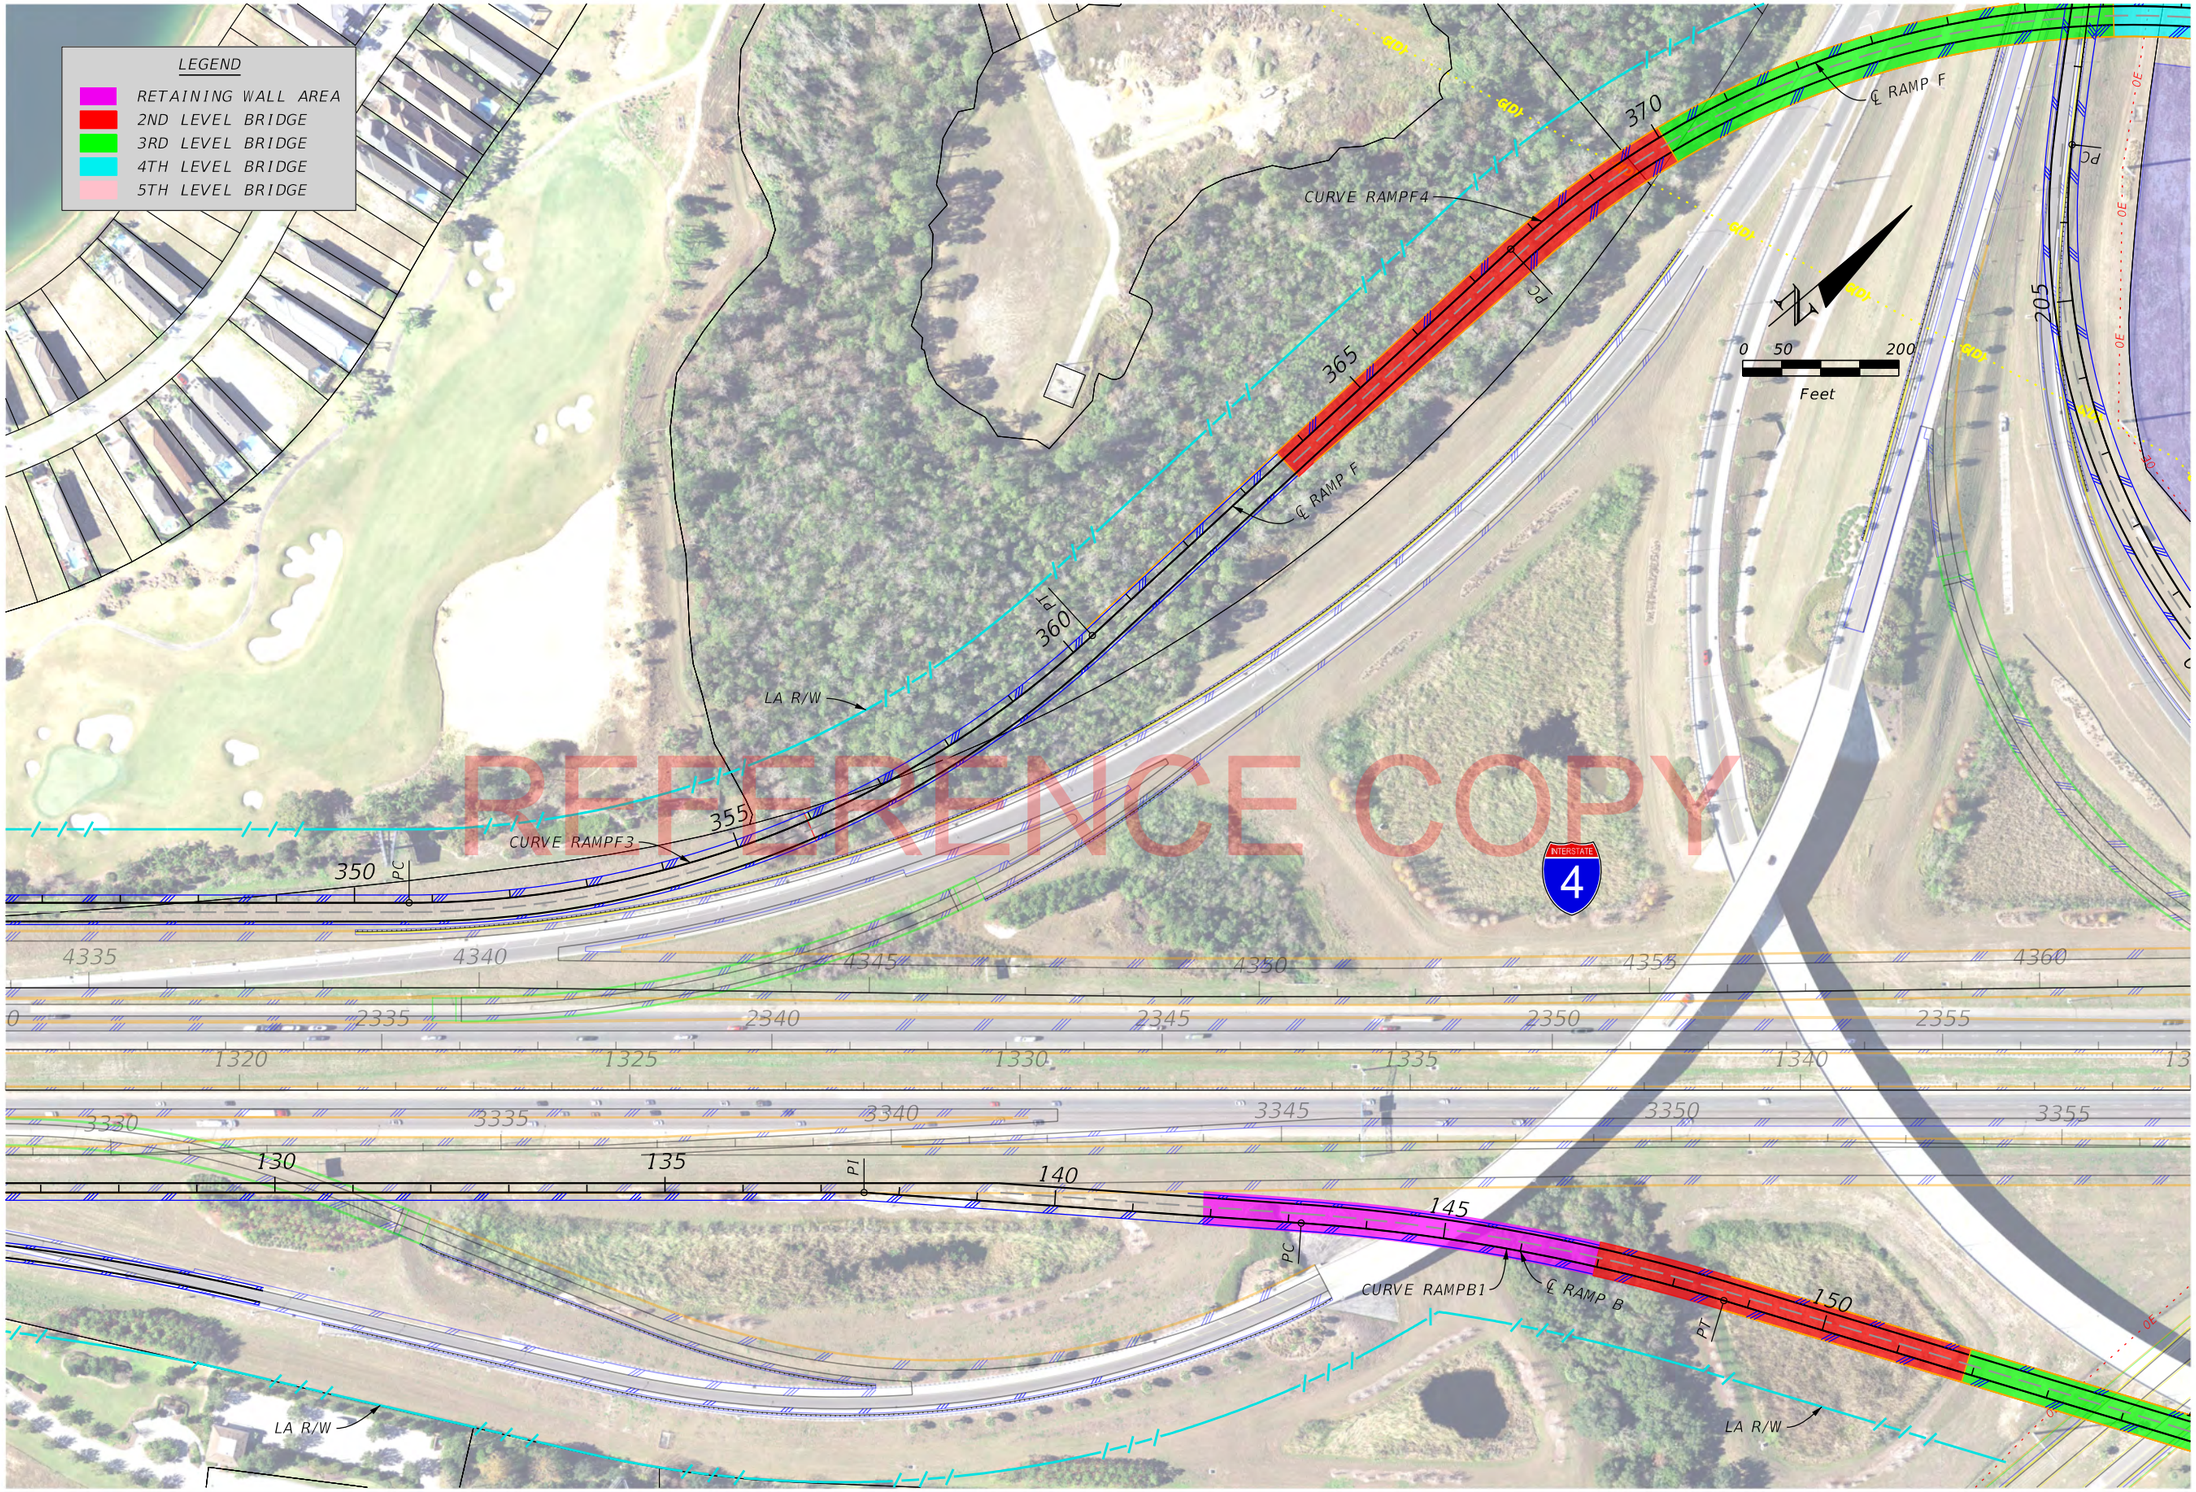

PREFERENCE COPY

REVISIONS			
DATE	DESCRIPTION	DATE	DESCRIPTION

CENTRAL FLORIDA EXPRESSWAY AUTHORITY

Concept, Feasability and Mobility Study
for the
Poinciana Parkway Extension / I-4 Connector

Alternative 2A
I-4 Interchange at SR 429
North Alignment

SHEET NO.

NA-9

Bill.Lemos 3/21/2018 4:23:21 PM K:\ORL_TPTO\149800000___I-4 Connector\200_Engineering\CADD\roadway\Roadway Alignments\plans\plan2A_NI-31.dgn

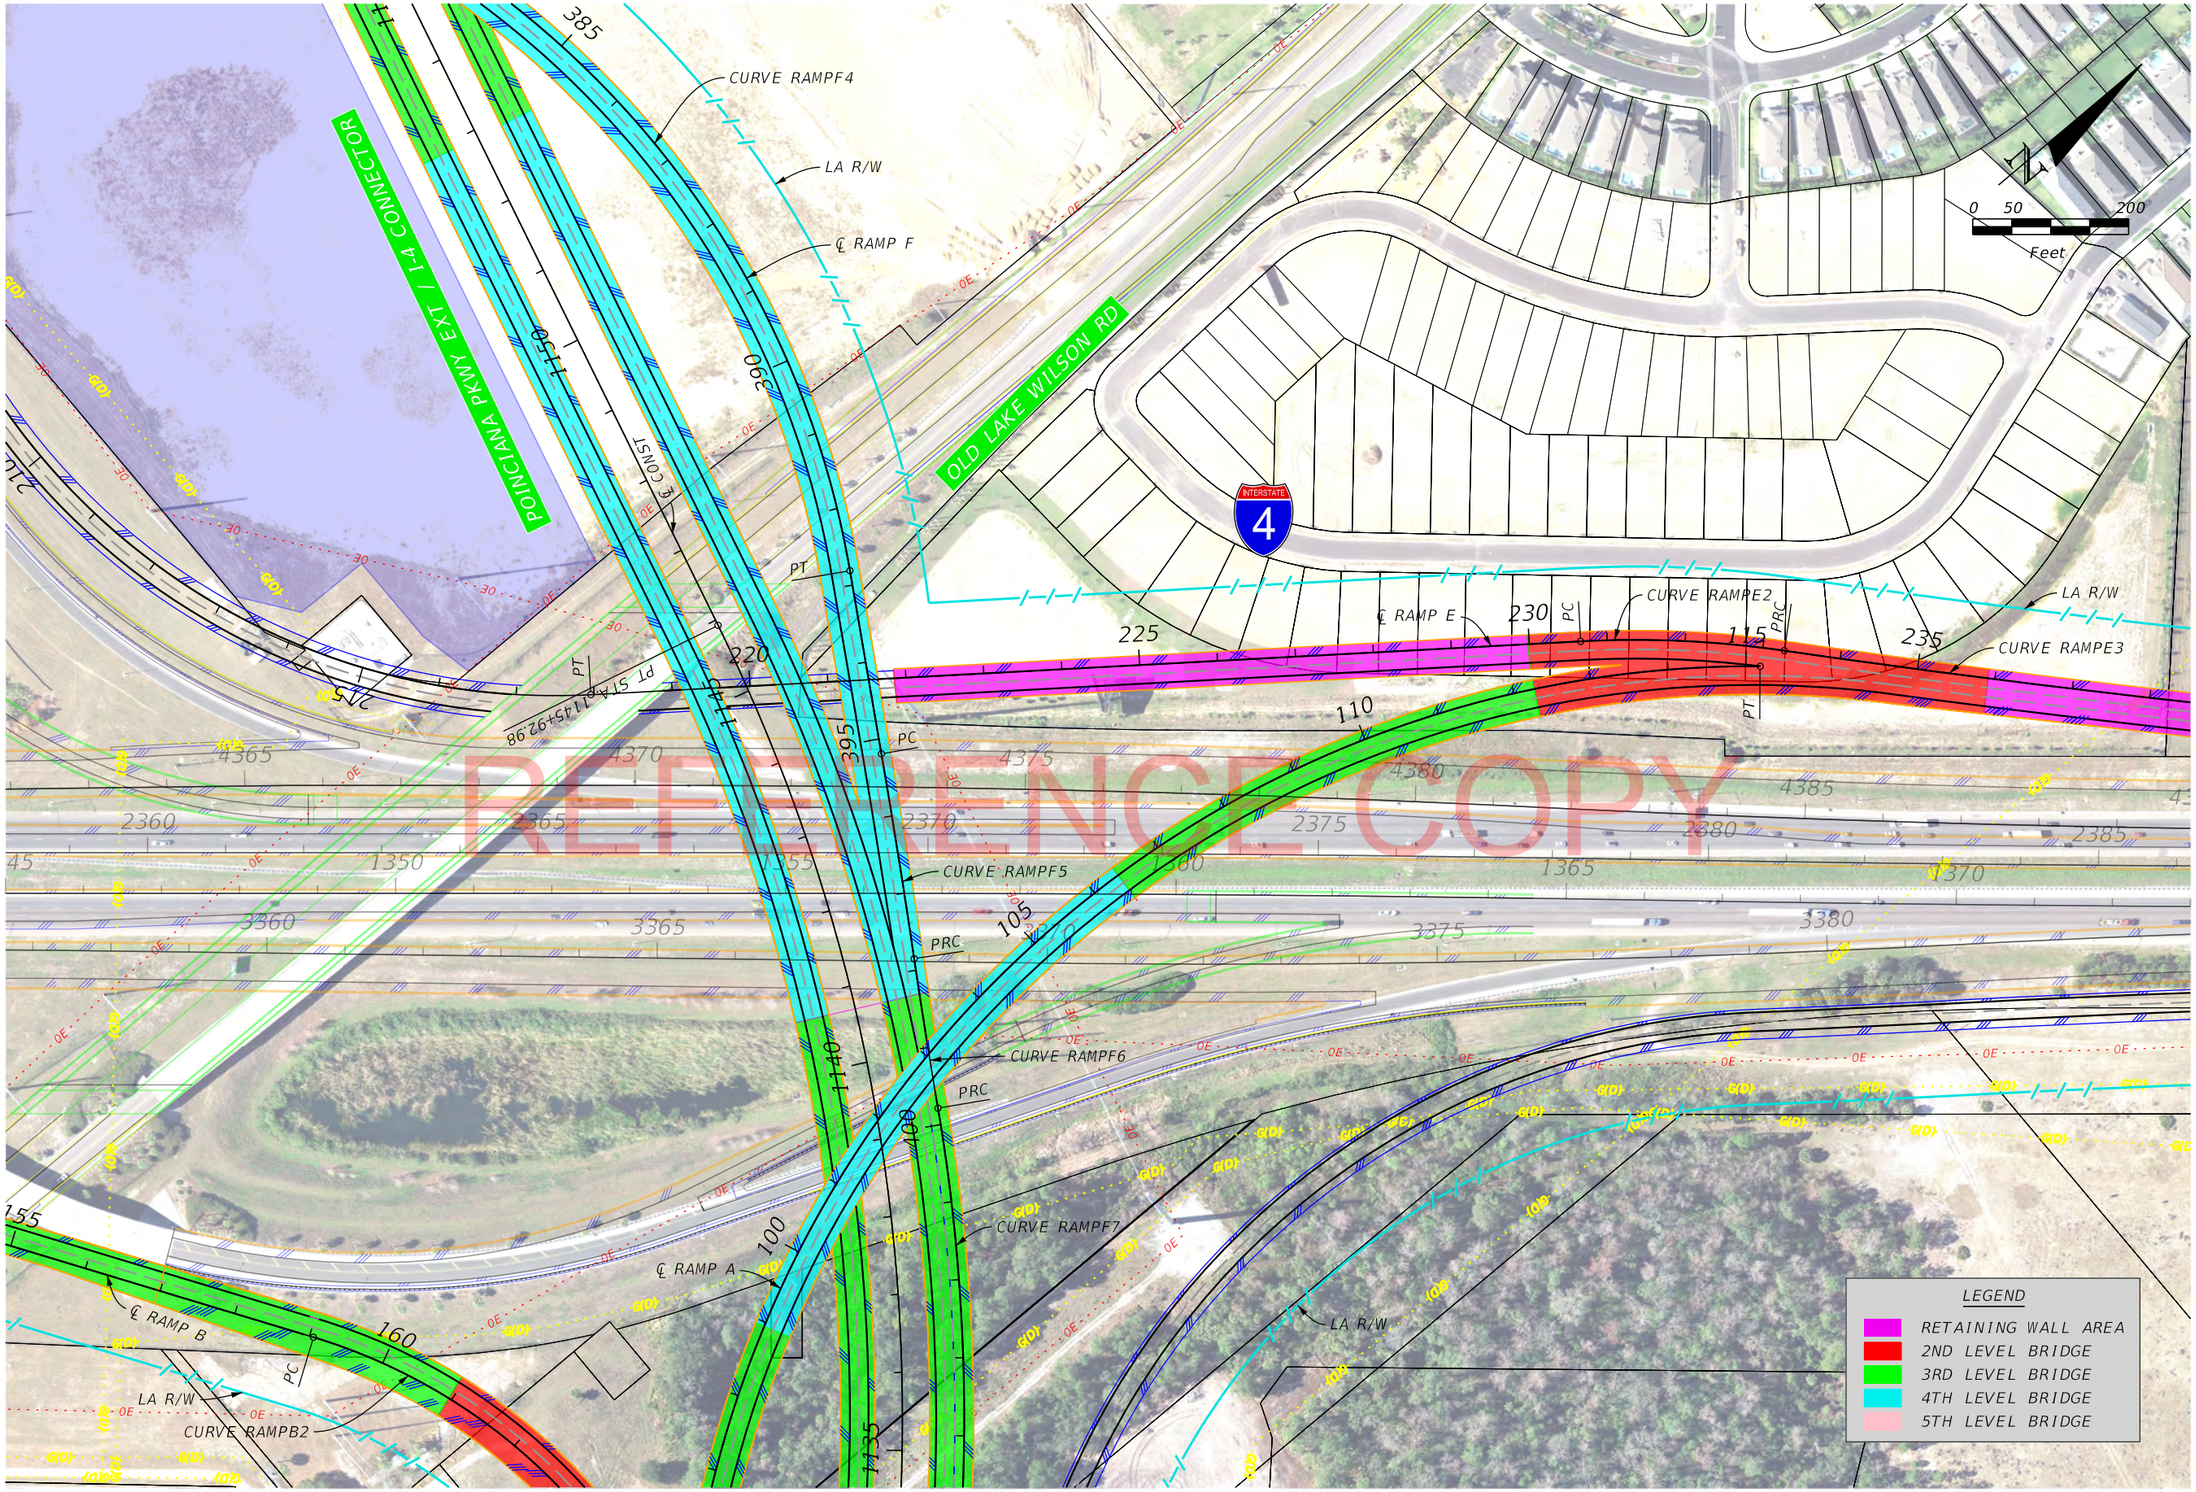

REFERENCE COPY

REVISIONS			
DATE	DESCRIPTION	DATE	DESCRIPTION

CENTRAL FLORIDA EXPRESSWAY AUTHORITY

Concept, Feasability and Mobility Study
for the
Poinciana Parkway Extension / I-4 Connector

Alternative 2A
I-4 Interchange at SR 429
North Alignment

SHEET NO.

NA-10

REFERENCE COPY

REVISIONS			
DATE	DESCRIPTION	DATE	DESCRIPTION

CENTRAL FLORIDA EXPRESSWAY AUTHORITY

Concept, Feasability and Mobility Study
for the
Poinciana Parkway Extension / I-4 Connector

Alternative 2A
I-4 Interchange at SR 429
North Alignment

SHEET NO.
NA-11

Bill.Lemos 3/21/2018 4:24:51 PM K:\ORL_TPTO\149800000___I-4 Connector\200_Engineering\CADD\roadway\Roadway Alignments\plans\plan2A_NI-33.dgn

REFERENCE COPY

REVISIONS			
DATE	DESCRIPTION	DATE	DESCRIPTION

CENTRAL FLORIDA EXPRESSWAY AUTHORITY

Concept, Feasability and Mobility Study
for the
Poinciana Parkway Extension / I-4 Connector

Alternative 2A
I-4 Interchange at SR 429
North Alignment

SHEET NO.

NA-12

Bill.Lemos 3/21/2018 4:26:06 PM K:\ORL_TPTO\149800000___I-4 Connector\200_Engineering\CADD\roadway\Roadway Alignments\plans\plan2A_NI-34.dgn

Alternative 2A I-4 Interchange at SR 429 North Alignment ~ Ramp Curve Data

RAMP A

```
CURVE DATA RAMPA1
PI STA. = 38+65.04
Δ       = 2° 26' 04" (LT)
D       = 0° 28' 42"
T       = 254.46
L       = 508.85
R       = 11,976.00
PC STA. = 36+10.58
PT STA. = 41+19.42
e = NC

CURVE DATA RAMPA2
PI STA. = 44+06.44
Δ       = 2° 26' 04" (RT)
D       = 0° 28' 35"
T       = 255.48
L       = 510.89
R       = 12,024.00
PC STA. = 41+50.96
PT STA. = 46+61.85
e = NC

CURVE DATA RAMPA3
PI STA. = 49+97.00
Δ       = 2° 39' 08" (RT)
D       = 0° 57' 44"
T       = 137.85
L       = 275.65
R       = 5,955.00
PC STA. = 48+59.15
PT STA. = 51+34.80
0.021

CURVE DATA RAMPA4
PI STA. = 54+96.86
Δ       = 8° 50' 38" (RT)
D       = 1° 13' 26"
T       = 362.06
L       = 722.69
R       = 4,681.95
PC STA. = 51+34.80
PT STA. = 58+57.49
e = 0.026

CURVE DATA RAMPA5
PI STA. = 61+92.70
Δ       = 6° 25' 51" (RT)
D       = 0° 57' 37"
T       = 335.21
L       = 669.73
R       = 5,967.00
PC STA. = 58+57.49
PT STA. = 65+27.21
e = 0.021

CURVE DATA RAMPA6
PI STA. = 68+36.79
Δ       = 8° 08' 58" (RT)
D       = 1° 19' 06"
T       = 309.58
L       = 618.11
R       = 4,345.72
PC STA. = 65+27.21
PT STA. = 71+45.33
e = 0.028

CURVE DATA RAMPA7
PI STA. = 74+94.22
Δ       = 6° 40' 45" (RT)
D       = 0° 57' 30"
T       = 348.90
L       = 697.00
R       = 5,979.00
PC STA. = 71+45.33
PT STA. = 78+42.33
e = 0.021

CURVE DATA RAMPA8
PI STA. = 82+13.33
Δ       = 2° 24' 56" (LT)
D       = 0° 38' 18"
T       = 189.24
L       = 378.42
R       = 8,976.00
PC STA. = 80+24.09
PT STA. = 84+02.52
e = NC
```

RAMP A

```
CURVE DATA RAMPA9
PI STA. = 89+67.77
Δ       = 11° 01' 16" (LT)
D       = 1° 55' 31"
T       = 287.11
L       = 572.44
R       = 2,976.00
PC STA. = 86+80.66
PT STA. = 92+53.10
e = 0.039

CURVE DATA RAMPA10
PI STA. = 107+38.13
Δ       = 85° 22' 53" (RT)
D       = 4° 10' 12"
T       = 1,267.48
L       = 2,047.52
R       = 1,374.00
PC STA. = 94+70.65
PT STA. = 115+18.17
e = 0.074
```

RAMP B

```
CURVE DATA RAMPB1
PI STA. = 145+93.66
Δ       = 12° 46' 14" (RT)
D       = 2° 18' 51"
T       = 277.08
L       = 551.87
R       = 2,476.00
PC STA. = 143+16.58
PT STA. = 148+68.45
e = 0.046

CURVE DATA RAMPB2
PI STA. = 166+56.05
Δ       = 91° 37' 09" (RT)
D       = 7° 50' 55"
T       = 750.93
L       = 1,167.31
R       = 730.00
PC STA. = 159+05.13
PT STA. = 170+72.44
e = 0.10
```

RAMP E

```
CURVE DATA RAMPE1
PI STA. = 213+17.66
Δ       = 99° 32' 00" (LT)
D       = 6° 39' 16"
T       = 1,017.66
L       = 1,495.72
R       = 861.00
PC STA. = 203+00.01
PT STA. = 217+95.73
e = 0.096

CURVE DATA RAMPE2
PI STA. = 231+97.27
Δ       = 11° 19' 52" (RT)
D       = 4° 19' 39"
T       = 131.35
L       = 261.84
R       = 1,324.00
PC STA. = 230+65.92
PT STA. = 233+27.76
e = 0.076
```

RAMP E

```
CURVE DATA RAMPE3
PI STA. = 237+23.79
Δ       = 3° 02' 27" (LT)
D       = 0° 23' 02"
T       = 396.03
L       = 791.87
R       = 14,920.82
PC STA. = 233+27.76
PT STA. = 241+19.63
e = NC

CURVE DATA RAMPE4
PI STA. = 245+28.82
Δ       = 0° 48' 19" (LT)
D       = 0° 23' 01"
T       = 104.95
L       = 209.89
R       = 14,932.82
PC STA. = 244+23.87
PT STA. = 246+33.76
e = NC
```

RAMP F

```
CURVE DATA RAMPF1
PI STA. = 329+80.25
Δ       = 3° 59' 09" (LT)
D       = 2° 18' 51"
T       = 86.16
L       = 172.25
R       = 2,476.00
PC STA. = 328+94.09
PT STA. = 330+66.34
e = 0.046

CURVE DATA RAMPF2
PI STA. = 335+12.46
Δ       = 3° 59' 09" (RT)
D       = 2° 16' 12"
T       = 87.83
L       = 175.59
R       = 2,524.00
PC STA. = 334+24.63
PT STA. = 336+00.22
e = 0.045

CURVE DATA RAMPF3
PI STA. = 355+74.75
Δ       = 42° 41' 56" (LT)
D       = 4° 26' 17"
T       = 504.62
L       = 962.10
R       = 1,291.00
PC STA. = 350+70.13
PT STA. = 360+32.23
e = 0.077

CURVE DATA RAMPF4
PI STA. = 389+21.79
Δ       = 122° 56' 48" (RT)
D       = 4° 52' 49"
T       = 2,159.85
L       = 2,519.20
R       = 1,174.00
PC STA. = 367+61.95
PT STA. = 392+81.15
e = 0.083

CURVE DATA RAMPF5
PI STA. = 396+51.99
Δ       = 1° 19' 17" (RT)
D       = 0° 29' 51"
T       = 132.81
L       = 265.61
R       = 11,516.47
PC STA. = 395+19.17
PT STA. = 397+84.79
e = NC
```

RAMP F

```
CURVE DATA RAMPF6
PI STA. = 398+81.76
Δ       = 1° 14' 05" (LT)
D       = 0° 38' 12"
T       = 96.97
L       = 193.94
R       = 9,000.00
PC STA. = 397+84.79
PT STA. = 399+78.72
e = NC

CURVE DATA RAMPF7
PI STA. = 405+71.34
Δ       = 28° 03' 18" (RT)
D       = 2° 24' 56"
T       = 592.61
L       = 1,161.45
R       = 2,372.00
PC STA. = 399+78.72
PT STA. = 411+40.18
e = 0.082
```

RAMP G

```
CURVE DATA RAMPG1
PI STA. = 452+41.36
Δ       = 18° 31' 12" (RT)
D       = 3° 52' 13"
T       = 241.36
L       = 478.51
R       = 1,480.37
PC STA. = 450+00.00
PT STA. = 454+78.51
e = 0.070

CURVE DATA RAMPG2
PI STA. = 470+41.35
Δ       = 7° 52' 10" (RT)
D       = 1° 54' 01"
T       = 207.38
L       = 414.10
R       = 3,015.00
PC STA. = 468+33.98
PT STA. = 472+48.08
e = 0.039
```

RAMP H

```
CURVE DATA RAMPH1
PI STA. = 501+08.57
Δ       = 4° 58' 25" (LT)
D       = 2° 17' 31"
T       = 108.57
L       = 217.01
R       = 2,500.00
PC STA. = 500+00.00
PT STA. = 502+17.01
e = 0.046

CURVE DATA RAMPH2
PI STA. = 503+85.27
Δ       = 4° 58' 25" (RT)
D       = 3° 01' 15"
T       = 82.37
L       = 164.64
R       = 1,896.65
PC STA. = 503+02.90
PT STA. = 504+67.54
e = 0.057
```

RAMP H

```
CURVE DATA RAMPH3
PI STA. = 509+98.69
Δ       = 19° 42' 09" (LT)
D       = 3° 51' 30"
T       = 257.87
L       = 510.65
R       = 1,485.00
PC STA. = 507+40.82
PT STA. = 512+51.47
e = 0.070
```

REFERENCE COPY

REVISIONS			
DATE	DESCRIPTION	DATE	DESCRIPTION

CENTRAL FLORIDA EXPRESSWAY AUTHORITY

Concept, Feasability and Mobility Study
for the
Poinciana Parkway Extension / I-4 Connector

Alternative 2A
I-4 Interchange at SR 429
North Alignment

SHEET NO.
NA-13

APPENDIX I


REFERENCE COPY

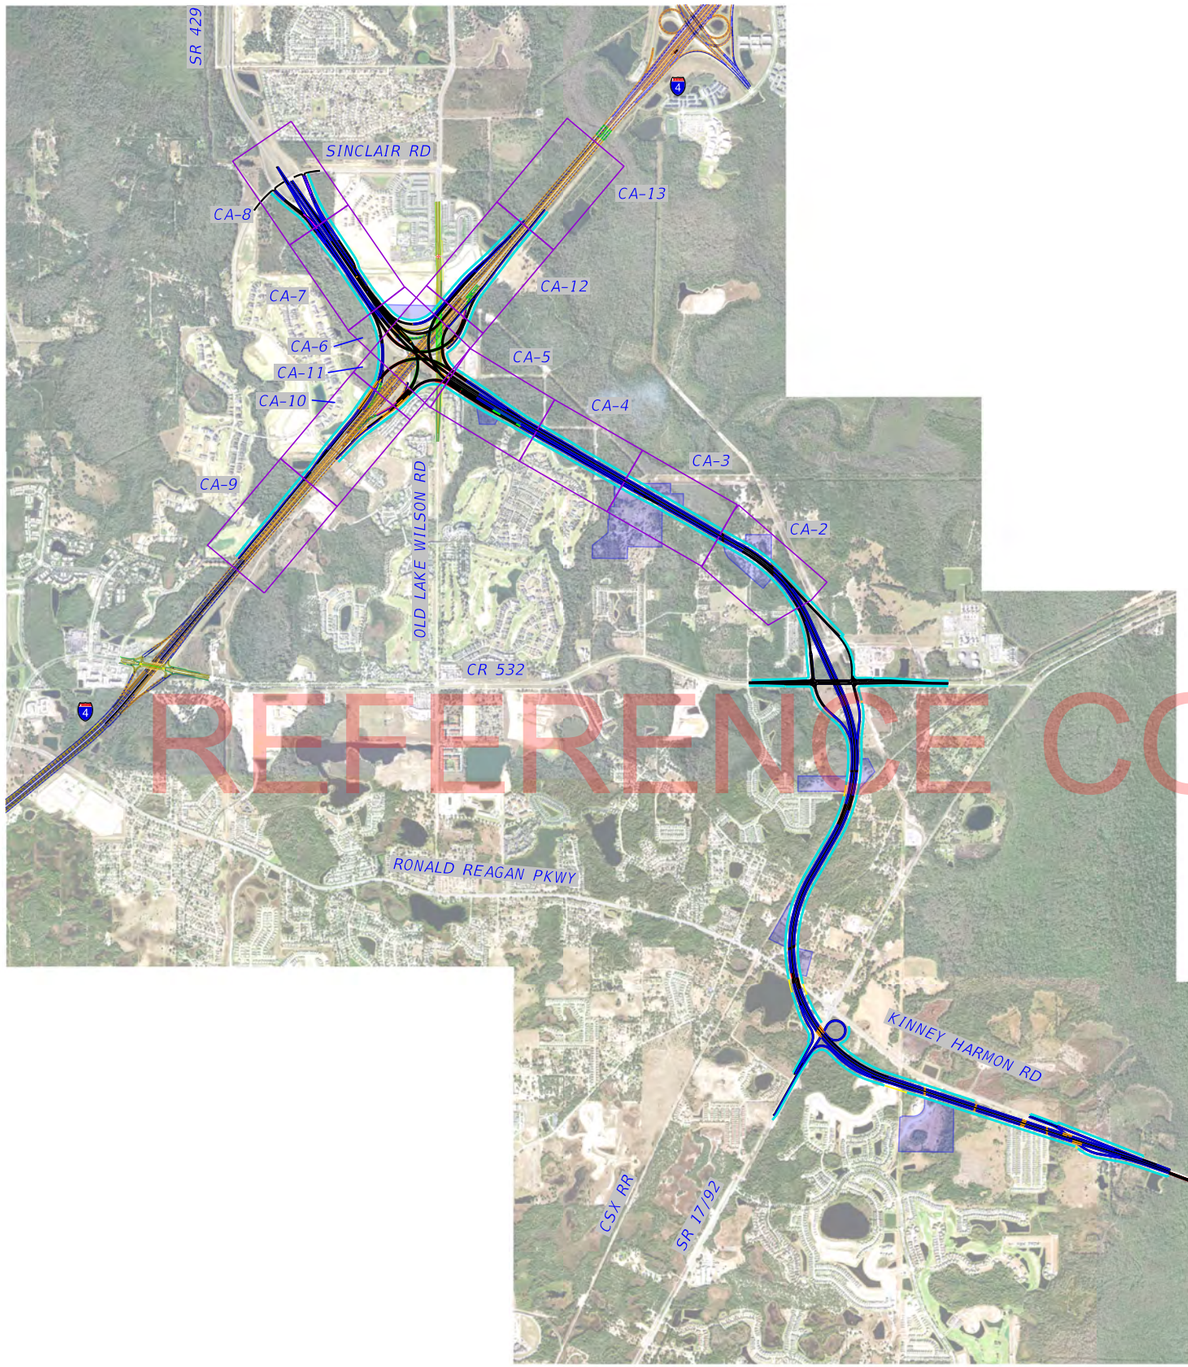

REFERENCE COPY

N

0 4000

Feet

REVISIONS			
DATE	DESCRIPTION	DATE	DESCRIPTION

CENTRAL FLORIDA EXPRESSWAY AUTHORITY

Concept, Feasability and Mobility Study
for the
Poinciana Parkway Extension / I-4 Connector

Alternative 2A
I-4 Interchange at SR 429
Center Alignment

SHEET NO.

CA-1

Bill.Lemos 3/21/2018 1:52:51 PM K:\ORL_TPTO\149800000___I-4 Connector\200_Engineering\CADD\roadway\Roadway Alignments\plans\play2A_1_CL.dgn

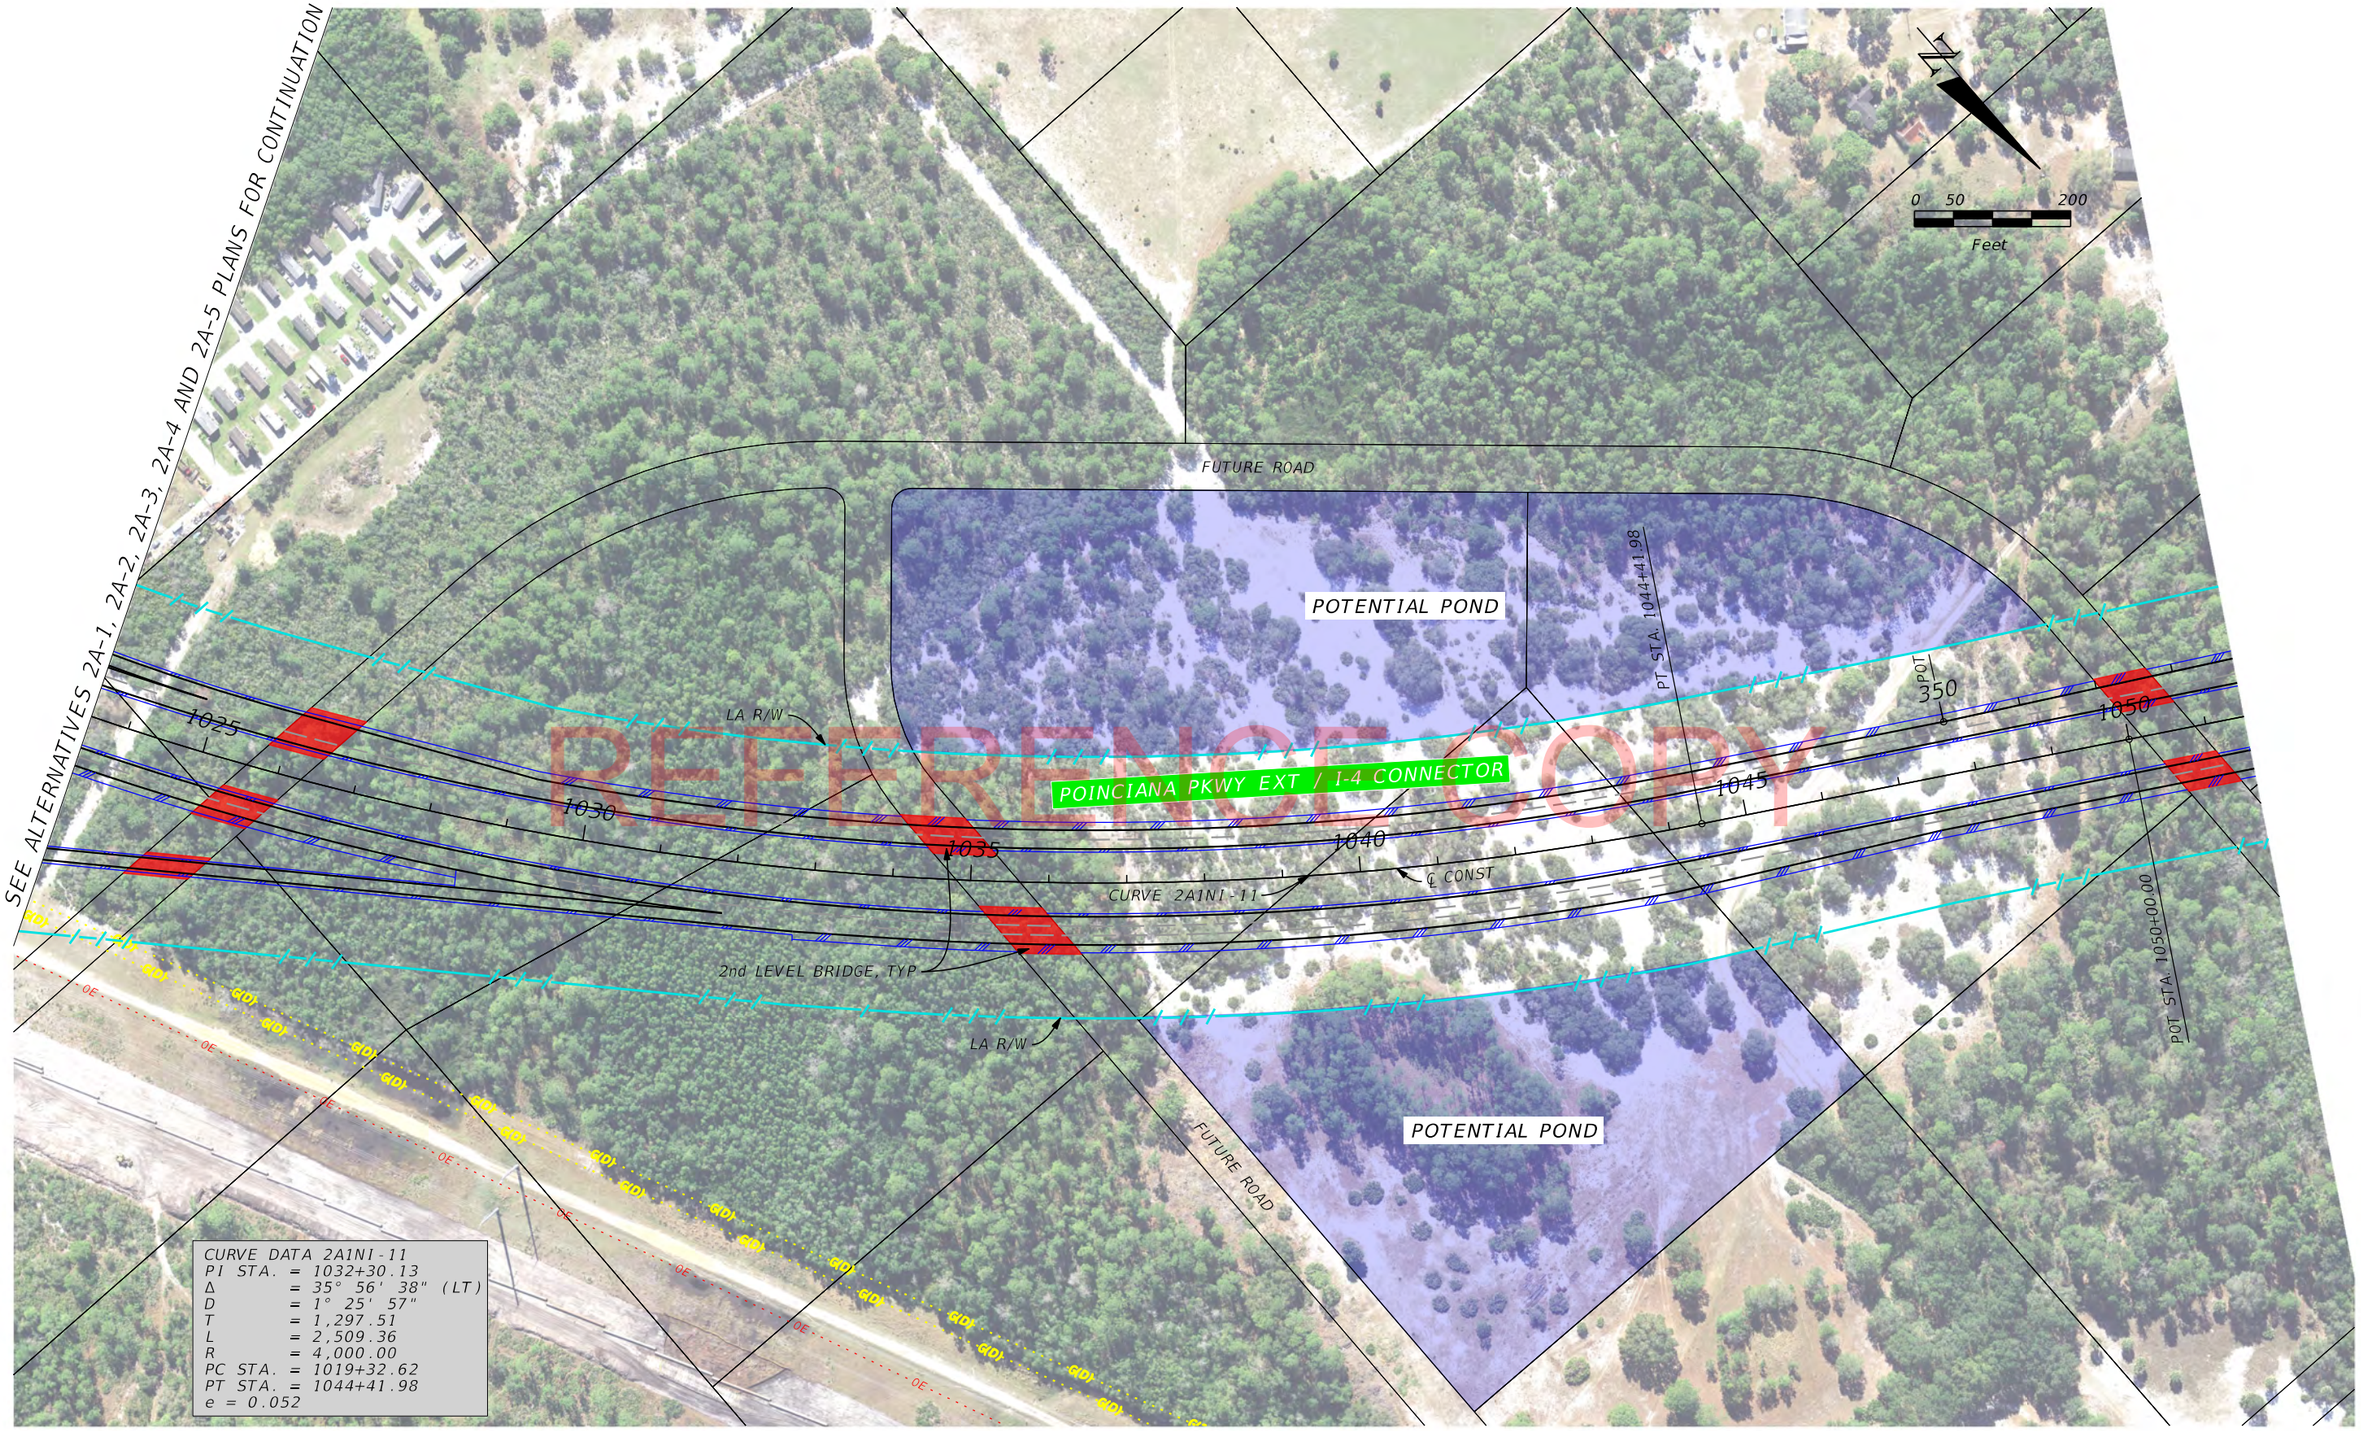

REFERENCE COPY

REVISIONS			
DATE	DESCRIPTION	DATE	DESCRIPTION

CENTRAL FLORIDA EXPRESSWAY AUTHORITY

Concept, Feasability and Mobility Study
for the
Poinciana Parkway Extension / I-4 Connector

Alternative 2A
I-4 Interchange at SR 429
Center Alignment

SHEET NO.
CA-2

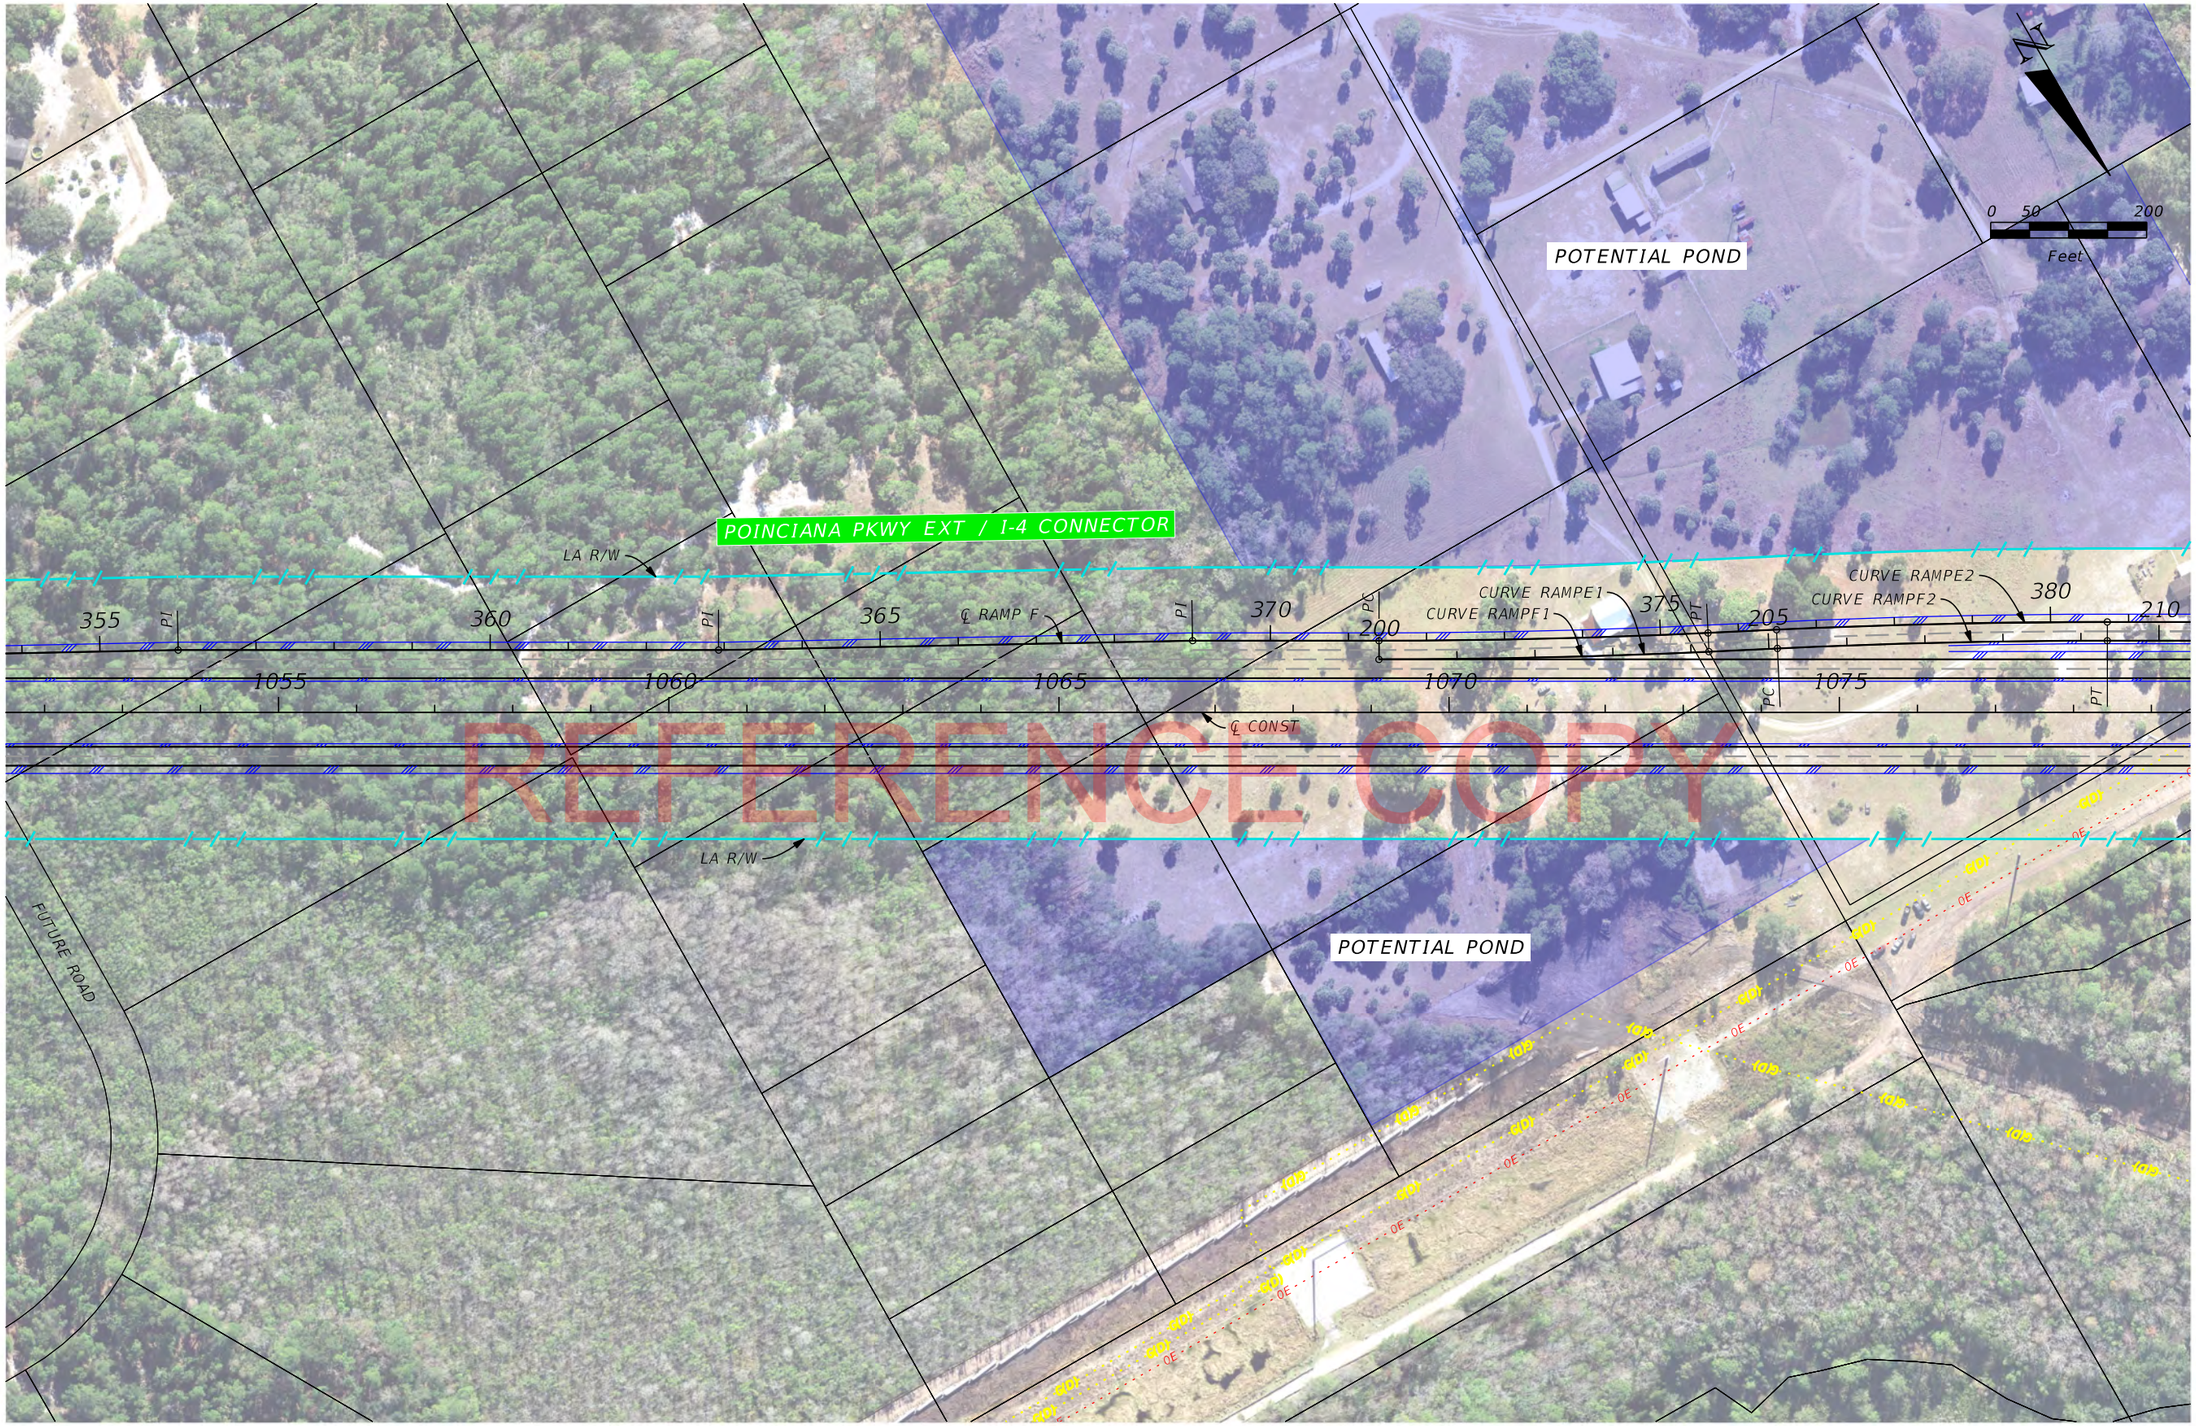

REFERENCE COPY

REVISIONS			
DATE	DESCRIPTION	DATE	DESCRIPTION

CENTRAL FLORIDA EXPRESSWAY AUTHORITY

Concept, Feasability and Mobility Study
for the
Poinciana Parkway Extension / I-4 Connector

Alternative 2A
I-4 Interchange at SR 429
Center Alignment

SHEET NO.
CA-3

Bill.Lemos 3/21/2018 1:55:05 PM K:\ORL_TPTO\149800000___I-4 Connector\200_Engineering\CADD\roadway\Roadway Alignments\plans\plan2A_CI-23.dgn

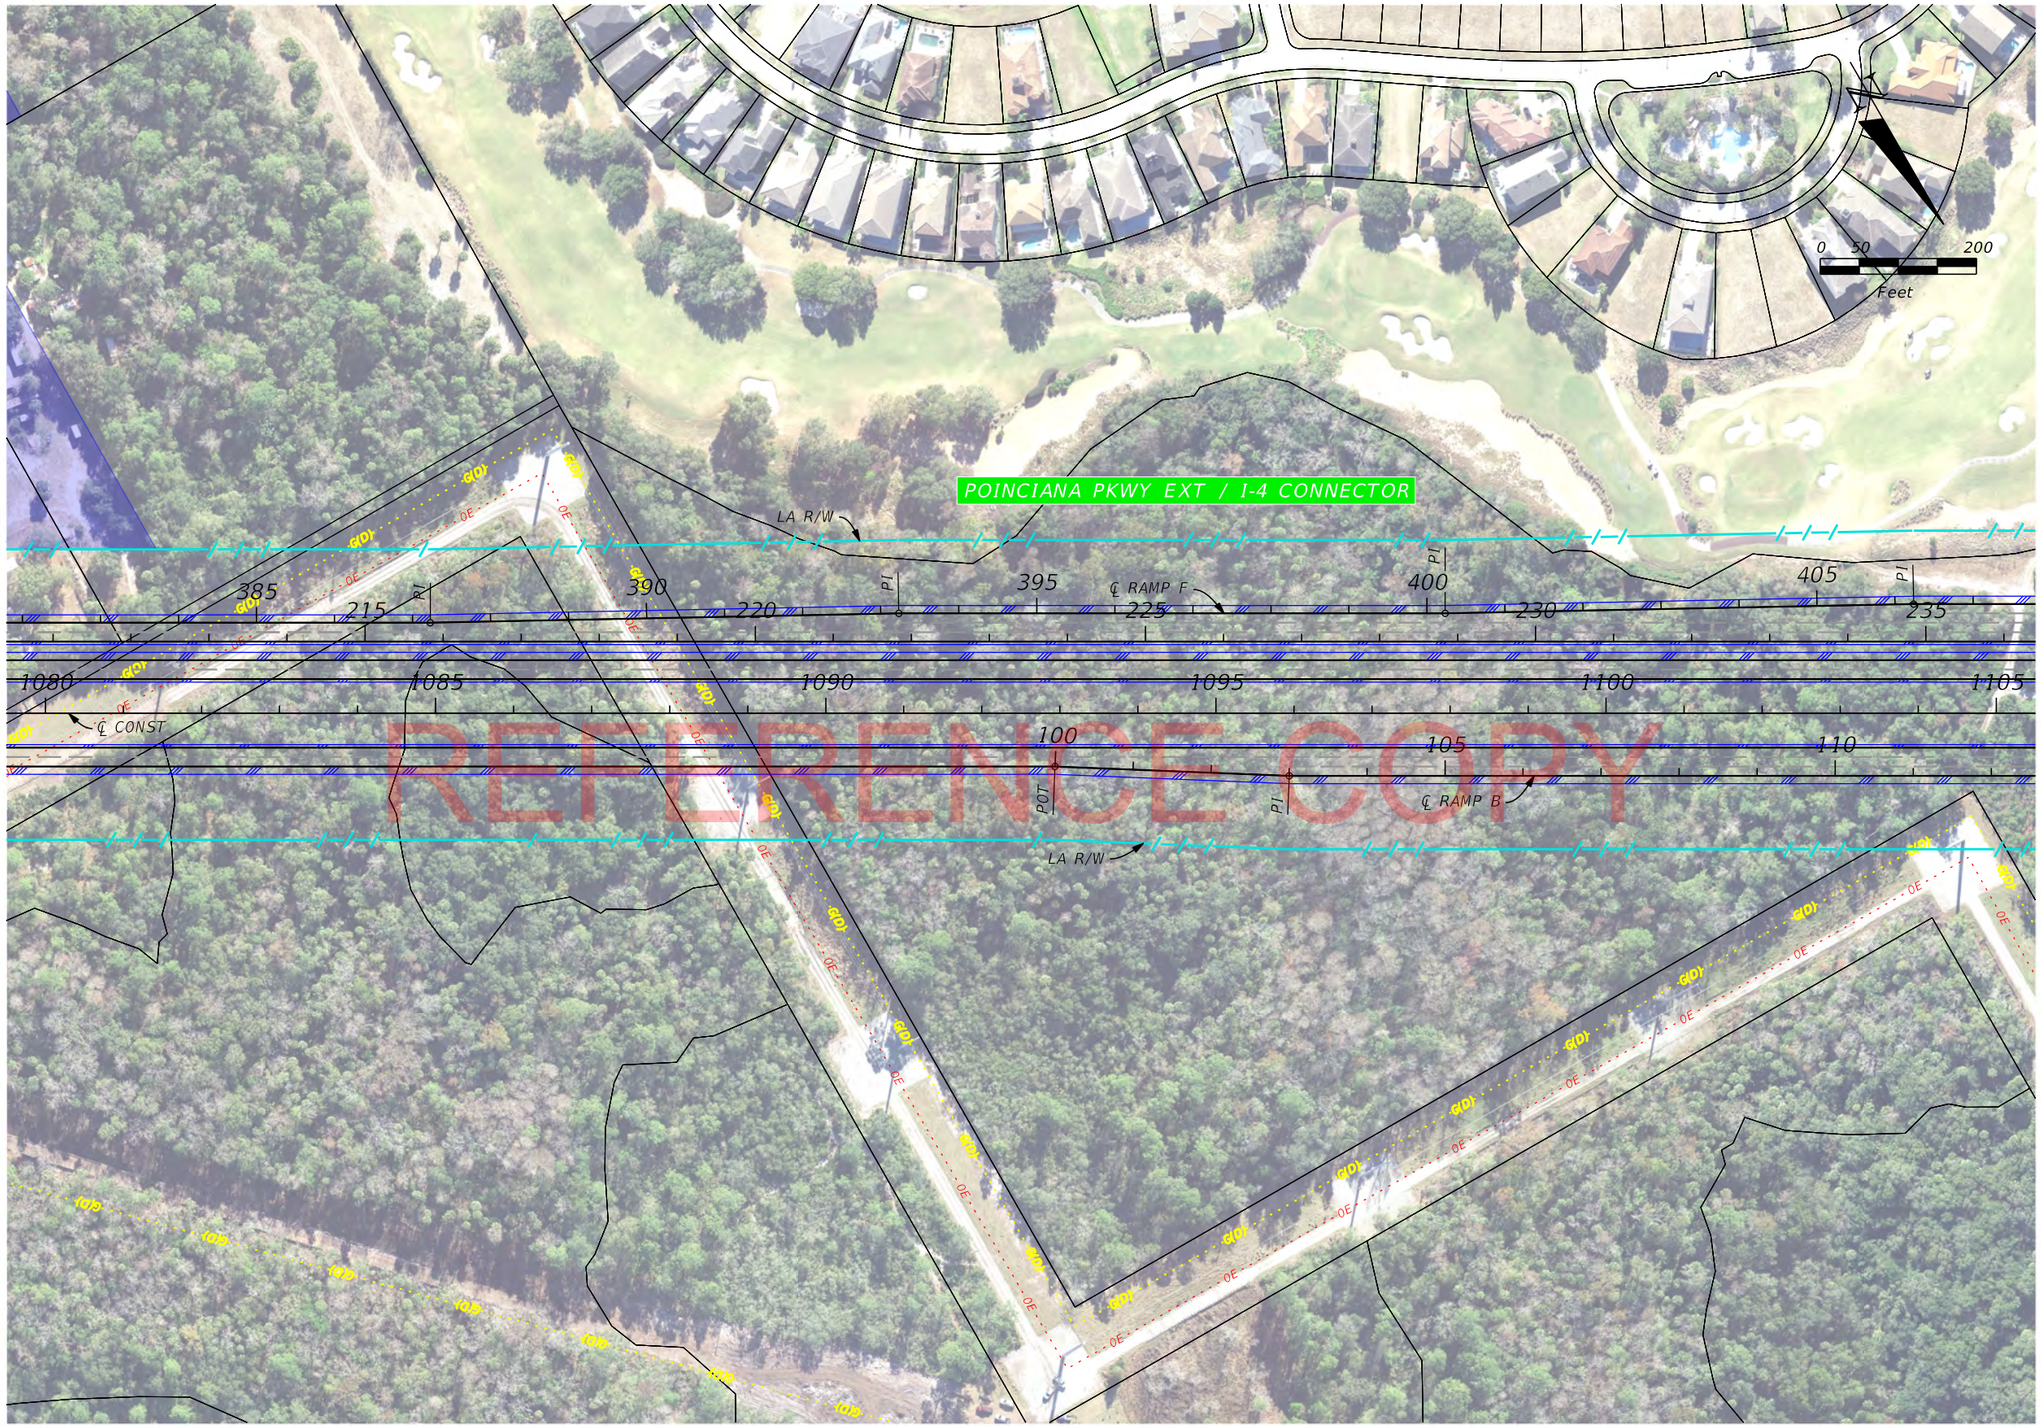

REFERENCE COPY

REVISIONS			
DATE	DESCRIPTION	DATE	DESCRIPTION

CENTRAL FLORIDA EXPRESSWAY AUTHORITY

Concept, Feasability and Mobility Study
for the
Poinciana Parkway Extension / I-4 Connector

Alternative 2A
I-4 Interchange at SR 429
Center Alignment

SHEET NO.
CA-4

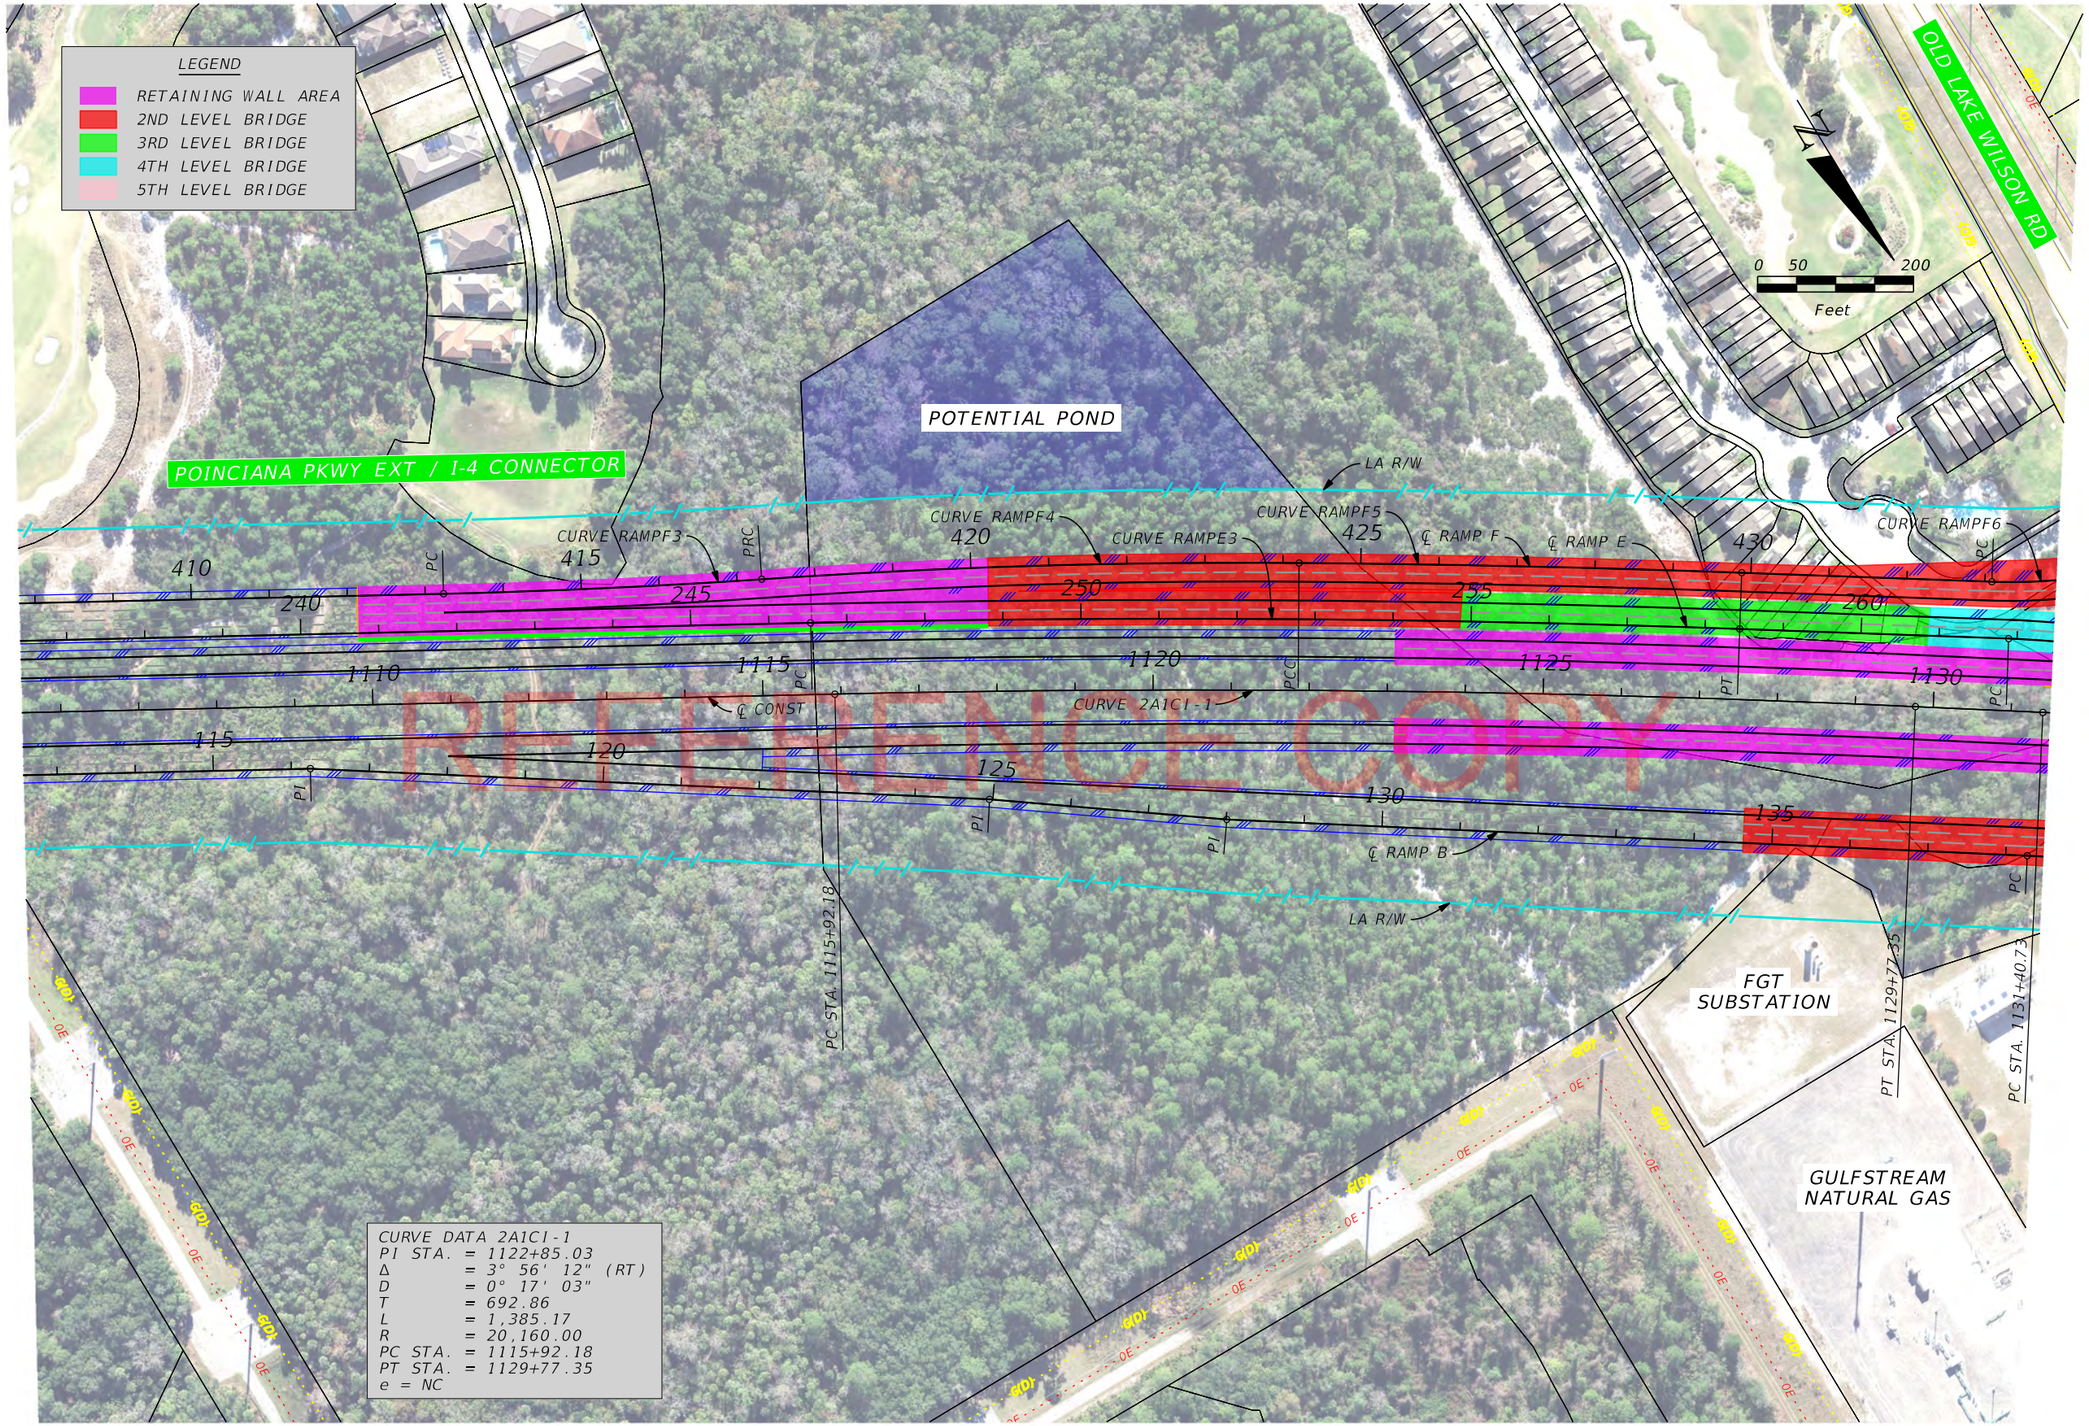

REVISIONS			
DATE	DESCRIPTION	DATE	DESCRIPTION

CENTRAL FLORIDA EXPRESSWAY AUTHORITY

Concept, Feasability and Mobility Study
for the
Poinciana Parkway Extension / I-4 Connector

Alternative 2A
I-4 Interchange at SR 429
Center Alignment

SHEET NO.
CA-5

Bill.Lemos 3/21/2018 1:57:31 PM K:\ORL_TPTO\149800000___I-4 Connector\200_Engineering\CADD\roadway\Roadway Alignments\plans\plan2A_CI-25.dgn

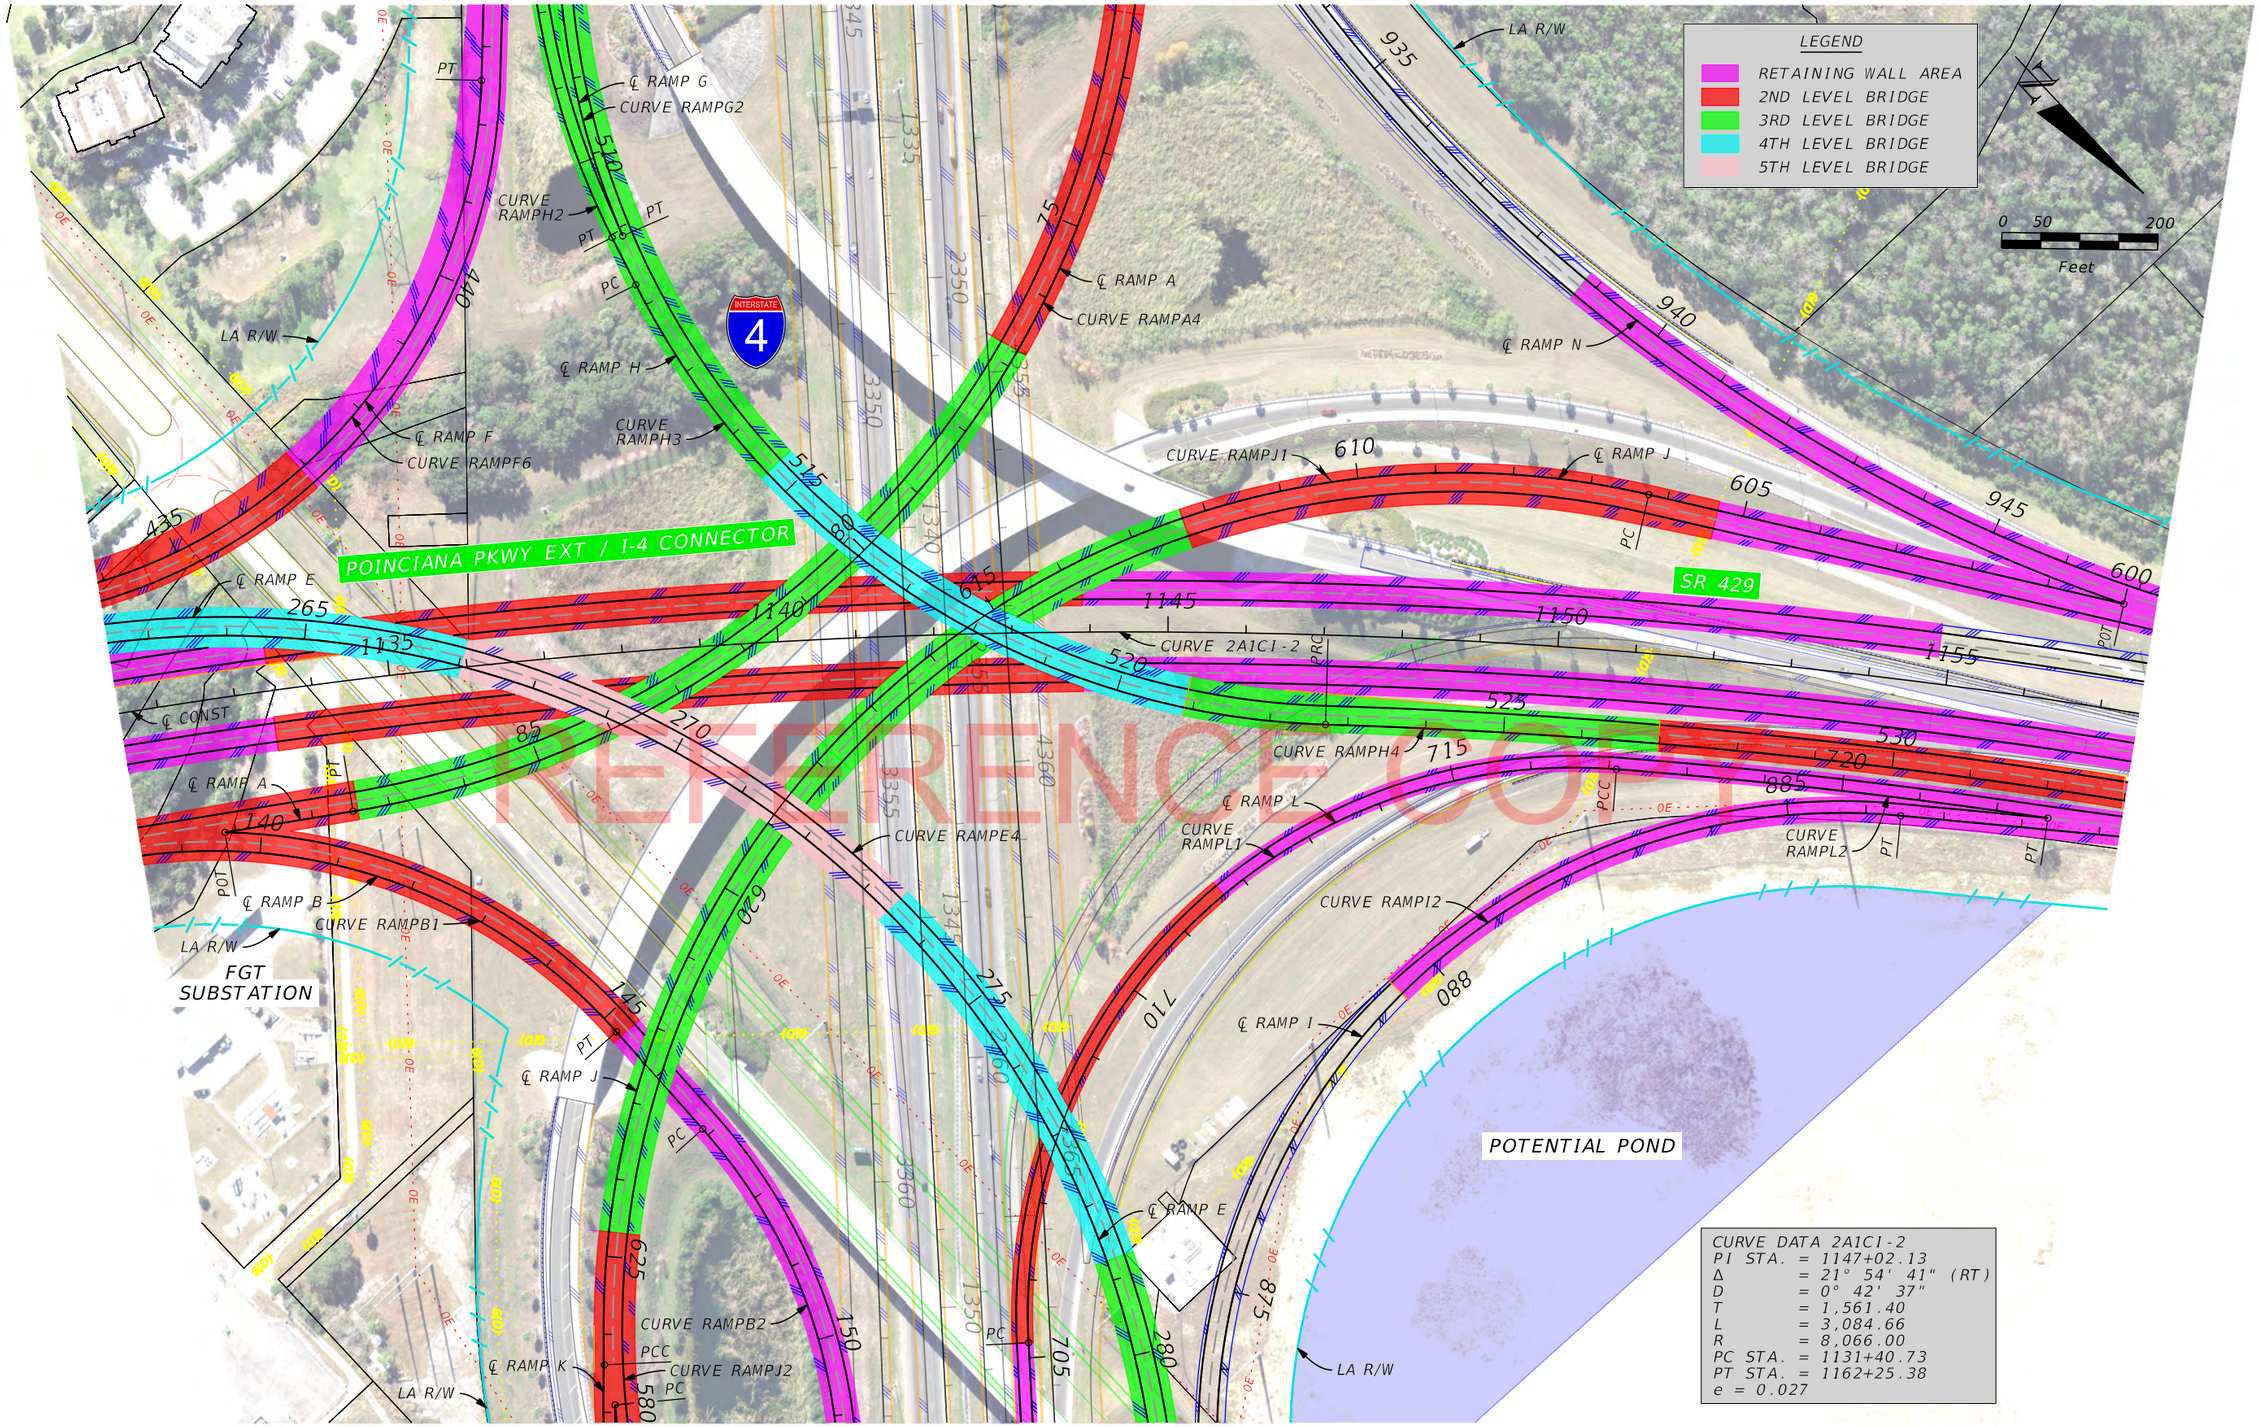

REFERENCE COPY

REVISIONS			
DATE	DESCRIPTION	DATE	DESCRIPTION

CENTRAL FLORIDA EXPRESSWAY AUTHORITY

Concept, Feasability and Mobility Study
for the
Poinciana Parkway Extension / I-4 Connector

Alternative 2A
I-4 Interchange at SR 429
Center Alignment

SHEET NO.

CA-6

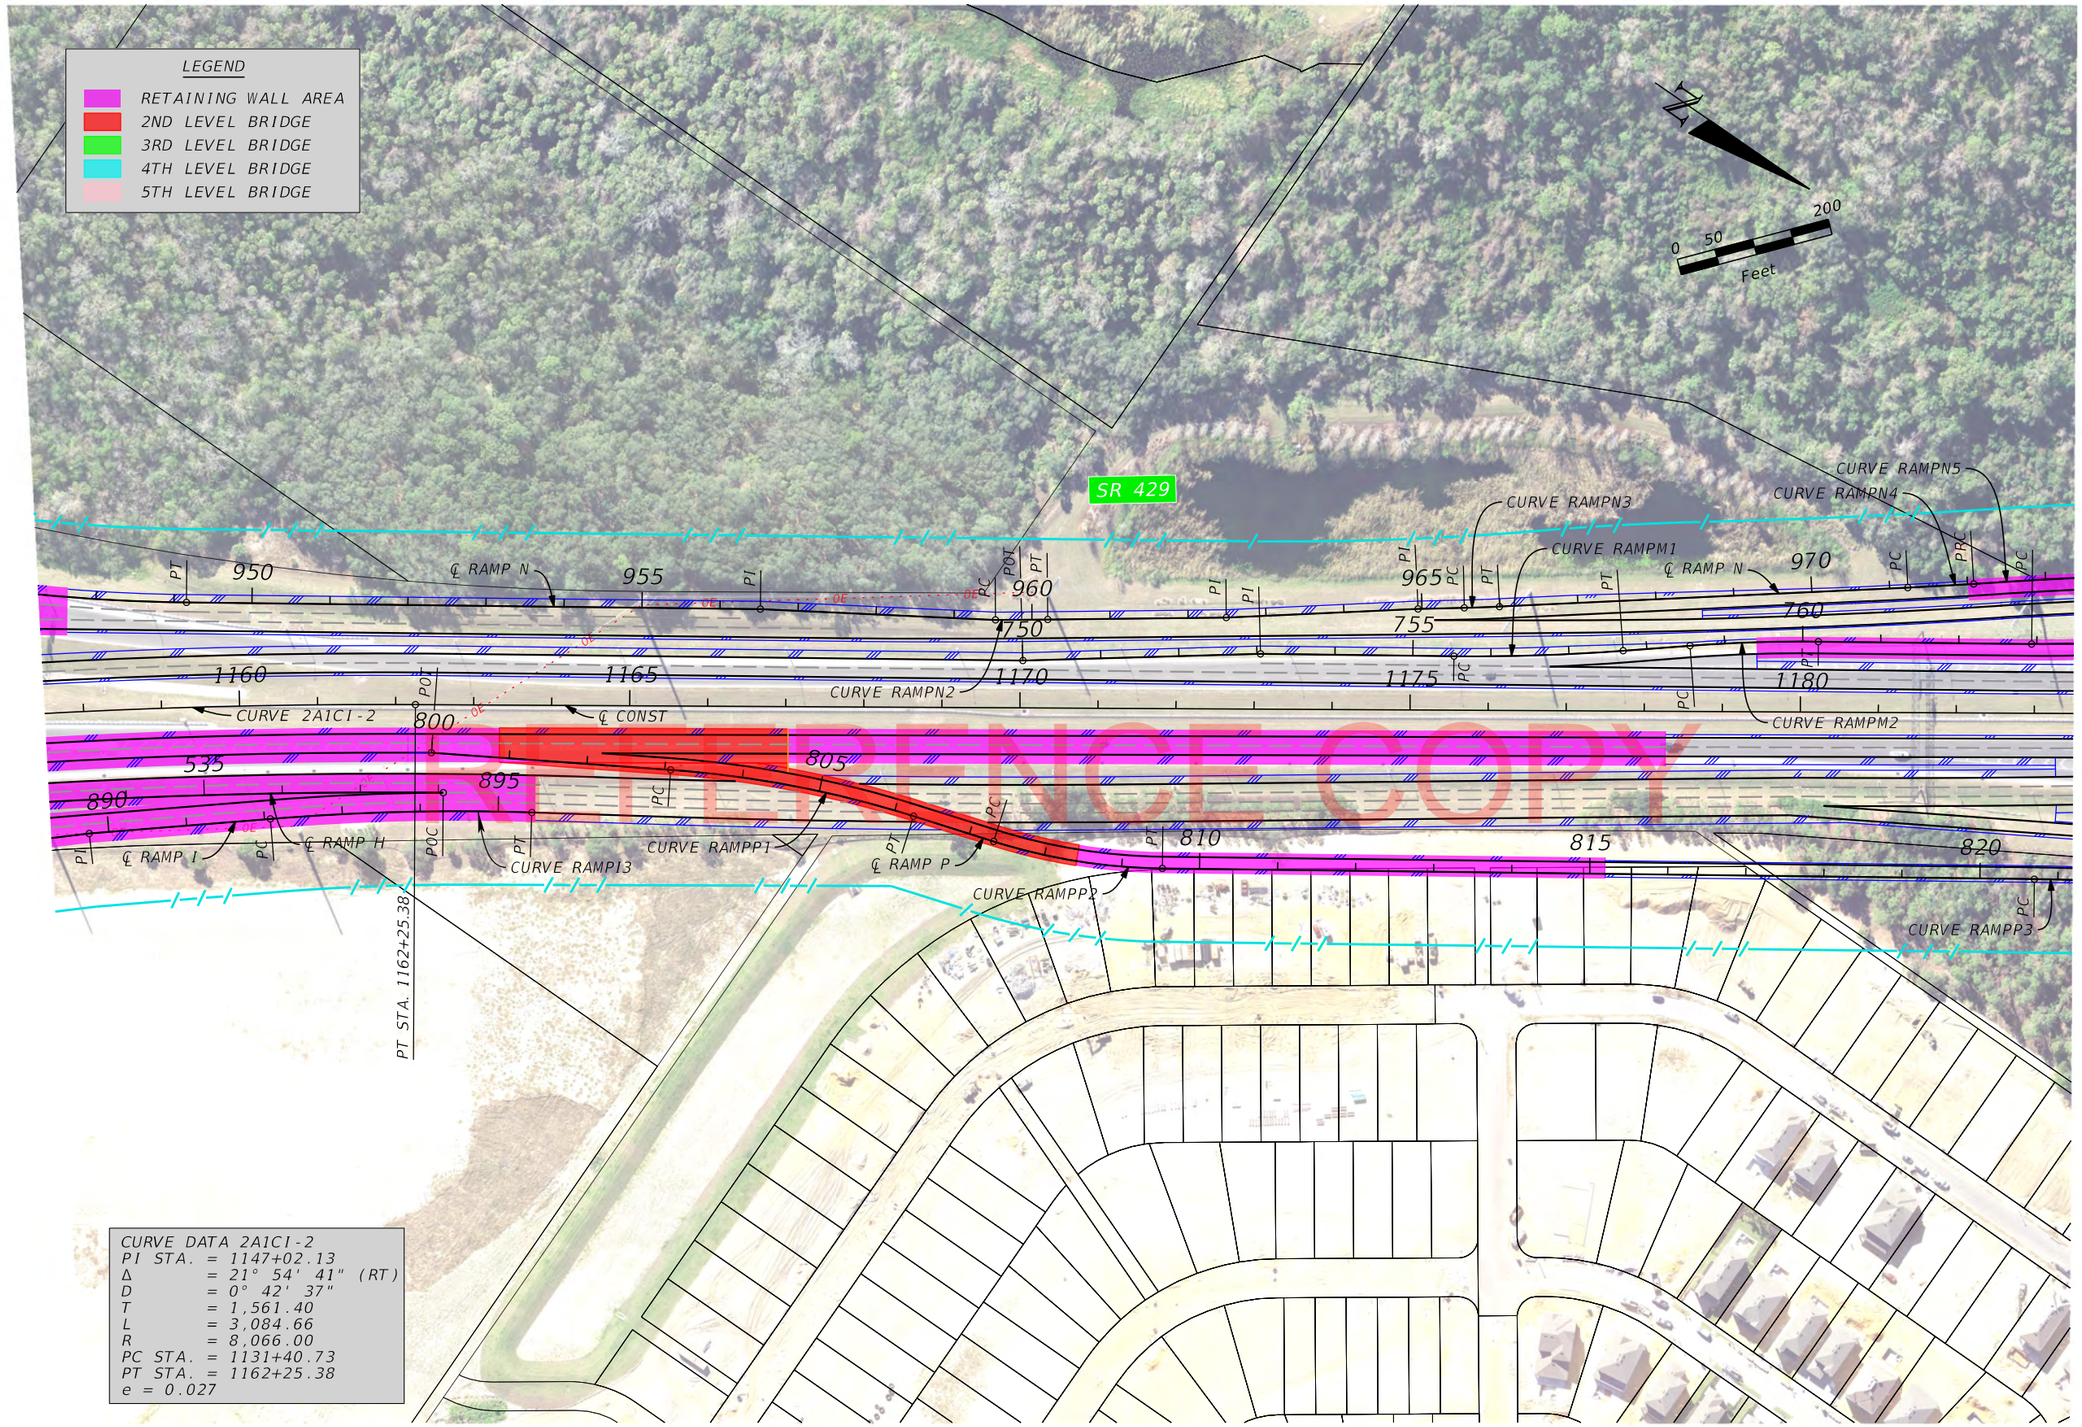

REFERENCE COPY

CURVE DATA 2A1CI-2
PI STA. = 1147+02.13
Δ = 21° 54' 41" (RT)
D = 0° 42' 37"
T = 1,561.40
L = 3,084.66
R = 8,066.00
PC STA. = 1131+40.73
PT STA. = 1162+25.38
e = 0.027

REVISIONS			
DATE	DESCRIPTION	DATE	DESCRIPTION

CENTRAL FLORIDA EXPRESSWAY AUTHORITY

Concept, Feasability and Mobility Study
for the
Poinciana Parkway Extension / I-4 Connector

Alternative 2A
I-4 Interchange at SR 429
Center Alignment

SHEET NO.
CA-7

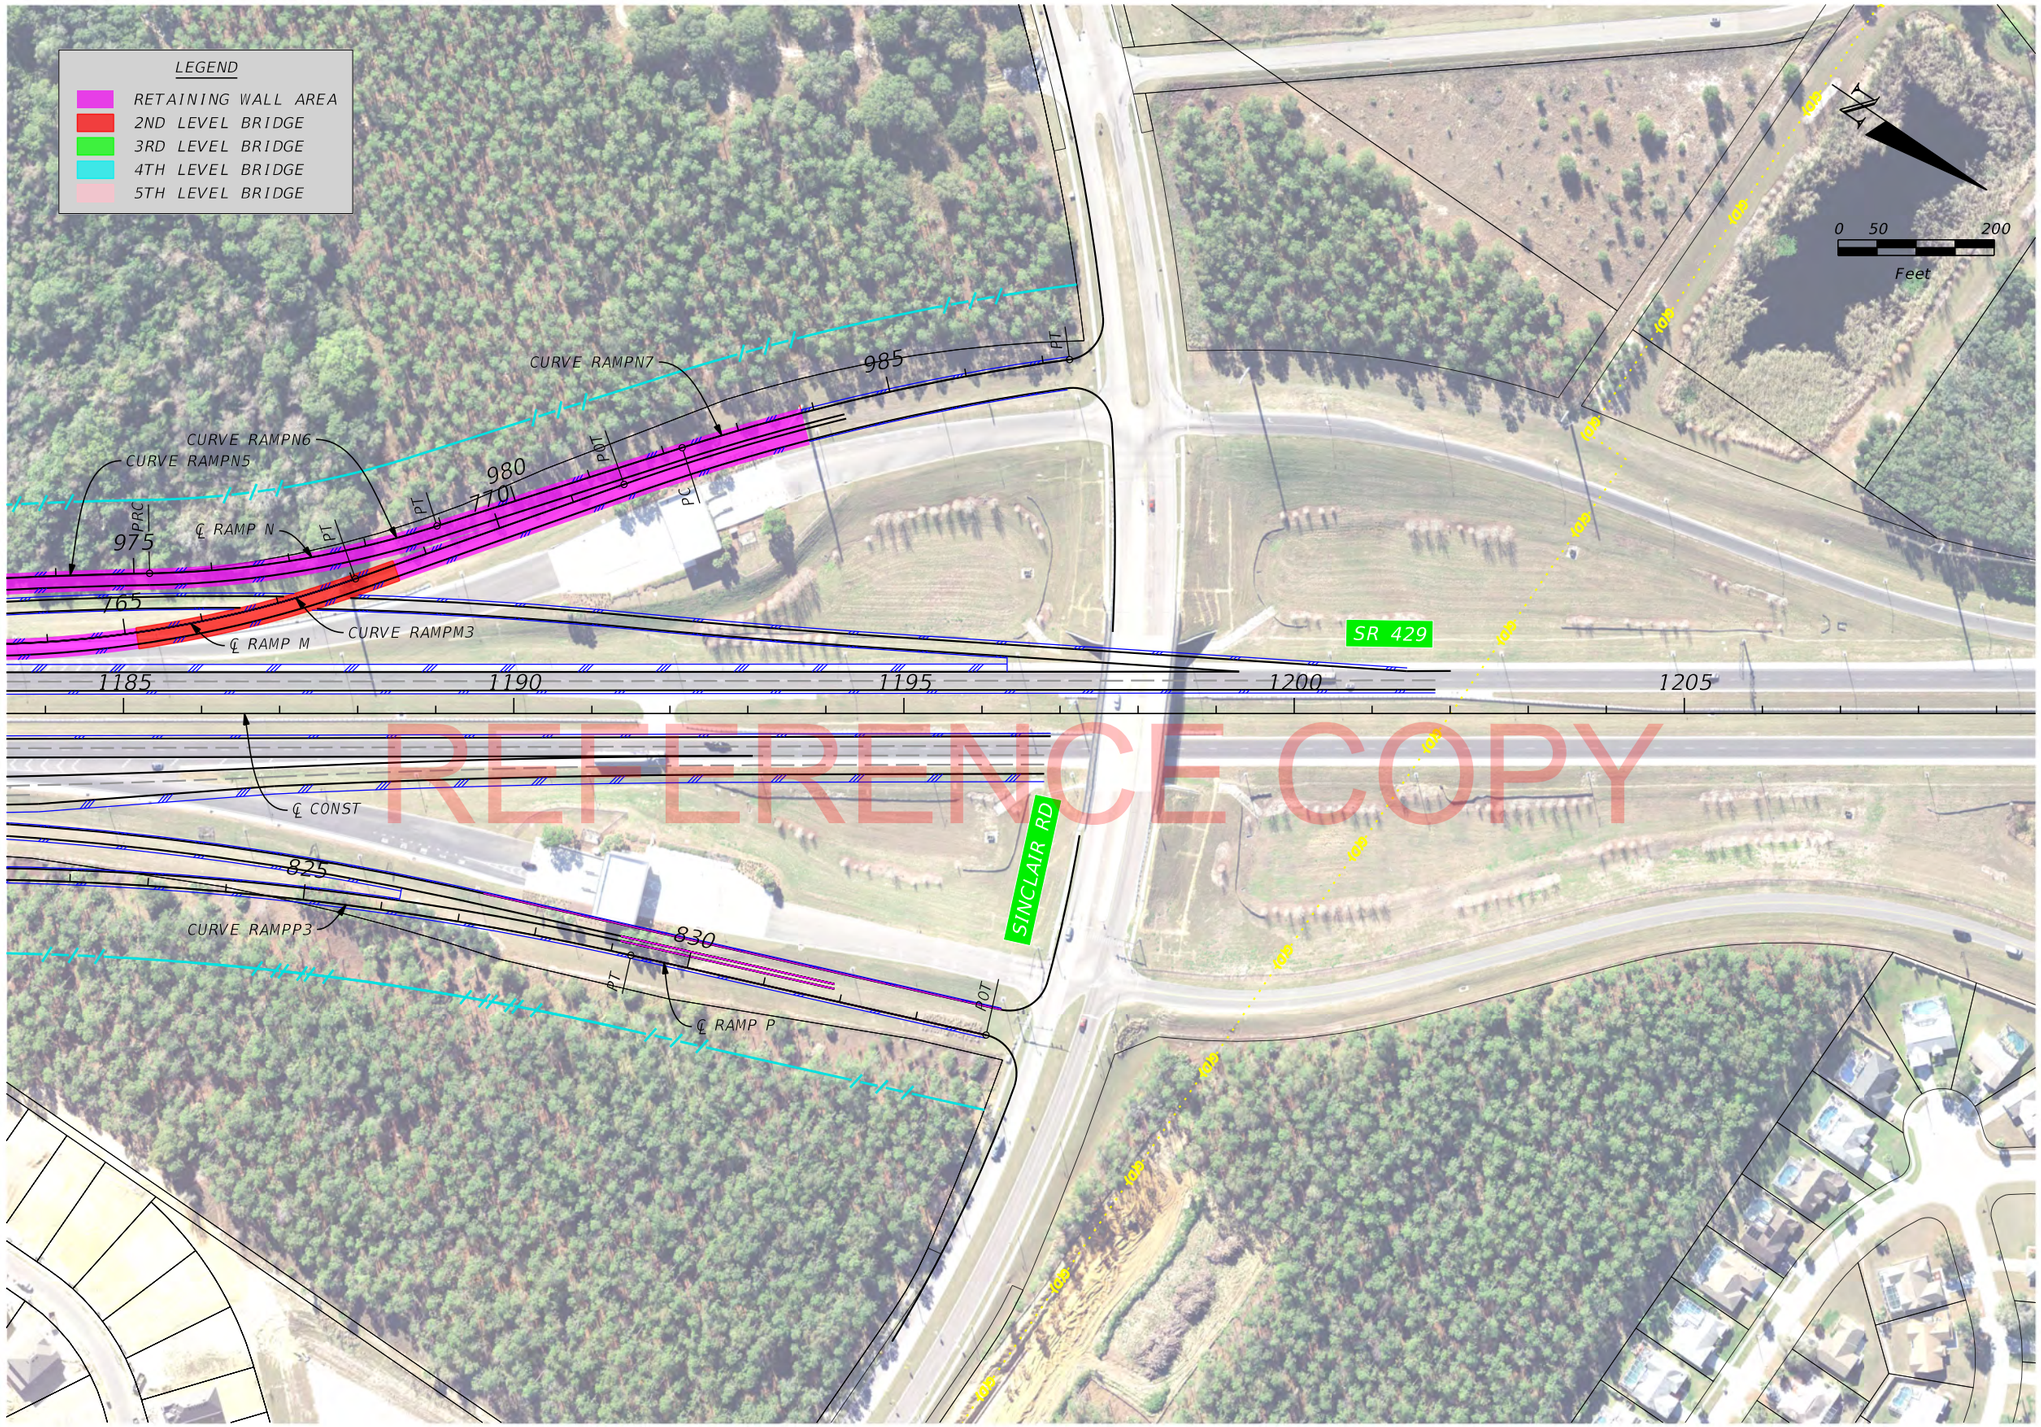

REVISIONS			
DATE	DESCRIPTION	DATE	DESCRIPTION

CENTRAL FLORIDA EXPRESSWAY AUTHORITY

Concept, Feasability and Mobility Study
for the
Poinciana Parkway Extension / I-4 Connector

Alternative 2A
I-4 Interchange at SR 429
Center Alignment

SHEET NO.
CA-8

Bill.Lemos 3/21/2018 2:00:52 PM K:\ORL_TPTO\149800000___I-4 Connector\200_Engineering\CADD\roadway\Roadway Alignments\plans\plan2A_CI-28.dgn

REFERENCE COPY

REVISIONS			
DATE	DESCRIPTION	DATE	DESCRIPTION

CENTRAL FLORIDA EXPRESSWAY AUTHORITY

Concept, Feasability and Mobility Study
for the
Poinciana Parkway Extension / I-4 Connector

Alternative 2A
I-4 Interchange at SR 429
Center Alignment

SHEET NO.
CA-9

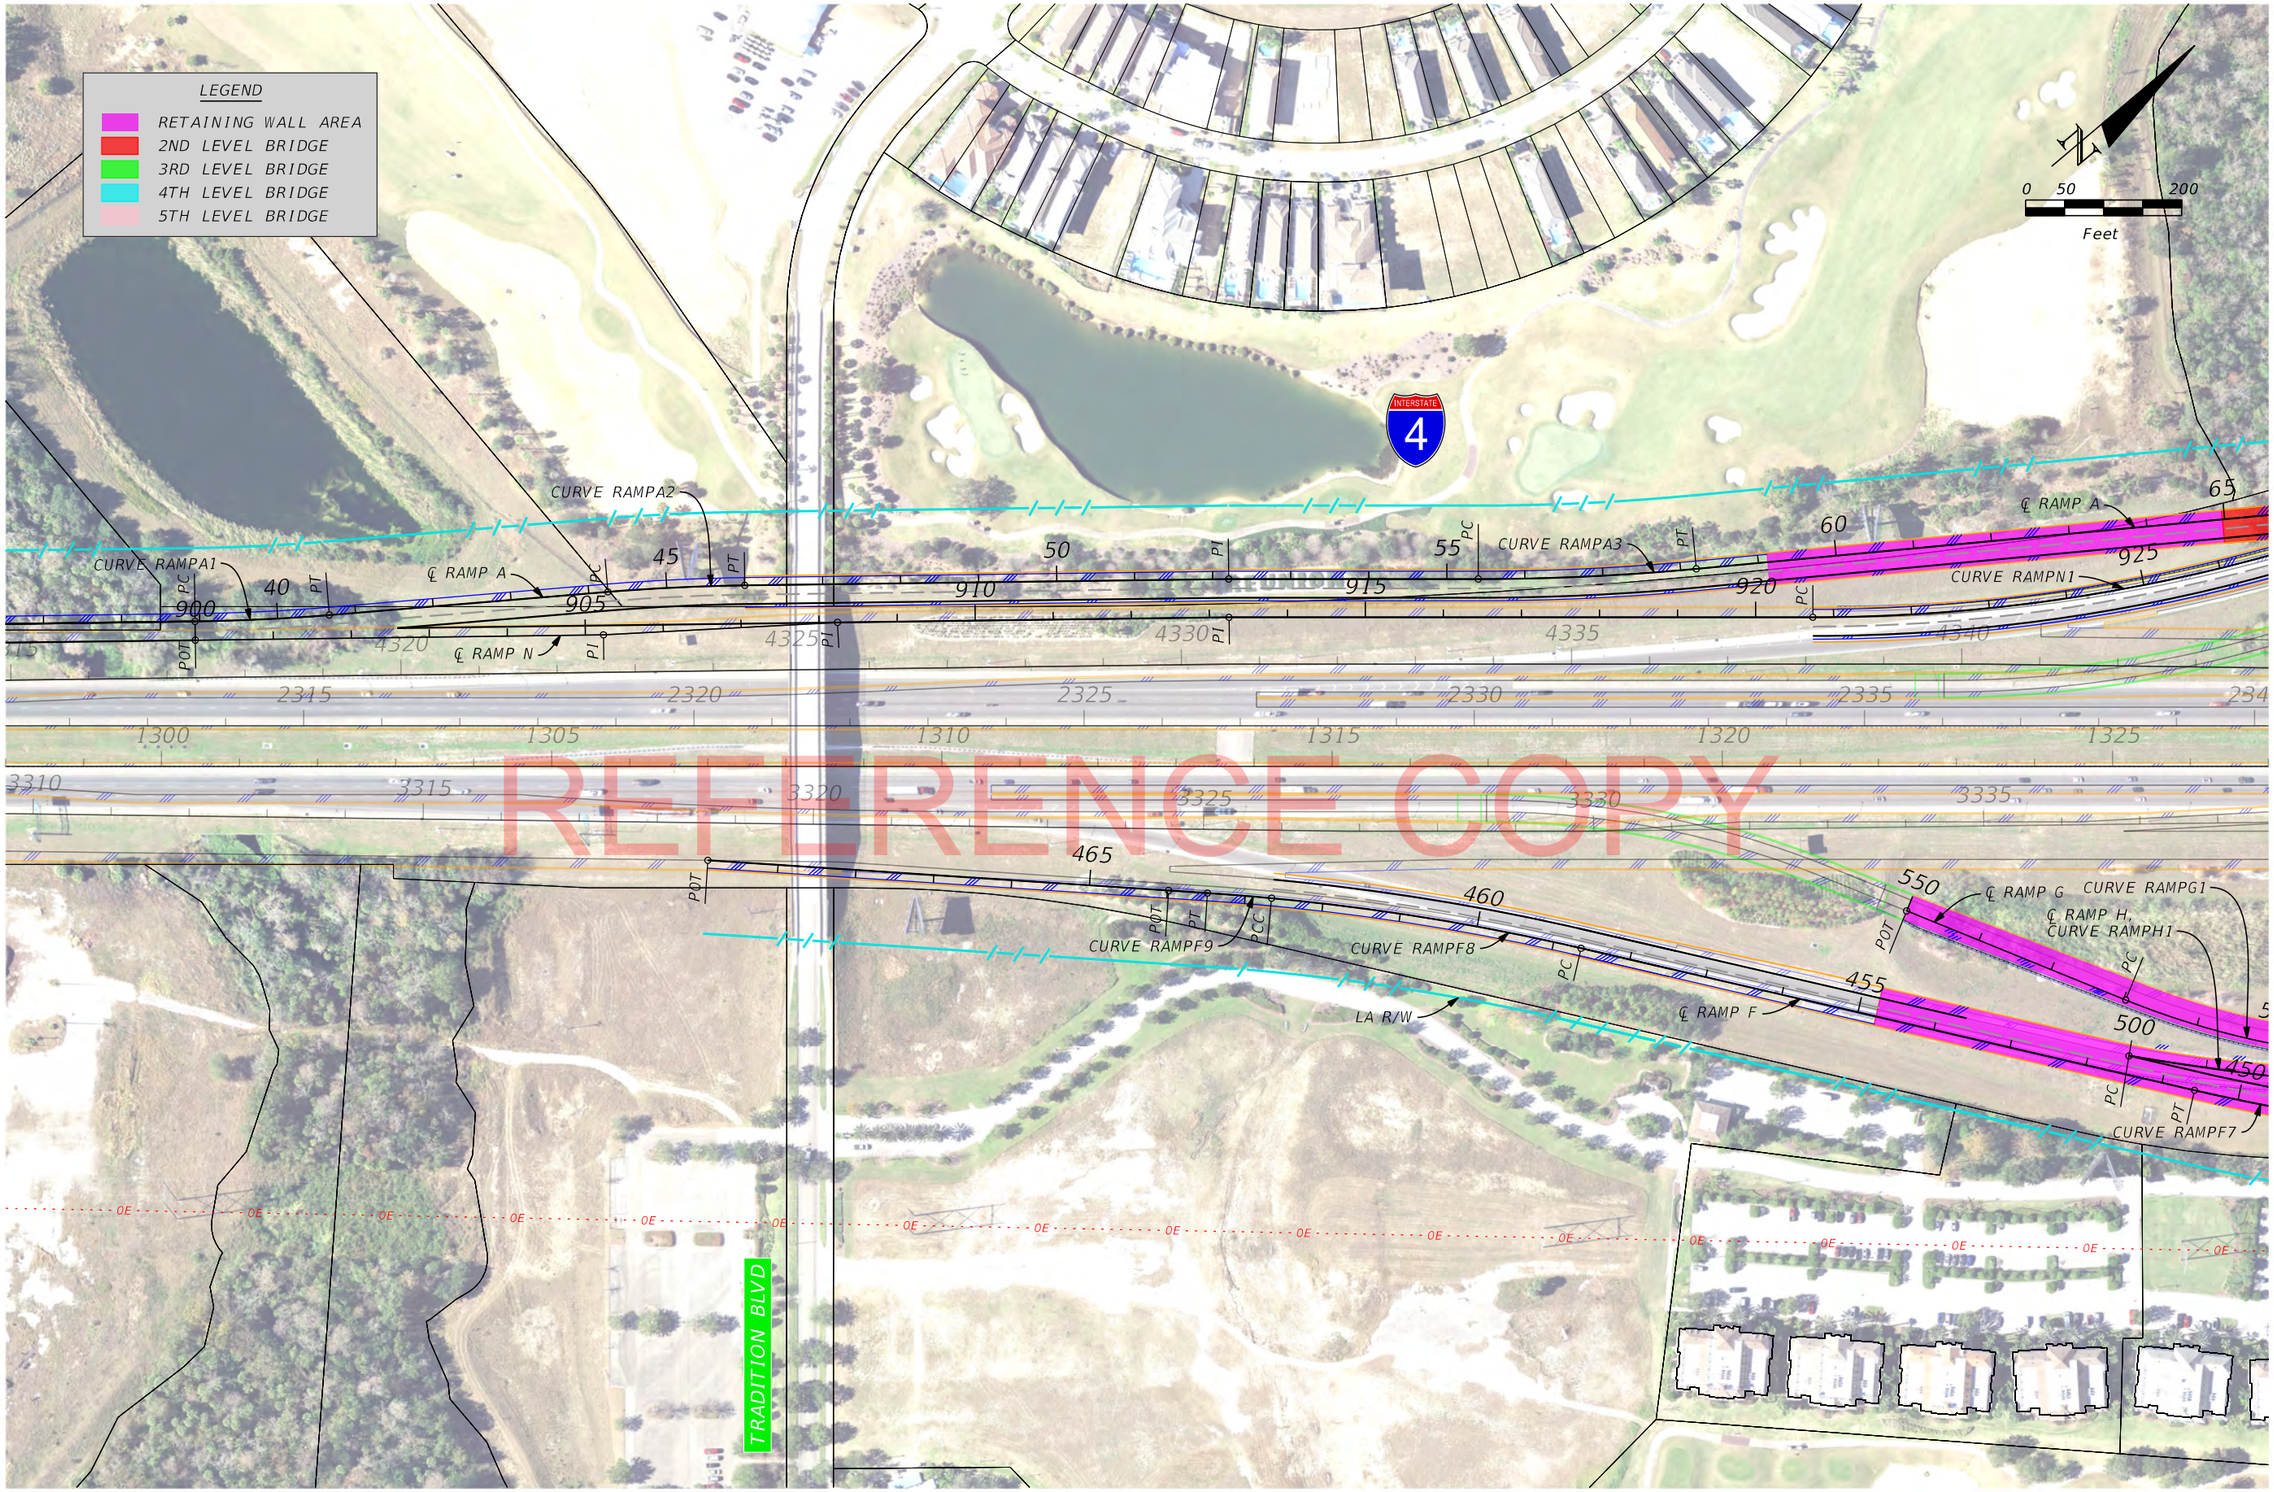

REVISIONS			
DATE	DESCRIPTION	DATE	DESCRIPTION

CENTRAL FLORIDA EXPRESSWAY AUTHORITY

Concept, Feasability and Mobility Study
for the
Poinciana Parkway Extension / I-4 Connector

Alternative 2A
I-4 Interchange at SR 429
Center Alignment

SHEET NO.
CA-10

LEGEND

- RETAINING WALL AREA
- 2ND LEVEL BRIDGE
- 3RD LEVEL BRIDGE
- 4TH LEVEL BRIDGE
- 5TH LEVEL BRIDGE

0 50 200
Feet

POTENTIAL POND

SR 429

INTERSTATE 4

OLD LAKE WILSON RD

POINCIANA PKWY EXT / I-4 CONNECTOR

℄ RAMP N
℄ RAMP J
℄ RAMP L
℄ RAMP I
℄ RAMP A
℄ RAMP E
℄ RAMP G
℄ RAMP H
℄ RAMP F
℄ RAMP K
℄ RAMP J
℄ RAMP B

CURVE RAMPL2
CURVE RAMPH4
CURVE RAMPL1
CURVE RAMPI2
CURVE RAMP4
CURVE RAMPA4
CURVE RAMPN1
CURVE RAMPG1
CURVE RAMPH1
CURVE RAMPG2
CURVE RAMPH3
CURVE RAMPH2
CURVE RAMPF7
CURVE RAMPF6
CURVE RAMPJ1
CURVE RAMPB2
CURVE RAMPK1
CURVE RAMPJ2
CURVE RAMPB1

LA R/W

FGT SUBSTATION

GULFSTREAM NATURAL GAS

COMMUNICATION TOWERS

REFERENCE COPY

REVISIONS			
DATE	DESCRIPTION	DATE	DESCRIPTION

CENTRAL FLORIDA EXPRESSWAY AUTHORITY

Concept, Feasability and Mobility Study
for the
Poinciana Parkway Extension / I-4 Connector

Alternative 2A
I-4 Interchange at SR 429
Center Alignment

SHEET NO.
CA-11

Bill.Lemos 3/21/2018 2:04:47 PM K:\ORL_TPTO\149800000___I-4 Connector\200_Engineering\CADD\roadway\Roadway Alignments\plans\plan2A_CI-31.dgn

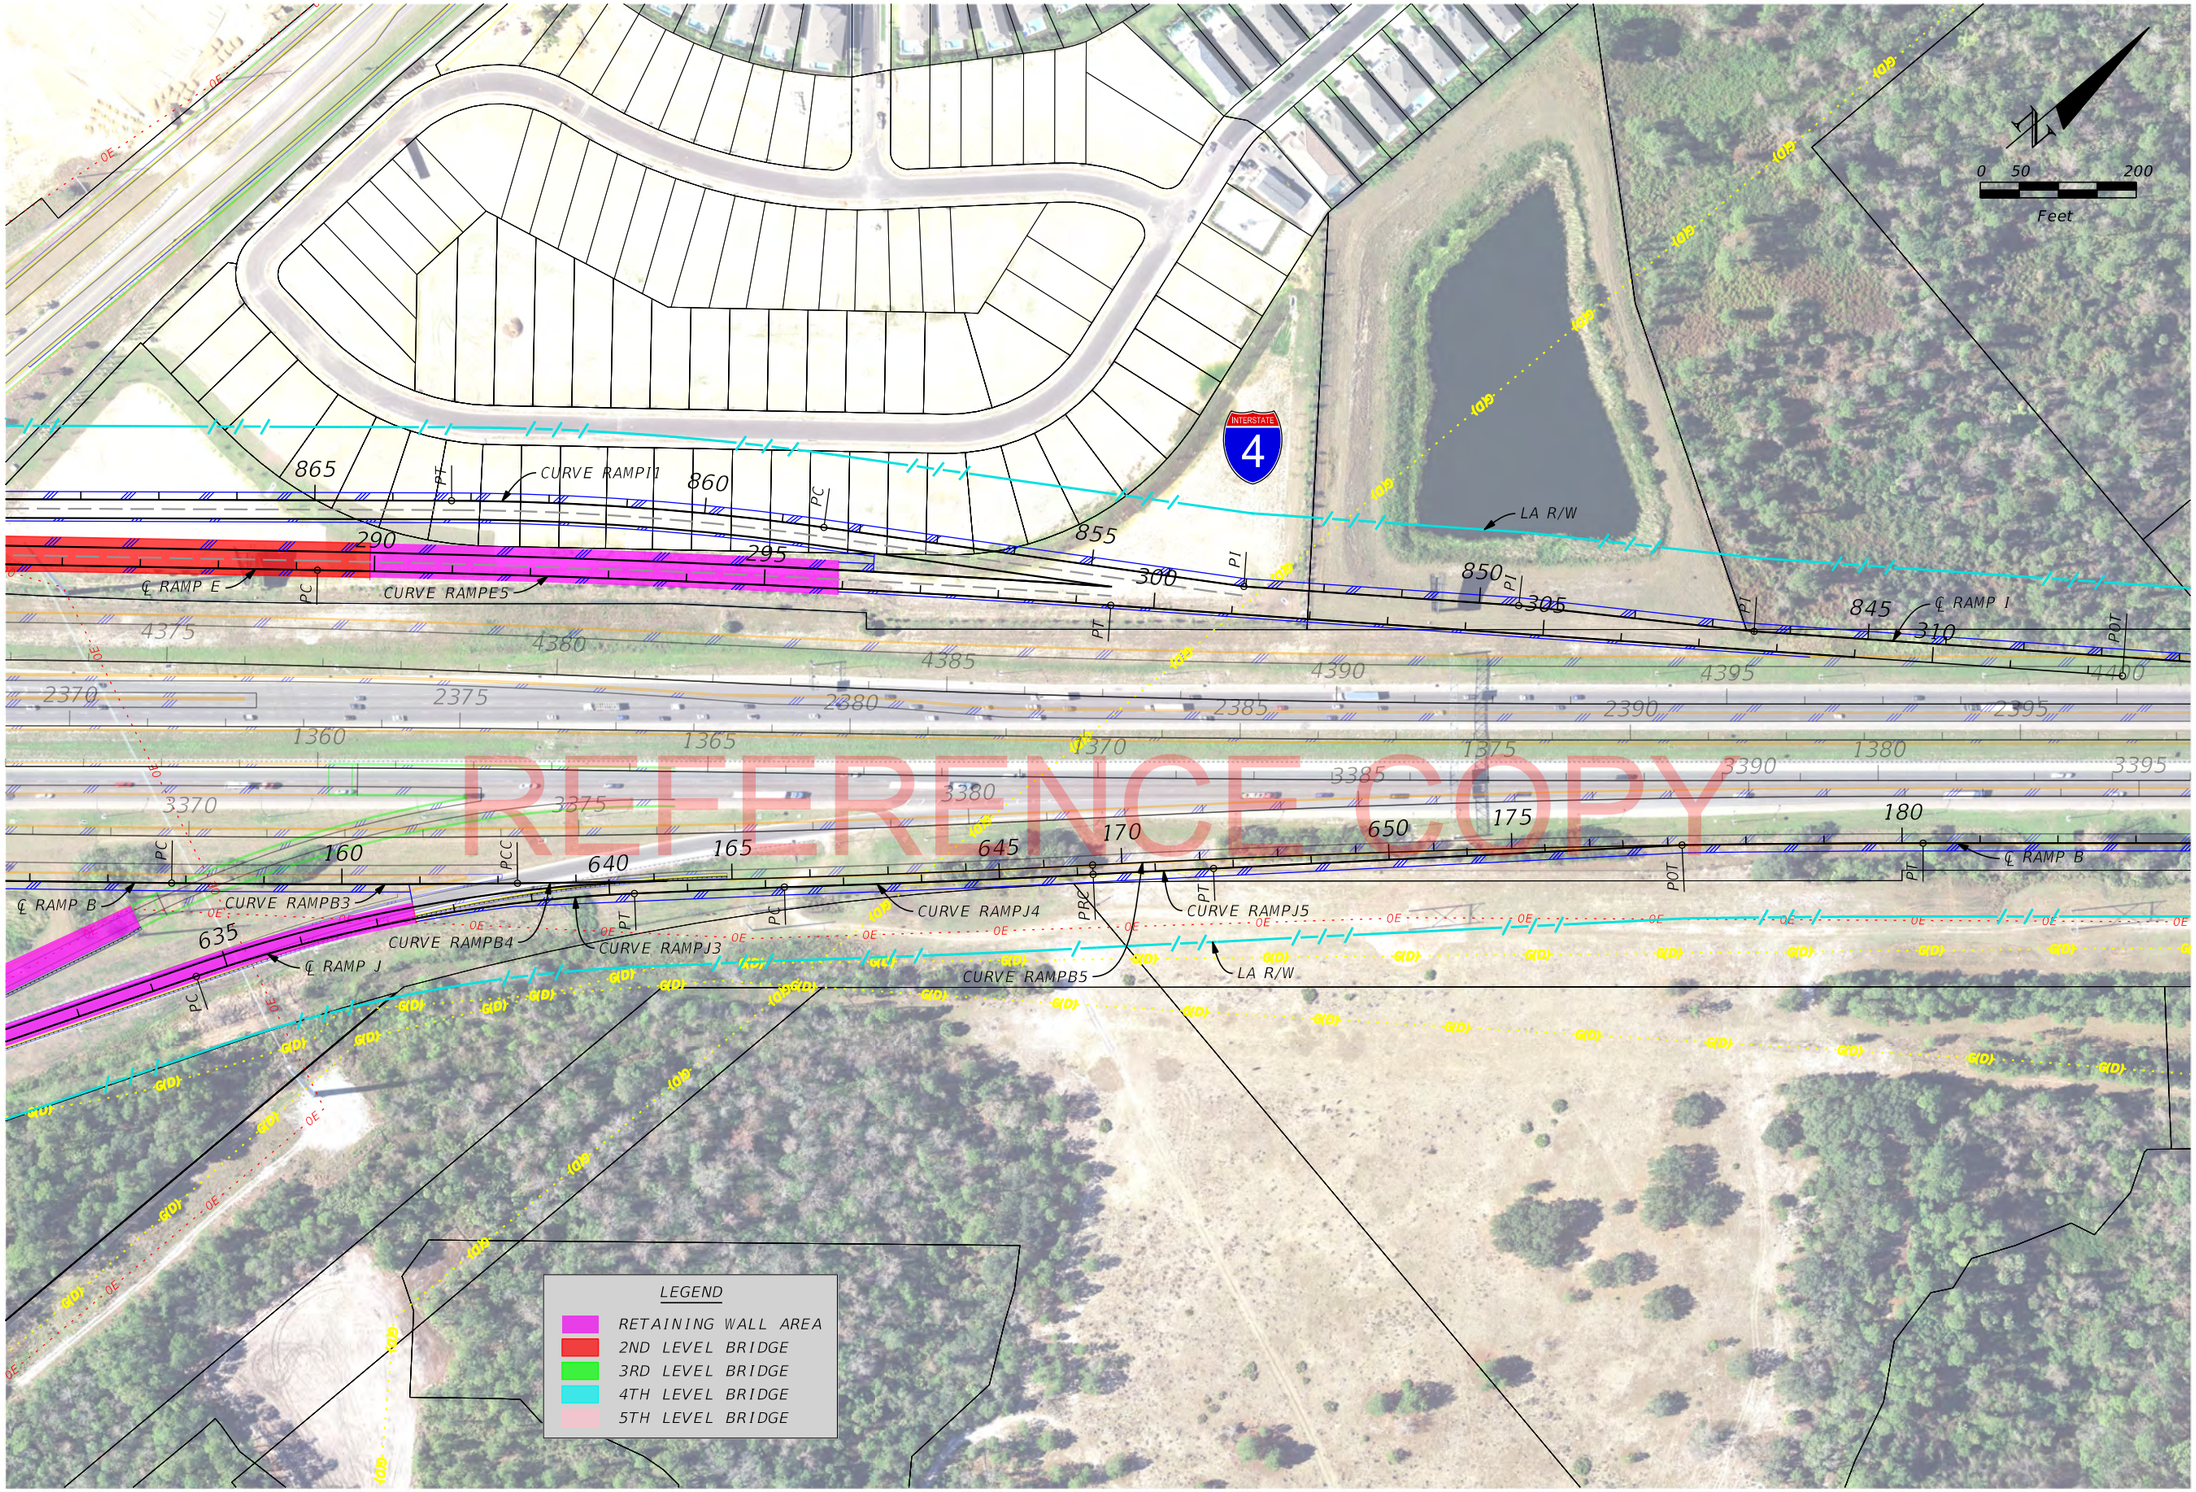

REFERENCE COPY

REVISIONS			
DATE	DESCRIPTION	DATE	DESCRIPTION

CENTRAL FLORIDA EXPRESSWAY AUTHORITY

Concept, Feasability and Mobility Study
for the
Poinciana Parkway Extension / I-4 Connector

Alternative 2A
I-4 Interchange at SR 429
Center Alignment

SHEET NO.
CA-12

REFERENCE COPY

REVISIONS			
DATE	DESCRIPTION	DATE	DESCRIPTION

CENTRAL FLORIDA EXPRESSWAY AUTHORITY

Concept, Feasability and Mobility Study
for the
Poinciana Parkway Extension / I-4 Connector

Alternative 2A
I-4 Interchange at SR 429
Center Alignment

SHEET NO.
CA-13

Bill.Lemos 3/21/2018 2:06:27 PM K:\ORL_TPTO\149800000___I-4 Connector\200_Engineering\CADD\roadway\Roadway Alignments\plans\plan2A_CI-33.dgn

Alternative 2A I-4 Interchange at SR 429 Center Alignment ~ Ramp Curve Data

RAMP A

CURVE DATA RAMPA1
PI STA. = 39+80.25
Δ = 3° 59' 09" (LT)
D = 2° 18' 51"
T = 86.16
L = 172.25
R = 2,476.00
PC STA. = 38+94.09
PT STA. = 40+66.34
e = 0.046

CURVE DATA RAMPA2
PI STA. = 45+12.46
Δ = 3° 59' 09" (RT)
D = 2° 16' 12"
T = 87.83
L = 175.59
R = 2,524.00
PC STA. = 44+24.63
PT STA. = 46+00.22
e = 0.045

CURVE DATA RAMPA3
PI STA. = 56+80.22
Δ = 5° 21' 38" (LT)
D = 1° 54' 56"
T = 140.02
L = 279.83
R = 2,991.00
PC STA. = 55+40.21
PT STA. = 58+20.04
e = 0.039

CURVE DATA RAMPA4
PI STA. = 80+57.64
Δ = 89° 01' 05" (RT)
D = 4° 44' 21"
T = 1,188.46
L = 1,878.37
R = 1,209.00
PC STA. = 68+69.18
PT STA. = 87+47.56
e = 0.081

RAMP B

CURVE DATA RAMPB1
PI STA. = 142+08.08
Δ = 57° 40' 18" (RT)
D = 8° 17' 30"
T = 380.44
L = 695.53
R = 691.00
PC STA. = 138+27.64
PT STA. = 145+23.17
e = 0.10

CURVE DATA RAMPB2
PI STA. = 149+37.23
Δ = 39° 25' 14" (RT)
D = 8° 17' 30"
T = 247.55
L = 475.42
R = 691.00
PC STA. = 146+89.67
PT STA. = 151+65.09
e = 0.10

CURVE DATA RAMPB3
PI STA. = 160+03.39
Δ = 1° 24' 21" (LT)
D = 0° 19' 02"
T = 221.56
L = 443.09
R = 18,060.00
PC STA. = 157+81.83
PT STA. = 162+24.92
e = NC

RAMP B

CURVE DATA RAMPB4
PI STA. = 165+93.69
Δ = 2° 20' 22" (LT)
D = 0° 19' 02"
T = 368.77
L = 737.43
R = 18,060.00
PC STA. = 162+24.92
PT STA. = 169+62.35
e = NC

CURVE DATA RAMPB5
PI STA. = 174+94.80
Δ = 2° 59' 04" (RT)
D = 0° 16' 49"
T = 532.45
L = 1,064.66
R = 20,440.00
PC STA. = 169+62.35
PT STA. = 180+27.01
e = NC

RAMP E

CURVE DATA RAMPE1
PI STA. = 202+11.51
Δ = 2° 41' 33" (LT)
D = 0° 38' 12"
T = 211.51
L = 422.94
R = 9,000.00
PC STA. = 200+00.00
PT STA. = 204+22.94
e = NC

CURVE DATA RAMPE2
PI STA. = 207+22.33
Δ = 2° 41' 33" (RT)
D = 0° 38' 12"
T = 211.51
L = 422.94
R = 9,000.00
PC STA. = 205+10.82
PT STA. = 209+33.76
e = NC

CURVE DATA RAMPE3
PI STA. = 252+49.09
Δ = 3° 22' 11" (RT)
D = 0° 16' 59"
T = 595.65
L = 1,190.95
R = 20,250.00
PC STA. = 246+53.44
PT STA. = 258+44.39
e = NC

CURVE DATA RAMPE4
PI STA. = 275+68.37
Δ = 97° 56' 41" (RT)
D = 4° 46' 29"
T = 1,379.10
L = 2,051.35
R = 1,200.00
PC STA. = 261+89.27
PT STA. = 282+40.62
e = 0.081

CURVE DATA RAMPE5
PI STA. = 294+35.95
Δ = 2° 54' 56" (RT)
D = 0° 17' 11"
T = 508.99
L = 1,017.76
R = 20,000.00
PC STA. = 289+26.96
PT STA. = 299+44.72
e = NC

RAMP F

CURVE DATA RAMPF1
PI STA. = 373+50.06
Δ = 2° 41' 33" (LT)
D = 0° 38' 18"
T = 210.94
L = 421.81
R = 8,976.00
PC STA. = 371+39.11
PT STA. = 375+60.92
e = NC

CURVE DATA RAMPF2
PI STA. = 378+60.88
Δ = 2° 41' 33" (RT)
D = 0° 38' 06"
T = 212.07
L = 424.07
R = 9,024.00
PC STA. = 376+48.81
PT STA. = 380+72.87
e = NC

CURVE DATA RAMPF3
PI STA. = 415+27.59
Δ = 2° 36' 20" (LT)
D = 0° 38' 18"
T = 204.13
L = 408.20
R = 8,976.00
PC STA. = 413+23.46
PT STA. = 417+31.66
e = NC

CURVE DATA RAMPF4
PI STA. = 420+76.40
Δ = 4° 22' 32" (RT)
D = 0° 38' 06"
T = 344.74
L = 689.14
R = 9,024.00
PC STA. = 417+31.66
PT STA. = 424+20.80
e = NC

CURVE DATA RAMPF5
PI STA. = 427+04.52
Δ = 1° 35' 59" (RT)
D = 0° 16' 55"
T = 283.72
L = 567.41
R = 20,322.00
PC STA. = 424+20.80
PT STA. = 429+88.21
e = NC

CURVE DATA RAMPF6
PI STA. = 438+74.21
Δ = 78° 34' 35" (LT)
D = 8° 17' 30"
T = 565.34
L = 947.65
R = 691.00
PC STA. = 433+08.86
PT STA. = 442+56.51
e = 0.10

CURVE DATA RAMPF7
PI STA. = 448+70.76
Δ = 8° 28' 46" (RT)
D = 2° 16' 12"
T = 187.11
L = 373.54
R = 2,524.00
PC STA. = 446+83.65
PT STA. = 450+57.18
e = 0.045

CURVE DATA RAMPF8
PI STA. = 460+65.37
Δ = 7° 42' 11" (LT)
D = 1° 54' 56"
T = 201.36
L = 402.12
R = 2,991.00
PC STA. = 458+64.01
PT STA. = 462+66.13
e = 0.039

RAMP F

CURVE DATA RAMPF9
PI STA. = 463+07.33
Δ = 1° 34' 43" (LT)
D = 1° 54' 56"
T = 41.21
L = 82.41
R = 2,991.00
PC STA. = 462+66.13
PT STA. = 463+48.54
e = 0.039*

RAMP G

CURVE DATA RAMPG1
PI STA. = 554+64.11
Δ = 18° 02' 26" (LT)
D = 5° 38' 42"
T = 161.13
L = 319.59
R = 1,015.00
PC STA. = 553+02.98
PT STA. = 556+22.57
e = 0.089

CURVE DATA RAMPG2
PI STA. = 561+98.90
Δ = 24° 26' 55" (LT)
D = 5° 38' 42"
T = 219.90
L = 433.11
R = 1,015.00
PC STA. = 559+79.00
PT STA. = 564+12.10
e = 0.089

RAMP H

CURVE DATA RAMPH1
PI STA. = 501+79.83
Δ = 5° 08' 54" (LT)
D = 1° 25' 57"
T = 179.83
L = 359.42
R = 4,000.00
PC STA. = 500+00.00
PT STA. = 503+59.42
e = 0.030

CURVE DATA RAMPH2
PI STA. = 508+60.73
Δ = 27° 59' 43" (LT)
D = 5° 38' 42"
T = 253.02
L = 495.94
R = 1,015.00
PC STA. = 506+07.71
PT STA. = 511+03.64
e = 0.089

CURVE DATA RAMPH3
PI STA. = 517+81.23
Δ = 61° 33' 15" (LT)
D = 5° 35' 43"
T = 609.87
L = 1,100.11
R = 1,024.00
PC STA. = 511+71.36
PT STA. = 522+71.47
e = 0.089

RAMP H

CURVE DATA RAMPH4
PI STA. = 530+41.26
Δ = 11° 03' 46" (RT)
D = 0° 43' 15"
T = 769.79
L = 1,534.79
R = 7,949.00
PC STA. = 522+71.47
PT STA. = 538+06.26
e = RC

RAMP I

CURVE DATA RAMPI1
PI STA. = 860+85.84
Δ = 7° 47' 07" (LT)
D = 1° 37' 33"
T = 239.79
L = 478.84
R = 3,524.00
PC STA. = 858+46.05
PT STA. = 863+24.89
e = 0.034

CURVE DATA RAMPI2
PI STA. = 881+97.30
Δ = 98° 15' 22" (RT)
D = 7° 09' 43"
T = 924.46
L = 1,371.91
R = 800.00
PC STA. = 872+72.84
PT STA. = 886+44.76
e = 0.098

CURVE DATA RAMPI3
PI STA. = 893+75.51
Δ = 6° 27' 23" (RT)
D = 1° 55' 31"
T = 167.86
L = 335.36
R = 2,976.00
PC STA. = 892+07.66
PT STA. = 895+43.01
e = 0.039

RAMP J

CURVE DATA RAMPJ1
PI STA. = 620+63.45
Δ = 105° 30' 16" (LT)
D = 5° 14' 14"
T = 1,438.80
L = 2,014.49
R = 1,094.00
PC STA. = 606+24.66
PT STA. = 626+39.15
e = 0.085

CURVE DATA RAMPJ2
PI STA. = 628+79.76
Δ = 24° 40' 37" (LT)
D = 5° 12' 31"
T = 240.61
L = 473.76
R = 1,100.00
PC STA. = 626+39.15
PT STA. = 631+12.91
e = 0.085

RAMP J

CURVE DATA RAMPJ3
PI STA. = 637+46.96
Δ = 16° 25' 24" (RT)
D = 2° 51' 53"
T = 288.62
L = 573.28
R = 2,000.00
PC STA. = 634+58.34
PT STA. = 640+31.63
e = 0.055

CURVE DATA RAMPJ4
PI STA. = 644+21.99
Δ = 1° 15' 19" (LT)
D = 0° 19' 01"
T = 197.99
L = 395.96
R = 18,072.00
PC STA. = 642+24.00
PT STA. = 646+19.96
e = NC

CURVE DATA RAMPJ5
PI STA. = 646+97.23
Δ = 0° 26' 00" (RT)
D = 0° 16' 50"
T = 77.27
L = 154.53
R = 20,428.00
PC STA. = 646+19.96
PT STA. = 647+74.49
e = NC

RAMP K

CURVE DATA RAMPK1
PI STA. = 582+35.53
Δ = 24° 17' 38" (LT)
D = 5° 14' 09"
T = 235.53
L = 463.99
R = 1,094.30
PC STA. = 580+00.00
PT STA. = 584+63.99
e = 0.085

RAMP L

CURVE DATA RAMPL1
PI STA. = 713+16.56
Δ = 97° 26' 18" (RT)
D = 8° 11' 06"
T = 797.33
L = 1,190.43
R = 700.00
PC STA. = 705+19.23
PT STA. = 717+09.66
e = 0.10

CURVE DATA RAMPL2
PI STA. = 719+88.02
Δ = 4° 01' 48" (RT)
D = 0° 43' 27"
T = 278.36
L = 556.49
R = 7,912.00
PC STA. = 717+09.66
PT STA. = 722+66.16
e = RC

REFERENCE COPY

REVISIONS			
DATE	DESCRIPTION	DATE	DESCRIPTION

CENTRAL FLORIDA EXPRESSWAY AUTHORITY

Concept, Feasability and Mobility Study
for the
Poinciana Parkway Extension / I-4 Connector

Alternative 2A
I-4 Interchange at SR 429
Center Alignment

SHEET NO.
CA-14

Alternative 2A I-4 Interchange at SR 429 Center Alignment ~ Ramp Curve Data

RAMP M

CURVE DATA RAMPM1
PI STA. = 756+61.07
Δ = 4° 58' 25" (LT)
D = 2° 17' 31"
T = 108.57
L = 217.01
R = 2,500.00
PC STA. = 755+52.50
PT STA. = 757+69.51
e = 0.046

CURVE DATA RAMPM2
PI STA. = 759+37.77
Δ = 4° 58' 25" (RT)
D = 3° 01' 15"
T = 82.37
L = 164.64
R = 1,896.65
PC STA. = 758+55.40
PT STA. = 760+20.03
e = 0.057

CURVE DATA RAMPM3
PI STA. = 765+51.18
Δ = 19° 42' 09" (LT)
D = 3° 51' 30"
T = 257.87
L = 510.65
R = 1,485.00
PC STA. = 762+93.31
PT STA. = 768+03.96
e = 0.070

RAMP N

CURVE DATA RAMPN5
PI STA. = 973+64.02
Δ = 3° 16' 09" (RT)
D = 1° 02' 49"
T = 156.18
L = 312.28
R = 5,472.84
PC STA. = 972+07.83
PT STA. = 975+20.11
e = 0.022

CURVE DATA RAMPN6
PI STA. = 977+08.76
Δ = 16° 42' 11" (LT)
D = 4° 27' 32"
T = 188.64
L = 374.61
R = 1,285.00
PC STA. = 975+20.11
PT STA. = 978+94.72
e = 0.078

CURVE DATA RAMPN7
PI STA. = 984+79.96
Δ = 9° 47' 53" (RT)
D = 1° 55' 21"
T = 255.47
L = 509.69
R = 2,980.45
PC STA. = 982+24.49
PT STA. = 987+34.18
e = 0.039

RAMP N

CURVE DATA RAMPN1
PI STA. = 937+32.31
Δ = 74° 02' 21" (LT)
D = 2° 36' 16"
T = 1,659.00
L = 2,842.90
R = 2,200.00
PC STA. = 920+73.31
PT STA. = 949+16.21
e = 0.051

CURVE DATA RAMPN2
PI STA. = 959+86.76
Δ = 0° 19' 14" (LT)
D = 0° 28' 42"
T = 33.50
L = 67.00
R = 11,976.00
PC STA. = 959+53.26
PT STA. = 960+20.26
e = NC

CURVE DATA RAMPN3
PI STA. = 965+76.85
Δ = 1° 18' 08" (LT)
D = 2° 53' 11"
T = 22.56
L = 45.11
R = 1,985.00
PC STA. = 965+54.29
PT STA. = 965+99.41
e = 0.055

CURVE DATA RAMPN4
PI STA. = 971+65.51
Δ = 0° 29' 14" (LT)
D = 0° 34' 32"
T = 42.33
L = 84.65
R = 9,955.00
PC STA. = 971+23.18
PT STA. = 972+07.83
e = NC

RAMP P

CURVE DATA RAMPP1
PI STA. = 804+66.95
Δ = 13° 22' 12" (RT)
D = 4° 12' 38"
T = 159.49
L = 317.53
R = 1,360.75
PC STA. = 803+07.46
PT STA. = 806+25.00
e = 0.075

CURVE DATA RAMPP2
PI STA. = 808+43.28
Δ = 16° 46' 23" (LT)
D = 7° 38' 22"
T = 110.57
L = 219.56
R = 750.00
PC STA. = 807+32.71
PT STA. = 809+52.27
e = 0.099

CURVE DATA RAMPP3
PI STA. = 824+99.53
Δ = 12° 15' 46" (RT)
D = 1° 25' 57"
T = 429.70
L = 856.11
R = 4,000.00
PC STA. = 820+69.83
PT STA. = 829+25.94
e = 0.030

REFERENCE COPY

REVISIONS			
DATE	DESCRIPTION	DATE	DESCRIPTION

CENTRAL FLORIDA EXPRESSWAY AUTHORITY

Concept, Feasability and Mobility Study
for the
Poinciana Parkway Extension / I-4 Connector

Alternative 2A
I-4 Interchange at SR 429
Center Alignment

SHEET NO.
CA-15

APPENDIX J


REFERENCE COPY

Table of Contents

Pond Sizing Methodology 2
General Overview 2
Treatment Volume 2
Attenuation Volume 3
Floodplain Evaluation 5
Base Flood Elevation (BFE) 6
Seasonal high water table (SHWT) 7
Assessing Floodplain Impacts 7
Pond Sizing 9
Pond Quantities 10

LIST OF FIGURES

- Figure A-1: Data Collection - Permit Coverage
- Figure A-2: Data Collection: NRCS Soils Coverage
- Figure A-3: Existing Land Cover/Land Use
- Figure A-4: Proposed Land Cover/Land Use
- Figure A-5: Floodplain Impacts - FEMA Flood Zones
- Figure A-6: Floodplain Impacts - Inundated Floodplains & SHWT

REFERENCE COPY

LIST OF APPENDICES

Appendix A – Pond Sizing Calculations

- Table A.1 – Attenuation Volume Summary
- Table A.2 – Treatment Volume Summary – Assumes Wet Detention Ponds
- Table A.3 – Floodplain Impacts
- Table A.4 – Pond Sizing Calculations
- Table A.5 – Pond Quantities Calculations
- Table A.6 – Pond Right-of-Way Area Summary
- Table A.7 – Pond Construction Quantity Summary

Pond Sizing Methodology

General Overview

The required pond volume for the proposed improvements is calculated by the following:

$$Total\ Pond\ Volume\ Required = Required\ Treatment\ Volume + Required\ Attenuation\ Volume + Floodplain\ Impact\ Volume$$

The treatment volume includes the first flush runoff volume from the proposed developed site to be retained and treated prior to discharging downstream. The attenuation volume includes the storage of the additional excess runoff caused by the proposed development by minimizing the peak flowrate from the site to mimic pre-development conditions so as not to adversely impact offsite properties. The floodplain impact volume includes the storage between the seasonal high water table and the 100-year event that is impacted due to the proposed development.

The basin area includes the alignment corridor right-of-way, which was divided into several subbasins along floodplain or hydraulic boundaries from the existing topology; proposed roadway profiles were not developed. Interchanges that connect the I-4/Poinciana Parkway Connector Expressway to various side streets were evaluated separately by creating additional subbasins for the interchange outside of the mainline corridor. It is assumed that each subbasin will have one pond, which is sized using the methodology described within the following sections. Evaluation of basin delineation, pond sites, and their potential impacts (with regard to maintenance, constructability, aesthetics, environmental, social, and cultural, etc.) will be conducted within the PD&E phase. All assumptions were based on the best available data from desktop review.

REFERENCE COPY

Within this feasibility effort, it is assumed that each of the pond volume parameters are "stacked" instead of taking credit for any possible volume overlapping; this provides a conservative estimate which can be further evaluated within the PD&E phase. The methodology used to determine these parameters for calculating pond volumes are described within the following sections.

Treatment Volume

For the purposes of the feasibility study, all proposed ponds are assumed to be wet. The required treatment volume for wet ponds is larger than dry ponds and the water tables are generally shallow within the project area. It assumed that evaluation of pond types will be accomplished during the PD&E phase.

The SFWMD required treatment volume criterion for a wet detention pond is the greatest volume of either 1-inch over the basin or 2.5-inches over the new impervious area. Part of the project area is located within the Reedy Creek Mitigation Bank drainage area, and the entire project is located with Lake Okeechobee BMAP, both of which require an additional 50% of additional treatment volume.

$$Treatment\ Volume = Greatest\ of\ 1"\ over\ Basin\ Area\ or\ 2.5"\ over\ New\ Impervious\ Area$$

$$BMAP\ Treatment\ Volume = 1.5 * Treatment\ Volume$$

Existing roadway impervious areas in the areas of the proposed alternative alignments were digitized via aerial imagery. The I-4 Beyond the Ultimate (BTU) roadway design files were obtained and the BTU proposed improvements were digitized and assumed to be the existing condition for this feasibility study. The proposed I-4/Poinciana Parkway Connector roadway impervious area along the mainline and the interchanges with I-4, Osceola Polk County Line Road, and US 17/92 were digitized from the feasibility roadway design files. The impervious area along the mainline includes a fully paved median resulting in a total impervious width of 156-feet. The impervious area for the interchange ramps assumed shoulder widths of 2 foot inside and 4 foot outside for single lane ramps, and 4 foot inside and 10 foot outside for two lane ramps where barrier walls were not shown.

CR 532 has existing stormwater management facilities that provide treatment and attenuation along CR 532 from I-4 to Old Lake Wilson Road (CR 545) under SFWMD ERP Application No. 051118-5 and 020114-21. There are also various existing stormwater management facilities treating and attenuating commercial and residential properties proposed to be impacted by each alignment, such as Legacy Callawalk under SWFWMD ERP Application No. 31438-6, Lake Wilson Preserve under SWFWMD Permit No. 22488, Tanglewood under SWFWMD Permit No. 27257-4, or Sandy Ridge under SWFWMD Permit No. 23879. Neither the impact to the existing stormwater ponds nor the available capacity in these ponds was evaluated within this effort and is expected to be evaluated within the PD&E phase.

Attenuation Volume

Criteria set forth by SFWMD, SWFWMD, and Osceola County was reviewed to determine the governing criteria from these agencies. It was determined that the controlling criteria for attenuation to use for this study is the SFWMD requirement due to most of the project being within SFWMD and the criteria being more stringent. The criteria utilized is that the post-development peak flow rate is not to exceed the pre-development peak flow rate for the 25-yr/72-hr storm event. It was determined that the I-4/Poinciana Parkway Connector Expressway design storm would require retaining volume from 10.5-inches of rainfall (SFWMD Isohyetal Maps, ERP HB Appendix C). Since no routing is being performed during this feasibility phase, the attenuation volume will be based on the pre-post difference in volume generation, not peak discharge rate.

REFERENCE COPY

The SCS Runoff Curve Number (CN) Method was used to determine the total runoff generation for the pre-development and post-development conditions. The SFWMD land cover and land use, dated 2008/09, was modified to include existing roadway impervious area and I-4 Beyond the Ultimate design files within the corridor basins to determine the CN for the pre-development condition. The I-4/Poinciana Parkway Connector Expressway alternative alignments were digitized, as described above, to determine the difference in land use along the proposed corridors.

$$Runoff = \frac{(P - 0.2S)^2}{(P + 0.8S)}$$

$$S = \frac{1000}{CN} - 10$$

$$Volume = Runoff * Basin\ Area$$

$$Attenuation\ Volume\ =\ Post\ Development\ Volume\ -\ Pre\ Development\ Volume$$

For basins that have a lower CN in the post-development condition, (e.g. wetland land coverage is converted to impervious area and open – good land uses), the attenuation volume is assumed zero and no credit is provided for generating a lower runoff volume. See **Table 1** for the conversion between the Florida Land Use and Cover Classification System (FLUCCS) within the SFWMD land use file to the CN land use categories to determine the attenuation volume.

TABLE 1 - CONVERSION OF FLUCCS LAND USE DESCRIPTIONS TO SCS RUNOFF CURVE NUMBER CATEGORY

FLUCCS	SCS Runoff CN (TR-55)

REFERENCE COPY

FLUCCS	SCS Runoff CN (TR-55)

REFERENCE COPY

Floodplain Evaluation

For the floodplain analysis, potential impacts to the Federal Emergency Management Agency (FEMA) mapped floodplains as part of the Osceola County June 2013 FIS and Polk County December 2016 FIS were reviewed and quantified. Flood zones classified as Zone X, Zone AE, and Zone A are present along the corridor and only these FEMA-approved floodplain areas were reviewed and quantified for impacts. Natural historic depressions or wetlands were not evaluated for floodplain impacts as part of this feasibility study, but may require further evaluation in future phases.

Zone X is an area of minimal flood hazard and was not evaluated for floodplain impacts. There is one Zone D floodplain within the project area, throughout Reedy Creek and adjacent to the Sabal Trail underground utility line. According to FEMA, a Zone D designation is used where there are possible but undetermined flood hazards, as no analysis of flood hazards has been conducted. Zone AE has an

established Base Flood Elevation (BFE) that has been approved by FEMA. Zone A has an identified area of inundation resulting from the 100-year storm event, but no BFE has been established. To assess the floodplain impacts for each corridor, an approximate BFE and Seasonal High Water Table (SHWT) for the FEMA floodplain shapes was established. These elevations were estimated using the best available data and considered the following sources in **Table 2**. No site-specific information (i.e. geotechnical testing, wetland survey, topographic survey, etc.) was obtained for these estimates. No hydrologic/hydraulic modeling was performed. Some of the information reviewed utilized the NGVD 1929 vertical datum; this information was converted to the NAVD 1988 vertical datum using Corpscon v6 as follows: 0.00 ft NGVD = -0.91 ft NAVD.

TABLE 2 - DESCRIPTION OF DATA REVIEWED IN PRELIMINARY ANALYSIS

Data	Source	Relevance
DEM or Contours developed from source	2016 LiDAR data from Osceola County in 3-ft grid format; 2005 Polk County LiDAR in 5-ft grid format	High
Infrared aerial imagery	2004 Osceola County	High
Historic aerial imagery	Google Earth (dating back to 1995) and UF Historical Imagery Library (dating back to 1959)	High
Geotechnical borings	SWFWMD & SFWMD ERP Applications	High
Wet detention ponds normal water elevations	SWFWMD & SFWMD ERP Applications	High
Wetland seasonal high water tables	SWFWMD & SFWMD ERP Applications	High
Canal monitoring stations ○ Stage ○ Flow	SFWMD Arc Hydro database	High
Soil coverage	NRCS coverage provided by USDA	Medium – Depth to water table information
Depth to Surficial Aquifer Water Table	FDEP Florida Aquifer Vulnerability Assessment (FAVA)	Low – Information available is very coarse (6,000 feet x 6000 feet grid)
USGS 7.5-Minute Quad Maps with 5-ft contours (ft, NGVD29)	USGS Quad Maps: Davenport and Intercession City	Low (dated 1980 & 2015)
Land use land coverage	SFWMD	Low – Ensure floodplain is still applicable

REFERENCE COPY

Base Flood Elevation (BFE)

The BFE can vary across the extent of the floodplain based on local topography, the amount of vegetative cover, presence of urbanization, water control infrastructure, and inflows to the floodplain. To estimate the BFE, the factors local to the area of potential impacts was weighted heavier. If the BFE

was estimated from a provided source (i.e. Zone AE, permit data, etc.), the elevation was rounded to the nearest 0.1 foot; if the elevation was estimated from the DEM, it was rounded to the nearest half foot. The following ranking was applied in order to estimate the BFE:

1. FEMA established BFE (i.e. Zone AE or LOMR)
2. Modeled BFE as part of an Environmental Resource Permit (ERP) application
3. Floodplain compensation pond information within an ERP application
4. Stage data from regulated lakes and canals (Using HEC SSP to estimate the 100-year stage)
5. Comparison of infrared and historic aerial images to the DEM to estimate high water elevations in previous years (i.e. inspection of tree line migration, etc.)
6. USGS 7.5 Minute Quad Maps with 5-ft contours (NGVD29)
7. Comparison of FEMA-mapped floodplain shape and DEM or contours derived from DEM

Seasonal high water table (SHWT)

The seasonal high water table (SHWT) is the elevation to which the water table can be expected to rise due to a normal wet season. The water table surface is generally parallel to the natural ground surface in relatively flat areas with uniform soil type. Approximately 65% of the project area for the I-4/Poinciana Parkway Connector consists of Type A/D soils. These soils are poorly drained when wet and have water table depths typically between 3.5 foot below ground and 2 feet above ground within the project area. The remaining soils within the project area are Type A (30%), B/D (2%), and C/D (2%).

To estimate the SHWT, the factors local to the area of potential impacts was weighted heavier. If the SHWT is estimated from a provided source (i.e. stage data, permit data, etc.), the elevation is estimated to the nearest 0.1 foot; if the elevation is estimated from the DEM, it is estimated to the nearest half foot. The following ranking was applied in order to estimate the SHWT:

REFERENCE COPY

1. The average annual wet season stage in the lakes and canals with regulated flood control where stage data is available. (Wet season is defined as June through October.)
2. Surveyed SHWT provided in an ERP application.
3. Wet detention pond information in an ERP application; Note it is understood that the normal water elevation is not equivalent to the SHWT, but it can serve as a reliable approximation.
4. Tailwater information from an ERP application if tailwater (or initial stage of tailwater) is identified as being representative of the SHWT.
5. Comparison of adjacent wetland shapes to the DEM to estimate wetland SHWT.
6. Comparison of infrared and historic aerial images to the DEM to estimate water elevations in previous years (i.e. visible standing water, etc.).
7. NRCS soils depth to water table applied over the DEM.

In one instance, an unnamed lake was given a waterbody elevation within the GIS layer NHD (National Hydrograhy Dataset) Waterbody, published by USGS. This elevation was used as the SHWT of the encompassing floodplain boundary (ID 24).

Assessing Floodplain Impacts

For the conceptual alignments, the floodplain impact volume was calculated by the following:

$$Floodplain\ Impact\ Volume = Floodplain\ Depth\ x\ Inundation\ Area$$

The floodplain depth is the difference between the BFE and the ground surface topography or the seasonal high water table (SHWT), whichever is higher. The minimum ground surface elevation within the 100-year inundation was used for the floodplain depth if the SHWT was below ground.

The Inundation Area is the average of the area of the BFE and SHWT (area of zero if below ground) plotted on the DEM within the right-of-way (R/W) of the conceptual corridors. Each FEMA floodplain shape was given a buffered boundary for creating the inundation plot. The inundation plot was performed because the 100-year FEMA floodplain boundary is coarse in many areas and may not encompass the actual low points as captured within the 2016 Osceola LiDAR and 2005 Polk LiDAR. The I-4 existing right-of-way was excluded from the floodplain impact analysis; it was assumed that I-4 Beyond the Ultimate will provide compensation for any floodplain impacts that occur within the existing right-of-way. In the instance of a waterbody that was not inundated due to LiDAR gaps within the DEM, additional manual digitization was performed to connect the SHWL & BFE inundation shapes along that waterbody (Floodplain ID 38). This was not performed on any permitted ponds that have been developed after the LiDAR was flown; it was assumed that these additional impacts will be further evaluated within the PD&E phase.

The conceptual corridors analyzed for floodplain impacts are as follows: CR 532 Alt. 1A, CR 532 Alt. 2, CR 532 Alt. 3, SR 429 Alt. 3, SR 429 Alt. 4, 2A-1, 2A-2, 2A-3, 2A-4, 2A-5, 3-2N, 3-2S, 3-5N, 3-5S, 3A-3, and 3A-5. These corridors will construct Poinciana Parkway to the ultimate condition and extend Poinciana Parkway to I-4. Poinciana Parkway was constructed in 2016 for an interim condition with primary and secondary drainage infrastructure designed for the ultimate configuration. According to SFWMD Permit Application 141010-12 (Segments 1, 2, & 3), floodplain encroachment within Poinciana Parkway has been compensated for within proposed stormwater management facilities and ditches; therefore, no additional floodplain impacts are anticipated throughout the Poinciana Parkway corridor. The floodplain impacts within the existing Poinciana Parkway corridor were removed by intersecting the inundation plots with the estimated (from 2016 parcel lines) Poinciana Parkway R/W. All corridors utilize a 324-foot R/W.

REFERENCE COPY

Floodplain impacts were not considered where the 100-year inundation shape within the corridor was less than 0.5 acres. Impacts were also not considered where a floodplain was plotted within the corridor which did not represent a FEMA floodplain. The floodplain impact assessment assumes all major hydraulic crossings will utilize culverts or box culverts rather than bridges.

All corridors except 2A-1 impact the Reedy Creek Mitigation Bank and floodplain, a large wetland slough that collects stormwater runoff from the southwestern region of the greater Orlando area. Reedy Creek flows south towards Lakes Marion and Hatchineha. The roadway corridors cross Reedy Creek where the established FEMA BFE is elevation 66 and the floodplain is approximately 10,000 feet wide. The floodplain is very flat in this area and remains at BFE 66 until nearly 5 miles south of Poinciana Parkway.

Pond Sizing

As mentioned, it is assumed that all proposed ponds within the I-4/Poinciana Parkway Connector Expressway will be wet detention facilities. From review of nearby CFX Contracts 450, 451, 417-304, 417-543, and 417-454, it was determined that the wet detention available storage for the treatment volume, attenuation volume, and floodplain impact volume is a 3-foot design depth above the normal water level (NWL). The assumed pond geometry is a square shape, 1:4 side slopes, 1-foot of freeboard, and 20% additional area for the maintenance berm and landscaping (See **Plate 1**), which resulted in the following equations to calculate the pond sizes:

$$Pond\ Length\ at\ Design\ Depth = \sqrt{\frac{Total\ Pond\ Volume\ Required * 43560\frac{ft^2}{ac}}{Design\ Depth}} + \left(\frac{Design\ Depth}{2} * (2 * 4)\right)$$

$$Required\ Pond\ Area = 1.2 * \frac{\left(Pond\ Length\ at\ Design\ Depth + \left(Freeboard\ Height * (2 * 4)\right)\right)^2}{43560\frac{ft^2}{ac}}$$

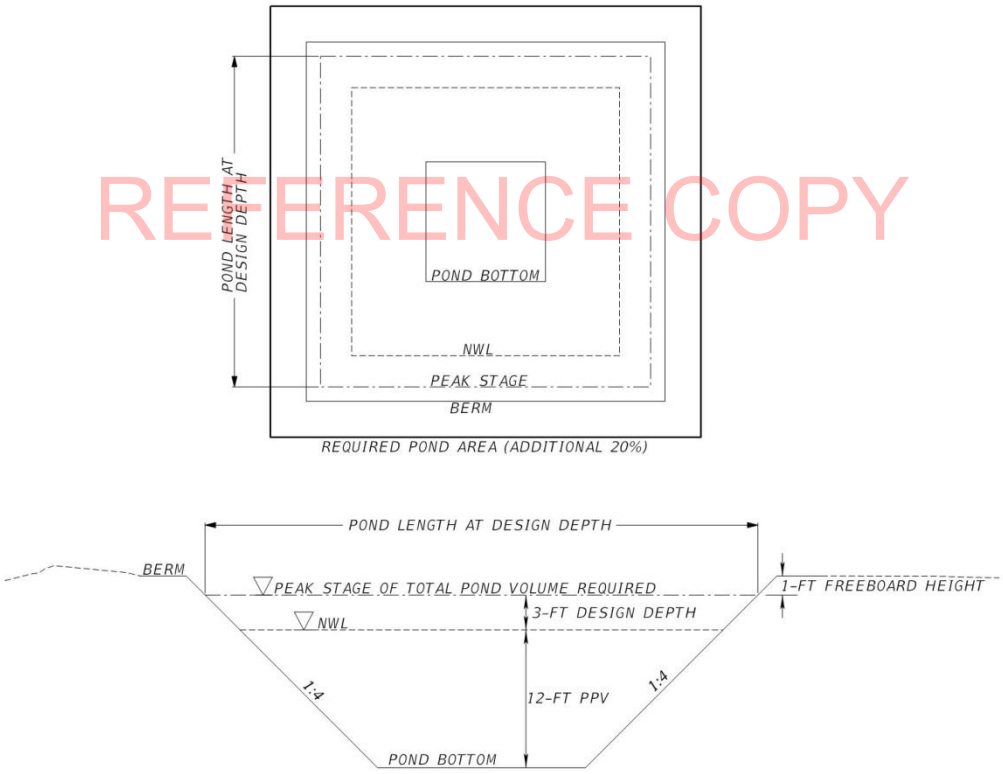

REFERENCE COPY

PLATE 1 - POND SIZING TYPICAL SECTION (NOT TO SCALE)

The interchange options were considered outside of the mainline pond sizing, by creating interchange basins. It was assumed that resulting infield areas would be used as stormwater facilities for the interchange. The available infield pond area includes the infield area 50 feet away from the proposed impervious area from the ramps, side streets, and mainline. Length

Pond Quantities

For comparison purposes, sodding and excavation quantities were estimated for the wet detention facilities. The presumed pond geometry includes a pond depth of 12-feet below the NWL for the permanent pool volume (PPV), continuing at 1:4 side slopes. It is assumed the total volume to be excavated will include the required pond volume and the PPV of the pond and the ponds are to be sodded above the NWL, which are determined with the following calculations:

$$Pond\ Area\ at\ NWL = \frac{\left(Pond\ Length\ at\ Design\ Depth - \left(Design\ Depth * (2 * 4)\right)\right)^2}{43560\frac{ft^2}{ac}}$$

$$Pond\ Bottom\ Area = \frac{\left(Pond\ Length\ at\ Design\ Depth - \left((Design\ Depth + 12) * (2 * 4)\right)\right)^2}{43560\frac{ft^2}{ac}}$$

$$PPV = \frac{Pond\ Area\ at\ NWL + Pond\ Bottom\ Area}{2} * 12$$

$$Total\ Excavation\ Volume = \frac{(Total\ Pond\ Volume\ Required + PPV) * 43560\frac{ft^2}{ac}}{27\frac{ft^3}{yd^3}}$$

$$Total\ Sodding\ Area = \frac{(Required\ Pond\ Area - Pond\ Area\ at\ NWL) * 43560\frac{ft^2}{ac}}{9\frac{ft^2}{yd^2}}$$

REFERENCE COPY

Fill associated with freeboard and berm area was not included.

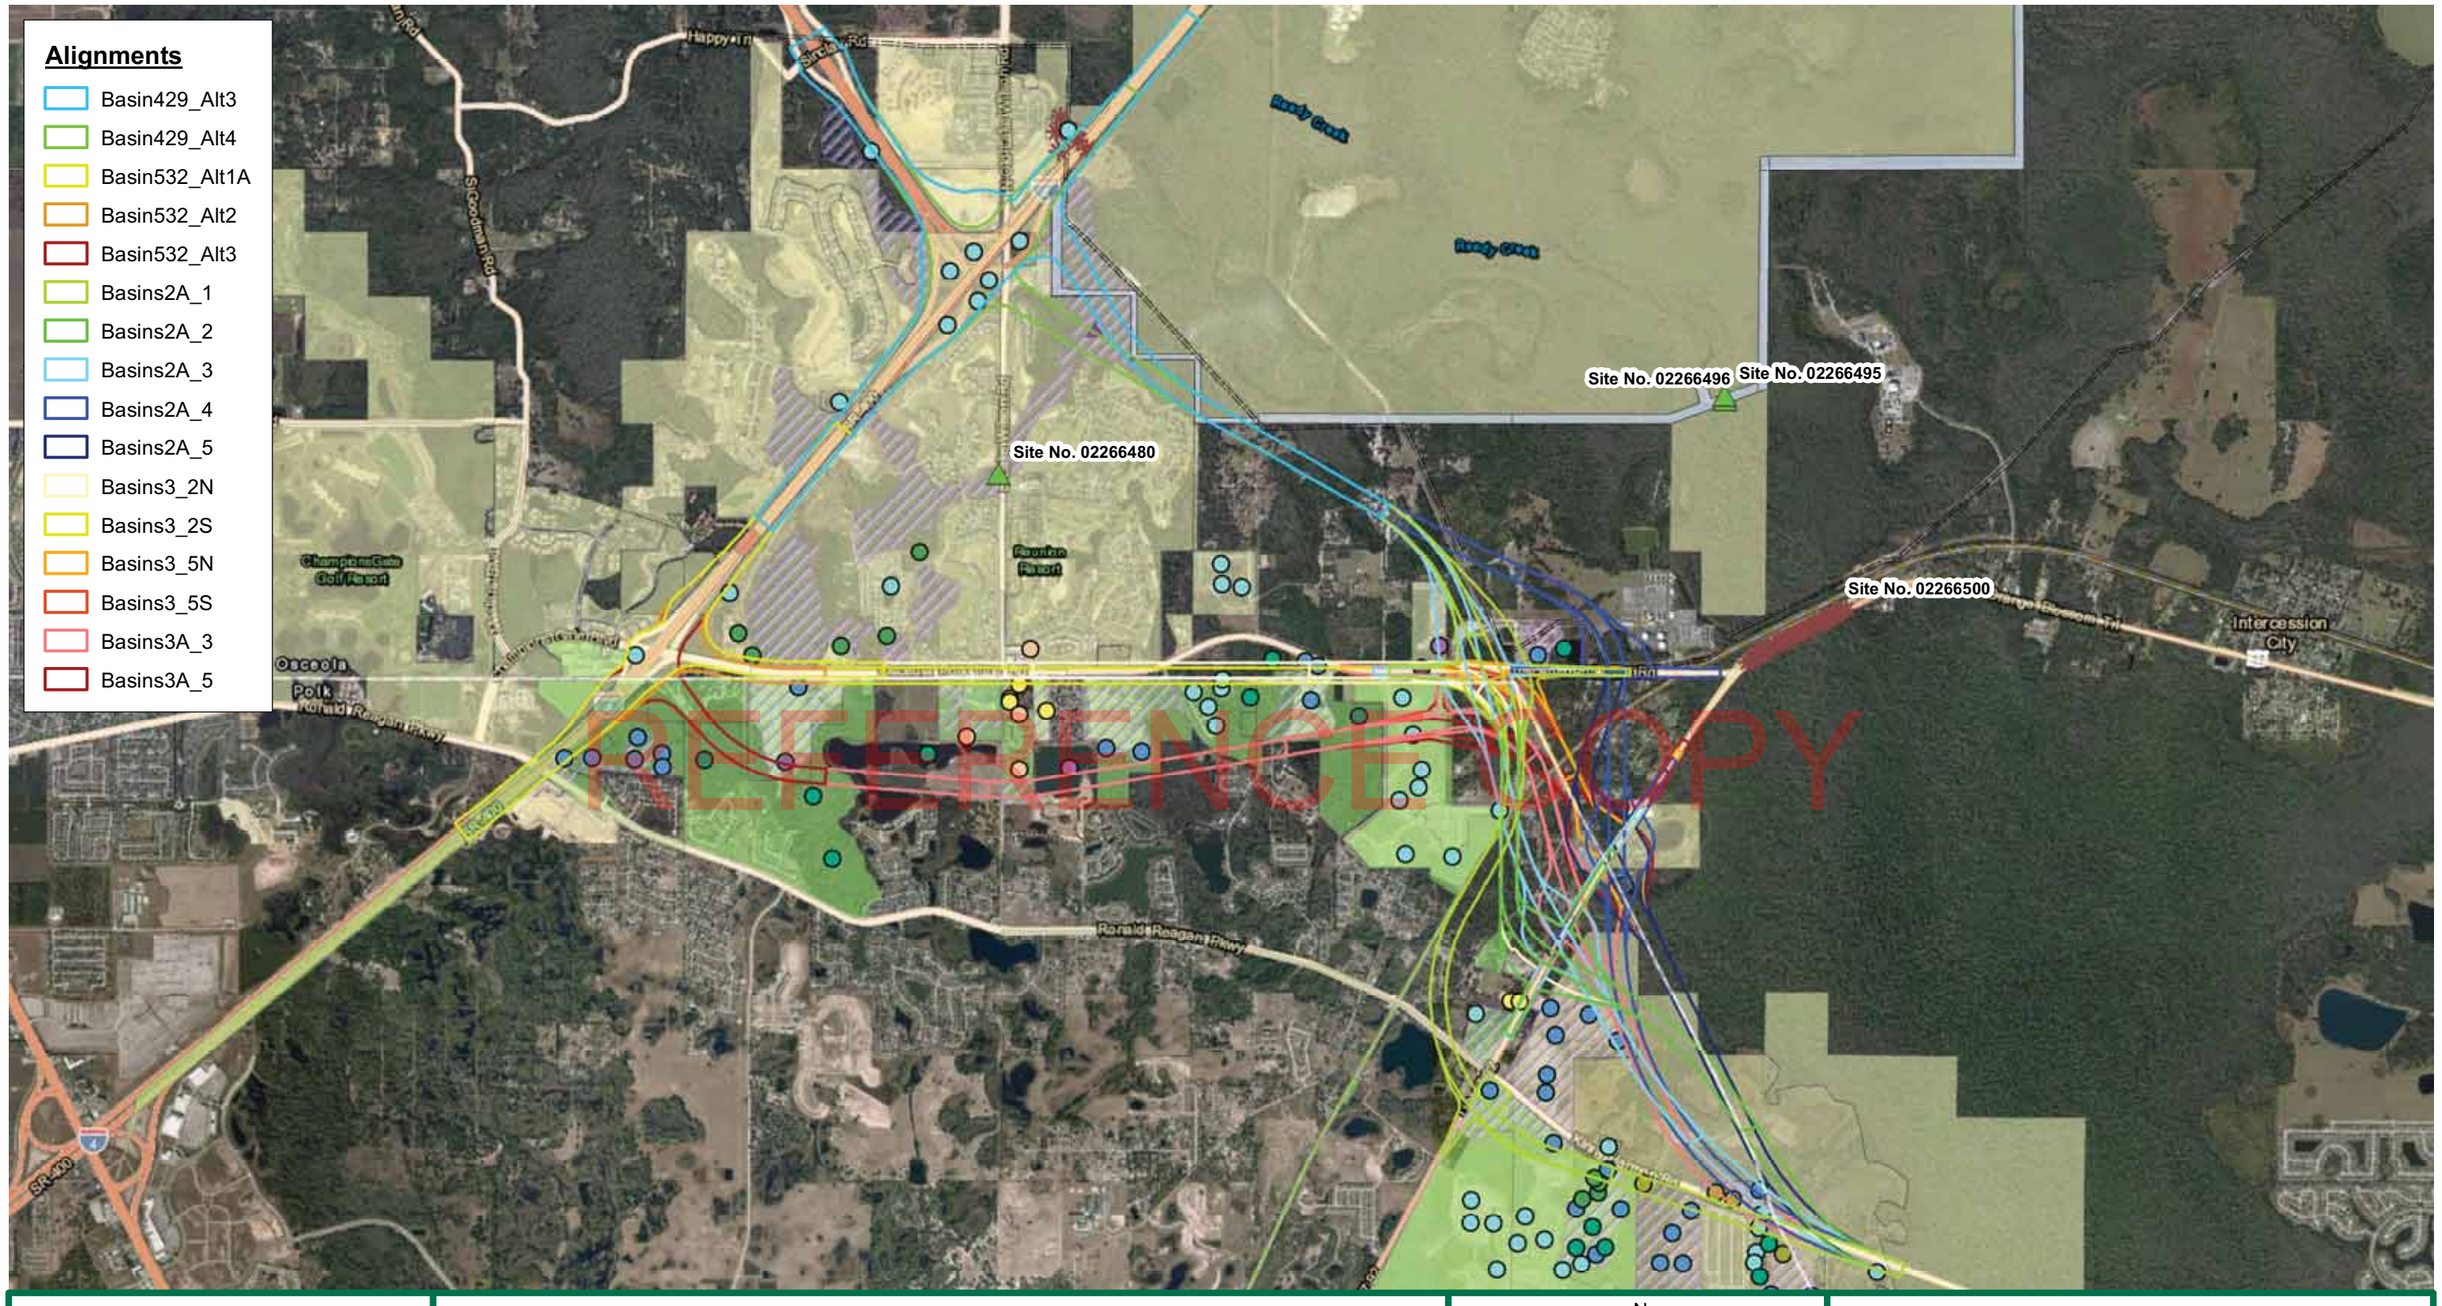

REFERENCE COPY

The Balmoral Group
165 Lincoln Avenue
Winter Park, Florida 32789

Legend

- Borrow Pit
- Dry Detention Pond
- Dry Detention Swale
- Dry Retention Pond
- Wet Detention Pond
- Wetland
- Future Dry Detention Pond
- Future Dry Retention Pond
- Future Wet Detention Pond
- FDOT Soil Borings Database
- USGS Gage Sites
- Sabal Trail Transmission Line
- Reedy Creek Improvement District
- Planned Development TW Info
- Planned Development
- SWFWMD Permits Reviewed
- SFWMD Permits Reviewed

N
W E
S

0 0.5 1
Miles

Figure A-1
Data Collection - Permit Coverage

Concept, Feasibility, & Mobility Study
Poinciana Pkwy Extension/I-4 Connector Expressway
Osceola & Polk County, FL

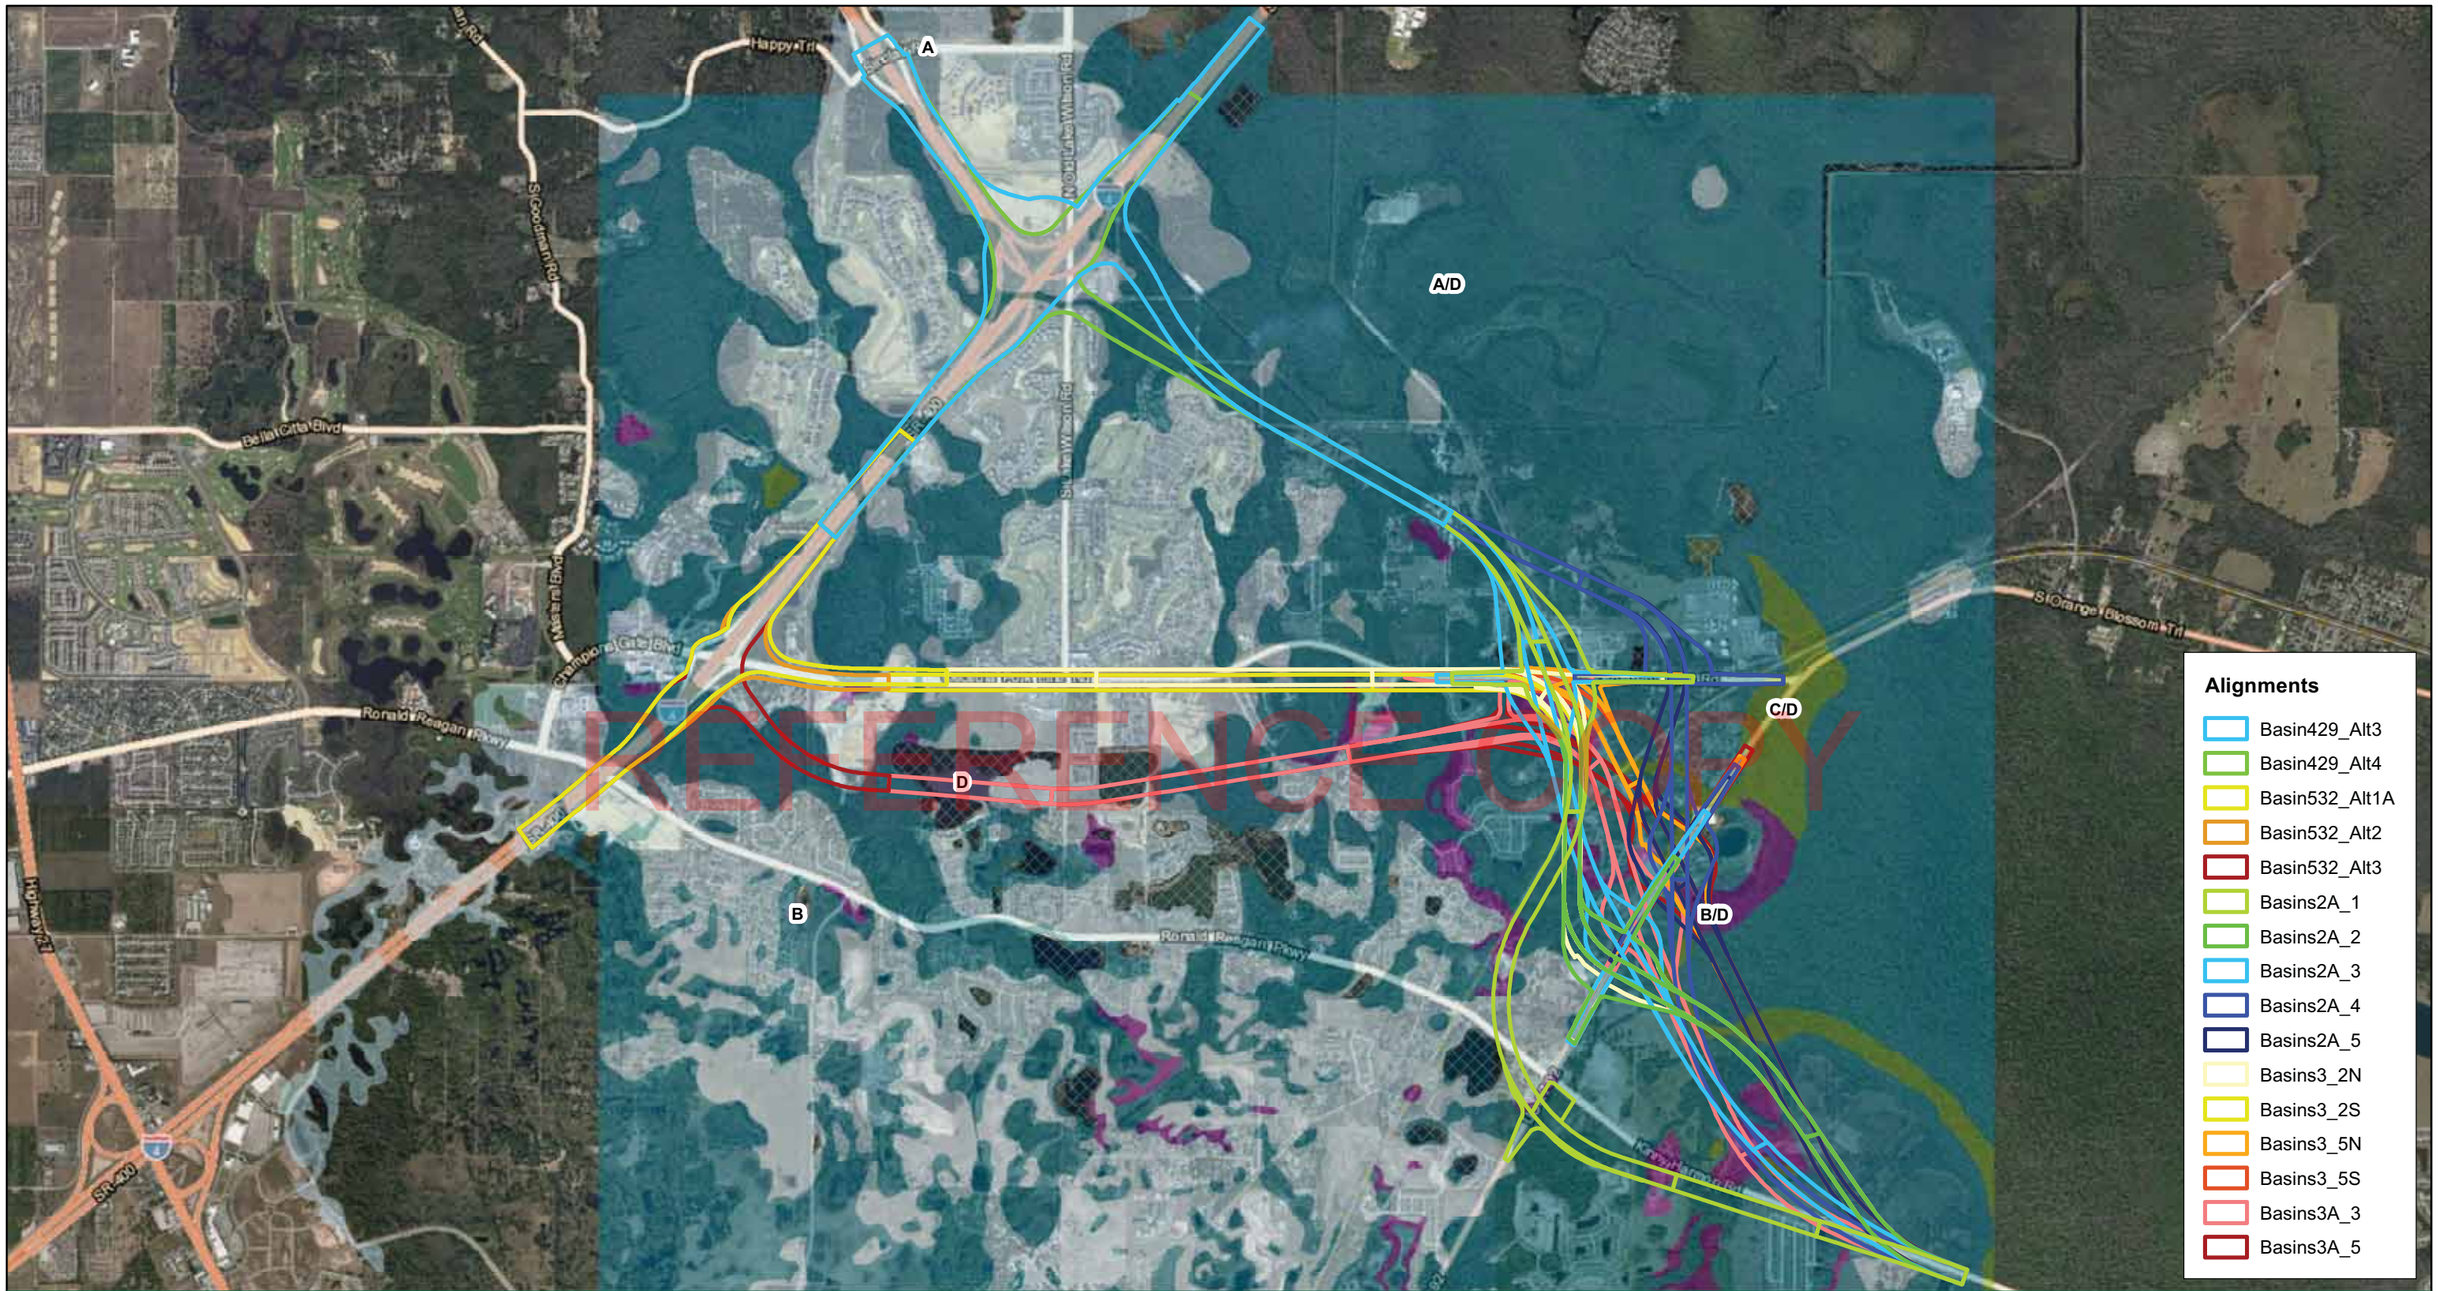

REFERENCE COPY

The Balmoral Group
165 Lincoln Avenue
Winter Park, Florida 32789

Legend

Hydrologic Soil Group

- Water
- A
- A/D
- B
- B/D
- C/D
- D

N
W E
S

0 0.5 1
Miles

Figure A-2 : Data Collection
NRCS Soils Coverage

Concept, Feasibility, & Mobility Study
Poinciana Pkwy Extension/I-4
Connector Expressway
Osceola & Polk County, FL

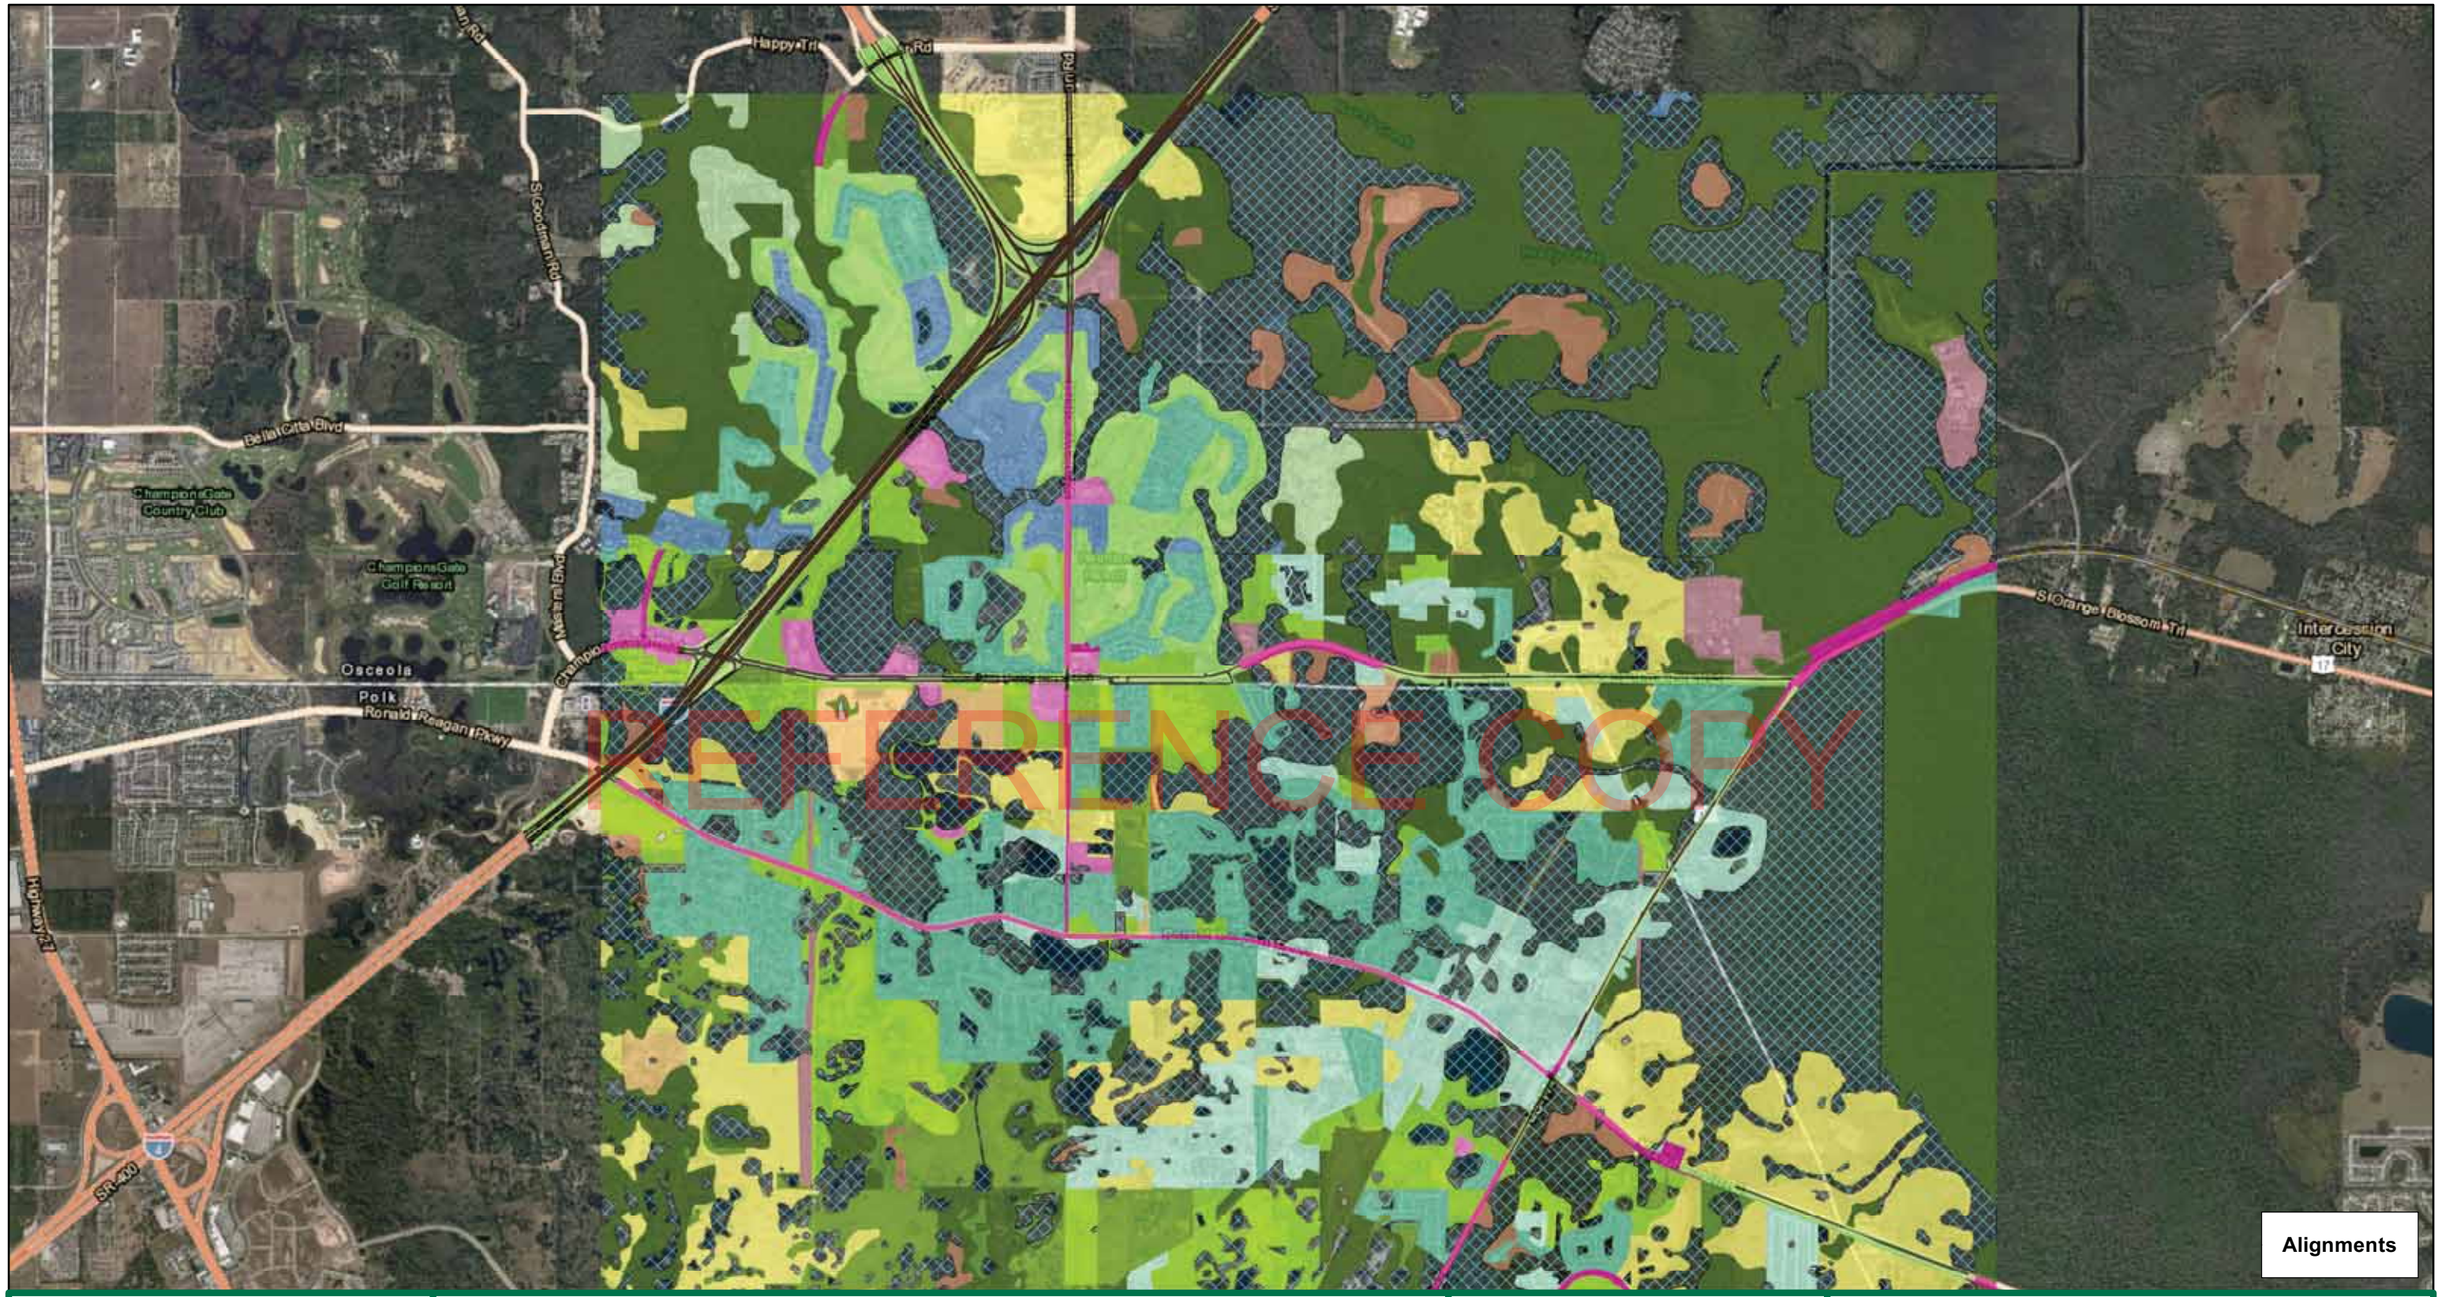

REFERENCE COPY

The Balmoral Group
165 Lincoln Avenue
Winter Park, Florida 32789

Legend

- Brush - Good
- Commercial and business
- Impervious
- Industrial
- Open - Fair
- Open - Good
- Open - Poor
- Pasture - Good
- Residential - 2 acres
- Residential - 1 acre
- Residential - 1/2 acre
- Residential - 1/4 acre
- Residential - 1/8 acre
- Row Crops - Straight Row
- Streets and Roads - Paved; Including R/W
- Water
- Woods - Good

N
W E
S

0 0.5 1
Miles

Figure A-3
Existing Land Cover/Land Use

Concept, Feasibility, & Mobility Study
Poinciana Pkwy Extension/I-4 Connector Expressway
Osceola & Polk County, FL

REFERENCE COPY

The Balmoral Group
165 Lincoln Avenue
Winter Park, Florida 32789

Legend

- Impervious
- Open - Good

N
W E
S

0 0.25 0.5
Miles

Figure A-4 : CR 532 Alt 1A Proposed Land Cover/Land Use

Concept, Feasibility, & Mobility Study
Poinciana Pkwy Extension/I-4
Connector Expressway
Osceola & Polk County, FL

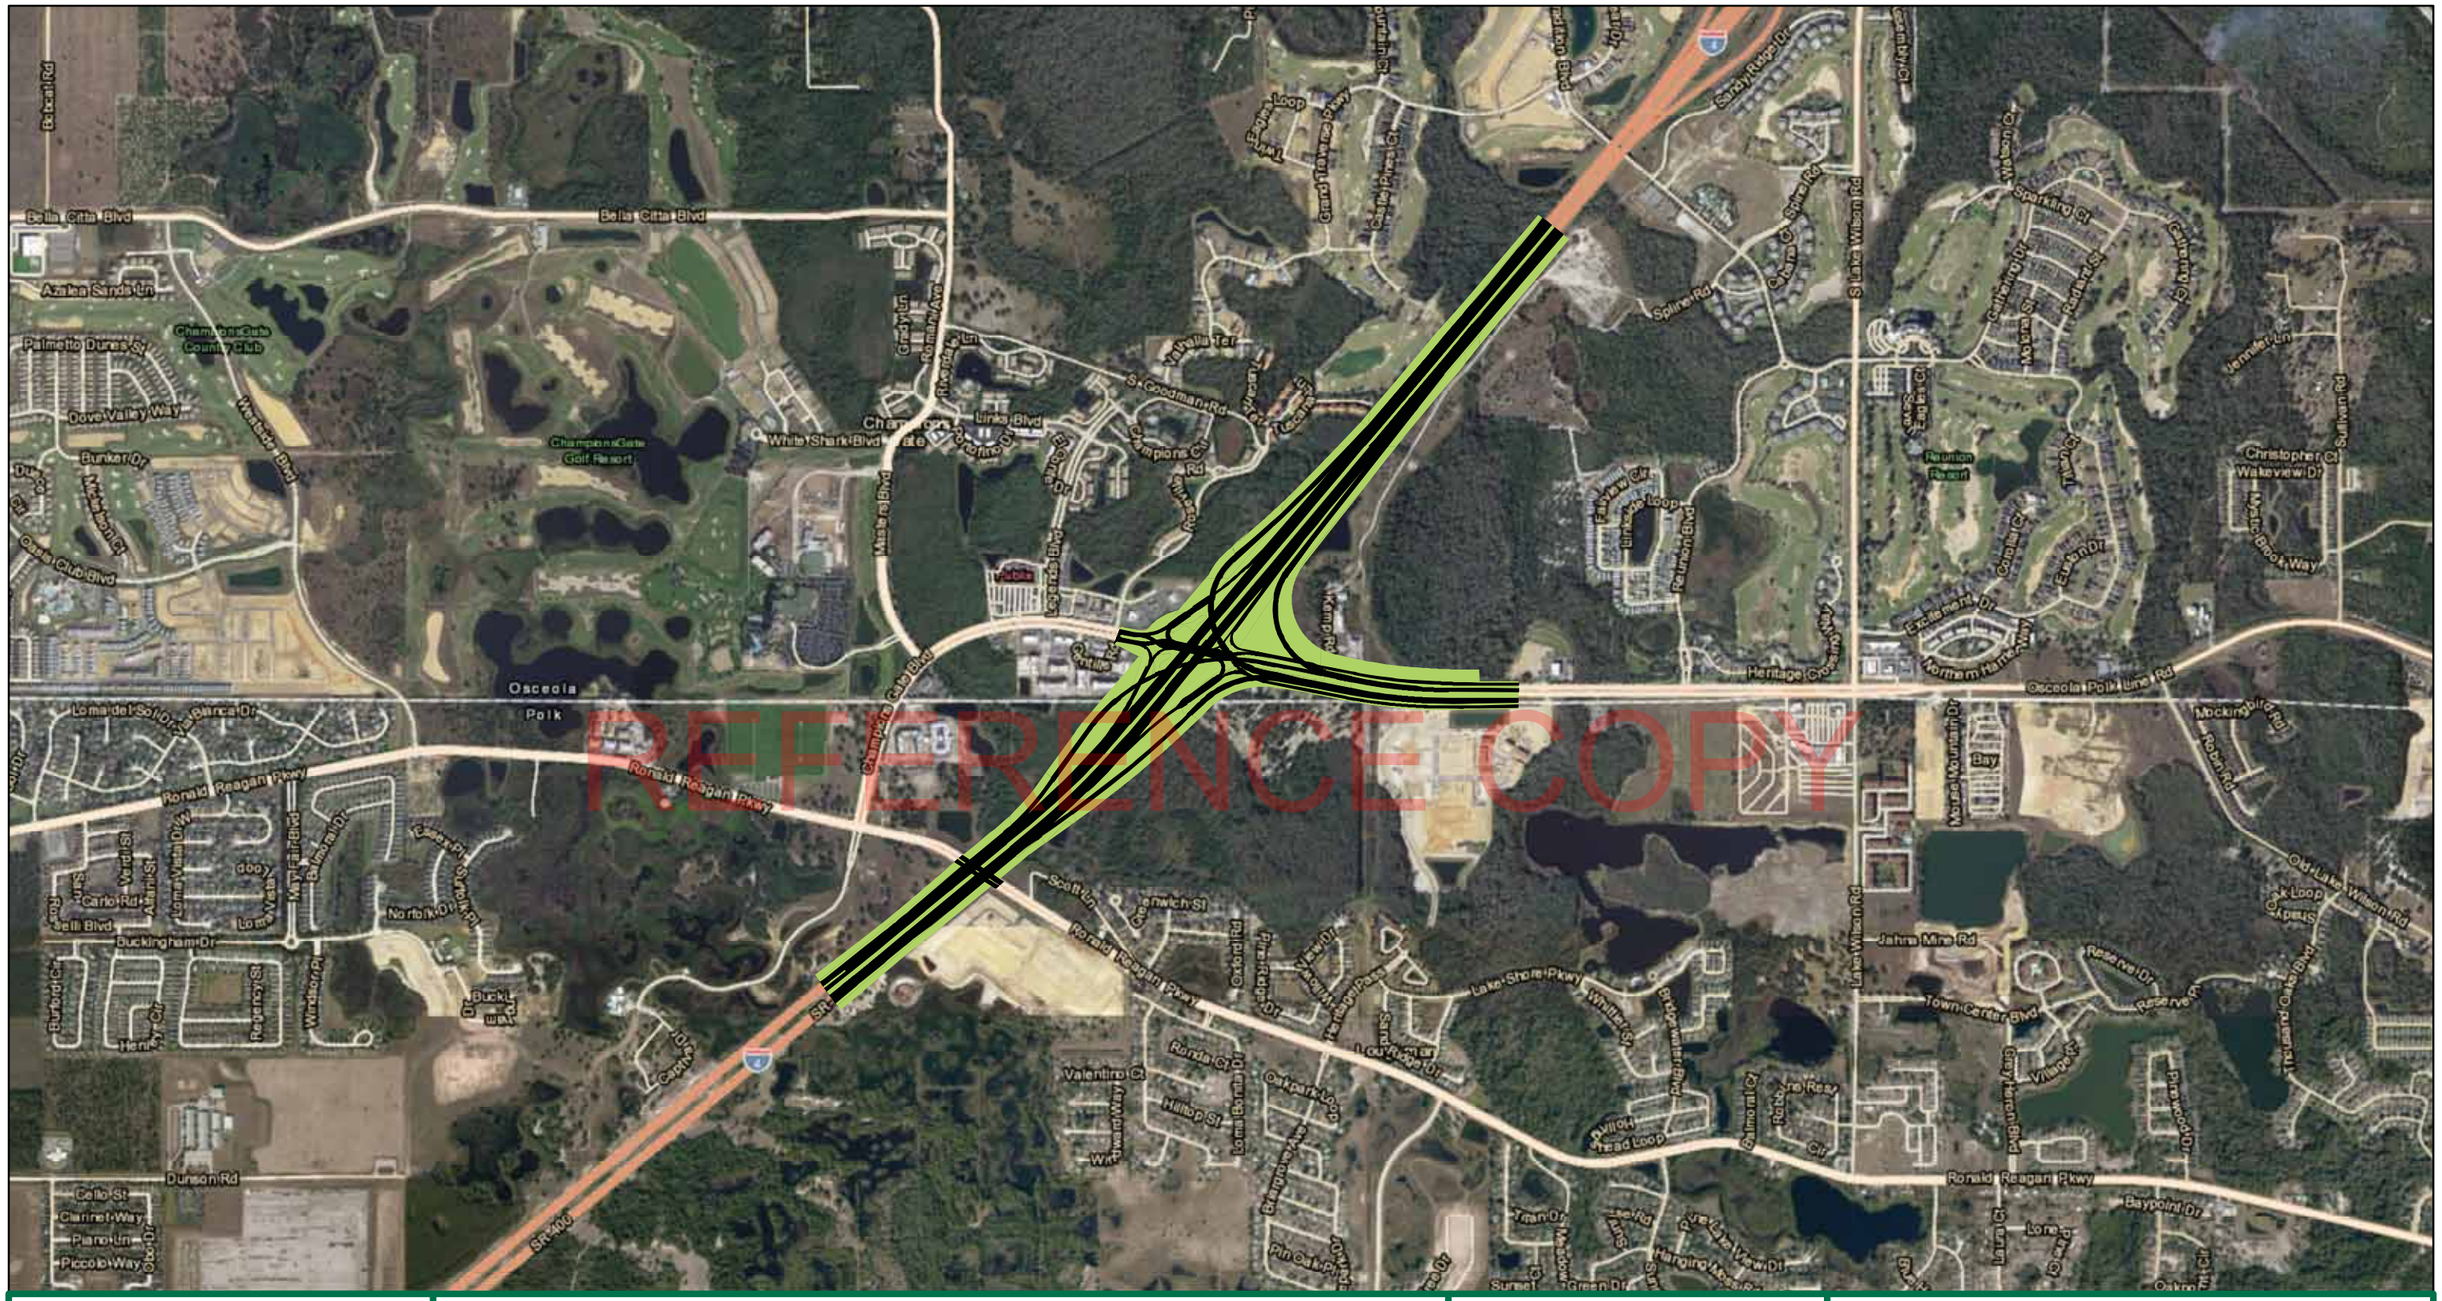

REFERENCE COPY

The Balmoral Group
165 Lincoln Avenue
Winter Park, Florida 32789

Legend

- Impervious
- Open - Good

N
W E
S

0 0.25 0.5
Miles

Figure A-4 : CR 532 Alt 2
Proposed Land Cover/Land Use

Concept, Feasibility, & Mobility Study
Poinciana Pkwy Extension/I-4
Connector Expressway
Osceola & Polk County, FL

REFERENCE COPY

The Balmoral Group
165 Lincoln Avenue
Winter Park, Florida 32789

Legend

- Impervious
- Open - Good

N
W E
S

0 0.25 0.5
Miles

Figure A-4 : CR 532 Alt 3
Proposed Land Cover/Land Use

Concept, Feasibility, & Mobility Study
Poinciana Pkwy Extension/I-4
Connector Expressway
Osceola & Polk County, FL

REFERENCE COPY

The Balmoral Group
165 Lincoln Avenue
Winter Park, Florida 32789

Legend

- Impervious
- Open - Good
- Pasture - Good
- Residential - 1/8 acre
- Water
- Woods - Good

N
W E
S

0 0.25 0.5
Miles

Figure A-4 : SR 429 Alt 3
Proposed Land Cover/Land Use

Concept, Feasibility, & Mobility Study
Poinciana Pkwy Extension/I-4
Connector Expressway
Osceola & Polk County, FL

REFERENCE COPY

The Balmoral Group
165 Lincoln Avenue
Winter Park, Florida 32789

Legend

- Brush - Good
- Impervious
- Open - Good
- Residential - 1/8 acre
- Water
- Woods - Good

N
W E
S

0 0.25 0.5
Miles

Figure A-4 : SR 429 Alt 4
Proposed Land Cover/Land Use

Concept, Feasibility, & Mobility Study
Poinciana Pkwy Extension/I-4
Connector Expressway
Osceola & Polk County, FL

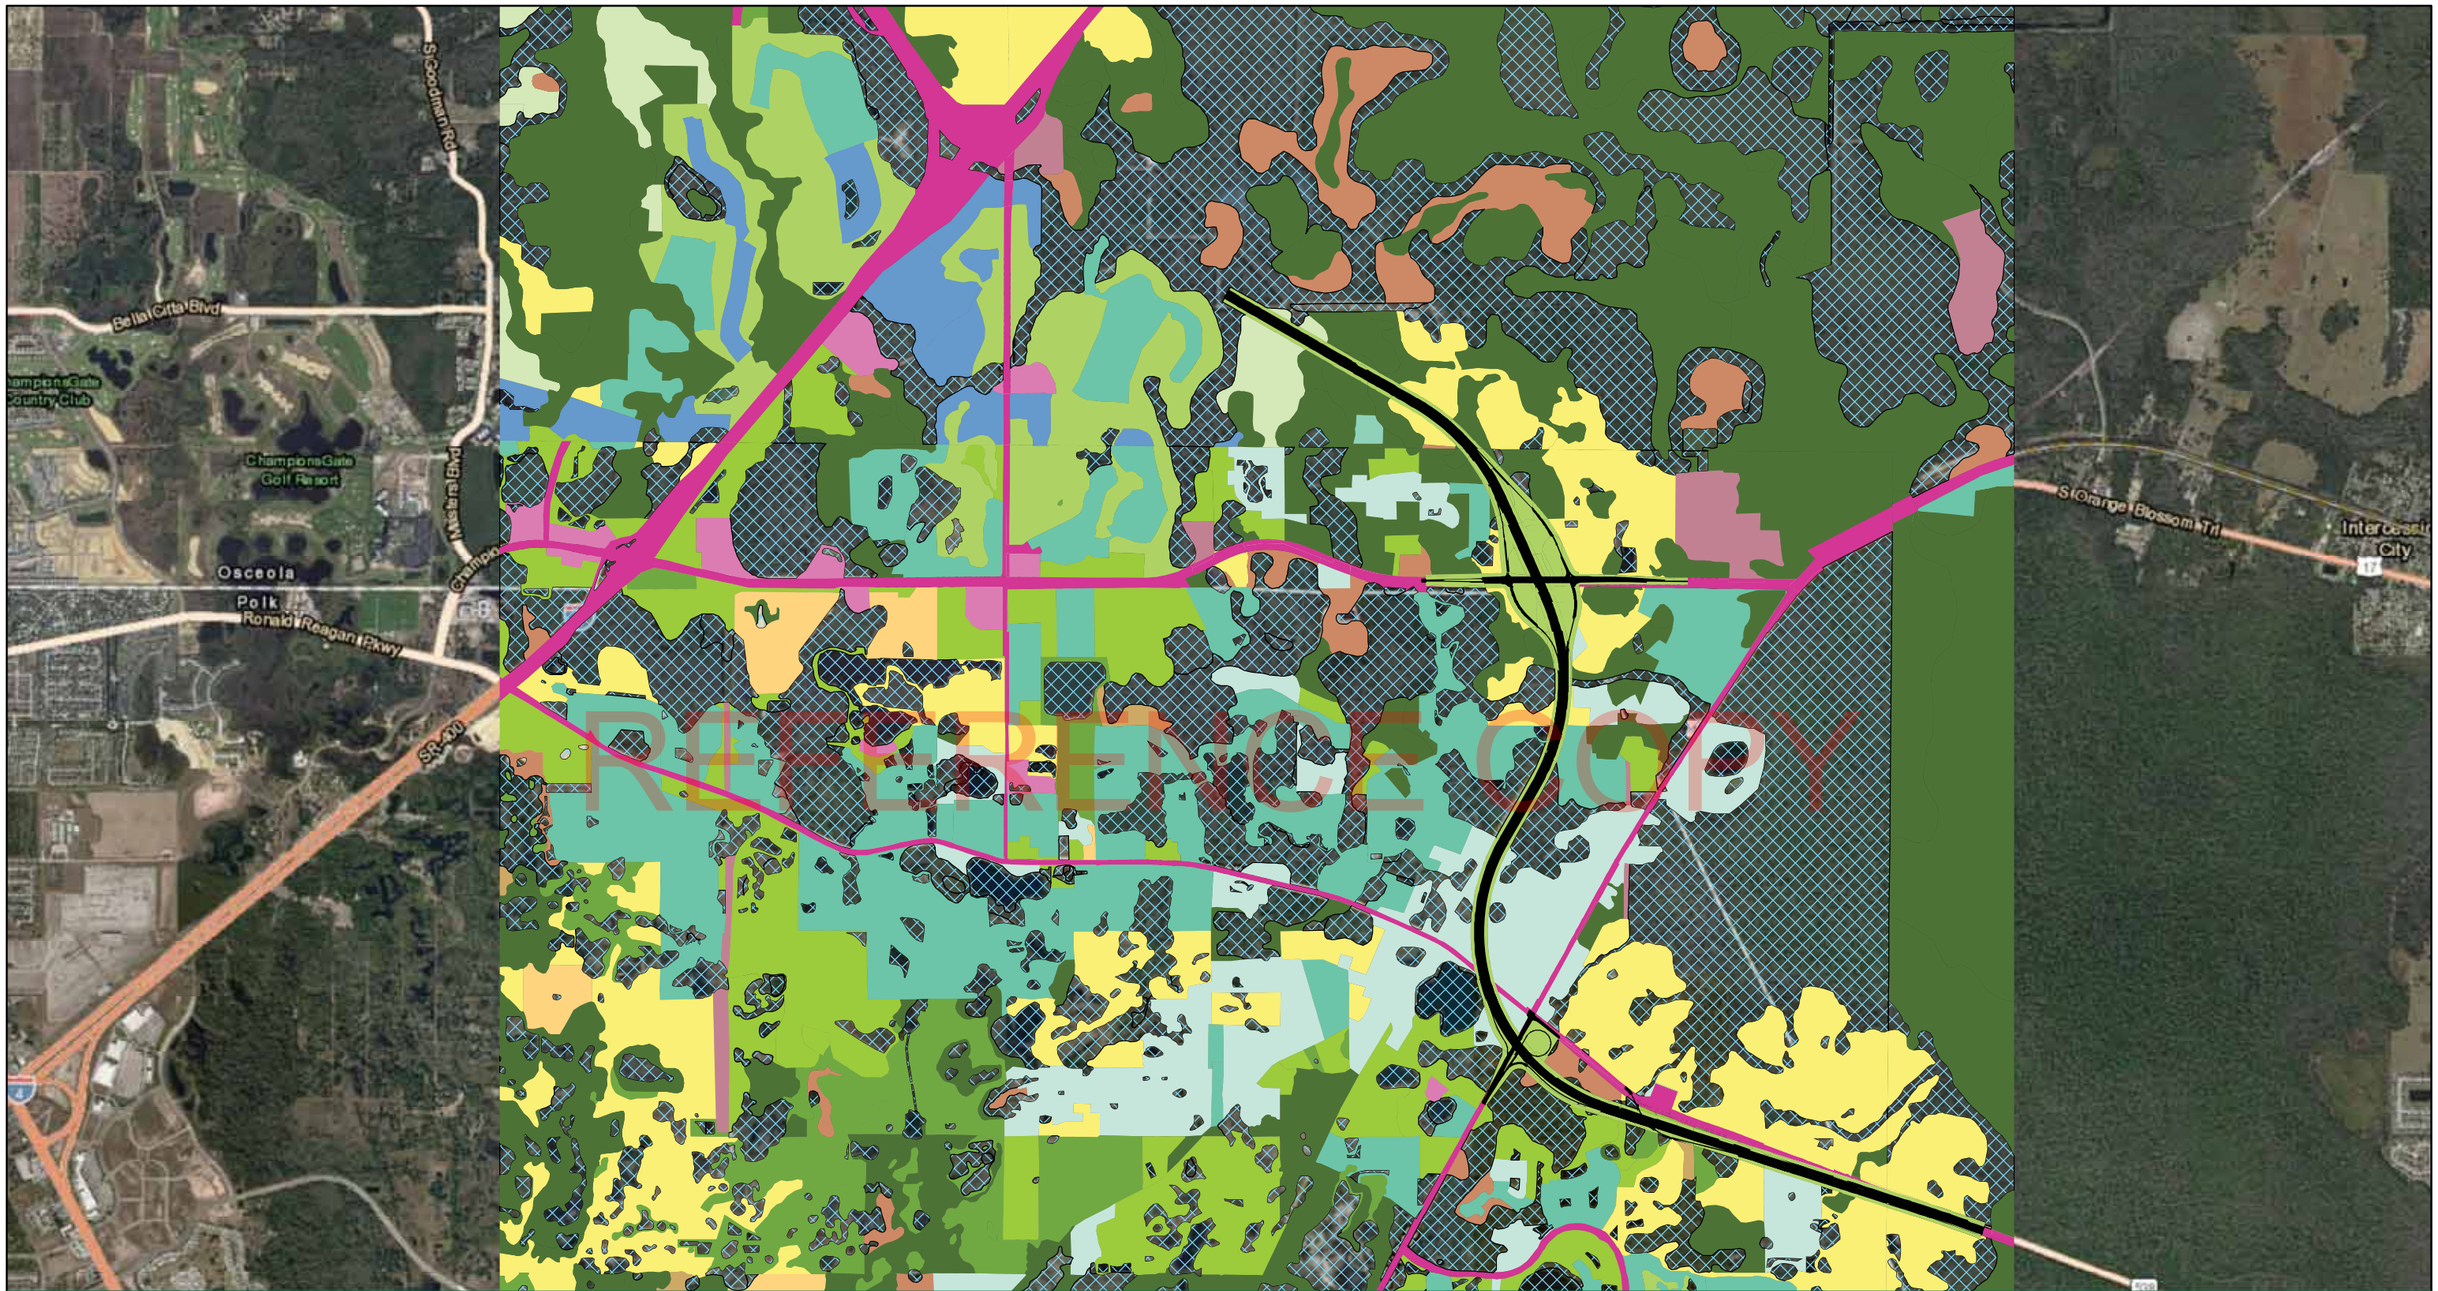

The Balmoral Group
165 Lincoln Avenue
Winter Park, Florida 32789

Legend

- Brush - Good
- Commercial and business
- Impervious
- Industrial
- Open - Fair
- Open - Good
- Open - Poor
- Pasture - Good
- Range - Good
- Residential - 2 acres
- Residential - 1 acre
- Residential - 1/2 acre
- Residential - 1/4 acre
- Residential - 1/8 acre
- Row Crops - Straight Row
- Streets and Roads - Paved; Including R/W
- Water
- Woods - Good

N
W E
S

0 0.5 1
Miles

Figure A-4 : Alignment 2A-1 Proposed Land Cover/Land Use

Concept, Feasibility, & Mobility Study
Poinciana Pkwy Extension/I-4 Connector Expressway
Osceola & Polk County, FL

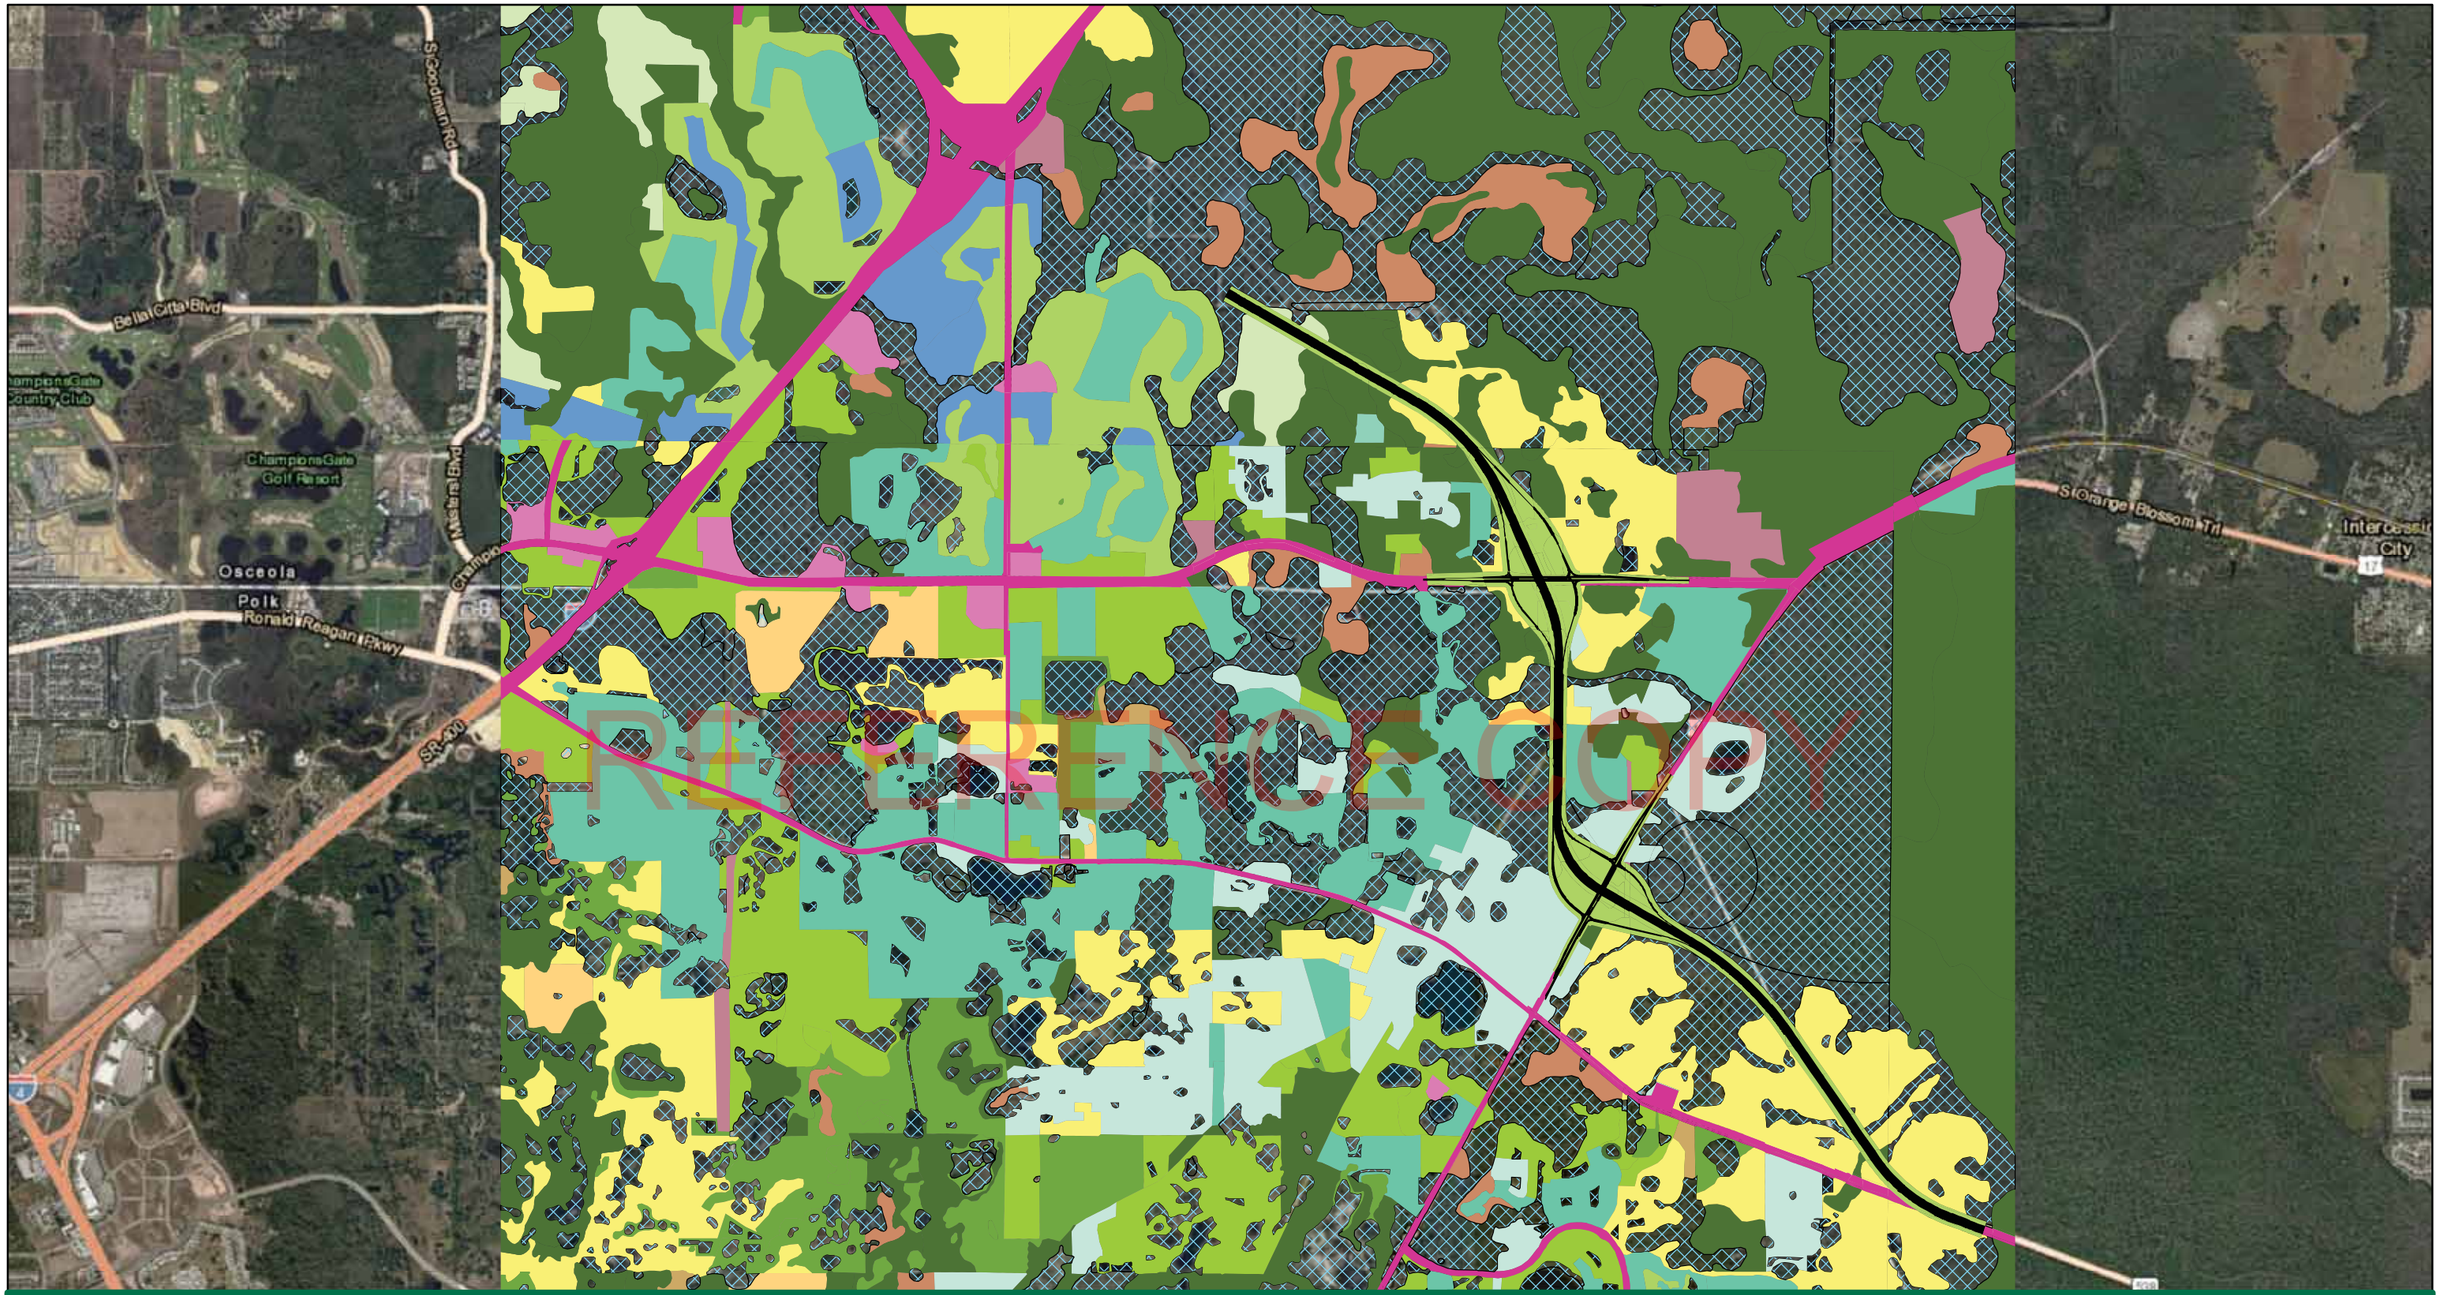

The Balmoral Group

165 Lincoln Avenue
Winter Park, Florida 32789

Legend

- Brush - Good
- Commercial and business
- Impervious
- Industrial
- Open - Fair
- Open - Good
- Open - Poor
- Pasture - Good
- Range - Good
- Residential - 2 acres
- Residential - 1 acre
- Residential - 1/2 acre
- Residential - 1/4 acre
- Residential - 1/8 acre
- Row Crops - Straight Row
- Streets and Roads - Paved; Including R/W
- Water
- Woods - Good

N
W E
S

0 0.5 1
Miles

Figure A-4 : Alignment 2A-2
Proposed Land Cover/Land Use

Concept, Feasibility, & Mobility Study
Poinciana Pkwy Extension/I-4 Connector Expressway
Osceola & Polk County, FL

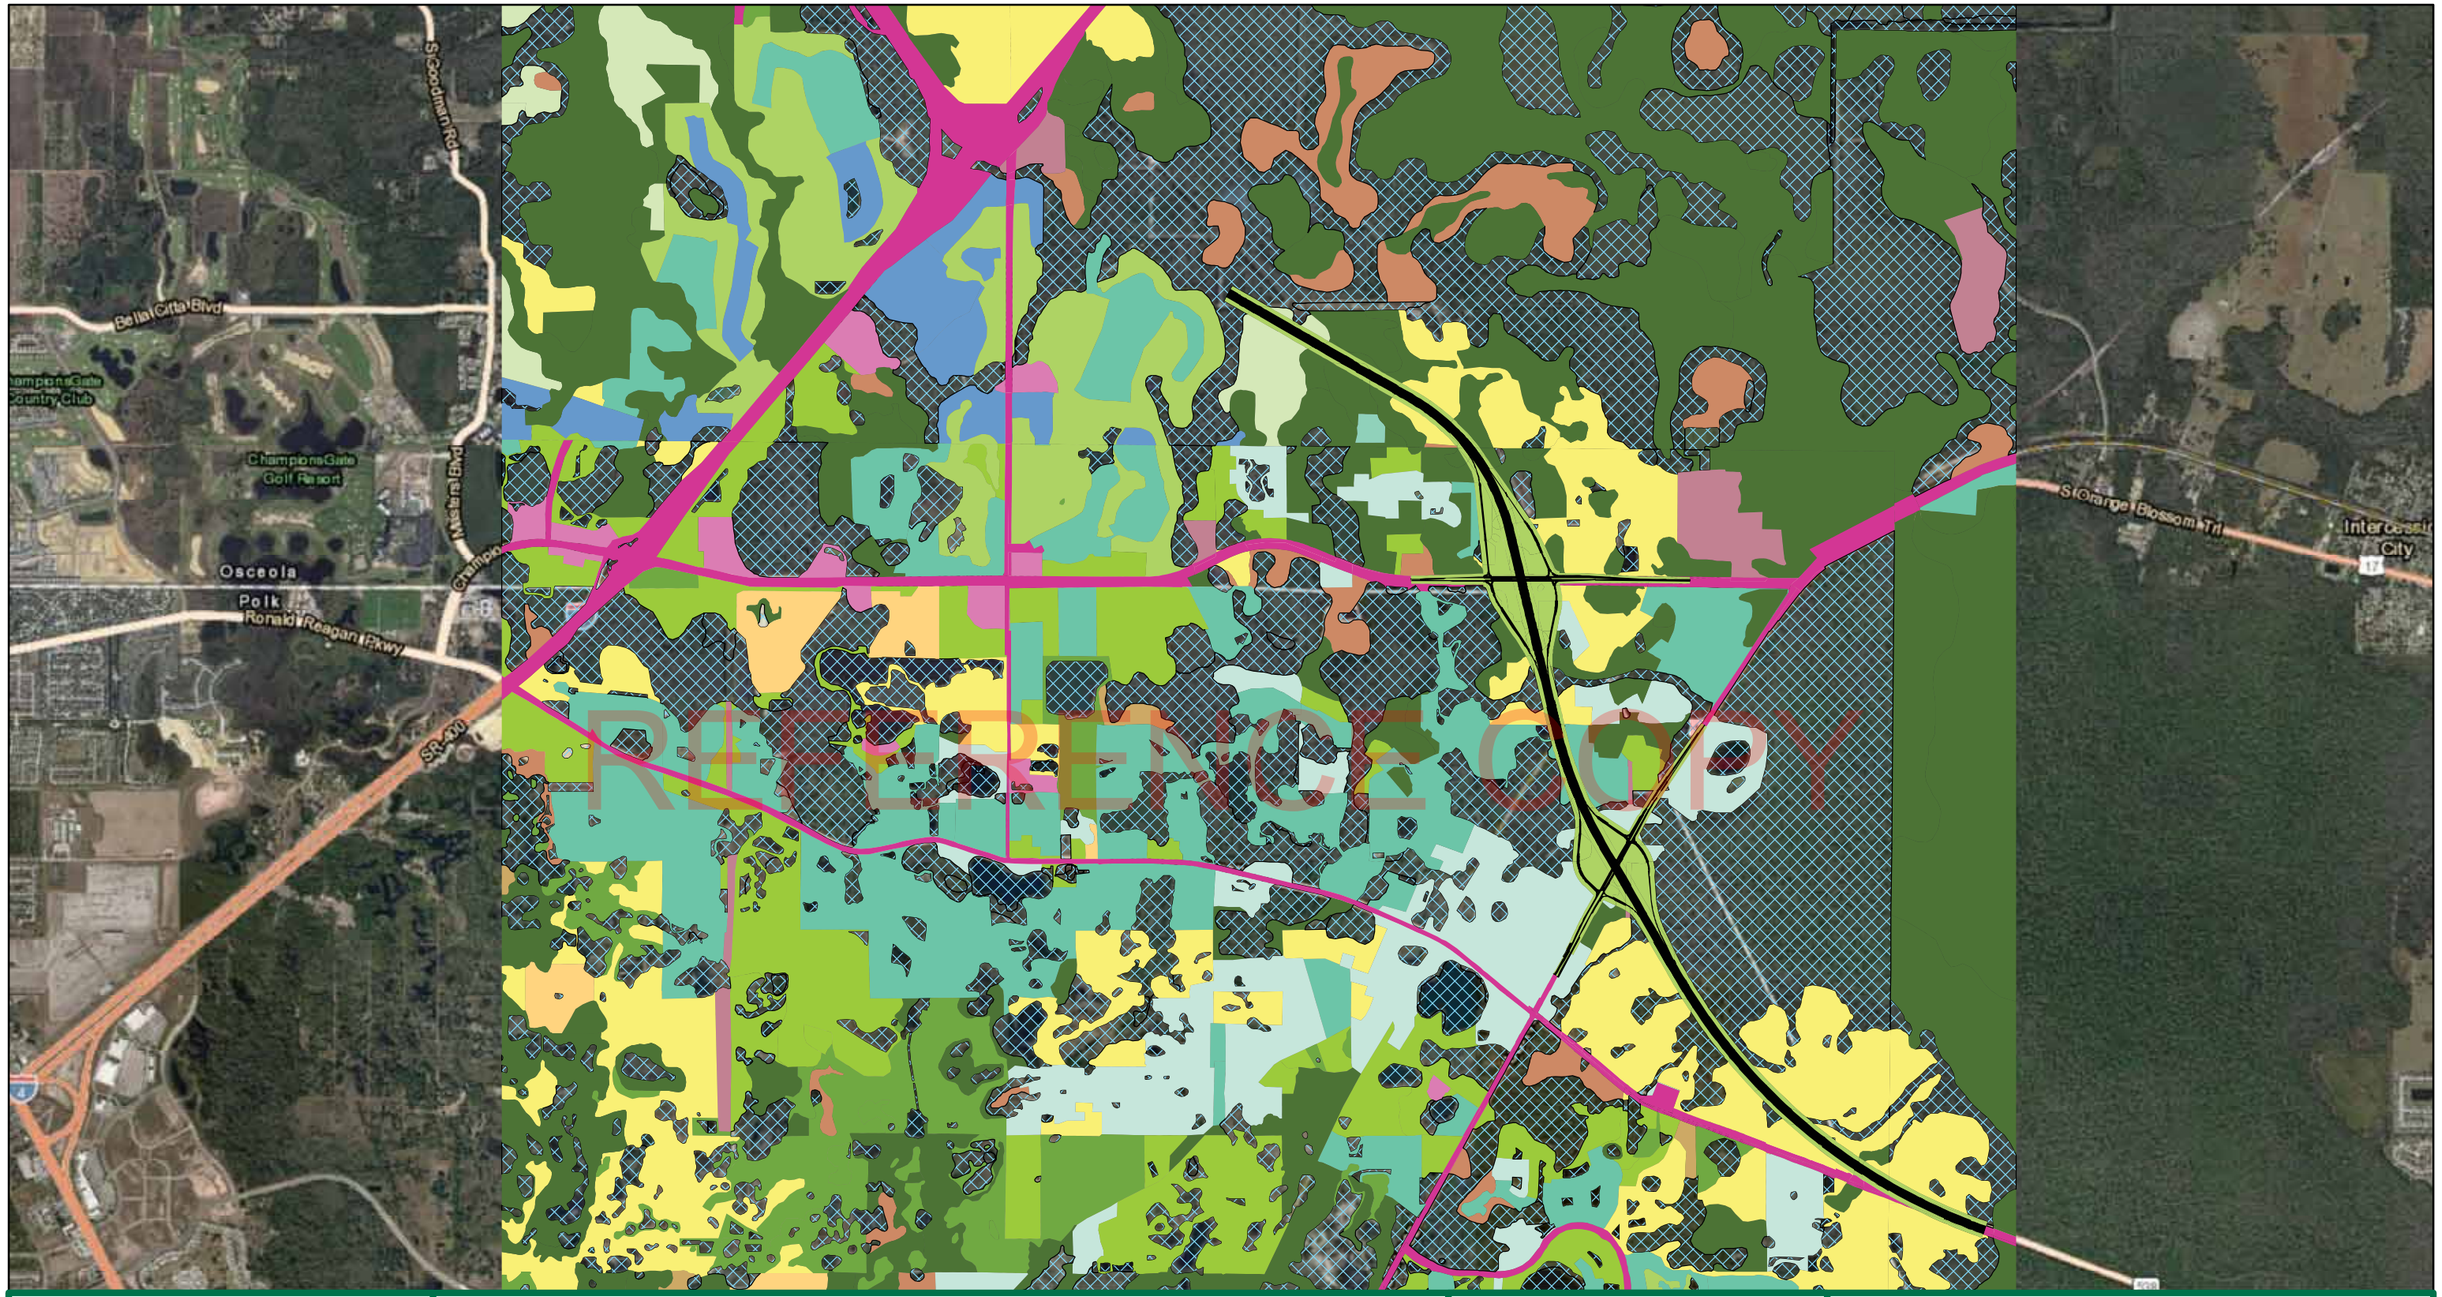

The Balmoral Group

165 Lincoln Avenue
Winter Park, Florida 32789

Legend

- Brush - Good
- Commercial and business
- Impervious
- Industrial
- Open - Fair
- Open - Good
- Open - Poor
- Pasture - Good
- Range - Good
- Residential - 2 acres
- Residential - 1 acre
- Residential - 1/2 acre
- Residential - 1/4 acre
- Residential - 1/8 acre
- Row Crops - Straight Row
- Streets and Roads - Paved; Including R/W
- Water
- Woods - Good

N
W E
S

0 0.5 1
Miles

Figure A-4 : Alignment 2A-3
Proposed Land Cover/Land Use

Concept, Feasibility, & Mobility Study
Poinciana Pkwy Extension/I-4 Connector Expressway
Osceola & Polk County, FL

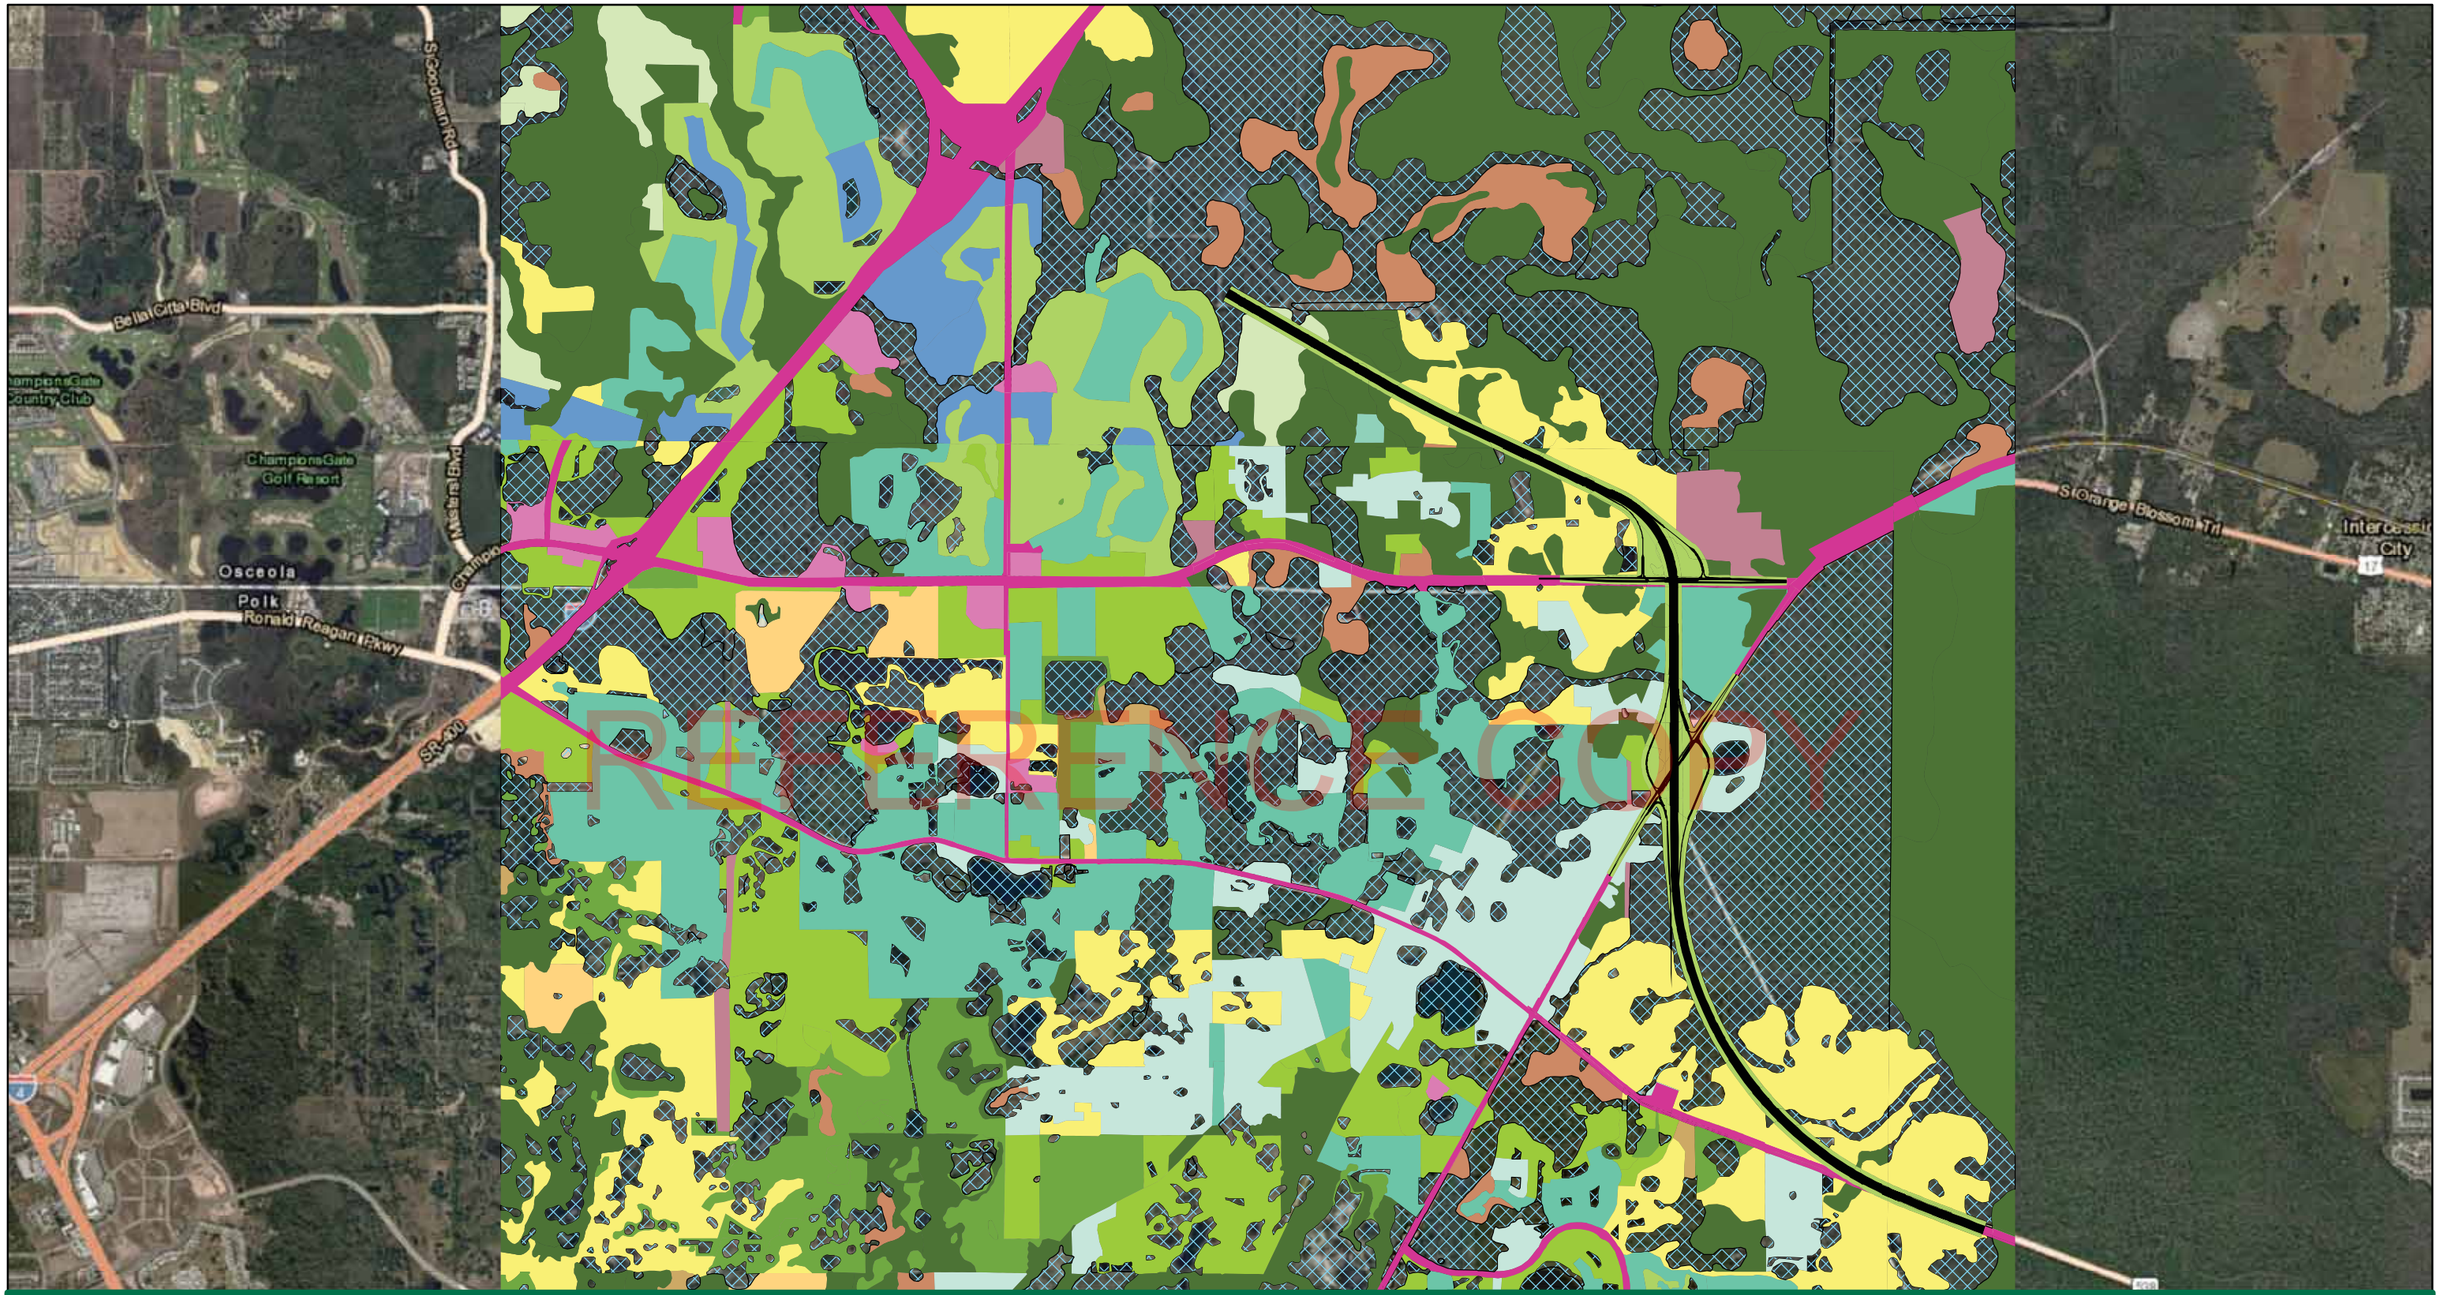

The Balmoral Group
165 Lincoln Avenue
Winter Park, Florida 32789

Legend

- Brush - Good
- Commercial and business
- Impervious
- Industrial
- Open - Fair
- Open - Good
- Open - Poor
- Pasture - Good
- Range - Good
- Residential - 2 acres
- Residential - 1 acre
- Residential - 1/2 acre
- Residential - 1/4 acre
- Residential - 1/8 acre
- Row Crops - Straight Row
- Streets and Roads - Paved; Including R/W
- Water
- Woods - Good

N
W E
S

0 0.5 1
Miles

Figure A-4 : Alignment 2A-4
Proposed Land Cover/Land Use

Concept, Feasibility, & Mobility Study
Poinciana Pkwy Extension/I-4 Connector Expressway
Osceola & Polk County, FL

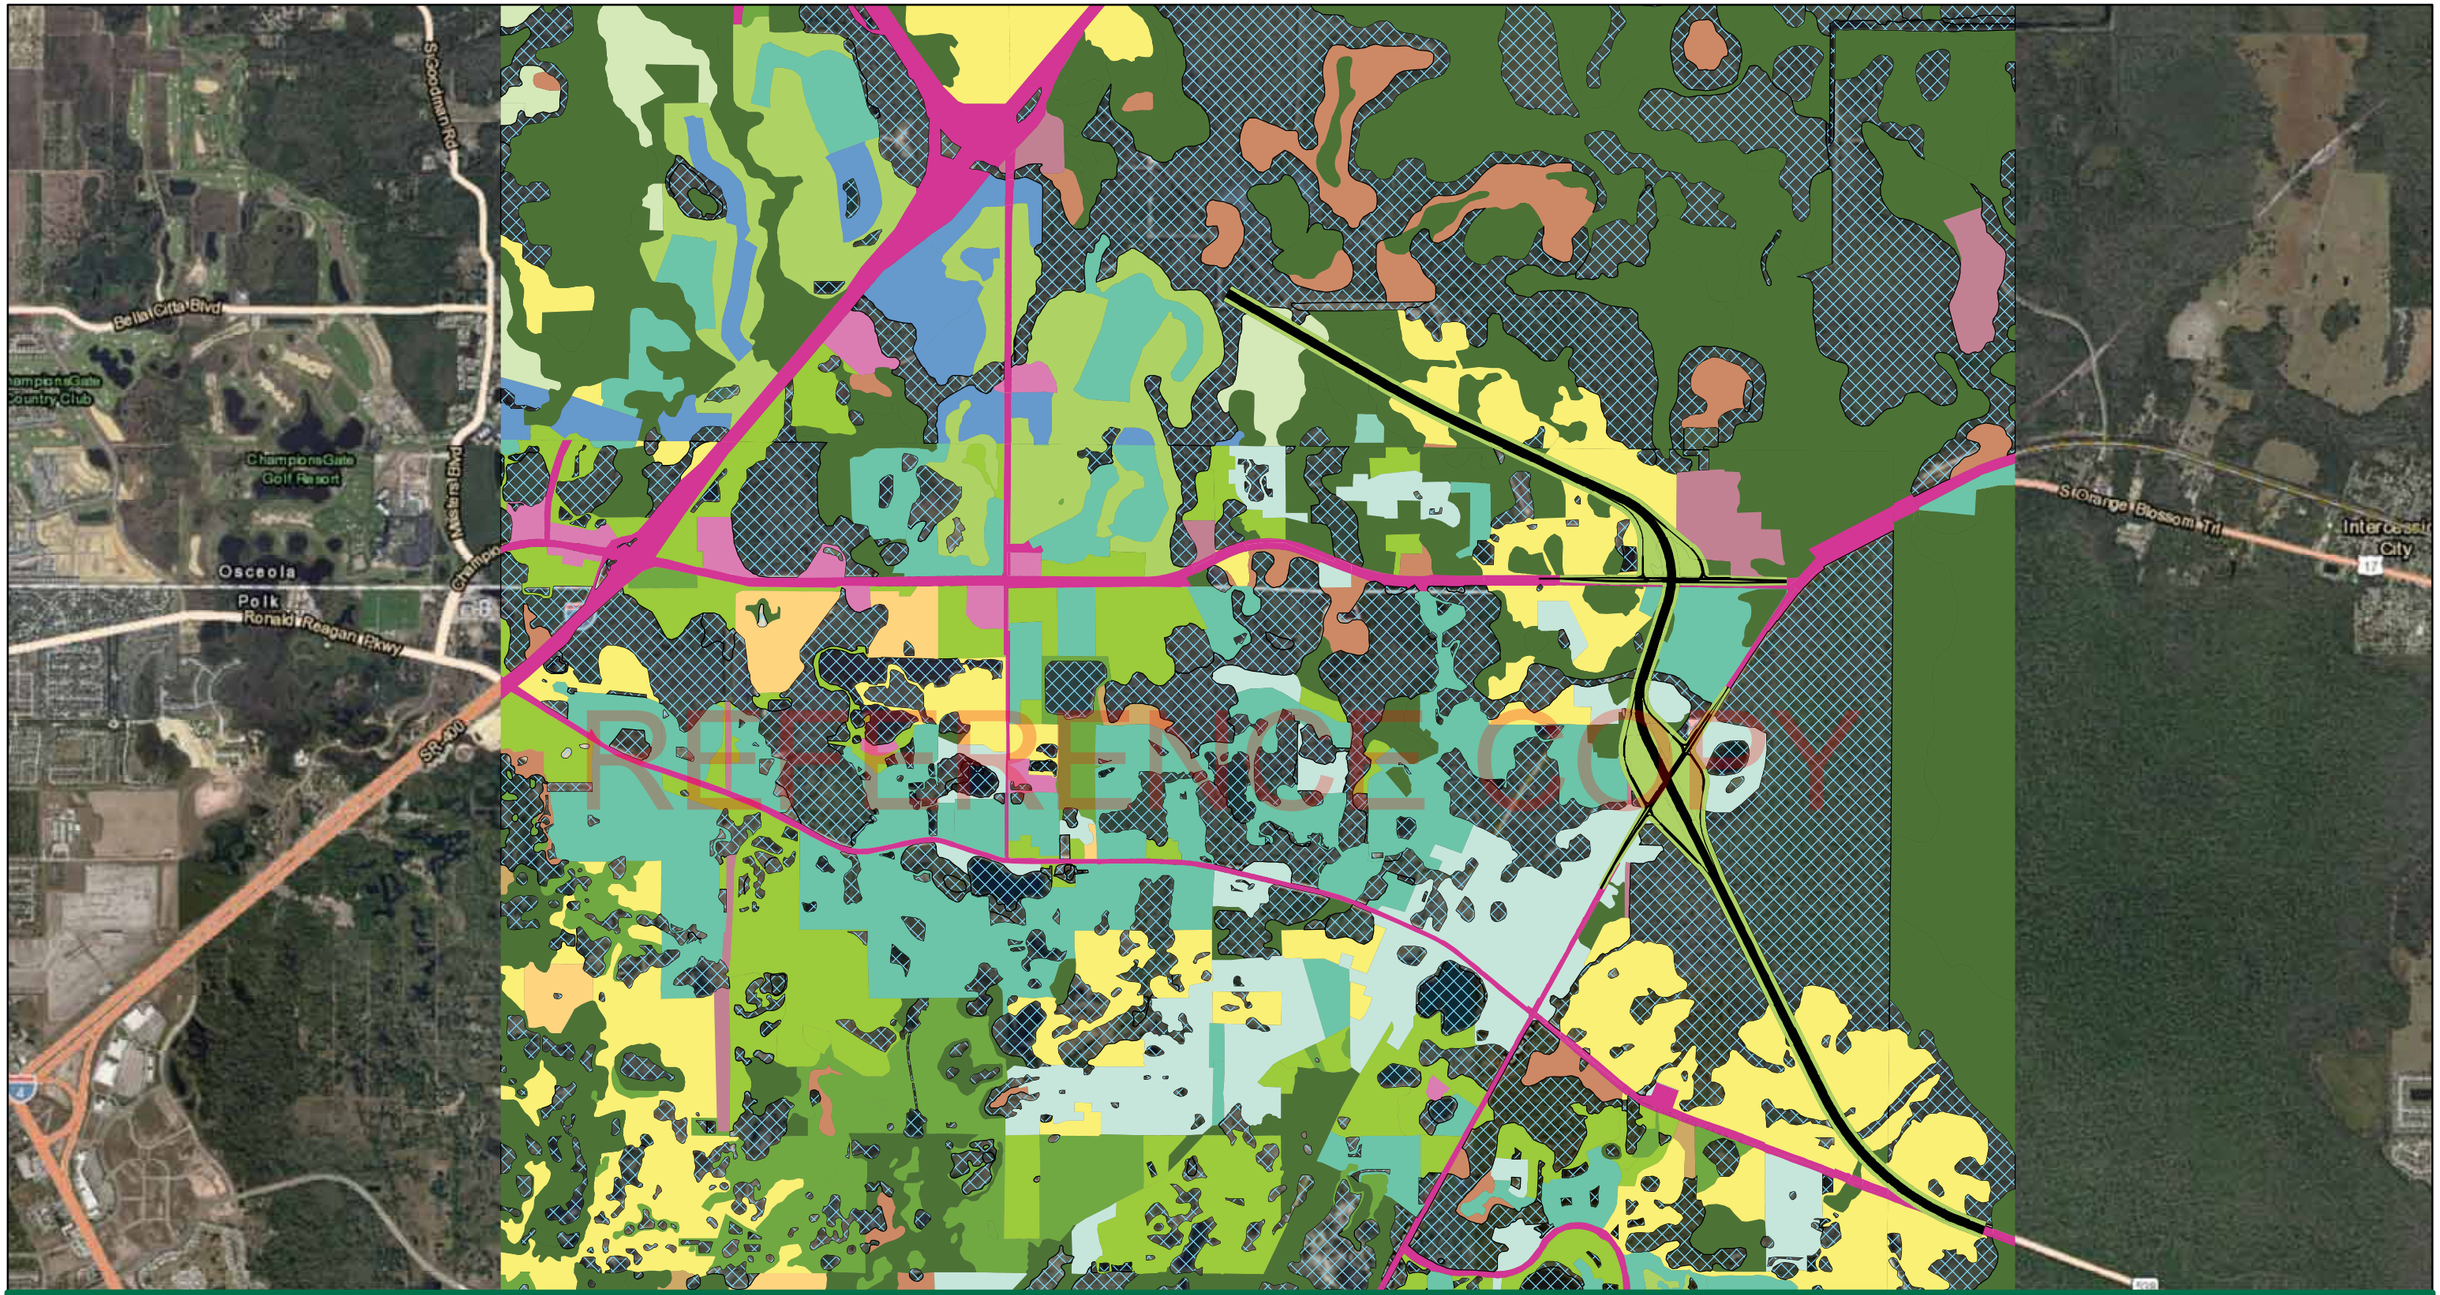

Legend

- Brush - Good
- Commercial and business
- Impervious
- Industrial
- Open - Fair
- Open - Good
- Open - Poor
- Pasture - Good
- Range - Good
- Residential - 2 acres
- Residential - 1 acre
- Residential - 1/2 acre
- Residential - 1/4 acre
- Residential - 1/8 acre
- Row Crops - Straight Row
- Streets and Roads - Paved; Including R/W
- Water
- Woods - Good

N
W E
S

0 0.5 1

Miles

The Balmoral Group
165 Lincoln Avenue
Winter Park, Florida 32789

Figure A-4 : Alignment 2A-5 Proposed Land Cover/Land Use

Concept, Feasibility, & Mobility Study
Poinciana Pkwy Extension/I-4 Connector Expressway
Osceola & Polk County, FL

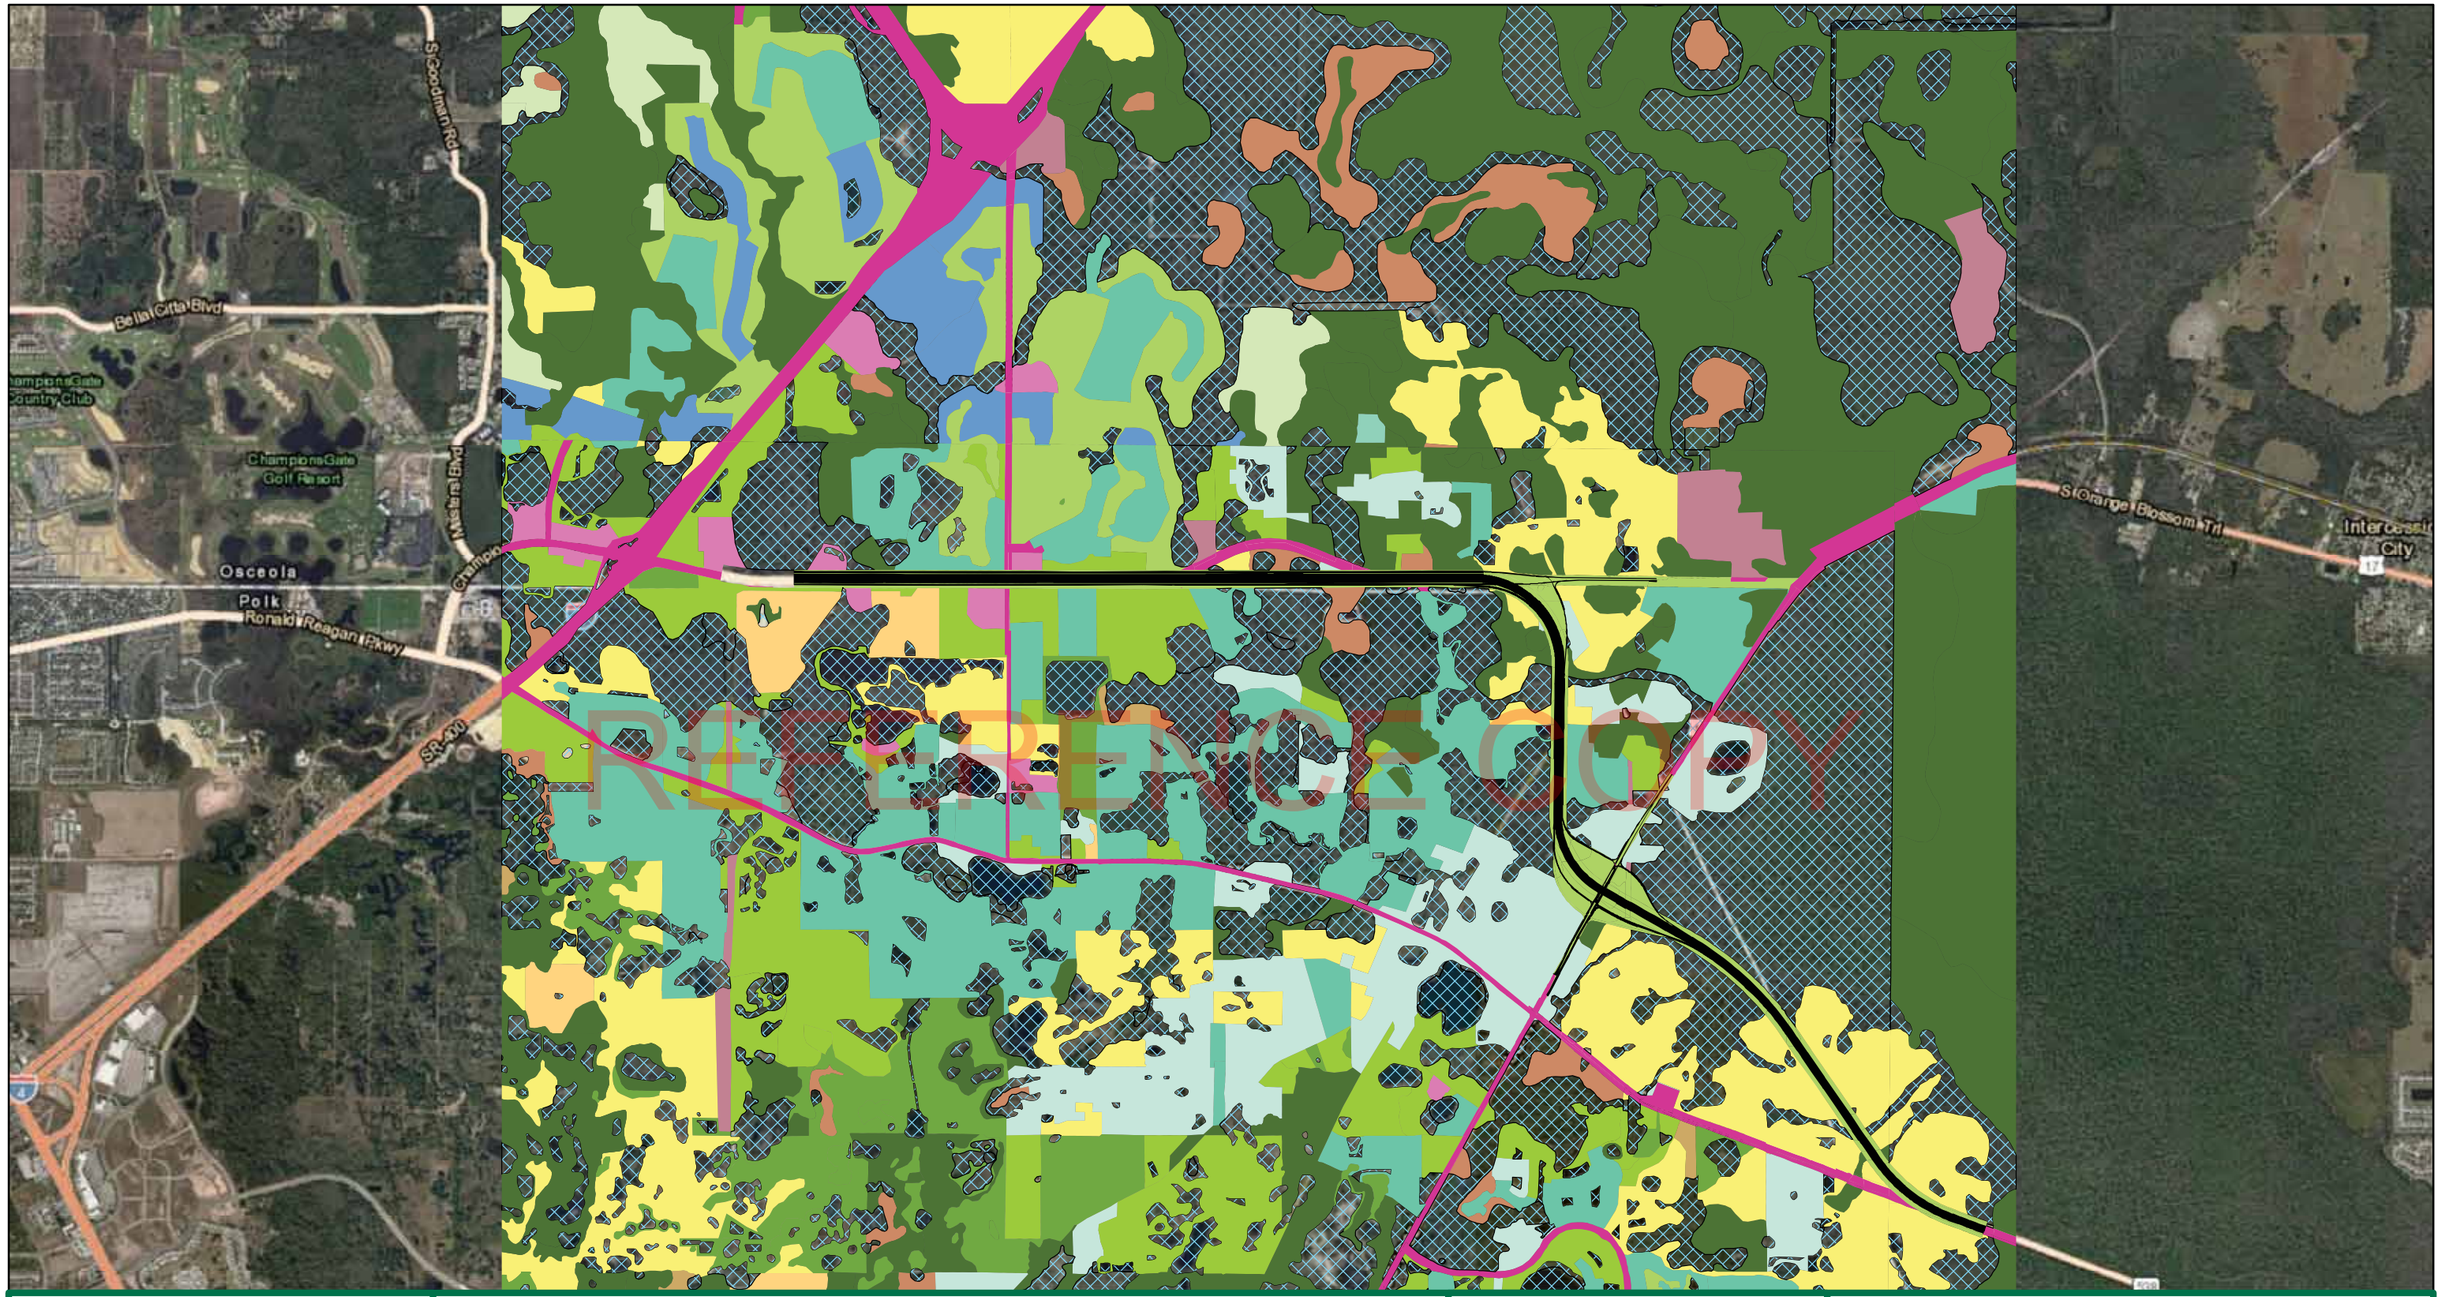

The Balmoral Group

165 Lincoln Avenue
Winter Park, Florida 32789

Legend

- Brush - Good
- Commercial and business
- Impervious
- Industrial
- Open - Fair
- Open - Good
- Open - Poor
- Pasture - Good
- Range - Good
- Residential - 2 acres
- Residential - 1 acre
- Residential - 1/2 acre
- Residential - 1/4 acre
- Residential - 1/8 acre
- Row Crops - Straight Row
- Streets and Roads - Paved; Including R/W
- Water
- Woods - Good

N
W E
S

0 0.5 1
Miles

Figure A-4 : Alignment 3-2N Proposed Land Cover/Land Use

Concept, Feasibility, & Mobility Study
Poinciana Pkwy Extension/I-4 Connector Expressway
Osceola & Polk County, FL

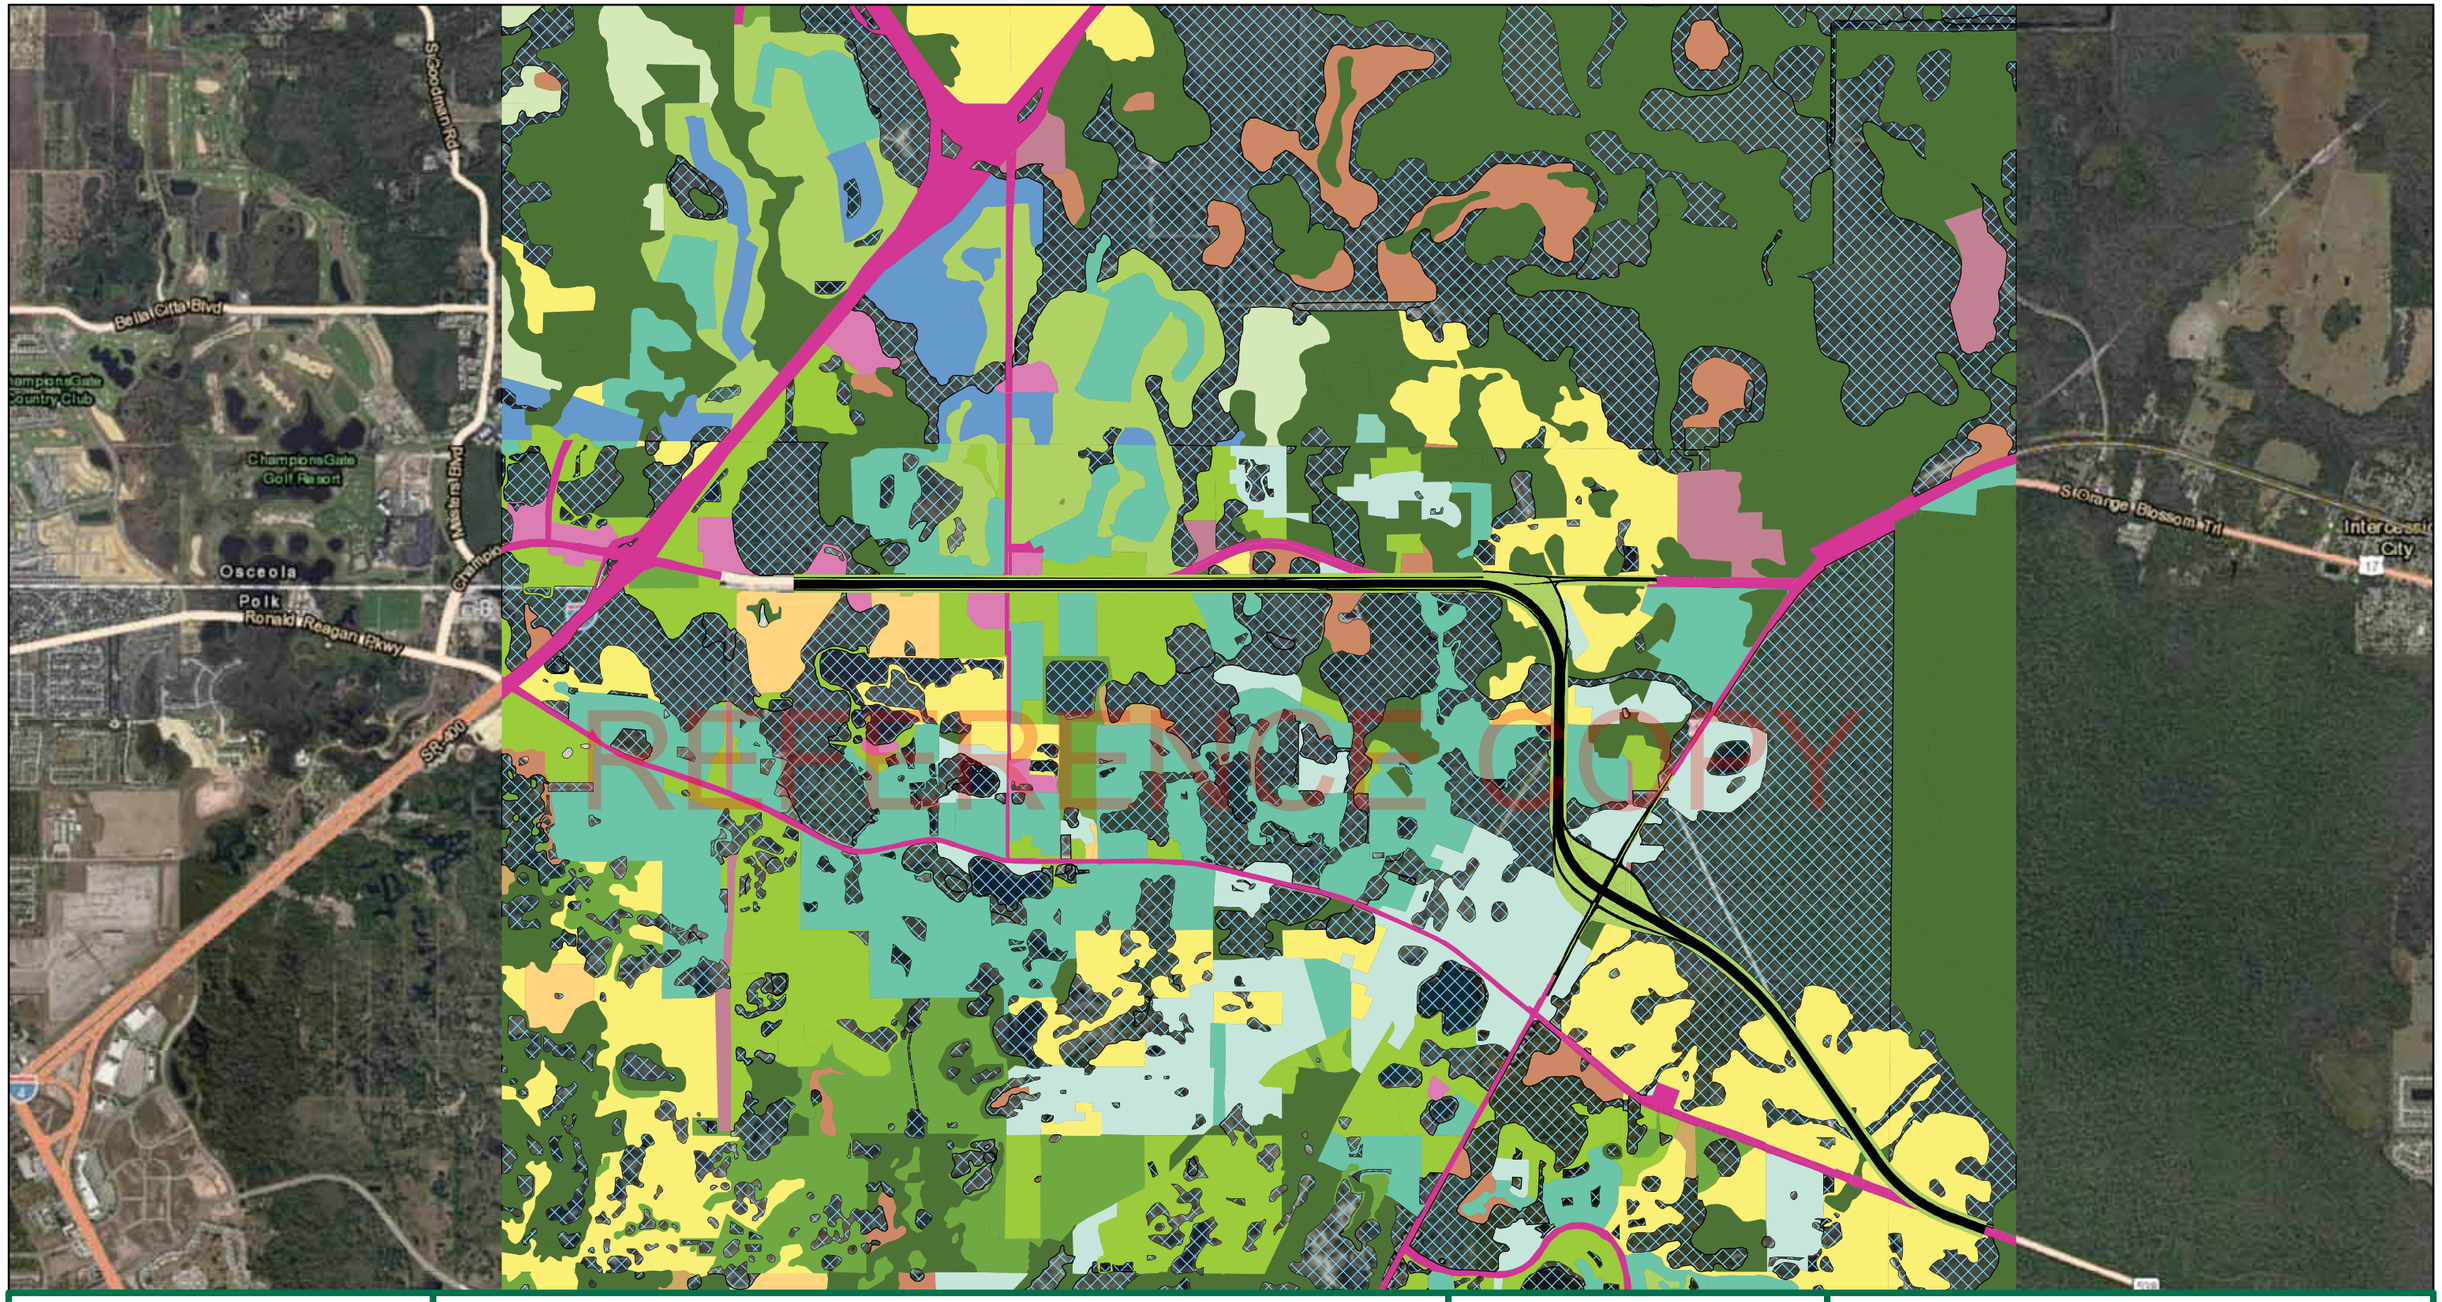

The Balmoral Group
165 Lincoln Avenue
Winter Park, Florida 32789

Legend

- Brush - Good
- Commercial and business
- Impervious
- Industrial
- Open - Fair
- Open - Good
- Open - Poor
- Pasture - Good
- Range - Good
- Residential - 2 acres
- Residential - 1 acre
- Residential - 1/2 acre
- Residential - 1/4 acre
- Residential - 1/8 acre
- Row Crops - Straight Row
- Streets and Roads - Paved; Including R/W
- Water
- Woods - Good

N
W E
S

0 0.5 1
Miles

Figure A-4 : Alignment 3-2S Proposed Land Cover/Land Use

Concept, Feasibility, & Mobility Study
Poinciana Pkwy Extension/I-4 Connector Expressway
Osceola & Polk County, FL

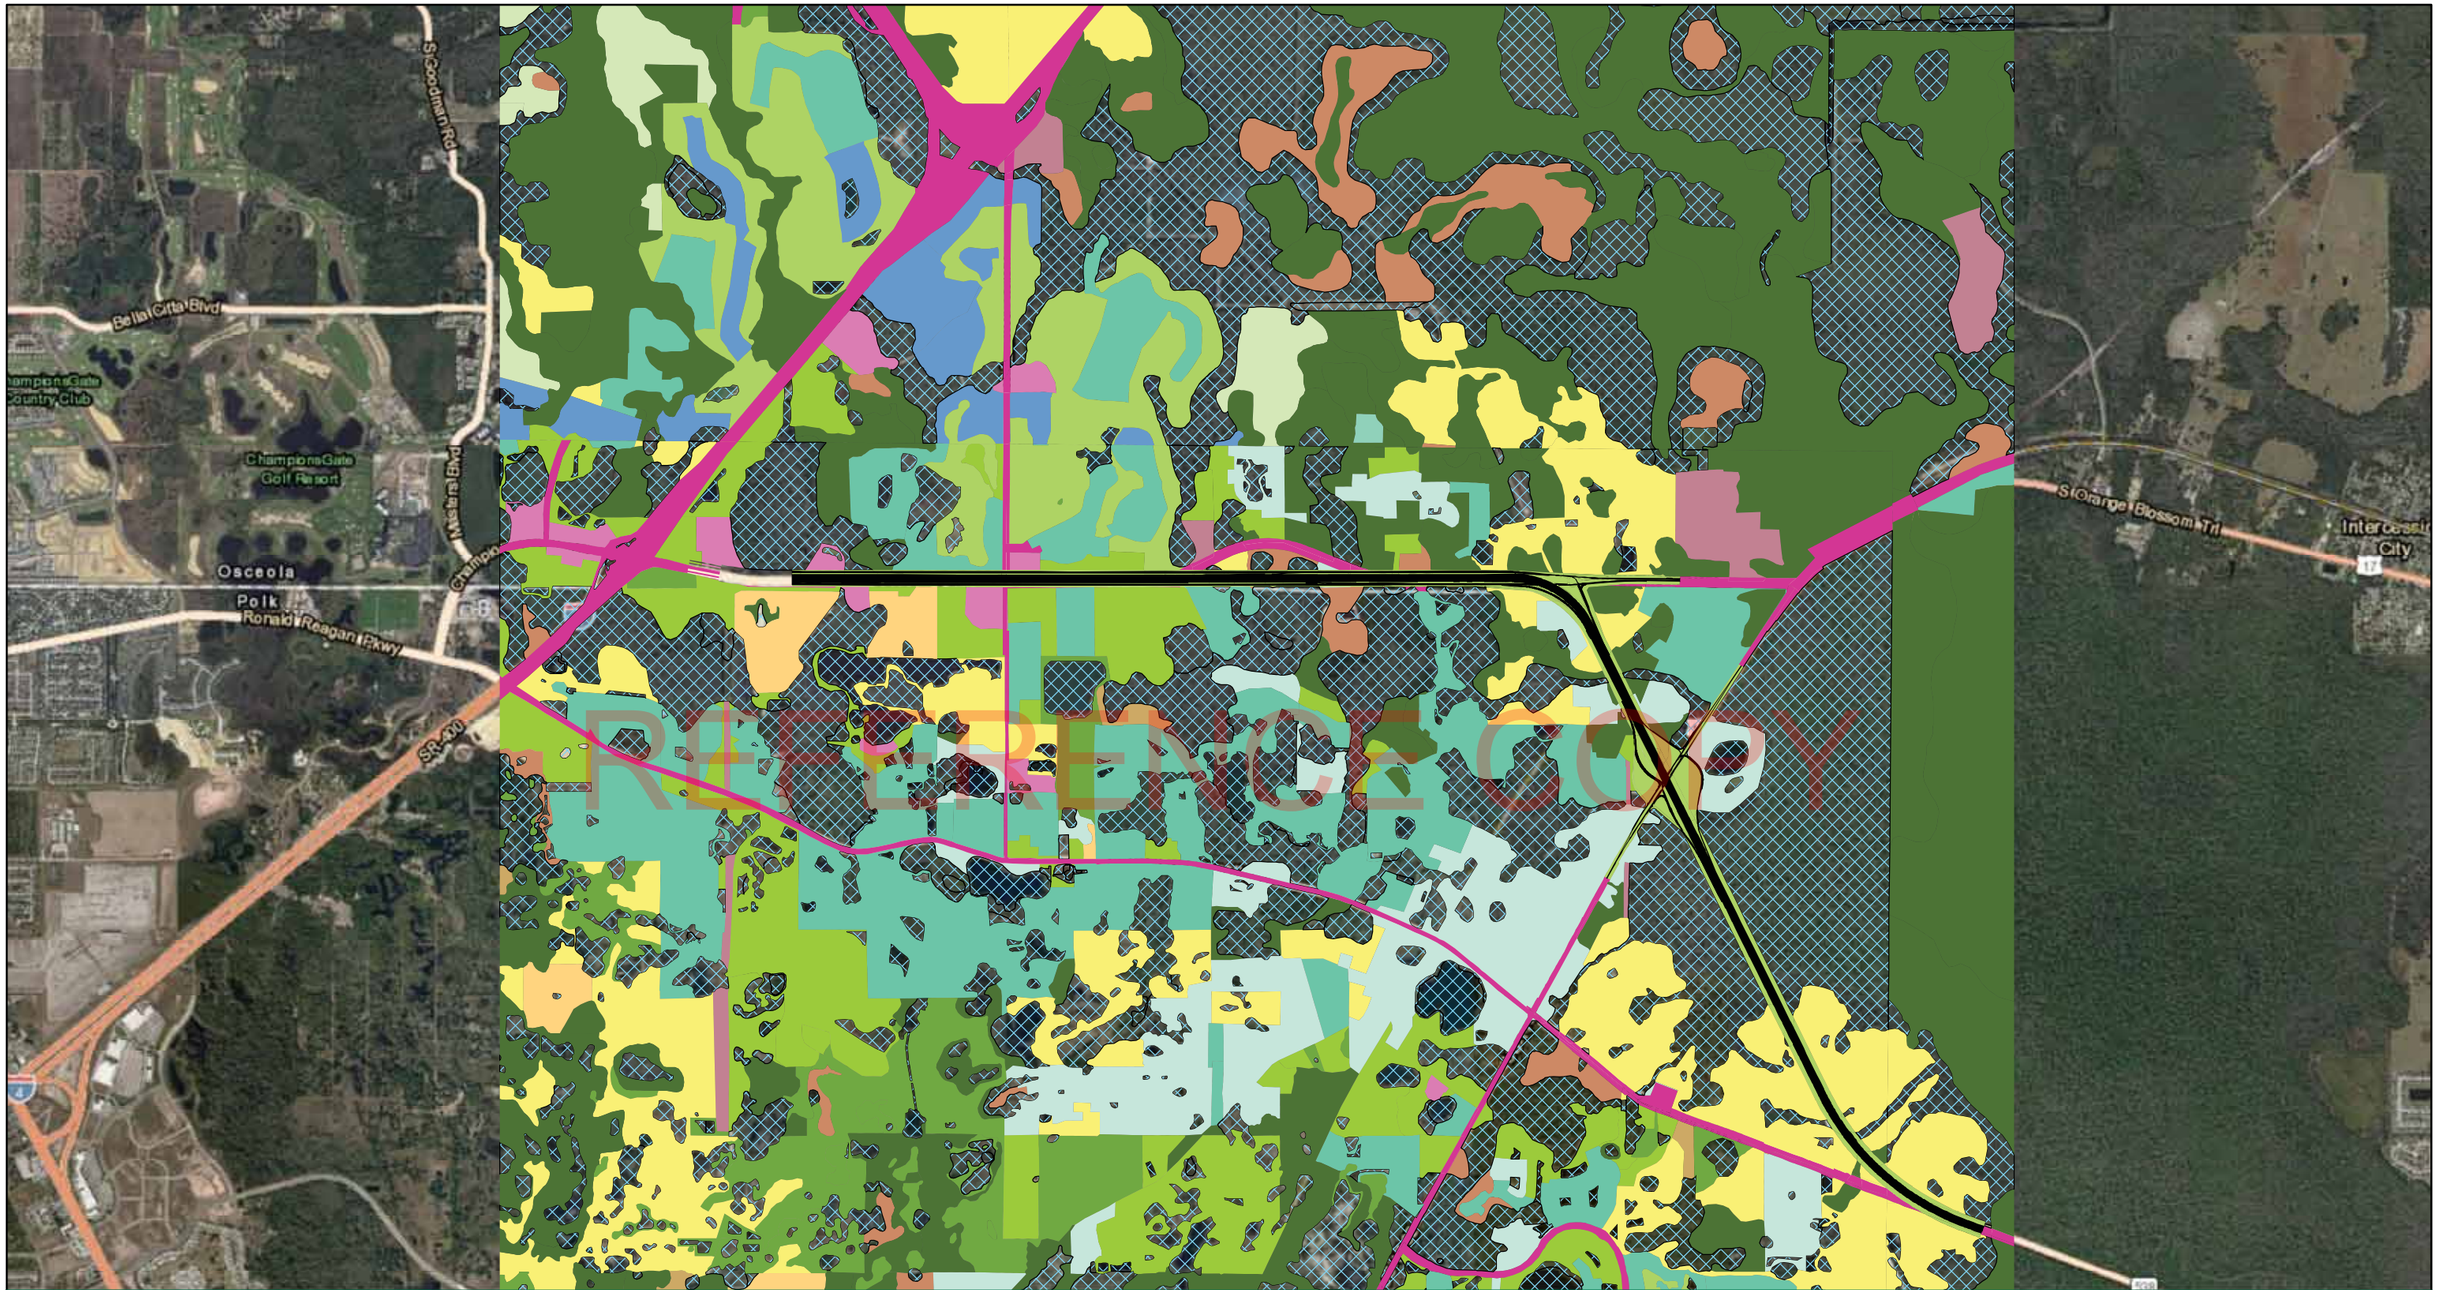

The Balmoral Group
165 Lincoln Avenue
Winter Park, Florida 32789

Legend

- Brush - Good
- Commercial and business
- Impervious
- Industrial
- Open - Fair
- Open - Good
- Open - Poor
- Pasture - Good
- Range - Good
- Residential - 2 acres
- Residential - 1 acre
- Residential - 1/2 acre
- Residential - 1/4 acre
- Residential - 1/8 acre
- Row Crops - Straight Row
- Streets and Roads - Paved; Including R/W
- Water
- Woods - Good

N
W E
S

0 0.5 1
Miles

Figure A-4 : Alignment 3-5N Proposed Land Cover/Land Use

Concept, Feasibility, & Mobility Study
Poinciana Pkwy Extension/I-4 Connector Expressway
Osceola & Polk County, FL

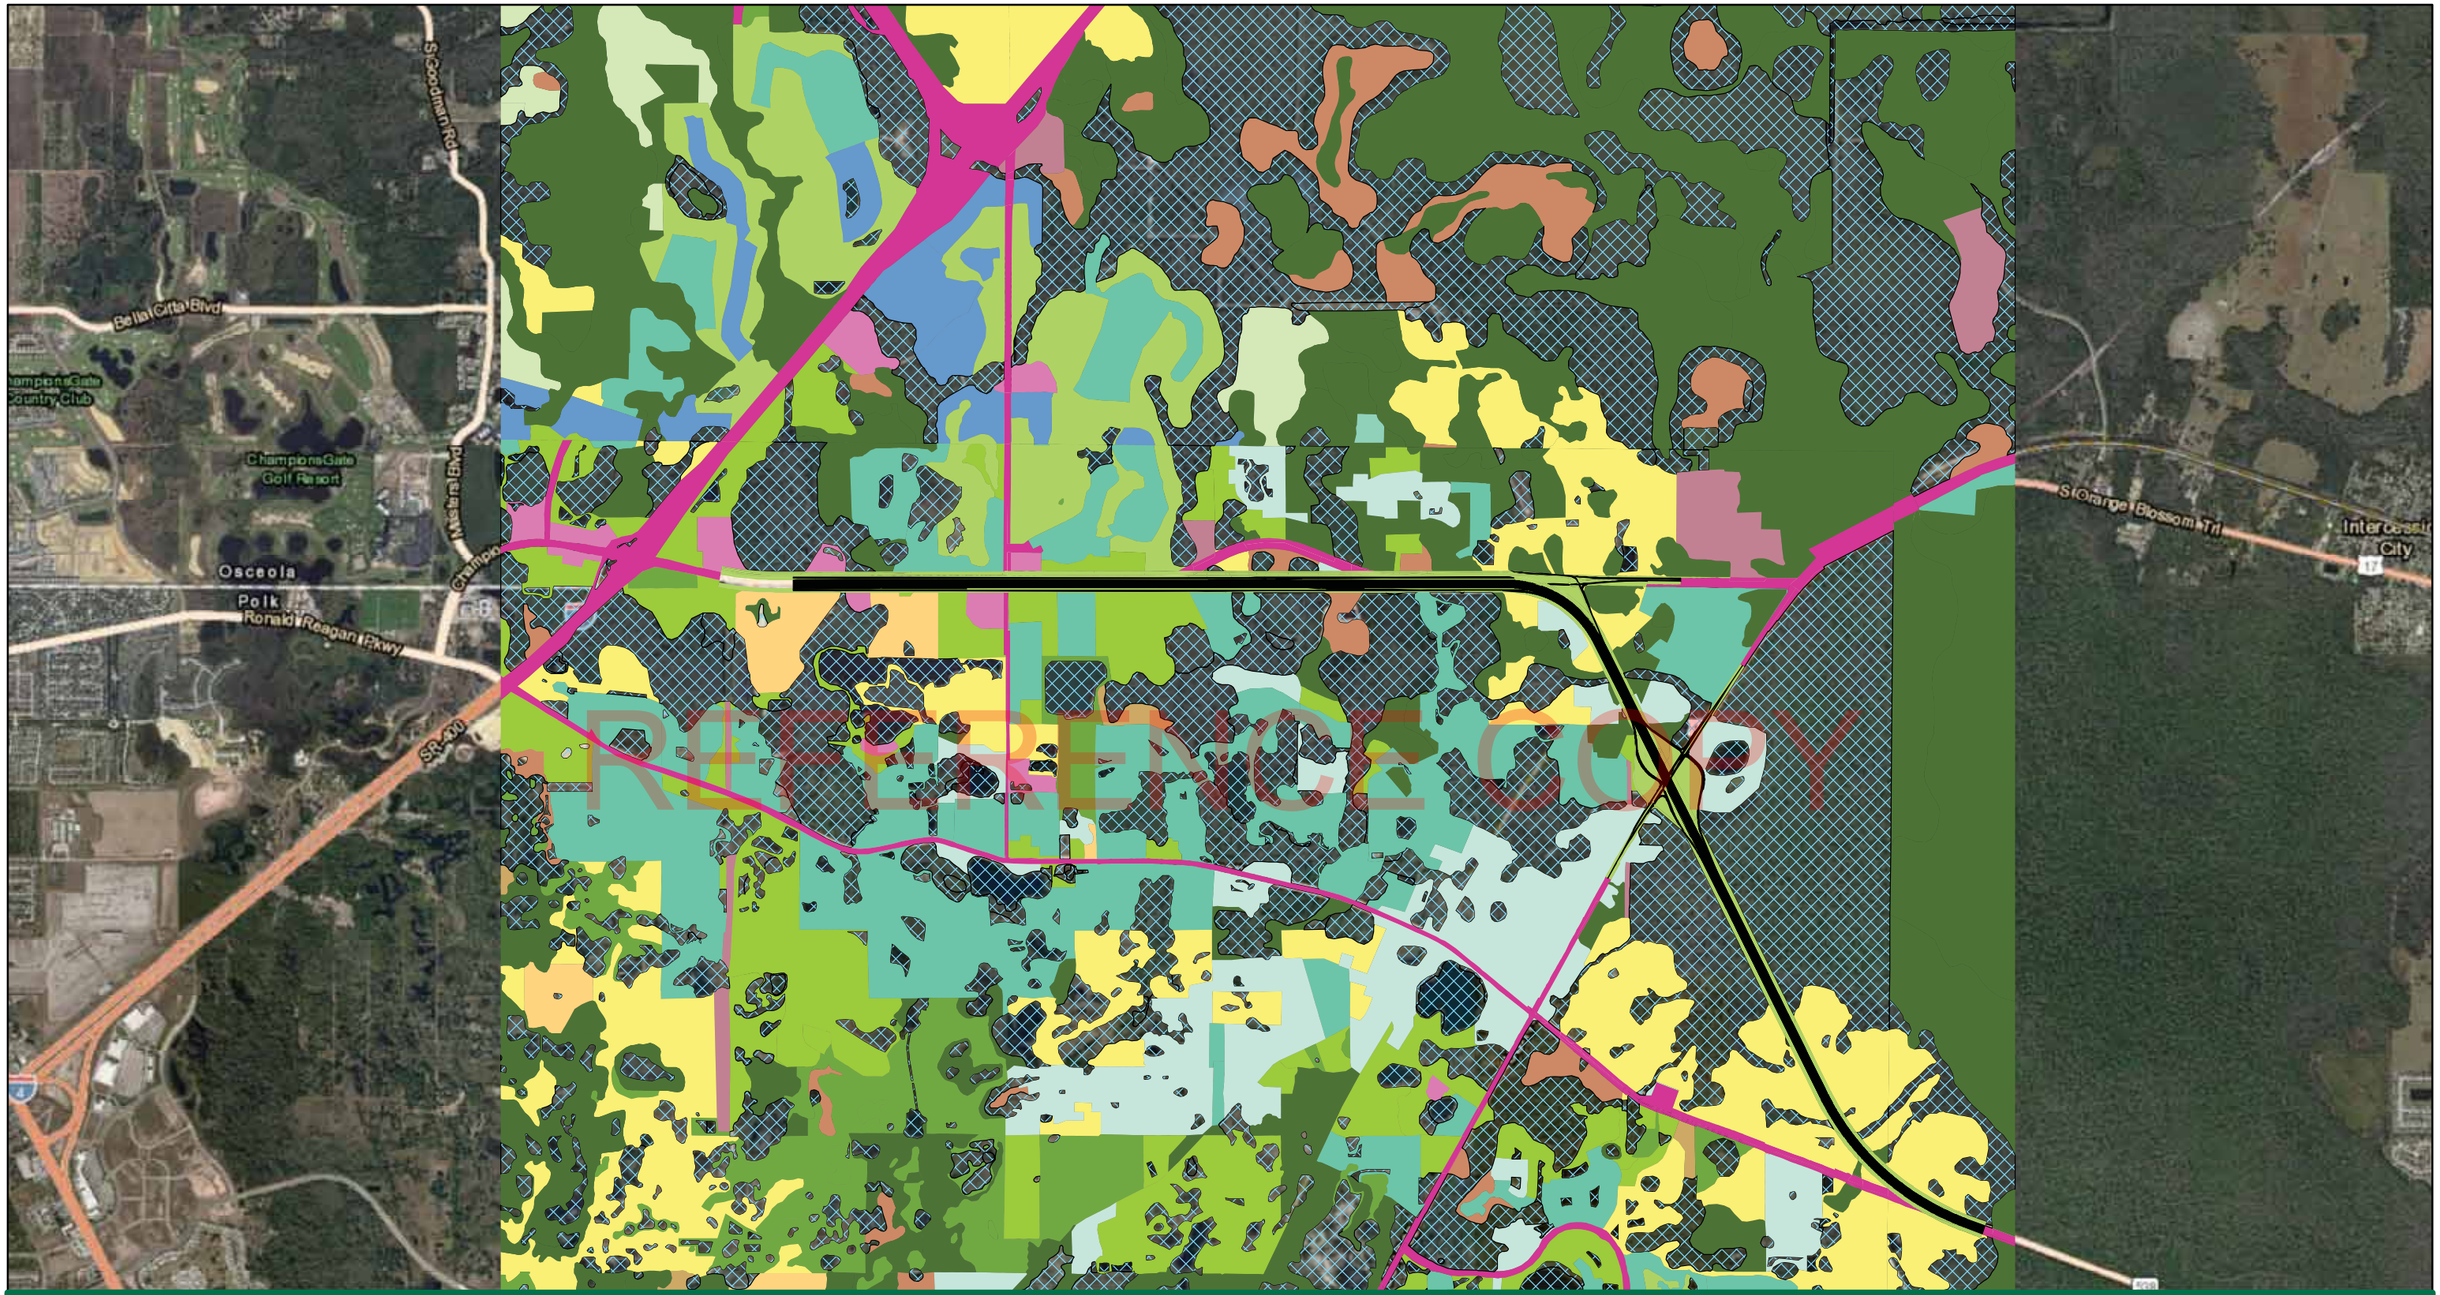

The Balmoral Group

165 Lincoln Avenue
Winter Park, Florida 32789

Legend

- Brush - Good
- Commercial and business
- Impervious
- Industrial
- Open - Fair
- Open - Good
- Open - Poor
- Pasture - Good
- Range - Good
- Residential - 2 acres
- Residential - 1 acre
- Residential - 1/2 acre
- Residential - 1/4 acre
- Residential - 1/8 acre
- Row Crops - Straight Row
- Streets and Roads - Paved; Including R/W
- Water
- Woods - Good

N
W E
S

0 0.5 1
Miles

Figure A-4 : Alignment 3-5S Proposed Land Cover/Land Use

Concept, Feasibility, & Mobility Study
Poinciana Pkwy Extension/I-4 Connector Expressway
Osceola & Polk County, FL

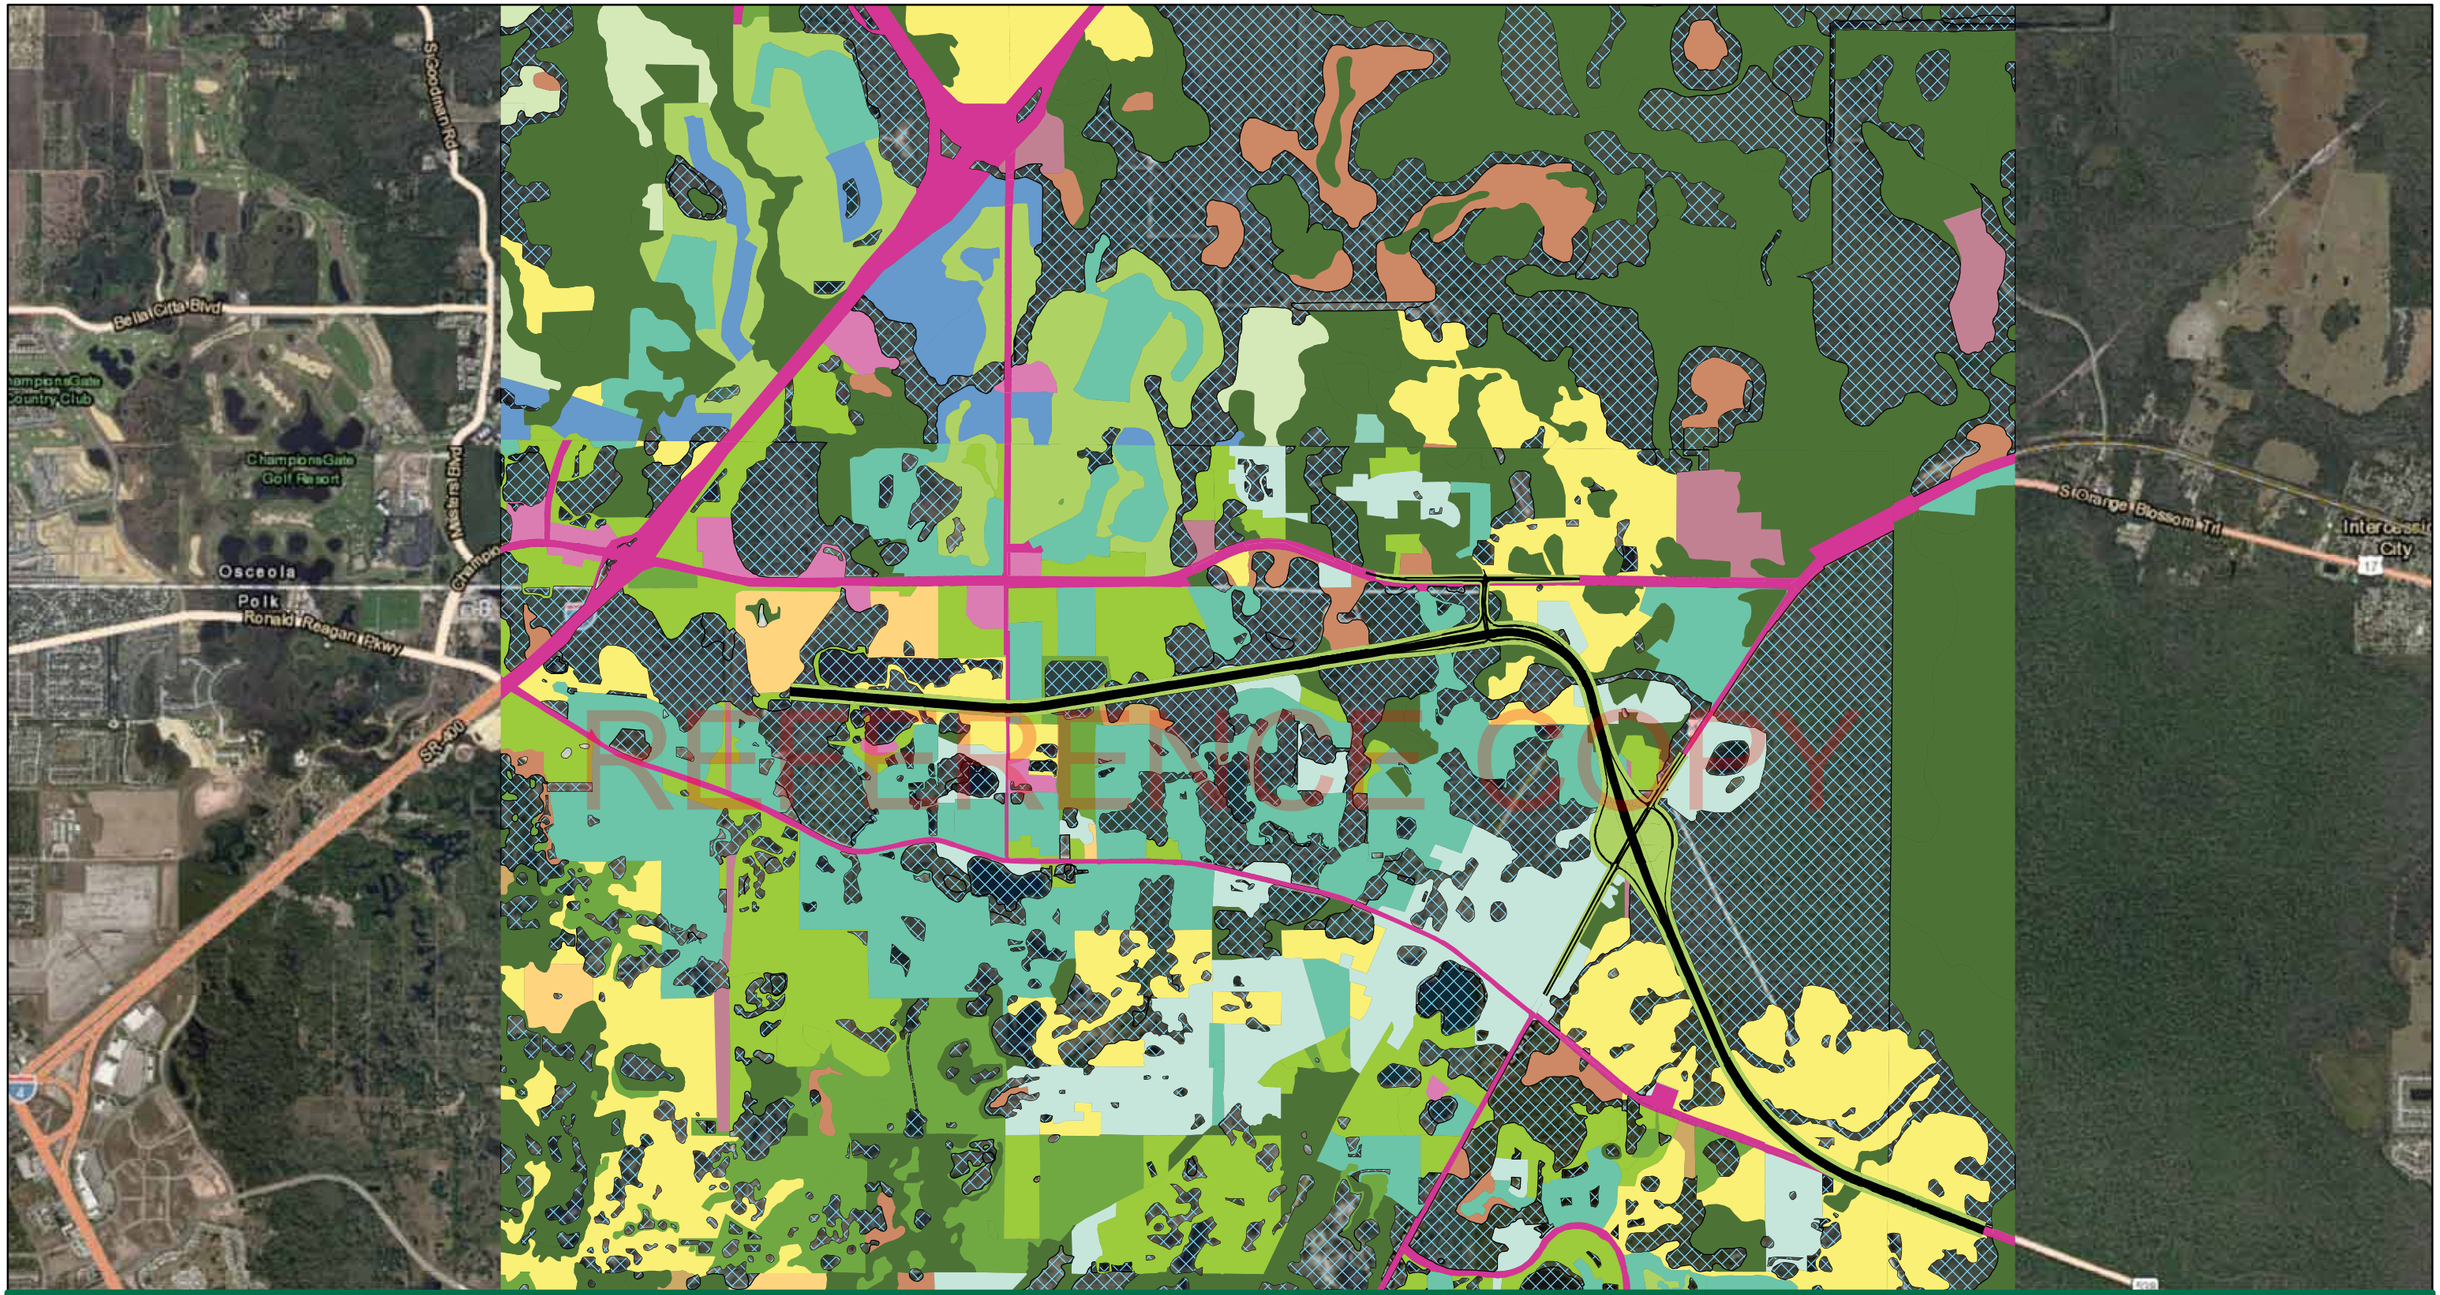

The Balmoral Group

165 Lincoln Avenue
Winter Park, Florida 32789

Legend

- Brush - Good
- Commercial and business
- Impervious
- Industrial
- Open - Fair
- Open - Good
- Open - Poor
- Pasture - Good
- Range - Good
- Residential - 2 acres
- Residential - 1 acre
- Residential - 1/2 acre
- Residential - 1/4 acre
- Residential - 1/8 acre
- Row Crops - Straight Row
- Streets and Roads - Paved; Including R/W
- Water
- Woods - Good

N
W E
S

0 0.5 1
Miles

Figure A-4 : Alignment 3A-3 Proposed Land Cover/Land Use

Concept, Feasibility, & Mobility Study
Poinciana Pkwy Extension/I-4
Connector Expressway
Osceola & Polk County, FL

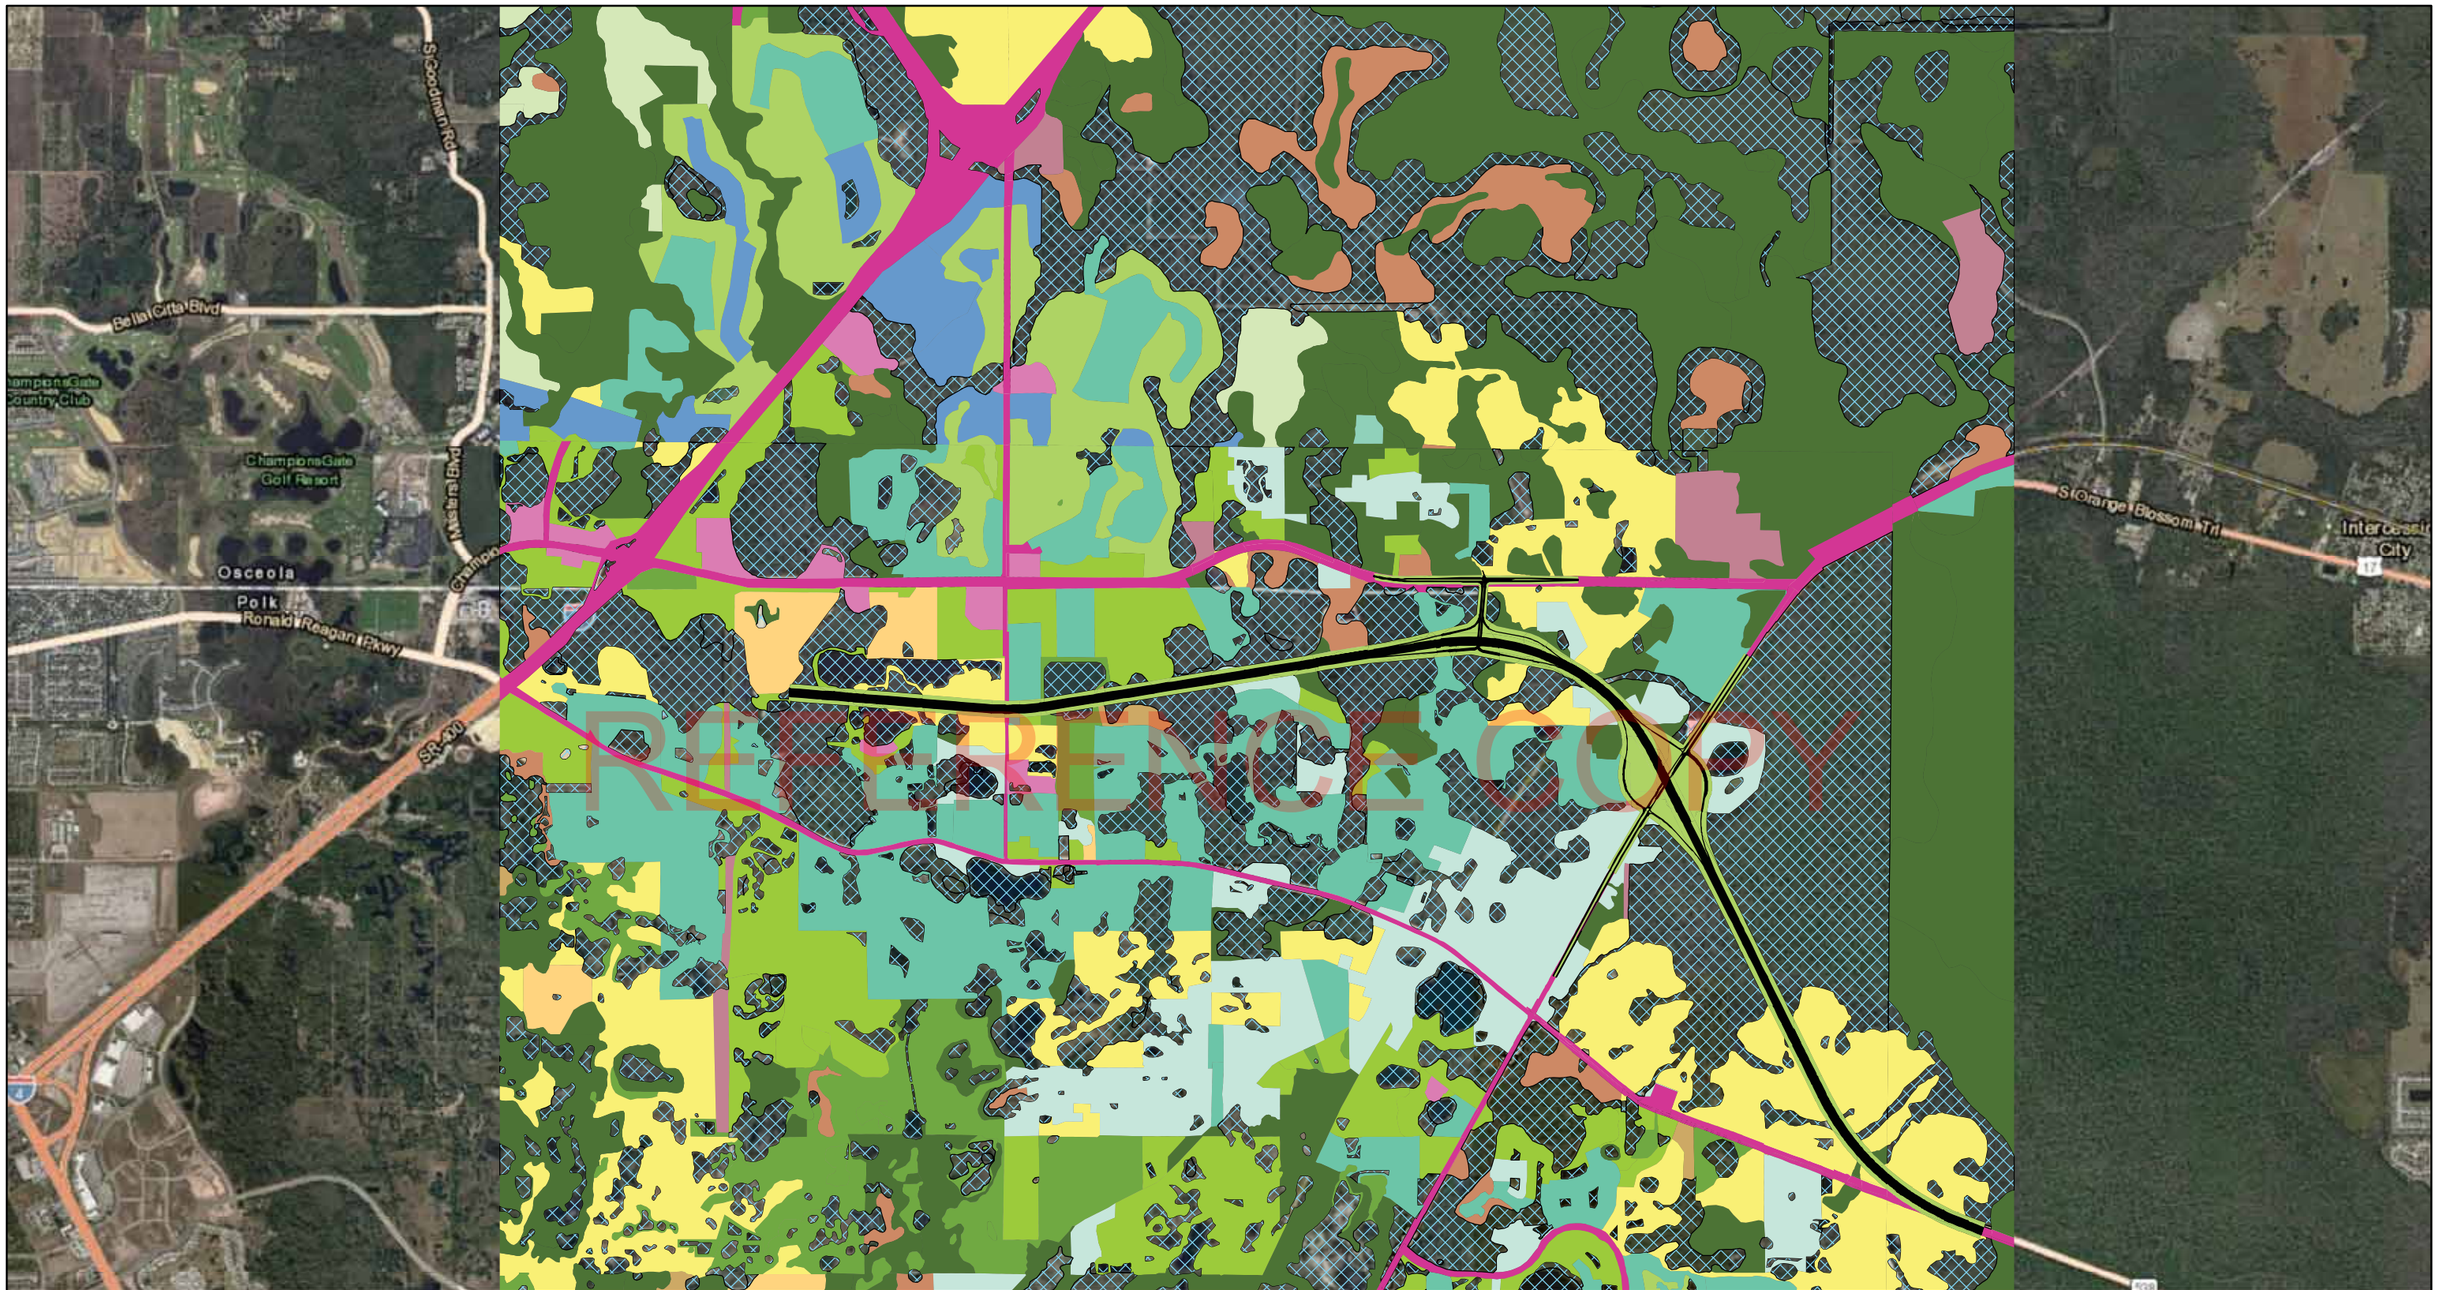

The Balmoral Group

165 Lincoln Avenue
Winter Park, Florida 32789

Legend

- Brush - Good
- Commercial and business
- Impervious
- Industrial
- Open - Fair
- Open - Good
- Open - Poor
- Pasture - Good
- Range - Good
- Residential - 2 acres
- Residential - 1 acre
- Residential - 1/2 acre
- Residential - 1/4 acre
- Residential - 1/8 acre
- Row Crops - Straight Row
- Streets and Roads - Paved; Including R/W
- Water
- Woods - Good

N
W E
S

0 0.5 1
Miles

Figure A-4 : Alignment 3A-5 Proposed Land Cover/Land Use

Concept, Feasibility, & Mobility Study
Poinciana Pkwy Extension/I-4 Connector Expressway
Osceola & Polk County, FL

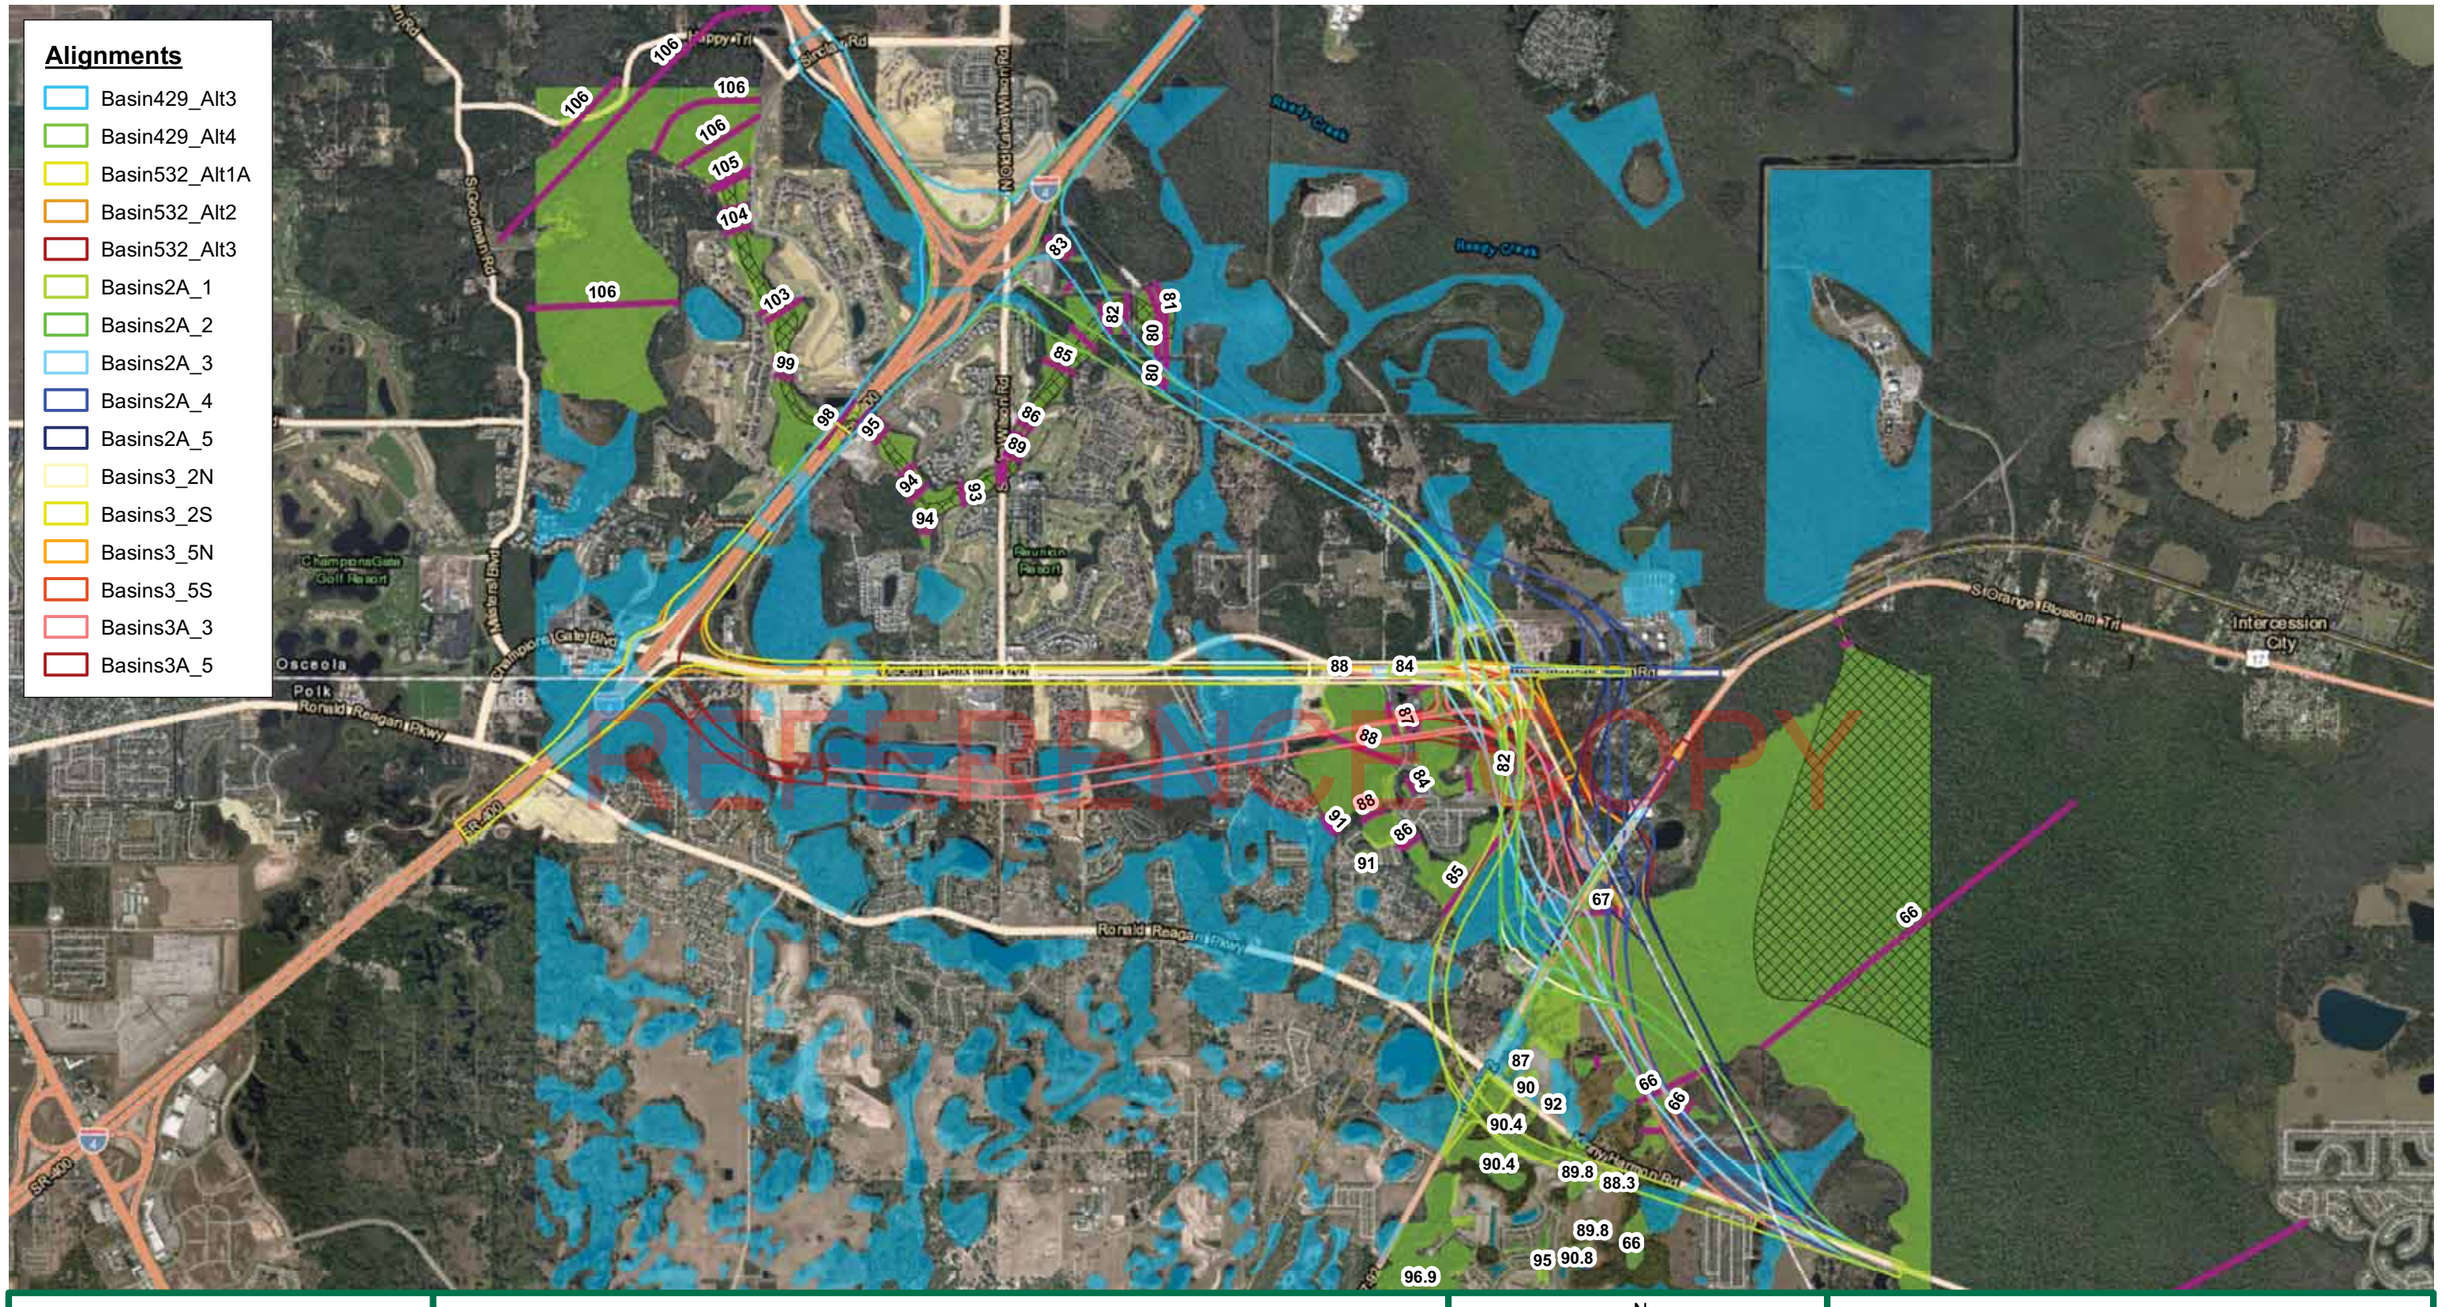

The Balmoral Group

165 Lincoln Avenue
Winter Park, Florida 32789

Legend

FEMA BFE

Zone AE

FEMA Floodway

FEMA Flood Zone

Zone A

N
W E
S

0 0.5 1
Miles

Figure A-5 : Floodplain Impacts FEMA Flood Zones

Concept, Feasibility, & Mobility Study
Poinciana Pkwy Extension/I-4 Connector Expressway
Osceola & Polk County, FL

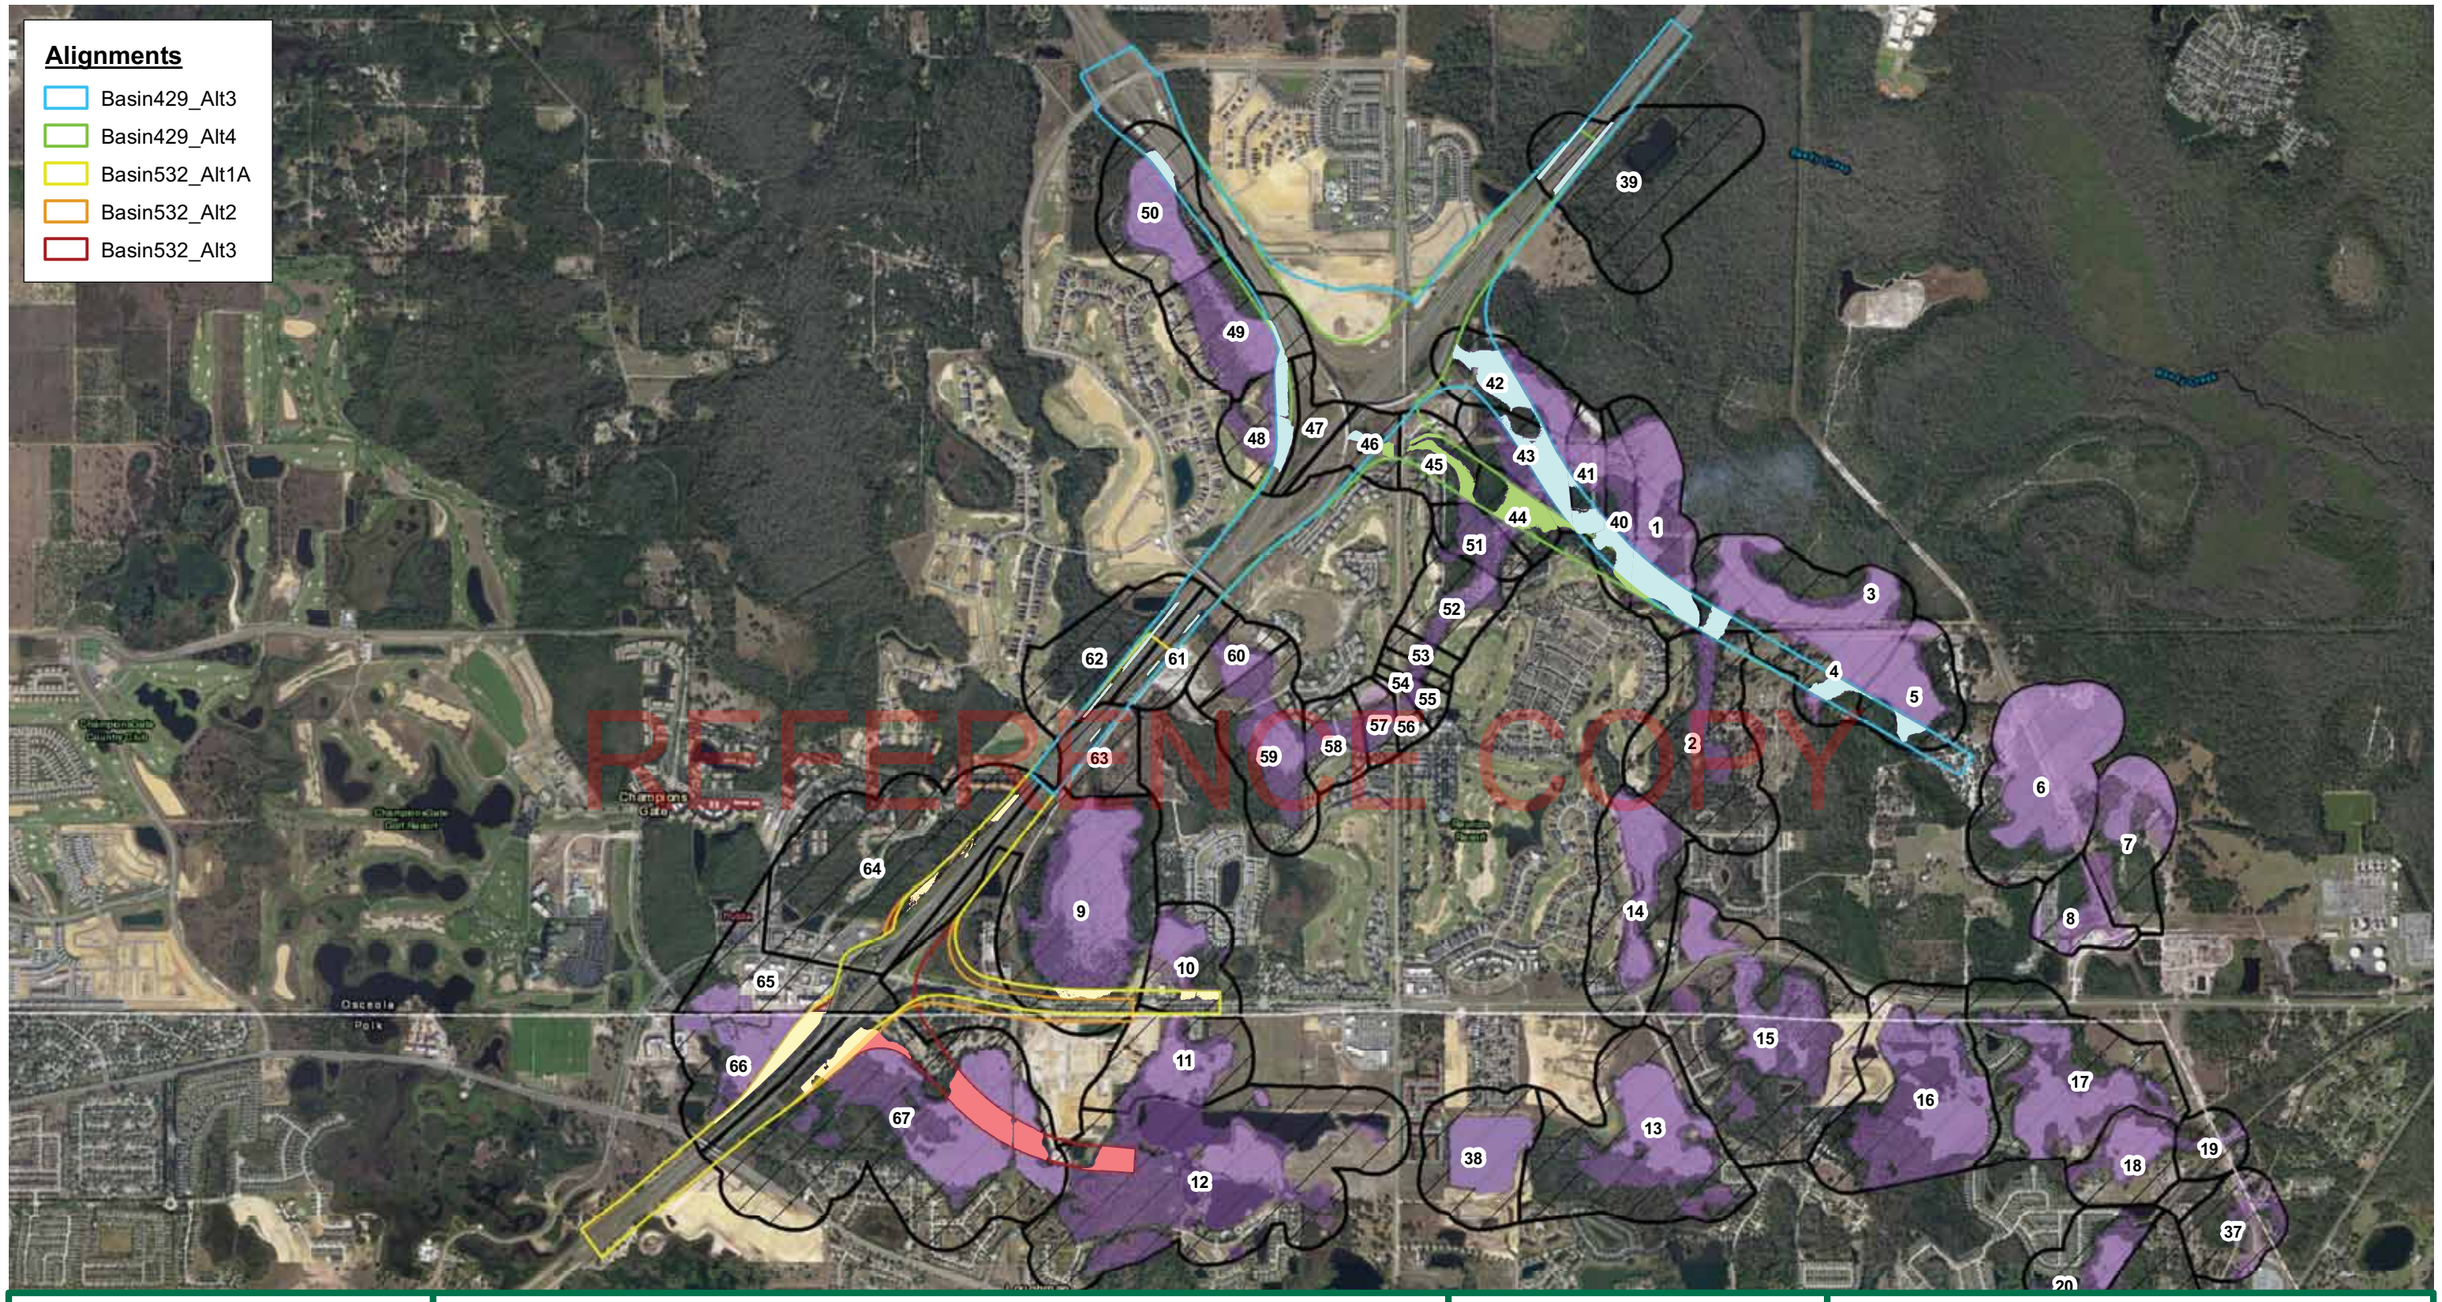

The Balmoral Group
165 Lincoln Avenue
Winter Park, Florida 32789

Legend

- SR 429 Alt 3 Impacts
- SR 429 Alt 4 Impacts
- CR 532 Alt 1A Impacts
- CR 532 Alt 2 Impacts
- CR 532 Alt 3 Impacts
- SHWT Inundation Shape
- 100-yr Inundation Shape
- Buffered FEMA Shapes

N
W E
S

0 0.35 0.7
Miles

Figure A-6 : Floodplain Impacts Inundated Floodplains & SHWL

Concept, Feasibility, & Mobility Study
Poinciana Pkwy Extension/I-4
Connector Expressway
Osceola & Polk County, FL

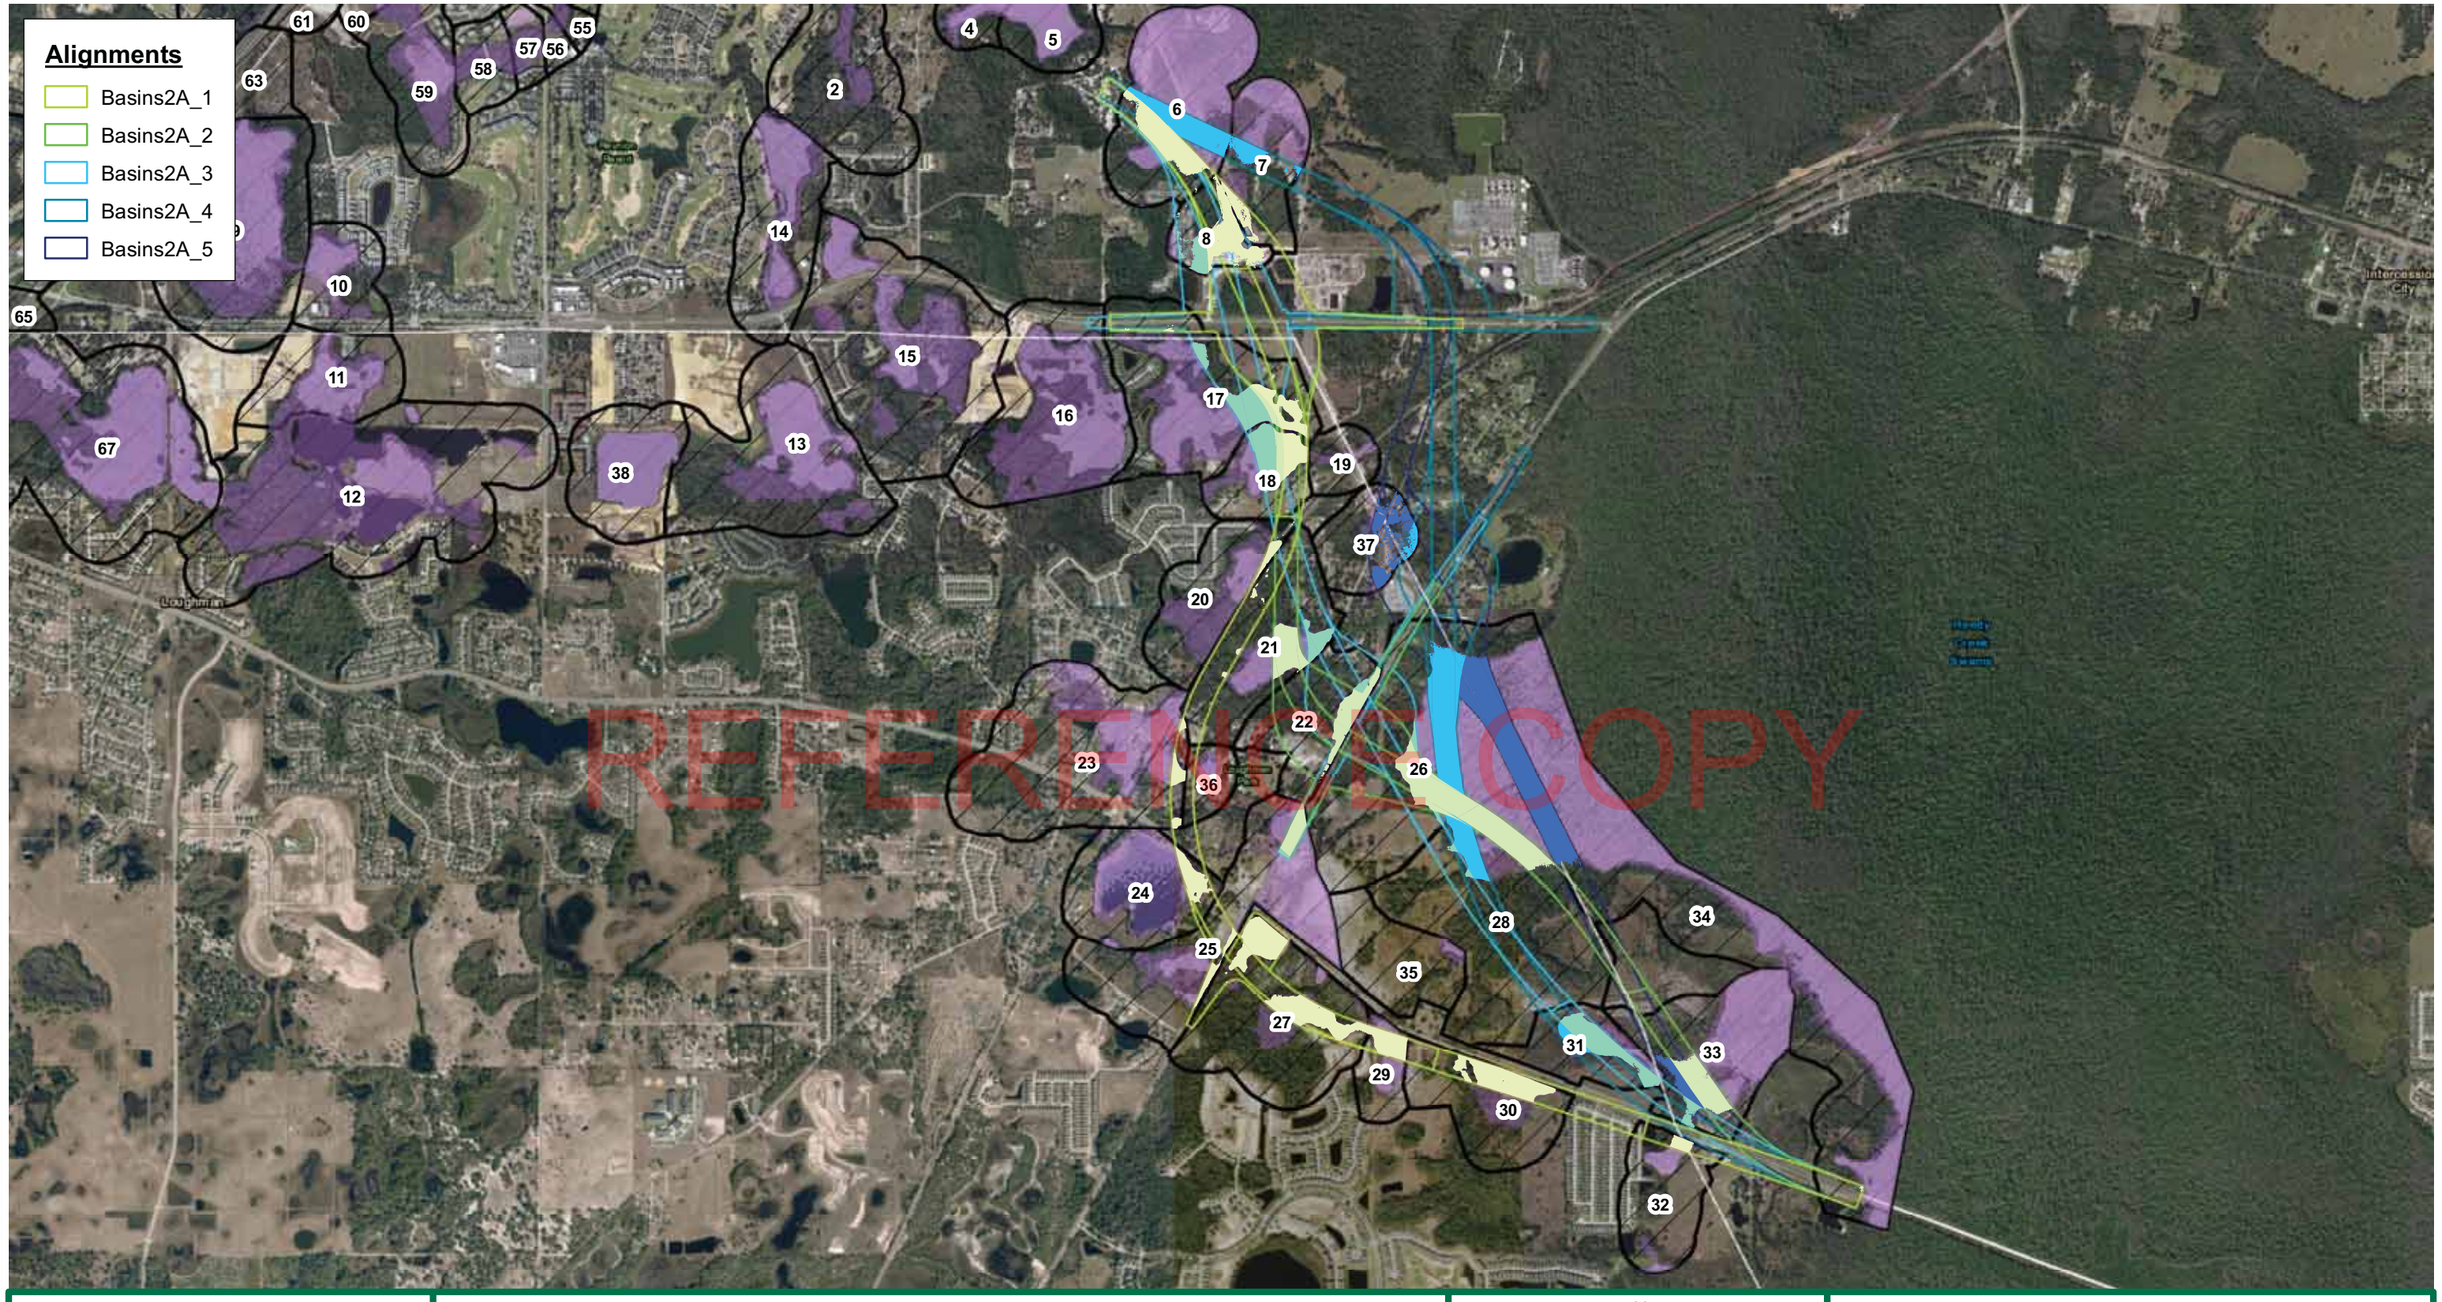

REFERENCE COPY

The Balmoral Group
165 Lincoln Avenue
Winter Park, Florida 32789

Legend

- Alt 2A-1 Impacts
- Alt 2A-2 Impacts
- Alt 2A-3 Impacts
- Alt 2A-4 Impacts
- Alt 2A-5 Impacts
- SHWT Inundation Shape
- 100-yr Inundation Shape
- Buffered FEMA Shapes

N
W E
S

0 0.35 0.7
Miles

Figure A-6 : Floodplain Impacts Inundated Floodplains & SHWL

Concept, Feasibility, & Mobility Study
Poinciana Pkwy Extension/I-4
Connector Expressway
Osceola & Polk County, FL

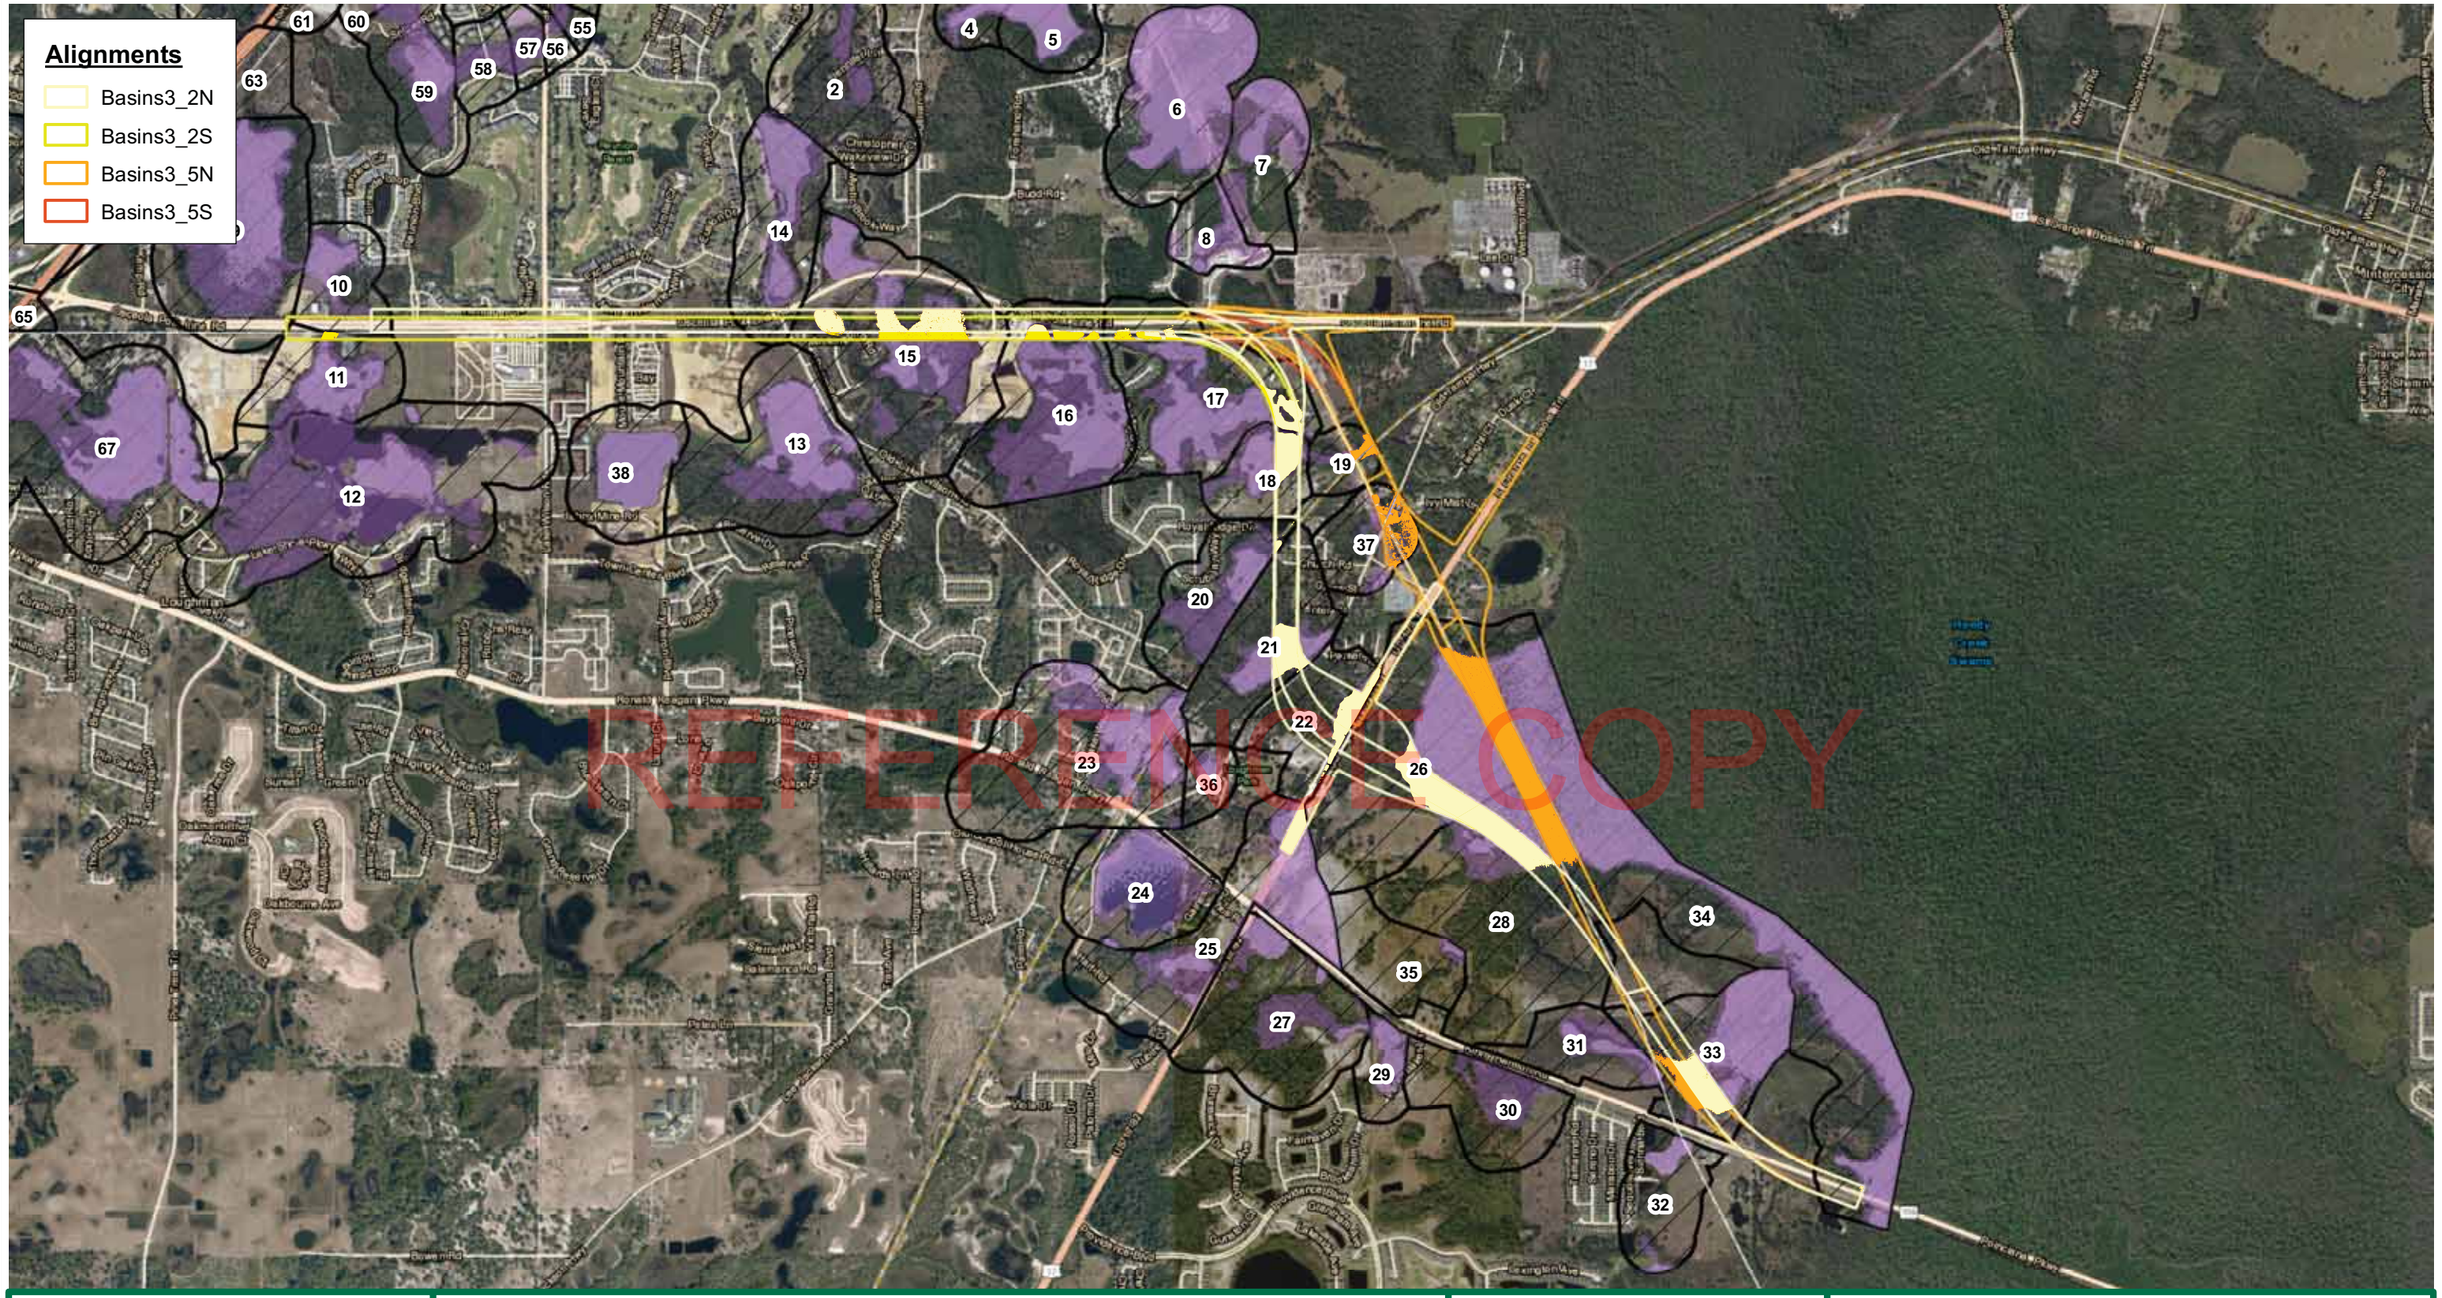

The Balmoral Group

165 Lincoln Avenue
Winter Park, Florida 32789

Legend

- Alt 3-2N Impacts
- Alt 3-2S Impacts
- Alt 3-5N Impacts
- Alt 3-5S Impacts
- SHWT Inundation Shape
- 100-yr Inundation Shape
- Buffered FEMA Shapes

N
W E
S

0 0.35 0.7
Miles

Figure A-6 : Floodplain Impacts Inundated Floodplains & SHWL

Concept, Feasibility, & Mobility Study
Poinciana Pkwy Extension/I-4
Connector Expressway
Osceola & Polk County, FL

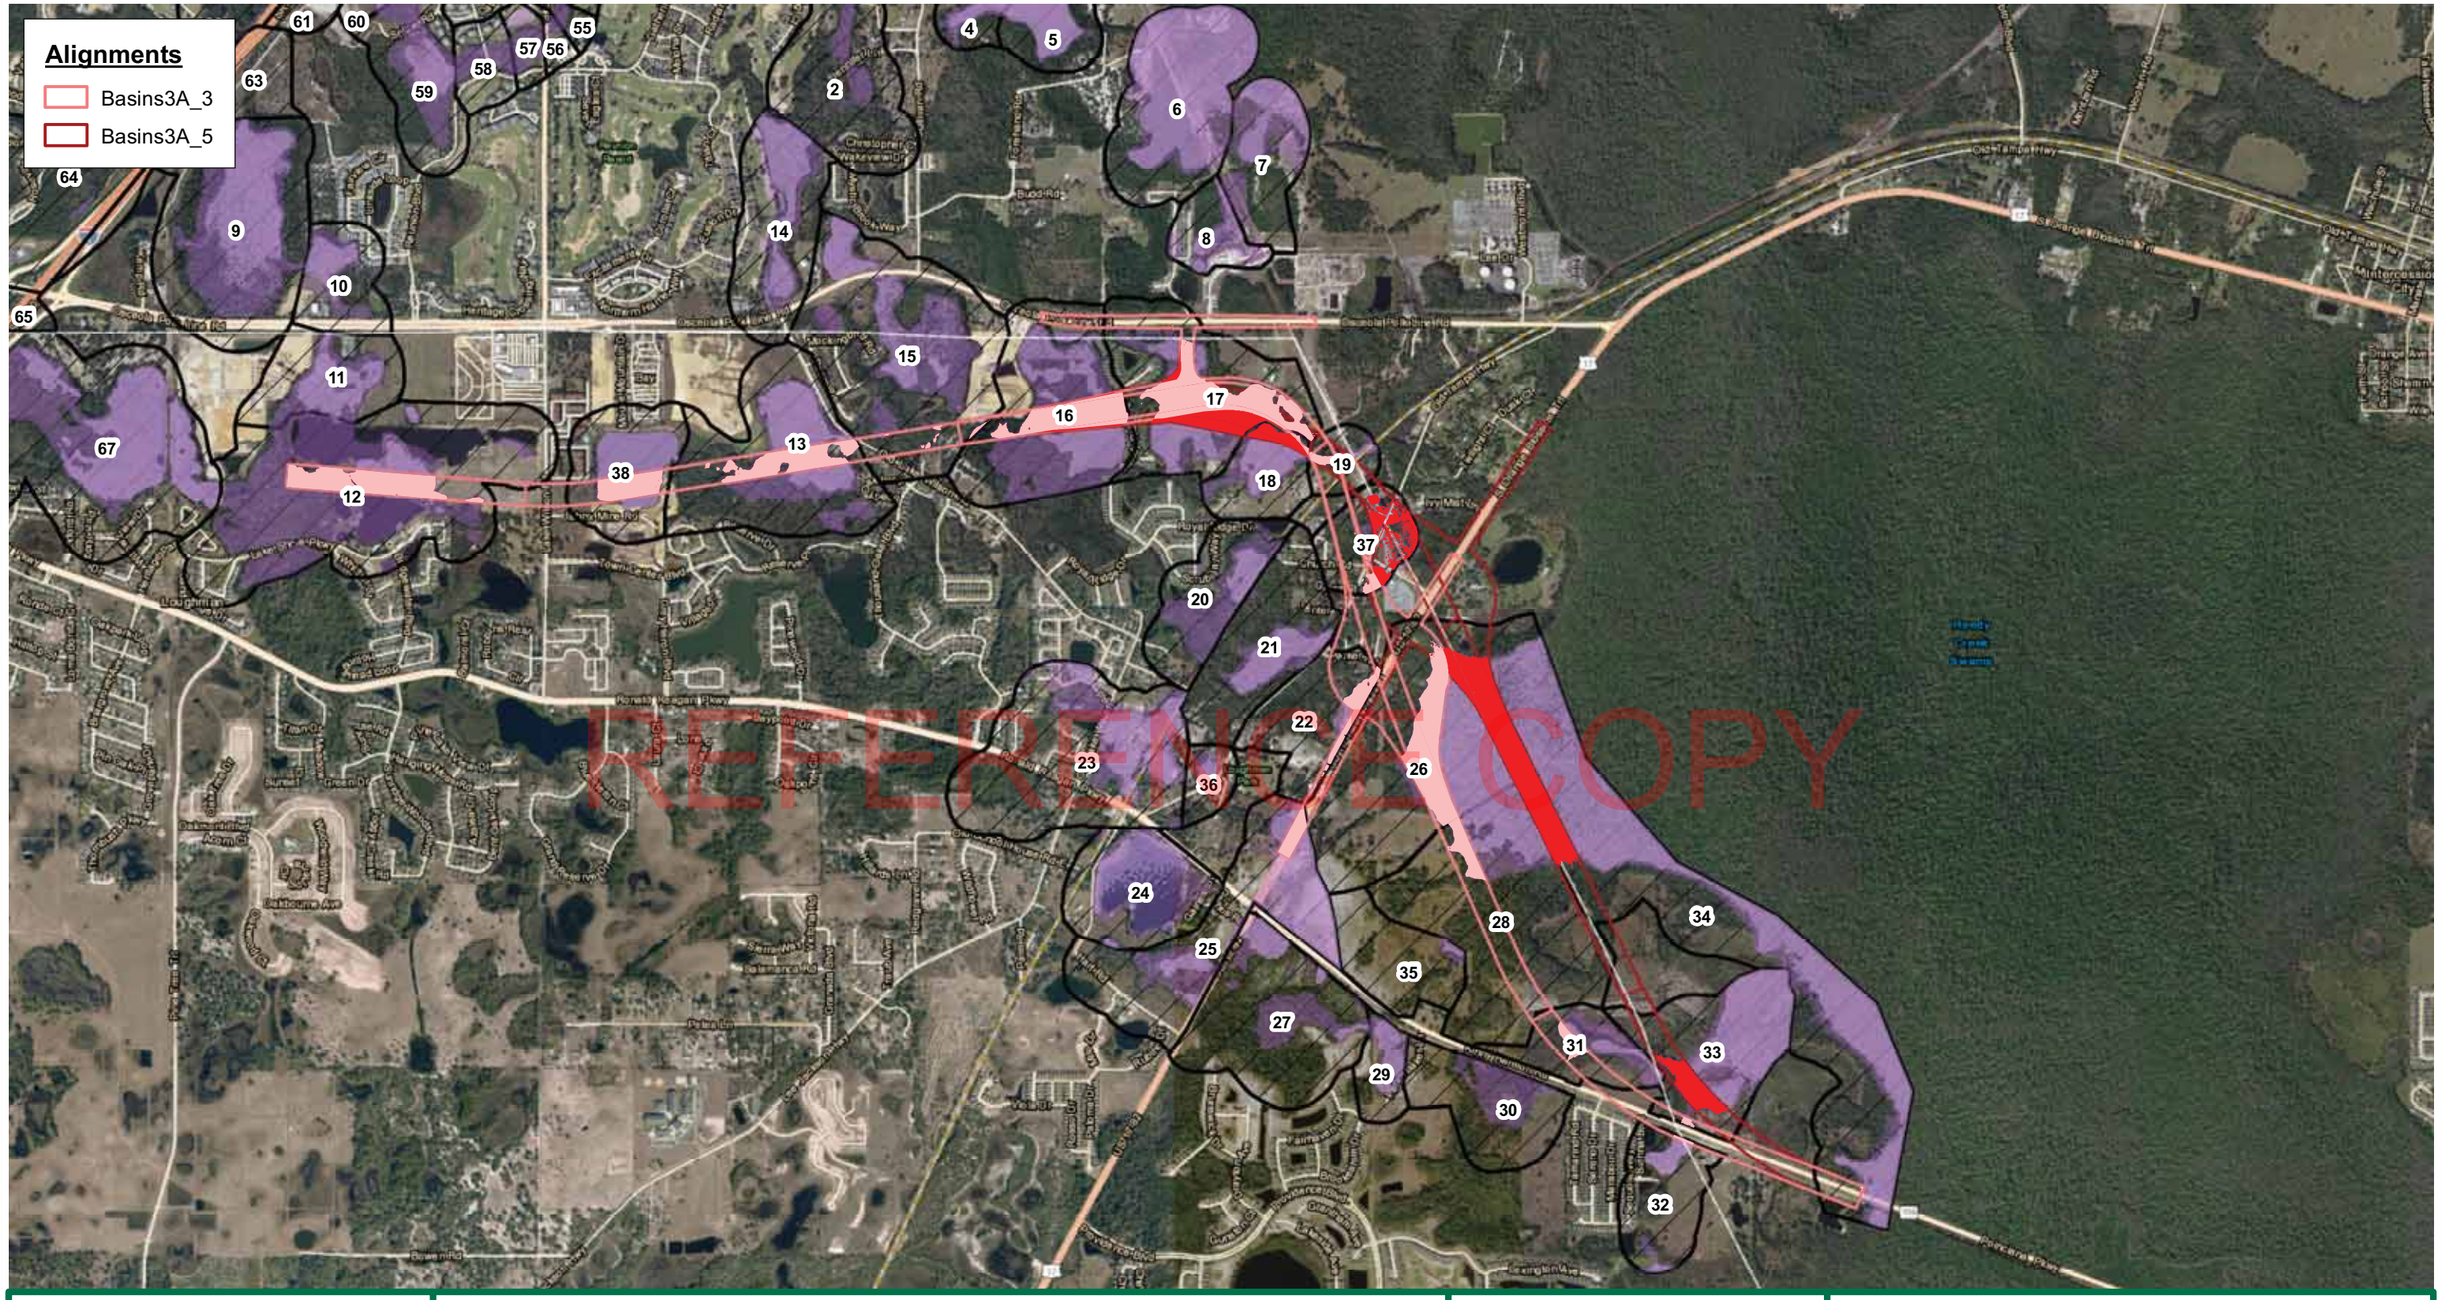
Alignments
Basins3A_3
Basins3A_5
61
60
55
57
56
58
63
59
4
5
2
6
7
64
9
14
8
10
65
15
11
17
16
67
13
19
38
18
12
37
20
21
22
23
26
36
24
28
34
25
35
27
31
33
29
30
32
Bass Pro Blvd
Buck Rd
Old Tampa Hwy
Ronald Reagan Pkwy
Loughman
Lake Marion Creek Dr

Project: CFX Feasibility Study: I-4 / Poinciana Parkway Connector
County: Osceola & Polk

Notes:
(1) Attenuation volume zero if pre CN is greater than post CN (may occur due to existing water/wetland features)
(2) Interchange CN does not account for wet infield ponds. Open Space CN is used for infield areas; this will need to be further refined in PD&E.

Rainfall (25yr/72hr, in) **10.5**

Table A.1 - Attenuation Volume Summary

ALIGNMENT 2A-1

		Existing					Proposed					Results
Basin	**Area (ac)**	**Weighted CN**	**S**	**Ia**	**Runoff (in)**	**Runoff (ac-ft)**	**Weighted CN**	**S**	**Ia**	**Runoff (in)**	**Runoff (ac-ft)**	**Attenuation Volume (ac-ft)**
B2A-1_2	24.31	80.0	2.50	0.50	8.00	16.21	89.3	1.20	0.24	9.19	18.61	2.4
B2A-1_3	27.61	82.8	2.08	0.42	8.36	19.24	89.2	1.21	0.24	9.17	21.11	1.9
B2A-1_3IC	73.63	82.1	2.18	0.44	8.27	50.75	82.3	2.15	0.43	8.30	50.91	0.2
B2A-1_4	49.44	77.6	2.89	0.58	7.68	31.65	81.2	2.31	0.46	8.16	33.60	2.0
B2A-1_5	25.14	90.5	1.05	0.21	9.34	19.57	89.6	1.16	0.23	9.23	19.33	0.0
B2A-1_5IC	17.22	91.6	0.91	0.18	9.48	13.60	79.9	2.51	0.50	7.99	11.46	0.0
B2A-1_6	23.46	85.8	1.65	0.33	8.75	17.11	89.2	1.21	0.24	9.18	17.95	0.8
B2A-1_7	23.94	77.9	2.84	0.57	7.73	15.42	86.2	1.60	0.32	8.79	17.55	2.1

REFERENCE COPY

ALIGNMENT 2A-2

		Existing					Proposed					Results
Basin	**Area (ac)**	**Weighted CN**	**S**	**Ia**	**Runoff (in)**	**Runoff (ac-ft)**	**Weighted CN**	**S**	**Ia**	**Runoff (in)**	**Runoff (ac-ft)**	**Attenuation Volume (ac-ft)**
B2A-2_2	24.31	80.0	2.50	0.50	8.00	16.21	89.3	1.20	0.24	9.19	18.61	2.4
B2A-2_3	27.45	83.5	1.97	0.39	8.45	19.34	89.2	1.21	0.24	9.18	21.00	1.7
B2A-2_3IC	73.83	82.1	2.19	0.44	8.27	50.86	82.3	2.15	0.43	8.30	51.07	0.2
B2A-2_4	26.28	92.0	0.87	0.17	9.52	20.85	89.3	1.19	0.24	9.19	20.13	0.0
B2A-2_4IC	59.68	87.1	1.49	0.30	8.90	44.28	81.1	2.33	0.47	8.15	40.51	0.0
B2A-2_5	33.33	81.1	2.34	0.47	8.14	22.60	87.5	1.43	0.29	8.96	24.89	2.3
B2A-2_Reedy	41.43	93.4	0.71	0.14	9.69	33.46	89.0	1.23	0.25	9.16	31.61	0.0

ALIGNMENT 2A-3

		Existing					Proposed					Results
Basin	Area (ac)	Weighted CN	S	Ia	Runoff (in)	Runoff (ac-ft)	Weighted CN	S	Ia	Runoff (in)	Runoff (ac-ft)	Attenuation Volume (ac-ft)
B2A-3_2	23.57	80.1	2.48	0.50	8.01	15.74	89.1	1.22	0.24	9.17	18.01	2.3
B2A-3_3	27.14	83.5	1.98	0.40	8.45	19.10	89.3	1.20	0.24	9.19	20.78	1.7
B2A-3_3IC	74.11	83.2	2.01	0.40	8.42	51.99	82.4	2.13	0.43	8.32	51.36	0.0
B2A-3_4	22.60	88.1	1.35	0.27	9.04	17.02	89.5	1.17	0.23	9.22	17.35	0.3
B2A-3_4IC	55.35	88.8	1.27	0.25	9.12	42.06	83.0	2.05	0.41	8.39	38.69	0.0
B2A-3_5	38.12	82.4	2.14	0.43	8.31	26.40	87.5	1.43	0.29	8.96	28.46	2.1
B2A-3_Reedy	37.71	91.7	0.90	0.18	9.49	29.82	89.0	1.24	0.25	9.15	28.74	0.0

ALIGNMENT 2A-4

		Existing					Proposed					Results
Basin	Area (ac)	Weighted CN	S	Ia	Runoff (in)	Runoff (ac-ft)	Weighted CN	S	Ia	Runoff (in)	Runoff (ac-ft)	Attenuation Volume (ac-ft)
B2A-4_2	22.81	78.9	2.68	0.54	7.86	14.93	88.7	1.28	0.26	9.11	17.31	2.4
B2A-4_3	23.05	79.6	2.57	0.51	7.95	15.26	89.3	1.20	0.24	9.19	17.65	2.4
B2A-4_3IC	36.19	82.1	2.19	0.44	8.27	24.93	83.2	2.02	0.40	8.41	25.37	0.4
B2A-4_4	31.16	86.6	1.55	0.31	8.85	22.97	89.5	1.17	0.23	9.21	23.91	0.9
B2A-4_4IC	50.66	87.2	1.47	0.29	8.93	37.68	82.7	2.10	0.42	8.35	35.24	0.0
B2A-4_5	38.80	81.4	2.28	0.46	8.18	26.46	87.3	1.45	0.29	8.94	28.90	2.4
B2A-4_Reedy	44.53	96.7	0.34	0.07	10.10	37.48	89.4	1.19	0.24	9.20	34.14	0.0

REFERENCE COPY

ALIGNMENT 2A-5

		Existing					Proposed					Results
Basin	Area (ac)	Weighted CN	S	Ia	Runoff (in)	Runoff (ac-ft)	Weighted CN	S	Ia	Runoff (in)	Runoff (ac-ft)	Attenuation Volume (ac-ft)
B2A-5_2	22.81	78.9	2.68	0.54	7.86	14.93	88.7	1.28	0.26	9.11	17.31	2.4
B2A-5_3	23.15	79.6	2.57	0.51	7.95	15.33	89.3	1.19	0.24	9.19	17.73	2.4
B2A-5_3IC	36.72	82.0	2.19	0.44	8.27	25.29	83.1	2.03	0.41	8.40	25.71	0.4
B2A-5_4	33.89	82.7	2.10	0.42	8.35	23.57	89.2	1.21	0.24	9.18	25.92	2.4
B2A-5_4IC	65.80	88.3	1.33	0.27	9.06	49.66	82.4	2.13	0.43	8.32	45.59	0.0
B2A-5_5	33.67	81.6	2.25	0.45	8.21	23.04	87.9	1.38	0.28	9.01	25.27	2.2
B2A-5_Reedy	43.72	95.4	0.48	0.10	9.95	36.23	89.0	1.24	0.25	9.15	33.33	0.0

ALIGNMENT 3-2N

		Existing					Proposed					Results
Basin	Area (ac)	Weighted CN	S	Ia	Runoff (in)	Runoff (ac-ft)	Weighted CN	S	Ia	Runoff (in)	Runoff (ac-ft)	Attenuation Volume (ac-ft)
B3-2N_1	23.23	64.4	5.54	1.11	5.91	11.44	76.3	3.11	0.62	7.51	14.54	3.1
B3-2N_2	42.90	64.8	5.44	1.09	5.96	21.32	81.9	2.21	0.44	8.25	29.49	8.2
B3-2N_3	27.31	81.4	2.29	0.46	8.18	18.62	91.5	0.93	0.19	9.46	21.53	2.9
B3-2N_4	19.68	84.4	1.84	0.37	8.57	14.05	89.9	1.12	0.22	9.26	15.19	1.1
B3-2N_4IC	22.85	84.2	1.88	0.38	8.54	16.26	84.6	1.82	0.36	8.59	16.36	0.1
B3-2N_5	26.28	92.0	0.87	0.17	9.52	20.86	89.8	1.14	0.23	9.25	20.26	0.0
B3-2N_5IC	49.73	89.3	1.19	0.24	9.19	38.09	86.2	1.60	0.32	8.79	36.44	0.0
B3-2N_6	33.33	81.1	2.34	0.47	8.14	22.60	87.5	1.43	0.29	8.96	24.89	2.3
B3-2N_Reedy	41.43	93.4	0.71	0.14	9.69	33.46	89.1	1.22	0.24	9.16	31.64	0.0

ALIGNMENT 3-2S

		Existing					Proposed					Results
Basin	Area (ac)	Weighted CN	S	Ia	Runoff (in)	Runoff (ac-ft)	Weighted CN	S	Ia	Runoff (in)	Runoff (ac-ft)	Attenuation Volume (ac-ft)
B3-2S_1	32.28	66.1	5.12	1.02	6.15	16.55	77.4	2.91	0.58	7.66	20.62	4.1
B3-2S_2	42.92	67.1	4.90	0.98	6.29	22.49	82.6	2.11	0.42	8.33	29.80	7.3
B3-2S_3	26.80	85.8	1.65	0.33	8.75	19.54	91.4	0.94	0.19	9.45	21.10	1.6
B3-2S_4	19.28	84.0	1.91	0.38	8.51	13.68	89.9	1.13	0.23	9.26	14.88	1.2
B3-2S_4IC	24.41	83.5	1.98	0.40	8.45	17.19	83.8	1.93	0.39	8.49	17.27	0.1
B3-2S_5	26.28	92.0	0.87	0.17	9.52	20.85	89.8	1.14	0.23	9.25	20.26	0.0
B3-2S_5IC	49.74	89.3	1.19	0.24	9.19	38.10	86.2	1.60	0.32	8.79	36.45	0.0
B3-2S_6	33.33	81.1	2.34	0.47	8.14	22.60	87.5	1.43	0.29	8.96	24.89	2.3
B3-2S_Reedy	41.43	93.4	0.71	0.14	9.69	33.46	89.1	1.22	0.24	9.16	31.64	0.0

REFERENCE COPY

ALIGNMENT 3-5N

		Existing					Proposed					Results
Basin	Area (ac)	Weighted CN	S	Ia	Runoff (in)	Runoff (ac-ft)	Weighted CN	S	Ia	Runoff (in)	Runoff (ac-ft)	Attenuation Volume (ac-ft)
B3-5N_1	23.23	64.4	5.54	1.11	5.91	11.44	76.3	3.10	0.62	7.52	14.55	3.1
B3-5N_2	42.90	64.8	5.44	1.09	5.96	21.32	82.2	2.17	0.43	8.28	29.60	8.3
B3-5N_3	29.78	81.5	2.26	0.45	8.20	20.35	91.6	0.92	0.18	9.47	23.50	3.2
B3-5N_4	19.63	80.2	2.46	0.49	8.03	13.14	90.4	1.07	0.21	9.32	15.25	2.1
B3-5N_4IC	17.78	81.3	2.29	0.46	8.17	12.11	83.1	2.04	0.41	8.40	12.44	0.3
B3-5N_5	17.47	83.5	1.97	0.39	8.46	12.31	90.2	1.09	0.22	9.30	13.53	1.2
B3-5N_5IC	42.98	87.4	1.44	0.29	8.95	32.07	86.0	1.62	0.32	8.77	31.43	0.0
B3-5N_6	33.67	81.6	2.25	0.45	8.21	23.04	87.9	1.38	0.28	9.01	25.27	2.2
B3-5N_Reedy	43.72	95.4	0.48	0.10	9.95	36.23	89.1	1.22	0.24	9.17	33.39	0.0

ALIGNMENT 3-5S

		Existing					Proposed					Results
Basin	Area (ac)	Weighted CN	S	Ia	Runoff (in)	Runoff (ac-ft)	Weighted CN	S	Ia	Runoff (in)	Runoff (ac-ft)	Attenuation Volume (ac-ft)
B3-5S_1	32.28	66.1	5.12	1.02	6.15	16.55	78.3	2.78	0.56	7.77	20.91	4.4
B3-5S_2	42.92	67.1	4.90	0.98	6.29	22.49	83.4	1.99	0.40	8.44	30.20	7.7
B3-5S_3	27.15	86.0	1.63	0.33	8.77	19.83	91.5	0.93	0.19	9.47	21.42	1.6
B3-5S_4	21.34	80.7	2.40	0.48	8.09	14.38	89.9	1.13	0.23	9.26	16.46	2.1
B3-5S_4IC	21.21	81.2	2.32	0.46	8.15	14.40	82.9	2.07	0.41	8.37	14.79	0.4
B3-5S_5	17.47	83.5	1.97	0.39	8.46	12.31	90.2	1.09	0.22	9.30	13.54	1.2
B3-5S_5IC	42.99	87.4	1.44	0.29	8.95	32.07	86.0	1.62	0.32	8.77	31.43	0.0
B3-5S_6	33.67	81.6	2.25	0.45	8.21	23.04	87.9	1.38	0.28	9.01	25.28	2.2
B3-5S_Reedy	43.72	95.4	0.48	0.10	9.95	36.23	89.1	1.22	0.24	9.17	33.39	0.0

REFERENCE COPY

ALIGNMENT 3A-3

		Existing					Proposed					Results
Basin	Area (ac)	Weighted CN	S	Ia	Runoff (in)	Runoff (ac-ft)	Weighted CN	S	Ia	Runoff (in)	Runoff (ac-ft)	Attenuation Volume (ac-ft)
B3A-3_1	25.36	74.6	3.41	0.68	7.29	15.40	80.3	2.46	0.49	8.04	16.99	1.6
B3A-3_2	46.72	82.9	2.06	0.41	8.38	32.62	81.5	2.27	0.45	8.20	31.91	0.0
B3A-3_3	40.59	89.6	1.16	0.23	9.22	31.19	90.3	1.08	0.22	9.31	31.48	0.3
B3A-3_3IC	28.34	87.7	1.41	0.28	8.98	21.22	82.7	2.09	0.42	8.35	19.72	0.0
B3A-3_4	25.10	84.4	1.85	0.37	8.56	17.91	89.3	1.20	0.24	9.19	19.22	1.3
B3A-3_4IC	64.00	90.5	1.05	0.21	9.34	49.80	82.6	2.10	0.42	8.34	44.47	0.0
B3A-3_5	39.60	80.5	2.42	0.48	8.07	26.62	87.3	1.45	0.29	8.94	29.51	2.9
B3A-3_Reedy	39.91	95.5	0.47	0.09	9.95	33.11	89.0	1.24	0.25	9.14	30.41	0.0

ALIGNMENT 3A-5

		Existing					Proposed					Results
Basin	Area (ac)	Weighted CN	S	Ia	Runoff (in)	Runoff (ac-ft)	Weighted CN	S	Ia	Runoff (in)	Runoff (ac-ft)	Attenuation Volume (ac-ft)
B3A-5_1	25.36	74.6	3.41	0.68	7.29	15.40	80.3	2.46	0.49	8.04	16.99	1.6
B3A-5_2	46.72	82.9	2.06	0.41	8.38	32.62	81.5	2.27	0.45	8.20	31.91	0.0
B3A-5_3	38.36	90.2	1.09	0.22	9.30	29.72	89.6	1.16	0.23	9.23	29.50	0.0
B3A-5_3IC	35.34	87.8	1.39	0.28	8.99	26.49	83.1	2.03	0.41	8.41	24.75	0.0
B3A-5_4	24.57	83.7	1.94	0.39	8.48	17.36	89.4	1.19	0.24	9.19	18.82	1.5
B3A-5_4IC	66.75	88.4	1.32	0.26	9.07	50.44	82.6	2.11	0.42	8.33	46.36	0.0
B3A-5_5	33.67	81.6	2.25	0.45	8.21	23.04	87.9	1.38	0.28	9.01	25.27	2.2
B3A-5_Reedy	43.72	95.4	0.48	0.10	9.95	36.23	88.9	1.24	0.25	9.14	33.31	0.0

I-4 INTERCHANGE ALTERNATIVES

		Existing					Proposed					Results
Basin	Area (ac)	Weighted CN	S	Ia	Runoff (in)	Runoff (ac-ft)	Weighted CN	S	Ia	Runoff (in)	Runoff (ac-ft)	Attenuation Volume (ac-ft)
B532_ALT1A	192.72	77.9	2.84	0.57	7.73	124.10	76.6	3.05	0.61	7.56	121.40	0.0
B532_ALT2	187.19	77.1	2.97	0.59	7.62	118.83	76.4	3.10	0.62	7.52	117.37	0.0
B532_ALT3	194.13	79.4	2.60	0.52	7.92	128.12	77.3	2.93	0.59	7.65	123.80	0.0
B429_ALT3	406.63	72.7	3.75	0.75	7.04	238.62	76.7	3.04	0.61	7.57	256.50	17.9
B429_ALT4	358.92	74.1	3.50	0.70	7.22	215.95	77.7	2.87	0.57	7.70	230.38	14.4

REFERENCE COPY

Project: CFX Feasibility Study: I-4 / Poinciana Parkway Connector
County: Osceola & Polk

Table A.2 - Treatment Volume Summary - Assumes Wet Detention Ponds

ALIGNMENT 2A-1

Basin	Area (ac)	Existing Impervious Area (ac)	Proposed Impervious Area (ac)	Treatment Volume - Basin (ac-ft)	Treatment Volume - Impervious Area (ac-ft)	Treatment Volume Required (ac-ft)	Additional 50% Treatment Volume (ac-ft)
B2A-1_2	24.31	0.0	12.6	2.0	2.6	2.6	3.9
B2A-1_3	27.61	0.2	14.1	2.3	2.9	2.9	4.3
B2A-1_3IC	73.63	3.2	9.5	6.1	1.3	6.1	9.2
B2A-1_4	49.44	1.4	24.6	4.1	4.8	4.8	7.2
B2A-1_5	25.14	0.0	13.4	2.1	2.8	2.8	4.2
B2A-1_5IC	17.22	1.1	2.8	1.4	0.4	1.4	2.2
B2A-1_6	23.46	0.0	12.0	2.0	2.5	2.5	3.8
B2A-1_7	23.94	2.6	11.5	2.0	1.9	2.0	3.0

ALIGNMENT 2A-2

Basin	Area (ac)	Existing Impervious Area (ac)	Proposed Impervious Area (ac)	Treatment Volume - Basin (ac-ft)	Treatment Volume - Impervious Area (ac-ft)	Treatment Volume Required (ac-ft)	Additional 50% Treatment Volume (ac-ft)
B2A-2_2	24.31	0.0	12.6	2.0	2.6	2.6	3.9
B2A-2_3	27.45	0.2	14.1	2.3	2.9	2.9	4.3
B2A-2_3IC	73.83	3.2	9.5	6.2	1.3	6.2	9.2
B2A-2_4	26.28	0.2	13.6	2.2	2.8	2.8	4.2
B2A-2_4IC	59.68	3.8	8.9	5.0	1.1	5.0	7.5
B2A-2_5	33.33	1.8	16.0	2.8	3.0	3.0	4.5
B2A-2_Reedy	41.43	0.0	20.8	3.5	4.3	4.3	6.5

REFERENCE COPY

ALIGNMENT 2A-3

Basin	Area (ac)	Existing Impervious Area (ac)	Proposed Impervious Area (ac)	Treatment Volume - Basin (ac-ft)	Treatment Volume - Impervious Area (ac-ft)	Treatment Volume Required (ac-ft)	Additional 50% Treatment Volume (ac-ft)
B2A-3_2	23.57	0.0	12.0	2.0	2.5	2.5	3.7
B2A-3_3	27.14	0.2	14.0	2.3	2.9	2.9	4.3
B2A-3_3IC	74.11	3.6	10.0	6.2	1.3	6.2	9.3
B2A-3_4	22.60	0.3	12.0	1.9	2.4	2.4	3.7
B2A-3_4IC	55.35	4.7	9.2	4.6	0.9	4.6	6.9
B2A-3_5	38.12	2.2	18.4	3.2	3.4	3.4	5.0
B2A-3_Reedy	37.71	0.0	18.8	3.1	3.9	3.9	5.9

ALIGNMENT 2A-4

Basin	Area (ac)	Existing Impervious Area (ac)	Proposed Impervious Area (ac)	Treatment Volume - Basin (ac-ft)	Treatment Volume - Impervious Area (ac-ft)	Treatment Volume Required (ac-ft)	Additional 50% Treatment Volume (ac-ft)
B2A-4_2	22.81	0.0	11.0	1.9	2.3	2.3	3.4
B2A-4_3	23.05	0.1	11.9	1.9	2.5	2.5	3.7
B2A-4_3IC	36.19	2.8	6.4	3.0	0.7	3.0	4.5
B2A-4_4	31.16	0.5	16.6	2.6	3.3	3.3	5.0
B2A-4_4IC	50.66	2.8	7.5	4.2	1.0	4.2	6.3
B2A-4_5	38.80	2.7	18.7	3.2	3.3	3.3	5.0
B2A-4_Reedy	44.53	0.0	0.0	3.7	0.0	3.7	5.6

ALIGNMENT 2A-5

Basin	Area (ac)	Existing Impervious Area (ac)	Proposed Impervious Area (ac)	Treatment Volume - Basin (ac-ft)	Treatment Volume - Impervious Area (ac-ft)	Treatment Volume Required (ac-ft)	Additional 50% Treatment Volume (ac-ft)
B2A-5_2	22.81	0.0	11.0	1.9	2.3	2.3	3.4
B2A-5_3	23.15	0.1	12.0	1.9	2.5	2.5	3.7
B2A-5_3IC	36.72	2.8	6.3	3.1	0.7	3.1	4.6
B2A-5_4	33.89	0.4	17.4	2.8	3.5	3.5	5.3
B2A-5_4IC	65.80	3.0	8.9	5.5	1.2	5.5	8.2
B2A-5_5	33.67	1.8	16.2	2.8	3.0	3.0	4.5
B2A-5_Reedy	43.72	0.0	21.8	3.6	4.5	4.5	6.8

REFERENCE COPY

ALIGNMENT 3-2N

Basin	Area (ac)	Existing Impervious Area (ac)	Proposed Impervious Area (ac)	Treatment Volume - Basin (ac-ft)	Treatment Volume - Impervious Area (ac-ft)	Treatment Volume Required (ac-ft)	Additional 50% Treatment Volume (ac-ft)
B3-2N_1	23.23	6.5	14.6	1.9	1.7	1.9	2.9
B3-2N_2	42.90	4.3	27.7	3.6	4.9	4.9	7.3
B3-2N_3	27.31	2.4	17.4	2.3	3.1	3.1	4.7
B3-2N_4	19.68	0.0	10.8	1.6	2.3	2.3	3.4
B3-2N_4IC	22.85	1.9	4.0	1.9	0.4	1.9	2.9
B3-2N_5	26.28	0.2	14.3	2.2	2.9	2.9	4.4
B3-2N_5IC	49.73	3.8	8.3	4.1	0.9	4.1	6.2
B3-2N_6	33.33	1.8	16.0	2.8	3.0	3.0	4.5
B3-2N_Reedy	41.43	0.0	21.0	3.5	4.4	4.4	6.6

ALIGNMENT 3-2S

Basin	Area (ac)	Existing Impervious Area (ac)	Proposed Impervious Area (ac)	Treatment Volume - Basin (ac-ft)	Treatment Volume - Impervious Area (ac-ft)	Treatment Volume Required (ac-ft)	Additional 50% Treatment Volume (ac-ft)
B3-2S_1	32.28	8.6	20.7	2.7	2.5	2.7	4.0
B3-2S_2	42.92	3.9	27.7	3.6	5.0	5.0	7.4
B3-2S_3	26.80	2.1	17.0	2.2	3.1	3.1	4.6
B3-2S_4	19.28	0.0	11.0	1.6	2.3	2.3	3.4
B3-2S_4IC	24.41	2.1	4.3	2.0	0.5	2.0	3.1
B3-2S_5	26.28	0.2	14.3	2.2	2.9	2.9	4.4
B3-2S_5IC	49.74	3.8	8.3	4.1	0.9	4.1	6.2
B3-2S_6	33.33	1.8	16.0	2.8	3.0	3.0	4.5
B3-2S_Reedy	41.43	0.0	21.0	3.5	4.4	4.4	6.6

ALIGNMENT 3-5N

Basin	Area (ac)	Existing Impervious Area (ac)	Proposed Impervious Area (ac)	Treatment Volume - Basin (ac-ft)	Treatment Volume - Impervious Area (ac-ft)	Treatment Volume Required (ac-ft)	Additional 50% Treatment Volume (ac-ft)
B3-5N_1	23.23	6.5	14.6	1.9	1.7	1.9	2.9
B3-5N_2	42.90	4.3	27.8	3.6	4.9	4.9	7.4
B3-5N_3	29.78	3.0	19.2	2.5	3.4	3.4	5.1
B3-5N_4	19.63	0.0	11.3	1.6	2.4	2.4	3.5
B3-5N_4IC	17.78	1.6	3.2	1.5	0.3	1.5	2.2
B3-5N_5	17.47	0.3	9.9	1.5	2.0	2.0	3.0
B3-5N_5IC	42.98	3.2	7.2	3.6	0.8	3.6	5.4
B3-5N_6	33.67	1.8	16.2	2.8	3.0	3.0	4.5
B3-5N_Reedy	43.72	0.0	22.2	3.6	4.6	4.6	6.9

REFERENCE COPY

ALIGNMENT 3-5S

Basin	Area (ac)	Existing Impervious Area (ac)	Proposed Impervious Area (ac)	Treatment Volume - Basin (ac-ft)	Treatment Volume - Impervious Area (ac-ft)	Treatment Volume Required (ac-ft)	Additional 50% Treatment Volume (ac-ft)
B3-5S_1	32.28	8.6	21.1	2.7	2.6	2.7	4.0
B3-5S_2	42.92	3.9	28.4	3.6	5.1	5.1	7.7
B3-5S_3	27.15	2.5	17.4	2.3	3.1	3.1	4.7
B3-5S_4	21.34	0.0	11.7	1.8	2.4	2.4	3.6
B3-5S_4IC	21.21	1.9	3.8	1.8	0.4	1.8	2.7
B3-5S_5	17.47	0.3	9.9	1.5	2.0	2.0	3.0
B3-5S_5IC	42.99	3.2	7.2	3.6	0.8	3.6	5.4
B3-5S_6	33.67	1.8	16.2	2.8	3.0	3.0	4.5
B3-5S_Reedy	43.72	0.0	22.2	3.6	4.6	4.6	6.9

ALIGNMENT 3A-3

Basin	Area (ac)	Existing Impervious Area (ac)	Proposed Impervious Area (ac)	Treatment Volume - Basin (ac-ft)	Treatment Volume - Impervious Area (ac-ft)	Treatment Volume Required (ac-ft)	Additional 50% Treatment Volume (ac-ft)
B3A-3_1	25.36	0.0	12.2	2.1	2.5	2.5	3.8
B3A-3_2	46.72	0.0	22.5	3.9	4.7	4.7	7.0
B3A-3_3	40.59	0.0	23.4	3.4	4.9	4.9	7.3
B3A-3_3IC	28.34	3.0	4.3	2.4	0.3	2.4	3.5
B3A-3_4	25.10	0.3	13.0	2.1	2.6	2.6	3.9
B3A-3_4IC	64.00	4.2	9.5	5.3	1.1	5.3	8.0
B3A-3_5	39.60	3.1	19.1	3.3	3.3	3.3	5.0
B3A-3_Reedy	39.91	0.0	0.0	3.3	0.0	3.3	5.0

ALIGNMENT 3A-5

Basin	Area (ac)	Existing Impervious Area (ac)	Proposed Impervious Area (ac)	Treatment Volume - Basin (ac-ft)	Treatment Volume - Impervious Area (ac-ft)	Treatment Volume Required (ac-ft)	Additional 50% Treatment Volume (ac-ft)
B3A-5_1	25.36	0.0	12.2	2.1	2.5	2.5	3.8
B3A-5_2	46.72	0.0	22.5	3.9	4.7	4.7	7.0
B3A-5_3	38.36	0.0	20.8	3.2	4.3	4.3	6.5
B3A-5_3IC	35.34	3.0	6.2	2.9	0.7	2.9	4.4
B3A-5_4	24.57	0.3	12.8	2.0	2.6	2.6	3.9
B3A-5_4IC	66.75	3.2	9.3	5.6	1.3	5.6	8.3
B3A-5_5	33.67	1.8	16.2	2.8	3.0	3.0	4.5
B3A-5_Reedy	43.72	0.0	21.7	3.6	4.5	4.5	6.8

REFERENCE COPY

I-4 INTERCHANGE ALTERNATIVES

Basin	Area (ac)	Existing Impervious Area (ac)	Proposed Impervious Area (ac)	Treatment Volume - Basin (ac-ft)	Treatment Volume - Impervious Area (ac-ft)	Treatment Volume Required[(1)] (ac-ft)	Additional 50% Treatment Volume (ac-ft)
B532_ALT1A	192.72	74.3	98.1	16.1	5.0	5.0	7.4
B532_ALT2	187.19	72.2	92.4	15.6	4.2	4.2	6.3
B532_ALT3	194.13	66.5	92.3	16.2	5.4	5.4	8.1
B429_ALT3	406.63	109.6	188.3	33.9	16.4	16.4	24.6
B429_ALT4	358.92	104.1	165.8	29.9	12.8	12.8	19.3

(1) Assume additional impervious area governs due to previous BTU interchange stormwater ponds in place

Project: CFX Feasibility Study: I-4 / Poinciana Parkway Connector
County: Osceola & Polk

Table A.3 - Floodplain Impacts

ALIGNMENT 2A-1

Basin	Floodplain Impact IDs	Floodplain Impacts Total (ac-ft)
B2A-1_2	6,8	14.6
B2A-1_3	17,18	9.2
B2A-1_3IC	6,7,8,17	14.3
B2A-1_4	20,21,23,24,25	10.1
B2A-1_5	27,29	12.0
B2A-1_5IC	25,27	9.7
B2A-1_6	30	9.1
B2A-1_7	32	0.5

Total Volume Impact	**79 ac-ft**
Total 100-yr Area Impact	**67 ac**

REFERENCE COPY

ALIGNMENT 2A-2

Basin	Floodplain Impact IDs	Floodplain Impacts Total (ac-ft)
B2A-2_2	6,8	14.6
B2A-2_3	17,18	12.4
B2A-2_3IC	6,7,8,17	16.5
B2A-2_4	21,22	7.8
B2A-2_4IC	21,22,25,26	19.7
B2A-2_5	33	5.7
B2A-2_Reedy	26,28	15.0

Total Volume Impact	**92 ac-ft**
Total 100-yr Area Impact	**73 ac**

ALIGNMENT 2A-3

Basin	Floodplain Impact IDs	Floodplain Impacts Total (ac-ft)
B2A-3_2	6,8	12.6
B2A-3_3	17,18	22.1
B2A-3_3IC	8,17,18	22.7
B2A-3_4	21,22	3.0
B2A-3_4IC	21,22,25,26	12.3
B2A-3_5	31,33	13.7
B2A-3_Reedy	26	1.6

Total Volume Impact	**88 ac-ft**
Total 100-yr Area Impact	**61 ac**

ALIGNMENT 2A-4

Basin	Floodplain Impact IDs	Floodplain Impacts Total (ac-ft)
B2A-4_2	6,7	17.5
B2A-4_3	--	0.0
B2A-4_3IC	--	0.0
B2A-4_4	--	0.0
B2A-4_4IC	22,26,34,37	10.9
B2A-4_5	31,33	8.6
B2A-4_Reedy	26,28	21.0

REFERENCE COPY

Total Volume Impact	**58 ac-ft**
Total 100-yr Area Impact	**48 ac**

ALIGNMENT 2A-5

Basin	Floodplain Impact IDs	Floodplain Impacts Total (ac-ft)
B2A-5_2	6,7	17.5
B2A-5_3	--	0.0
B2A-5_3IC	--	0.0
B2A-5_4	37	1.9
B2A-5_4IC	22,26,34,37	7.3
B2A-5_5	33	5.3
B2A-5_Reedy	26,34	12.7

Total Volume Impact	**45 ac-ft**
Total 100-yr Area Impact	**61 ac**

ALIGNMENT 3-2N

Basin	Floodplain Impact IDs	Floodplain Impacts Total (ac-ft)
B3-2N_1	--	0.0
B3-2N_2	15	3.6
B3-2N_3	16	0.6
B3-2N_4	17,18	8.5
B3-2N_4IC	17	1.4
B3-2N_5	21,22	7.7
B3-2N_5IC	21,22,25,26	19.5
B3-2N_6	33	5.7
B3-2N_Reedy	26,28	15.0

Total Volume Impact	**62 ac-ft**
Total 100-yr Area Impact	**62 ac**

ALIGNMENT 3-2S

Basin	Floodplain Impact IDs	Floodplain Impacts Total (ac-ft)
B3-2S_1	11	0.8
B3-2S_2	15	3.9
B3-2S_3	16,17	3.4
B3-2S_4	17,18	12.5
B3-2S_4IC	17	4.9
B3-2S_5	21,22	7.8
B3-2S_5IC	21,22,25,26	19.6
B3-2S_6	33	5.7
B3-2S_Reedy	26,28	15.0

Total Volume Impact	**74 ac-ft**
Total 100-yr Area Impact	**67 ac**

REFERENCE COPY

ALIGNMENT 3-5N

Basin	Floodplain Impact IDs	Floodplain Impacts Total (ac-ft)
B3-5N_1	--	0.0
B3-5N_2	15	3.6
B3-5N_3	16	0.5
B3-5N_4	19	2.3
B3-5N_4IC	19	0.2
B3-5N_5	37	2.0
B3-5N_5IC	22,36,34,37	11.6
B3-5N_6	33	13.5
B3-5N_Reedy	26,34	20.9

Total Volume Impact	**55 ac-ft**
Total 100-yr Area Impact	**51 ac**

ALIGNMENT 3-5S

Basin	Floodplain Impact IDs	Floodplain Impacts Total (ac-ft)
B3-5S_1	11	0.8
B3-5S_2	15	3.9
B3-5S_3	16,17	3.4
B3-5S_4	19	3.0
B3-5S_4IC	19	0.8
B3-5S_5	37	2.0
B3-5S_5IC	22,26,34,37	12.3
B3-5S_6	33	13.5
B3-5S_Reedy	26,34	20.9

Total Volume Impact	**61 ac-ft**
Total 100-yr Area Impact	**56 ac**

REFERENCE COPY

ALIGNMENT 3A-3

Basin	Floodplain Impact IDs	Floodplain Impacts Total (ac-ft)
B3A-3_1	12	24.5
B3A-3_2	13, 15, 38	20.5
B3A-3_3	15, 16,17, 18, 19	19.8
B3A-3_3IC	16,17	10.8
B3A-3_4	19, 22, 26, 37	5.7
B3A-3_4IC	22,25,26,37	18.6
B3A-3_5	31, 32, 33, 34	3.1
B3A-3_Reedy	26,28	10.6

Total Volume Impact	**114 ac-ft**
Total 100-yr Area Impact	**107 ac**

ALIGNMENT 3A-5

Basin	Floodplain Impact IDs	Floodplain Impacts Total (ac-ft)
B3A-5_1	12	24.5
B3A-5_2	13,15,38	20.5
B3A-5_3	15 - 19	23.9
B3A-5_3IC	16,17,18	16.6
B3A-5_4	17, 19, 37	9.7
B3A-5_4IC	17-19, 22,26,28, 34,37	19.2
B3A-5_5	33, 34	13.5
B3A-5_Reedy	26,28,34	20.9

Total Volume Impact	**149 ac-ft**
Total 100-yr Area Impact	**125 ac**

REFERENCE COPY

I-4 INTERCHANGE ALTERNATIVES

Basin	Floodplain Impact IDs	Floodplain Impacts Total (ac-ft)	Total 100-yr Area Impact (ac)
B532_ALT1A	9,10,61,62,63,64,65,66,67,68	**17**	**15**
B532_ALT2	61,62,63,64,65,66,67	**15**	**14**
B532_ALT3	12,61,62,63,64,65,66,67	**29**	**32**
B429_ALT3	1,2,3,4,5,39,40,41,42,43,46,48,49,50,61,62,63	**149**	**59**
B429_ALT4	1,3,4,5,39,40,43,44,45,46,47,48,49,50,61,62,63	**97**	**41**

REFERENCE COPY

Project: CFX Feasibility Study: I-4 / Poinciana Parkway Connector
County: Osceola & Polk

Table A.4 - Pond Sizing Calculations

Alternative 2A-1 MAINLINE

Basin	Required Volume	Additional Percent for Landscaping / Maintenance Berm	Design Depth	Required Pond Area*
	ac-ft	pct	ft	ac
B2A-1_2	20.9	20%	3	9.0
B2A-1_3	15.4	20%	3	6.7
B2A-1_4	19.3	20%	3	8.3
B2A-1_5	16.2	20%	3	7.0
B2A-1_6	13.7	20%	3	6.0
B2A-1_7	5.6	20%	3	2.6

*Top of pond bank, Assumes 1 foot of freeboard, Assumes square shape, 4:1 slopes

Alternative 2A-1 INTERCHANGES

Basin	Interchange Location	Required Volume	Additional Percent for Landscaping / Maintenance Berm	Design Depth	Required Pond Area*	Available Infield Pond Area	Required Pond Area Outside of Infield
		ac-ft	pct	ft	ac	ac	ac
B2A-1_3IC	Osceola Polk Line Rd	23.7	20%	3	10.1	30.2	0.0
B2A-1_5IC	US 17-92	11.9	20%	3	5.2	2.8	2.4

*Top of pond bank, Assumes 1 foot of freeboard, Assumes square shape, 4:1 slopes

REFERENCE COPY

ALIGNMENT 2A_2 MAINLINE

Basin	Required Volume	Additional Percent for Landscaping / Maintenance Berm	Design Depth	Required Pond Area*
	ac-ft	pct	ft	ac
B2A-2_2	20.9	20%	3	9.0
B2A-2_3	18.4	20%	3	7.9
B2A-2_4	12.0	20%	3	5.3
B2A-2_5	12.5	20%	3	5.5
B2A-2_Reedy	21.5	20%	3	9.2

*Top of pond bank, Assumes 1 foot of freeboard, Assumes square shape, 4:1 slopes

ALIGNMENT 2A_2 INTERCHANGES

Basin	Interchange Location	Required Volume	Additional Percent for Landscaping / Maintenance Berm	Design Depth	Required Pond Area*	Available Infield Pond Area	Required Pond Area Outside of Infield
		ac-ft	pct	ft	ac	ac	ac
B2A-2_3IC	Osceola Polk Line Rd	25.9	20%	3	11.0	30.3	0.0
B2A-2_4IC	US 17-92	27.2	20%	3	11.6	24.0	0.0

*Top of pond bank, Assumes 1 foot of freeboard, Assumes square shape, 4:1 slopes

ALIGNMENT 2A_3 MAINLINE

Basin	Required Volume	Additional Percent for Landscaping / Maintenance Berm	Design Depth	Required Pond Area*
	ac-ft	pct	ft	ac
B2A-3_2	18.6	20%	3	8.0
B2A-3_3	28.1	20%	3	12.0
B2A-3_4	7.0	20%	3	3.2
B2A-3_5	20.8	20%	3	8.9
B2A-3_Reedy	7.5	20%	3	3.4

*Top of pond bank, Assumes 1 foot of freeboard, Assumes square shape, 4:1 slopes

ALIGNMENT 2A_3 INTERCHANGES

Basin	Interchange Location	Required Volume	Additional Percent for Landscaping / Maintenance Berm	Design Depth	Required Pond Area*	Available Infield Pond Area	Required Pond Area Outside of Infield
		ac-ft	pct	ft	ac	ac	ac
B2A-3_3IC	Osceola Polk Line Rd	32.0	20%	3	13.6	31.4	0.0
B2A-3_4IC	US 17-92	19.2	20%	3	8.3	18.0	0.0

*Top of pond bank, Assumes 1 foot of freeboard, Assumes square shape, 4:1 slopes

ALIGNMENT 2A_4 MAINLINE

REFERENCE COPY

Basin	Required Volume	Additional Percent for Landscaping / Maintenance Berm	Design Depth	Required Pond Area*
	ac-ft	pct	ft	ac
B2A-4_2	23.3	20%	3	10.0
B2A-4_3	6.1	20%	3	2.8
B2A-4_4	5.9	20%	3	2.7
B2A-4_5	16.0	20%	3	6.9
B2A-4_Reedy	26.6	20%	3	11.3

*Top of pond bank, Assumes 1 foot of freeboard, Assumes square shape, 4:1 slopes

ALIGNMENT 2A_4 INTERCHANGES

Basin	Interchange Location	Required Volume	Additional Percent for Landscaping / Maintenance Berm	Design Depth	Required Pond Area*	Available Infield Pond Area	Required Pond Area Outside of Infield
		ac-ft	pct	ft	ac	ac	ac
B2A-4_3IC	Osceola Polk Line Rd	4.9	20%	3	2.3	10.2	0.0
B2A-4_4IC	US 17-92	17.2	20%	3	7.4	16.9	0.0

*Top of pond bank, Assumes 1 foot of freeboard, Assumes square shape, 4:1 slopes

ALIGNMENT 2A_5 MAINLINE

Basin	Required Volume	Additional Percent for Landscaping / Maintenance Berm	Design Depth	Required Pond Area*
	ac-ft	pct	ft	ac
B2A-5_2	23.3	20%	3	10.0
B2A-5_3	6.1	20%	3	2.8
B2A-5_4	9.6	20%	3	4.3
B2A-5_5	12.0	20%	3	5.3
B2A-5_Reedy	19.5	20%	3	8.4

*Top of pond bank, Assumes 1 foot of freeboard, Assumes square shape, 4:1 slopes

ALIGNMENT 2A_5 INTERCHANGES

Basin	Interchange Location	Required Volume	Additional Percent for Landscaping / Maintenance Berm	Design Depth	Required Pond Area*	Available Infield Pond Area	Required Pond Area Outside of Infield
		ac-ft	pct	ft	ac	ac	ac
B2A-5_3IC	Osceola Polk Line Rd	5.0	20%	3	2.3	10.6	0.0
B2A-5_4IC	US 17-92	15.5	20%	3	6.7	28.9	0.0

*Top of pond bank, Assumes 1 foot of freeboard, Assumes square shape, 4:1 slopes

ALIGNMENT 3_2N MAINLINE

REFERENCE COPY

Basin	Required Volume	Additional Percent for Landscaping / Maintenance Berm	Design Depth	Required Pond Area*
	ac-ft	pct	ft	ac
B3-2N_1	6.0	20%	3	2.7
B3-2N_2	19.1	20%	3	8.2
B3-2N_3	8.2	20%	3	3.7
B3-2N_4	13.0	20%	3	5.7
B3-2N_5	12.1	20%	3	5.3
B3-2N_6	12.5	20%	3	5.5
B3-2N_Reedy	21.6	20%	3	9.3

*Top of pond bank, Assumes 1 foot of freeboard, Assumes square shape, 4:1 slopes

ALIGNMENT 3_2N INTERCHANGES

Basin	Interchange Location	Required Volume	Additional Percent for Landscaping / Maintenance Berm	Design Depth	Required Pond Area*	Available Infield Pond Area	Required Pond Area Outside of Infield
		ac-ft	pct	ft	ac	ac	ac
B3-2N_4IC	Osceola Polk Line Rd	4.4	20%	3	2.0	5.3	0.0
B3-2N_5IC	US 17-92	25.7	20%	3	11.0	15.6	0.0

*Top of pond bank, Assumes 1 foot of freeboard, Assumes square shape, 4:1 slopes

ALIGNMENT 3_2S MAINLINE

Basin	Required Volume	Additional Percent for Landscaping / Maintenance Berm	Design Depth	Required Pond Area*
	ac-ft	pct	ft	ac
B3-2S_1	8.9	20%	3	4.0
B3-2S_2	18.6	20%	3	8.0
B3-2S_3	9.6	20%	3	4.3
B3-2S_4	17.1	20%	3	7.4
B3-2S_5	12.2	20%	3	5.4
B3-2S_6	12.5	20%	3	5.5
B3-2S_Reedy	21.6	20%	3	9.3

*Top of pond bank, Assumes 1 foot of freeboard, Assumes square shape, 4:1 slopes

ALIGNMENT 3_2S INTERCHANGES

Basin	Interchange Location	Required Volume	Additional Percent for Landscaping / Maintenance Berm	Design Depth	Required Pond Area*	Available Infield Pond Area	Required Pond Area Outside of Infield
		ac-ft	pct	ft	ac	ac	ac
B3-2S_4IC	Osceola Polk Line Rd	8.1	20%	3	3.6	8.1	0.0
B3-2S_5IC	US 17-92	25.8	20%	3	11.0	15.6	0.0

*Top of pond bank, Assumes 1 foot of freeboard, Assumes square shape, 4:1 slopes

ALIGNMENT 3_5N MAINLINE

REFERENCE COPY

Basin	Required Volume	Additional Percent for Landscaping / Maintenance Berm	Design Depth	Required Pond Area*
	ac-ft	pct	ft	ac
B3-5N_1	6.0	20%	3	2.7
B3-5N_2	19.3	20%	3	8.3
B3-5N_3	8.8	20%	3	3.9
B3-5N_4	7.9	20%	3	3.5
B3-5N_5	6.2	20%	3	2.8
B3-5N_6	20.2	20%	3	8.7
B3-5N_Reedy	27.8	20%	3	11.8

*Top of pond bank, Assumes 1 foot of freeboard, Assumes square shape, 4:1 slopes

ALIGNMENT 3_5N INTERCHANGES

Basin	Interchange Location	Required Volume	Additional Percent for Landscaping / Maintenance Berm	Design Depth	Required Pond Area*	Available Infield Pond Area	Required Pond Area Outside of Infield
		ac-ft	pct	ft	ac	ac	ac
B3-5N_4IC	Osceola Polk Line Rd	2.7	20%	3	1.3	1.0	0.3
B3-5N_5IC	US 17-92	17.0	20%	3	7.4	10.6	0.0

*Top of pond bank, Assumes 1 foot of freeboard, Assumes square shape, 4:1 slopes

ALIGNMENT 3_5S MAINLINE

Basin	Required Volume	Additional Percent for Landscaping / Maintenance Berm	Design Depth	Required Pond Area*
	ac-ft	pct	ft	ac
B3-5S_1	9.2	20%	3	4.1
B3-5S_2	19.3	20%	3	8.3
B3-5S_3	9.7	20%	3	4.3
B3-5S_4	8.7	20%	3	3.9
B3-5S_5	6.2	20%	3	2.8
B3-5S_6	20.2	20%	3	8.7
B3-5S_Reedy	27.8	20%	3	11.8

*Top of pond bank, Assumes 1 foot of freeboard, Assumes square shape, 4:1 slopes

ALIGNMENT 3_5S INTERCHANGES

Basin	Interchange Location	Required Volume	Additional Percent for Landscaping / Maintenance Berm	Design Depth	Required Pond Area*	Available Infield Pond Area	Required Pond Area Outside of Infield
		ac-ft	pct	ft	ac	ac	ac
B3-5S_4IC	Osceola Polk Line Rd	3.9	20%	3	1.8	3.8	0.0
B3-5S_5IC	US 17-92	17.7	20%	3	7.6	10.6	0.0

*Top of pond bank, Assumes 1 foot of freeboard, Assumes square shape, 4:1 slopes

ALIGNMENT 3A_3 MAINLINE

REFERENCE COPY

Basin	Required Volume	Additional Percent for Landscaping / Maintenance Berm	Design Depth	Required Pond Area*
	ac-ft	pct	ft	ac
B3A-3_1	29.9	20%	3	12.7
B3A-3_2	27.5	20%	3	11.7
B3A-3_3	27.4	20%	3	11.7
B3A-3_4	10.9	20%	3	4.8
B3A-3_5	11.0	20%	3	4.9
B3A-3_Reedy	15.6	20%	3	6.8

*Top of pond bank, Assumes 1 foot of freeboard, Assumes square shape, 4:1 slopes

ALIGNMENT 3A_3 INTERCHANGES

Basin	Interchange Location	Required Volume	Additional Percent for Landscaping / Maintenance Berm	Design Depth	Required Pond Area*	Available Infield Pond Area	Required Pond Area Outside of Infield
		ac-ft	pct	ft	ac	ac	ac
B3A-3_3IC	Osceola Polk Line Rd	14.3	20%	3	6.2	0.0	6.2
B3A-3_4IC	US 17-92	26.6	20%	3	11.3	24.3	0.0

*Top of pond bank, Assumes 1 foot of freeboard, Assumes square shape, 4:1 slopes

ALIGNMENT 3A_5 MAINLINE

Basin	Required Volume	Additional Percent for Landscaping / Maintenance Berm	Design Depth	Required Pond Area*
	ac-ft	pct	ft	ac
B3A-5_1	29.9	20%	3	12.7
B3A-5_2	27.5	20%	3	11.7
B3A-5_3	30.4	20%	3	12.9
B3A-5_4	15.1	20%	3	6.6
B3A-5_5	20.2	20%	3	8.7
B3A-5_Reedy	27.7	20%	3	11.8

*Top of pond bank, Assumes 1 foot of freeboard, Assumes square shape, 4:1 slopes

ALIGNMENT 3A_5 INTERCHANGES

Basin	Interchange Location	Required Volume	Additional Percent for Landscaping / Maintenance Berm	Design Depth	Required Pond Area*	Available Infield Pond Area	Required Pond Area Outside of Infield
		ac-ft	pct	ft	ac	ac	ac
B3A-5_3IC	Osceola Polk Line Rd	21.0	20%	3	9.0	1.2	7.8
B3A-5_4IC	US 17-92	27.5	20%	3	11.7	27.0	0.0

*Top of pond bank, Assumes 1 foot of freeboard, Assumes square shape, 4:1 slopes

I-4 INTERCHANGE ALTERNATIVES

REFERENCE COPY

Basin	Interchange Location	Required Volume	Additional Percent for Landscaping / Maintenance Berm	Design Depth	Required Pond Area*	Available Infield Pond Area	Required Pond Area Outside of Infield
		ac-ft	pct	ft	ac	ac	ac
B532_ALT1A	I-4 & SR 532	24.3	20%	3	10.4	0.0	10.4
B532_ALT2	I-4 & SR 532	20.9	20%	3	9.0	0.0	9.0
B532_ALT3	I-4 & SR 532	37.5	20%	3	15.8	0.0	15.8
B429_ALT3	I-4 & SR 429	191.4	20%	3	78.4	0.0	78.4
B429_ALT4	I-4 & SR 429	130.8	20%	3	53.8	0.0	53.8

*Top of pond bank, Assumes 1 foot of freeboard, Assumes square shape, 4:1 slopes

Project: CFX Feasibility Study: I-4 / Poinciana Parkway Connector
County: Osceola & Polk

Table A.5 - Pond Quantity Calculations

Alternative 2A-1 MAINLINE

Basin	Required Volume	Pond Area	PPV	Total Excavation Volume	Total Excavation Volume	Total Sodding
	ac-ft	ac	ac-ft	ac-ft	CY	SY
B2A-1_2	20.9	9.0	67.0	87.9	141,837	11,188
B2A-1_3	15.4	6.7	47.6	63.0	101,631	8,789
B2A-1_4	19.3	8.3	61.3	80.6	130,077	10,500
B2A-1_5	16.2	7.0	50.4	66.6	107,437	9,145
B2A-1_6	13.7	6.0	41.7	55.4	89,350	8,026
B2A-1_7	5.6	2.6	14.6	20.2	32,589	4,125

Alternative 2A-1 INTERCHANGES

Basin	Required Volume	Pond Area	PPV	Total Excavation Volume	Total Excavation Volume	Total Sodding
	ac-ft	ac	ac-ft	ac-ft	CY	SY
B2A-1_3IC	23.7	10.1	77.0	100.7	162,518	12,377
B2A-1_5IC	11.9	5.2	35.5	47.4	76,448	7,202

REFERENCE COPY

Alternative 2A-2 MAINLINE

Basin	Required Volume	Pond Area	PPV	Total Excavation Volume	Total Excavation Volume	Total Sodding
	ac-ft	ac	ac-ft	ac-ft	CY	SY
B2A-2_2	20.9	9.0	67.0	87.9	141,837	11,188
B2A-2_3	18.4	7.9	58.1	76.5	123,484	10,109
B2A-2_4	12.0	5.3	35.8	47.8	77,162	7,249
B2A-2_Reedy	12.5	5.5	37.5	50.0	80,736	7,479
B2A-2_5	21.5	9.2	69.2	90.7	146,258	11,445

Alternative 2A-2 INTERCHANGES

Basin	Required Volume	Pond Area	PPV	Total Excavation Volume	Total Excavation Volume	Total Sodding
	ac-ft	ac	ac-ft	ac-ft	CY	SY
B2A-2_3IC	25.9	11.0	85.0	110.9	178,844	13,300
B2A-2_4IC	27.2	11.6	89.7	116.9	188,520	13,841

Alternative 2A-3 MAINLINE

Basin	Required Volume	Pond Area	PPV	Total Excavation Volume	Total Excavation Volume	Total Sodding
	ac-ft	ac	ac-ft	ac-ft	CY	SY
B2A-3_2	18.6	8.0	58.8	77.4	124,947	10,196
B2A-3_3	28.1	12.0	92.9	121.0	195,230	14,214
B2A-3_4	7.0	3.2	19.1	26.1	42,087	4,846
B2A-3_Reedy	20.8	8.9	66.7	87.5	141,101	11,145
B2A-3_5	7.5	3.4	20.7	28.2	45,524	5,097

Alternative 2A-3 INTERCHANGES

Basin	Required Volume	Pond Area	PPV	Total Excavation Volume	Total Excavation Volume	Total Sodding
	ac-ft	ac	ac-ft	ac-ft	CY	SY
B2A-3_3IC	32.0	13.6	107.1	139.1	224,403	15,816
B2A-3_4IC	19.2	8.3	61.0	80.2	129,344	10,457

Alternative 2A-4 MAINLINE

Basin	Required Volume	Pond Area	PPV	Total Excavation Volume	Total Excavation Volume	Total Sodding
	ac-ft	ac	ac-ft	ac-ft	CY	SY
B2A-4_2	23.3	10.0	75.6	98.9	159,556	12,209
B2A-4_3	6.1	2.8	16.2	22.3	35,958	4,386
B2A-4_4	5.9	2.7	15.6	21.5	34,607	4,283
B2A-4_Reedy	16.0	6.9	49.7	65.7	105,984	9,056
B2A-4_5	26.6	11.3	87.5	114.1	184,052	13,592

REFERENCE COPY

Alternative 2A-4 INTERCHANGES

Basin	Required Volume	Pond Area	PPV	Total Excavation Volume	Total Excavation Volume	Total Sodding
	ac-ft	ac	ac-ft	ac-ft	CY	SY
B2A-4_3IC	4.9	2.3	12.4	17.3	27,925	3,752
B2A-4_4IC	17.2	7.4	53.9	71.1	114,718	9,585

Alternative 2A-5 MAINLINE

Basin	Required Volume	Pond Area	PPV	Total Excavation Volume	Total Excavation Volume	Total Sodding
	ac-ft	ac	ac-ft	ac-ft	CY	SY
B2A-5_2	23.3	10.0	75.6	98.9	159,556	12,209
B2A-5_3	6.1	2.8	16.2	22.3	35,958	4,386
B2A-5_4	9.6	4.3	27.7	37.3	60,152	6,122
B2A-5_Reedy	12.0	5.3	35.8	47.8	77,162	7,249
B2A-5_5	19.5	8.4	62.0	81.5	131,545	10,586

Alternative 2A-5 INTERCHANGES

Basin	Required Volume	Pond Area	PPV	Total Excavation Volume	Total Excavation Volume	Total Sodding
	ac-ft	ac	ac-ft	ac-ft	CY	SY
B2A-5_3IC	5.0	2.3	12.7	17.7	28,587	3,806
B2A-5_4IC	15.5	6.7	47.9	63.4	102,356	8,834

Alternative 3-2N MAINLINE

Basin	Required Volume	Pond Area	PPV	Total Excavation Volume	Total Excavation Volume	Total Sodding
	ac-ft	ac	ac-ft	ac-ft	CY	SY
B3-2N_1	6.0	2.7	15.9	21.9	35,282	4,335
B3-2N_2	19.1	8.2	60.6	79.7	128,611	10,413
B3-2N_3	8.2	3.7	23.0	31.2	50,368	5,444
B3-2N_4	13.0	5.7	39.3	52.3	84,319	7,708
B3-2N_5	12.1	5.3	36.2	48.3	77,876	7,295
B3-2N_Reedy	12.5	5.5	37.5	50.0	80,736	7,479
B3-2N_6	21.6	9.3	69.5	91.1	146,996	11,487

REFERENCE COPY

Alternative 3-2N INTERCHANGES

Basin	Required Volume	Pond Area	PPV	Total Excavation Volume	Total Excavation Volume	Total Sodding
	ac-ft	ac	ac-ft	ac-ft	CY	SY
B3-2N_4IC	4.4	2.0	10.9	15.3	24,637	3,479
B3-2N_5IC	25.7	11.0	84.2	109.9	177,358	13,217

Alternative 3-2S MAINLINE

Basin	Required Volume	Pond Area	PPV	Total Excavation Volume	Total Excavation Volume	Total Sodding
	ac-ft	ac	ac-ft	ac-ft	CY	SY
B3-2S_1	8.9	4.0	25.3	34.2	55,245	5,785
B3-2S_2	18.6	8.0	58.8	77.4	124,947	10,196
B3-2S_3	9.6	4.3	27.7	37.3	60,152	6,122
B3-2S_4	17.1	7.4	53.6	70.7	113,989	9,541
B3-2S_5	12.2	5.4	36.5	48.7	78,590	7,341
B3-2S_Reedy	12.5	5.5	37.5	50.0	80,736	7,479
B3-2S_6	21.6	9.3	69.5	91.1	146,996	11,487

Alternative 3-2S INTERCHANGES

Basin	Required Volume	Pond Area	PPV	Total Excavation Volume	Total Excavation Volume	Total Sodding
	ac-ft	ac	ac-ft	ac-ft	CY	SY
B3-2S_4IC	8.1	3.6	22.7	30.8	49,674	5,395
B3-2S_5IC	25.8	11.0	84.6	110.4	178,101	13,259

Alternative 3-5N MAINLINE

REFERENCE COPY

Basin	Required Volume	Pond Area	PPV	Total Excavation Volume	Total Excavation Volume	Total Sodding
	ac-ft	ac	ac-ft	ac-ft	CY	SY
B3-5N_1	6.0	2.7	15.9	21.9	35,282	4,335
B3-5N_2	19.3	8.3	61.3	80.6	130,077	10,500
B3-5N_3	8.8	3.9	25.0	33.8	54,546	5,736
B3-5N_4	7.9	3.5	22.0	29.9	48,287	5,296
B3-5N_5	6.2	2.8	16.5	22.7	36,635	4,438
B3-5N_Reedy	20.2	8.7	64.5	84.7	136,687	10,888
B3-5N_6	27.8	11.8	91.8	119.6	192,993	14,090

Alternative 3-5N INTERCHANGES

Basin	Required Volume	Pond Area	PPV	Total Excavation Volume	Total Excavation Volume	Total Sodding
	ac-ft	ac	ac-ft	ac-ft	CY	SY
B3-5N_4IC	3.9	1.3	5.9	9.8	15,780	2,493
B3-5N_5IC	17.7	7.4	53.2	70.9	114,389	9,497

Alternative 3-5S MAINLINE

Basin	Required Volume	Pond Area	PPV	Total Excavation Volume	Total Excavation Volume	Total Sodding
	ac-ft	ac	ac-ft	ac-ft	CY	SY
B3-5S_1	9.2	4.1	26.3	35.5	57,344	5,930
B3-5S_2	19.3	8.3	61.3	80.6	130,077	10,500
B3-5S_3	9.7	4.3	28.0	37.7	60,855	6,170
B3-5S_4	8.7	3.9	24.7	33.4	53,848	5,688
B3-5S_5	6.2	2.8	16.5	22.7	36,635	4,438
B3-5S_Reedy	20.2	8.7	64.5	84.7	136,687	10,888
B3-5S_6	27.8	11.8	91.8	119.6	192,993	14,090

Alternative 3-5S INTERCHANGES

Basin	Required Volume	Pond Area	PPV	Total Excavation Volume	Total Excavation Volume	Total Sodding
	ac-ft	ac	ac-ft	ac-ft	CY	SY
B3-5S_4IC	3.9	1.8	9.4	13.3	21,392	3,199
B3-5S_5IC	17.7	7.6	55.7	73.4	118,366	9,804

Alternative 3A-3 MAINLINE

REFERENCE COPY

Basin	Required Volume	Pond Area	PPV	Total Excavation Volume	Total Excavation Volume	Total Sodding
	ac-ft	ac	ac-ft	ac-ft	CY	SY
B3A-3_1	29.9	12.7	99.4	129.3	208,676	14,956
B3A-3_2	27.5	11.7	90.7	118.2	190,756	13,966
B3A-3_3	27.4	11.7	90.4	117.8	190,011	13,924
B3A-3_4	10.9	4.8	32.1	43.0	69,333	6,737
B3A-3_Reedy	11.0	4.9	32.4	43.4	70,043	6,784
B3A-3_5	15.6	6.8	48.3	63.9	103,081	8,878

Alternative 3A-3 INTERCHANGES

Basin	Required Volume	Pond Area	PPV	Total Excavation Volume	Total Excavation Volume	Total Sodding
	ac-ft	ac	ac-ft	ac-ft	CY	SY
B3A-3_3IC	14.3	6.2	43.8	58.1	93,675	8,297
B3A-3_4IC	26.6	11.3	87.5	114.1	184,052	13,592

Alternative 3A-5 MAINLINE

Basin	Required Volume	Pond Area	PPV	Total Excavation Volume	Total Excavation Volume	Total Sodding
	ac-ft	ac	ac-ft	ac-ft	CY	SY
B3A-5_1	29.9	12.7	99.4	129.3	208,676	14,956
B3A-5_2	27.5	11.7	90.7	118.2	190,756	13,966
B3A-5_3	30.4	12.9	101.3	131.7	212,417	15,161
B3A-5_4	15.1	6.6	46.5	61.6	99,458	8,656
B3A-5_Reedy	20.2	8.7	64.5	84.7	136,687	10,888
B3A-5_5	27.7	11.8	91.5	119.2	192,247	14,049

Alternative 3A-5 INTERCHANGES

Basin	Required Volume	Pond Area	PPV	Total Excavation Volume	Total Excavation Volume	Total Sodding
	ac-ft	ac	ac-ft	ac-ft	CY	SY
B3A-5_3IC	21.0	9.0	67.4	88.4	142,574	11,231
B3A-5_4IC	27.5	11.7	90.7	118.2	190,756	13,966

I-4 INTERCHANGE ALTERNATIVES

Basin	Required Volume	Pond Area	PPV	Total Excavation Volume	Total Excavation Volume	Total Sodding
	ac-ft	ac	ac-ft	ac-ft	CY	SY
B532_ALT1A	24.3	10.4	79.2	103.5	166,964	12,630
B532_ALT2	20.9	9.0	67.0	87.9	141,837	11,188
B532_ALT3	37.5	15.8	127.2	164.7	265,769	18,041
B429_ALT3	191.4	78.4	712.1	903.5	1,457,674	75,132
B429_ALT4	130.8	53.8	479.3	610.1	984,244	53,267

REFERENCE COPY

Project: CFX Feasibility Study: I-4 / Poinciana Parkway Connector
County: Osceola & Polk

Table A.6 - Pond Right-of-way Area Summary

Alignment	2A-1	2A-2	2A-3	2A-4	2A-5	3-2N	3-2S	3-5N	3-5S	3A-3	3A-5	532_1A	532_2	532_3	429_3	429_4
Alignment Length (miles)	4.4	3.9	3.8	4.1	4.0	5.5	5.7	5.4	5.6	5.5	5.4	--	--	--	--	--
Number of Mainline Ponds	6	5	5	5	5	7	7	7	7	6	6	--	--	--	--	--
Total Mainline Pond Area (ac)	39.6	36.9	35.5	33.7	30.7	40.4	43.8	41.9	43.9	52.5	64.4	--	--	--	--	--
Mainline Pond Size per Mile (ac/mi)	8.9	9.5	9.3	8.3	7.7	7.4	7.7	7.8	7.9	9.5	11.9	--	--	--	--	--
Number of Interchanges	2	2	2	2	2	2	2	2	2	2	2	1	1	1	1	1
Total Available Interchange Pond Area (ac)	33.0	54.3	49.3	27.1	39.5	20.8	23.7	11.6	14.4	24.3	28.2	0.0	0.0	0.0	0.0	0.0
Interchange Pond Area Outside of Infield (ac)	2.4	0.0	0.0	0.0	0.0	0.0	0.0	0.3	0.0	6.2	7.8	10.4	9.0	15.8	78.4	53.8

Table A.7 - Pond Construction Quantity Summary

Pay Item	2A_1	2A_1 IC	2A_2	2A_2 IC	2A_3	2A_3 IC	2A_4	2A_4 IC	2A_5	2A_5 IC
120-1: Regular Excavation (Pond)	602,922	238,965	569,476	367,365	548,890	353,747	520,157	142,642	464,372	130,943
570-1-2: Performance Sod	51,773	19,580	47,470	27,142	45,500	26,272	43,526	13,337	40,552	12,640

Pay Item	3_2N	3_2N IC	3_2S	3_2S IC	3_5N	3_5N IC	3_5S	3_5S IC
120-1: Regular Excavation (Pond)	604,187	201,994	660,655	227,774	634,508	130,169	668,440	139,759
570-1-2: Performance Sod	54,160	16,696	57,951	18,653	55,283	11,990	57,703	13,004

REFERENCE COPY

Pay Item	3A_3	3A_3 IC	3A_5	3A_5 IC
120-1: Regular Excavation (Pond)	831,899	277,727	1,040,240	333,329
570-1-2: Performance Sod	65,246	21,889	77,676	25,197

Pay Item	532_1A	532_2	532_3	429_3	429_4
120-1: Regular Excavation (Pond)	166,964	141,837	265,769	1,457,674	984,244
570-1-2: Performance Sod	12,630	11,188	18,041	75,132	53,267

APPENDIX K

Location Hydraulics Methodology

REFERENCE COPY

Table of Contents

Location Hydraulic Analysis Methodology 2
Quantity Estimates 4

LIST OF FIGURES

- Figure B-1: Location Hydraulics - Cross Drain Methodology

LIST OF APPENDICES

Appendix A – Location Hydraulics Calculations

- Table B.1 – Offsite Conveyance Summary of Quantities
- Table B.2 – Existing Offsite Conveyance Summary
- Table B.3 – Existing Offsite Conveyance Quantities
- Table B.4 – Proposed Offsite Conveyance Summary
- Table B.5 – Proposed Offsite Conveyance Calculations
- Table B.6 – Proposed Time of Concentration Summary
- Table B.7 – Proposed Offsite Time of Concentration Calculations

REFERENCE COPY

Location Hydraulic Analysis Methodology

For the location hydraulic analysis, existing and proposed cross drain locations were identified and the cross drain sizes were estimated. Note this analysis was focused on evaluating for significant offsite water conveyance. This evaluation is not a comprehensive list of all cross drains required for each conceptual corridor, but is meant to provide an inventory for cost comparison purposes. No field review or hydrologic/hydraulic modeling is performed as part of this analysis. The estimates of location and size for the cross drains are a preliminary estimate of what would be required to not create substantial changes in the flood elevations adjacent to the project; however, this cannot be confirmed without further evaluation in future phases.

Along the conceptual corridors, existing and proposed cross drain locations were identified by review of the Digital Elevation Model (DEM), Federal Emergency Management Agency (FEMA) floodplains, National Wetland Inventory, existing permit information, and aerial imagery. The following approaches were used:

1. If there is an existing cross drain currently conveying offsite flow, it is assumed the existing cross drain will be extended in the proposed condition with the same size and material as the current condition. If there is an existing cross drain upstream or downstream within close proximity to the new crossing, the same sized crossing was used.
    - It was noted that the existing upstream crossings along I-4 had larger culvert sizes than closer existing crossings. In these cases, the crossing size at I-4 was used with the assumption that the same level of service will require the larger crossing size.
    - For existing hydraulic crossings that are comprised of a large bubble up structure with an adjacent wildlife crossing, it was assumed that both the hydraulic crossing and wildlife crossing that is impacted will be extended. It was assumed that the proposed crossing would be strictly a cross drain and not a bubble-up structure.

2. In areas where a proposed cross drain location is identified and there is an upstream USGS gage site or monitoring site, with available data, HEC-SSP V2.1.1 was used to calculate the 50-year and 100-year flows from the actual data. This information is provided for reference only. If available, upstream and downstream crossings were reviewed to provide an approximate length of bridge. The only crossing that has a USGS gage site is located along the Davenport Floodway. The existing crossing at I-4 was used to size this crossing.

3. In areas where a proposed cross drain location is identified and there is no existing flow data, the Rational Method (Q=CiA) for basins less than 600 acres will be utilized and for basins greater than 600 acres, the USGS Regression Equations for Florida Region 3 (Q based off of contributing area and percent available storage) will be utilized to determine the design flow. The Continuity Equation, Q= VA, will be applied, using a velocity of 6 feet per second, to determine the required cross sectional area for the proposed cross drain. A pipe or culvert size based on this cross sectional area will be provided for cost purposes.

REFERENCE COPY

Using CatchmentSIM, preliminary basins were delineated using the 2016 Osceola County LiDAR DEM. Basins were reviewed and combined to create upstream contributing areas for each proposed cross drain. Cross drains with a contributing basin less than 15 acres were excluded from analysis.

For basins that use the Rational Method, a time of concentration line was delineated and computed using the overland flow, shallow concentrated flow, and channel flow equations. For each contributing area, the percent impervious area and pervious area was assigned from aerial imagery review. If the basin contained a majority of permitted stormwater management facilities, which would provide significant storage, it was more prudent to assume an undeveloped condition, using historic aerials. The assumption being that permitted stormwater ponds are designed to attenuate the post-development peak flow so as not to be greater than the pre-development peak flow rate. If the developed condition was assumed but the storage was not accounted for, then the contributing flow would be largely overestimated.

For basins that use the Regression Equations, storage area was determined from the U.S. Geological Survey (USGS) National Hydrography Dataset (NHD) and U.S. Fish and Wildlife Service (USFWS) National Wetlands Inventory (NWI). These storage areas are reviewed to insure storage is still provided within the current condition, and for any areas that have been drained for agricultural production were removed.

Proposed cross drains are sized for the 50-year design storm event unless the corridor crosses a FEMA regulated floodway, then the 100-year storm event is the design storm event. The Davenport Floodway is the only regulated floodway that is crossed along the I-4/Poinciana Pkwy Connector. Currently, this analysis assumes this crossing will be a culvert designed for the 100-year storm event. Note, no hydraulic modeling was performed to verify that this system will meet the No-Rise Criteria.

REFERENCE COPY

Pipe sizing assumed the required cross sectional area is the minimum allowable size and rounded up to the nearest conventional pipe size. Box culverts were sized for any areas resulting in a pipe size greater than a 60" RCP. For any proposed cross drains with ground elevation below the estimated seasonal high water level (SHWL), additional height or diameter size was provided to accommodate base flow.

If an upstream existing cross drain was identified within the contributing area, existing permits were reviewed for the 50-year peak flow (flood data box). Only the contributing area between the existing cross drain and the proposed cross drain location was used to determine the peak flow to that location. The calculated peak flow was then added to the existing cross drain flow to result in the design flow through the proposed cross drain. If only the existing cross drain size is available (no flow information), the existing cross drain design flow was estimated using the Continuity Equation and a velocity of 6 feet per second through a fully flowing pipe. In the instance of an identified upstream hydraulic bubble-up structure, it was assumed that the peak flow capacity of the bubble-up structure matches the size of its pipes. If no size or flow information was available for the existing cross drain, then it was ignored for these

computations. The contributing basin area will include upstream of these unknown existing pipe sizes.

Quantity Estimates

To provide a financial comparison between the alternative alignment options, quantity estimates for each proposed cross drain or existing cross drain extension were computed with the following assumptions:

- Endwalls will be used over MES due to available space within the typical section & spaced approximately 10-feet from Right-of-Way limit. Currently, the Right-Of-Way is 324-feet wide with approximately 82-feet available for an onsite roadside conveyance ditch system (See **Plate 2**). It is assumed that the cross drains will only convey offsite under the proposed roadway and will minimize the impact to the proposed typical section by allowing 15-feet on either side for cross drain endwalls and grading.

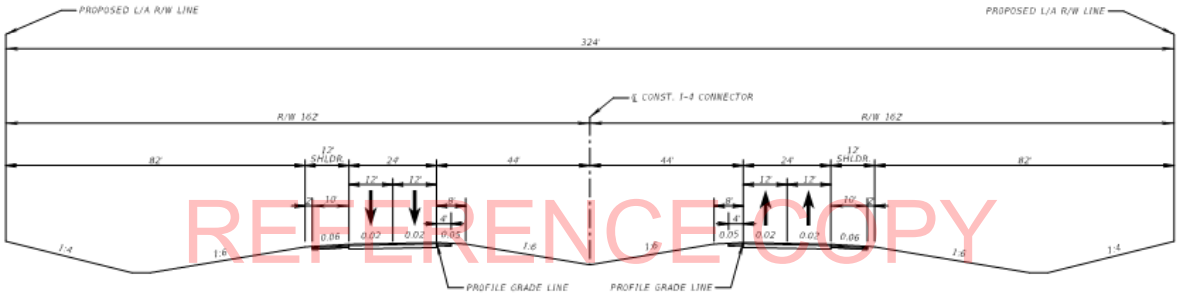

REFERENCE COPY

PLATE 1 - ROADWAY TYPICAL SECTION

- Riprap ditch lining will be used at the downstream side of each cross drain since the design velocity is at 6 fps. The riprap will extend 10-feet to the Right-of-Way and will be 1.5-feet deep. Any cross drains that were sized based off of existing cross drains were also assumed to require ditch lining.
- Existing cross drains that are to extended will be extended on both sides of the roadway.
- All existing cross drains are to be desilted. If the existing cross drain is a CBC, then it will be assumed that the silt is only 1-foot deep to quantify the cubic yard of slit to be removed.
- All box culverts will use Concrete Class IV and will follow Tables 9 – 16 in Index 400-292 of the FDOT Design Standards for the wall thickness (varies from 10" to 12") to quantify the required concrete with an additional 10% for box culvert corners and wingwalls.
- Any multi barrel box culverts were assumed to have 4" joint gap between precast box culverts. This item is not quantified, but assisted in the overall length for quantifying riprap ditch lining.
- All box culverts reinforcing steel has an approximate ratio of 265 between the required cubic yards of concrete and pounds of steel. This ratio was estimated from three CBC designs within FPID 201032-6-52-01 and FPID 410666-3-52-01.

- For the Regulated Davenport Floodway, the proposed offsite conveyance matches the size of the existing conveyance under I-4 connections as found in SFWMD Permit Application No. 020204-8. Documentation indicated that the connection was quadruple 12' x 8' CBC. Note no hydraulic modeling was performed to verify that this system will meet the No-Rise Criteria.

REFERENCE COPY

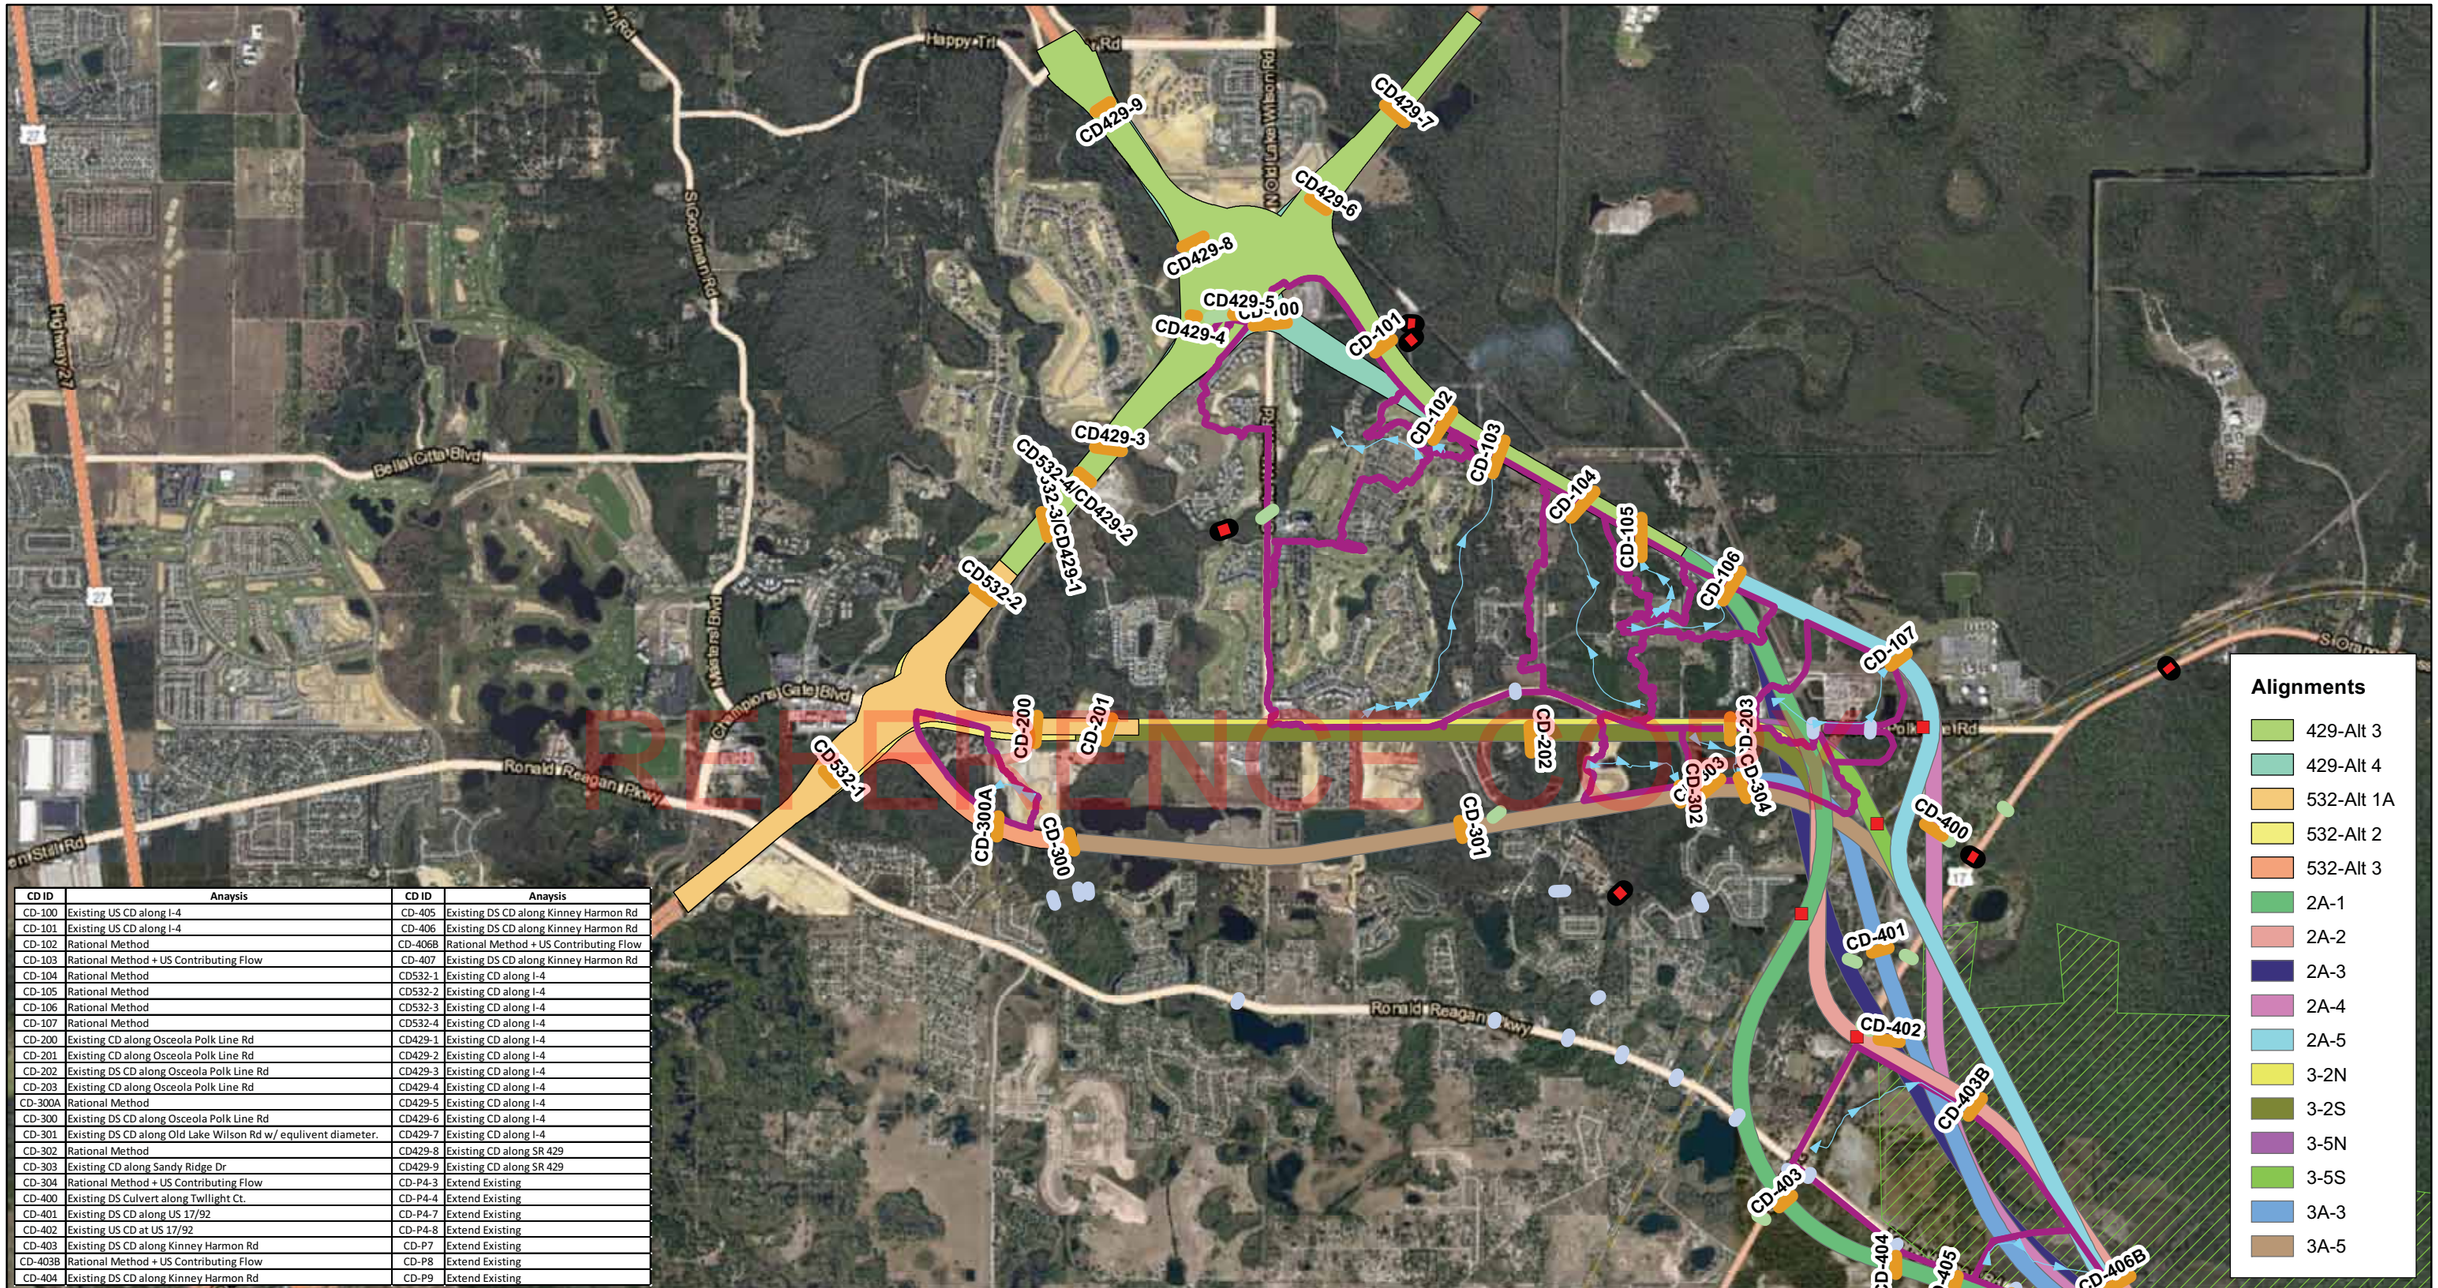

CD ID	Anaysis	CD ID	Anaysis
CD-100	Existing US CD along I-4	CD-405	Existing DS CD along Kinney Harmon Rd
CD-101	Existing US CD along I-4	CD-406	Existing DS CD along Kinney Harmon Rd
CD-102	Rational Method	CD-406B	Rational Method + US Contributing Flow
CD-103	Rational Method + US Contributing Flow	CD-407	Existing DS CD along Kinney Harmon Rd
CD-104	Rational Method	CD532-1	Existing CD along I-4
CD-105	Rational Method	CD532-2	Existing CD along I-4
CD-106	Rational Method	CD532-3	Existing CD along I-4
CD-107	Rational Method	CD532-4	Existing CD along I-4
CD-200	Existing CD along Osceola Polk Line Rd	CD429-1	Existing CD along I-4
CD-201	Existing CD along Osceola Polk Line Rd	CD429-2	Existing CD along I-4
CD-202	Existing DS CD along Osceola Polk Line Rd	CD429-3	Existing CD along I-4
CD-203	Existing CD along Osceola Polk Line Rd	CD429-4	Existing CD along I-4
CD-300A	Rational Method	CD429-5	Existing CD along I-4
CD-300	Existing DS CD along Osceola Polk Line Rd	CD429-6	Existing CD along I-4
CD-301	Existing DS CD along Old Lake Wilson Rd w/ equlivent diameter.	CD429-7	Existing CD along I-4
CD-302	Rational Method	CD429-8	Existing CD along SR 429
CD-303	Existing CD along Sandy Ridge Dr	CD429-9	Existing CD along SR 429
CD-304	Rational Method + US Contributing Flow	CD-P4-3	Extend Existing
CD-400	Existing DS Culvert along Twlight Ct.	CD-P4-4	Extend Existing
CD-401	Existing DS CD along US 17/92	CD-P4-7	Extend Existing
CD-402	Existing US CD at US 17/92	CD-P4-8	Extend Existing
CD-403	Existing DS CD along Kinney Harmon Rd	CD-P7	Extend Existing
CD-403B	Rational Method + US Contributing Flow	CD-P8	Extend Existing
CD-404	Existing DS CD along Kinney Harmon Rd	CD-P9	Extend Existing

The Balmoral Group
165 Lincoln Avenue
Winter Park, Florida 32789

Legend

- Hydraulic Crossing with Existing Road Crossing
- Cross Drains
- Longest Flow Path (Rational)
- Basins
- ReedyCreek_Miti...
- **Exist. Hydraulic Crossing**
- Pipe
- Bridge
- Culvert

N
W E
S

0 0.5 1
Miles

Figure B-1 : Location Hydraulics Cross Drain Methodology

Concept, Feasibility, & Mobility Study
Poinciana Pkwy Extension/I-4 Connector Expressway
Osceola & Polk County, FL

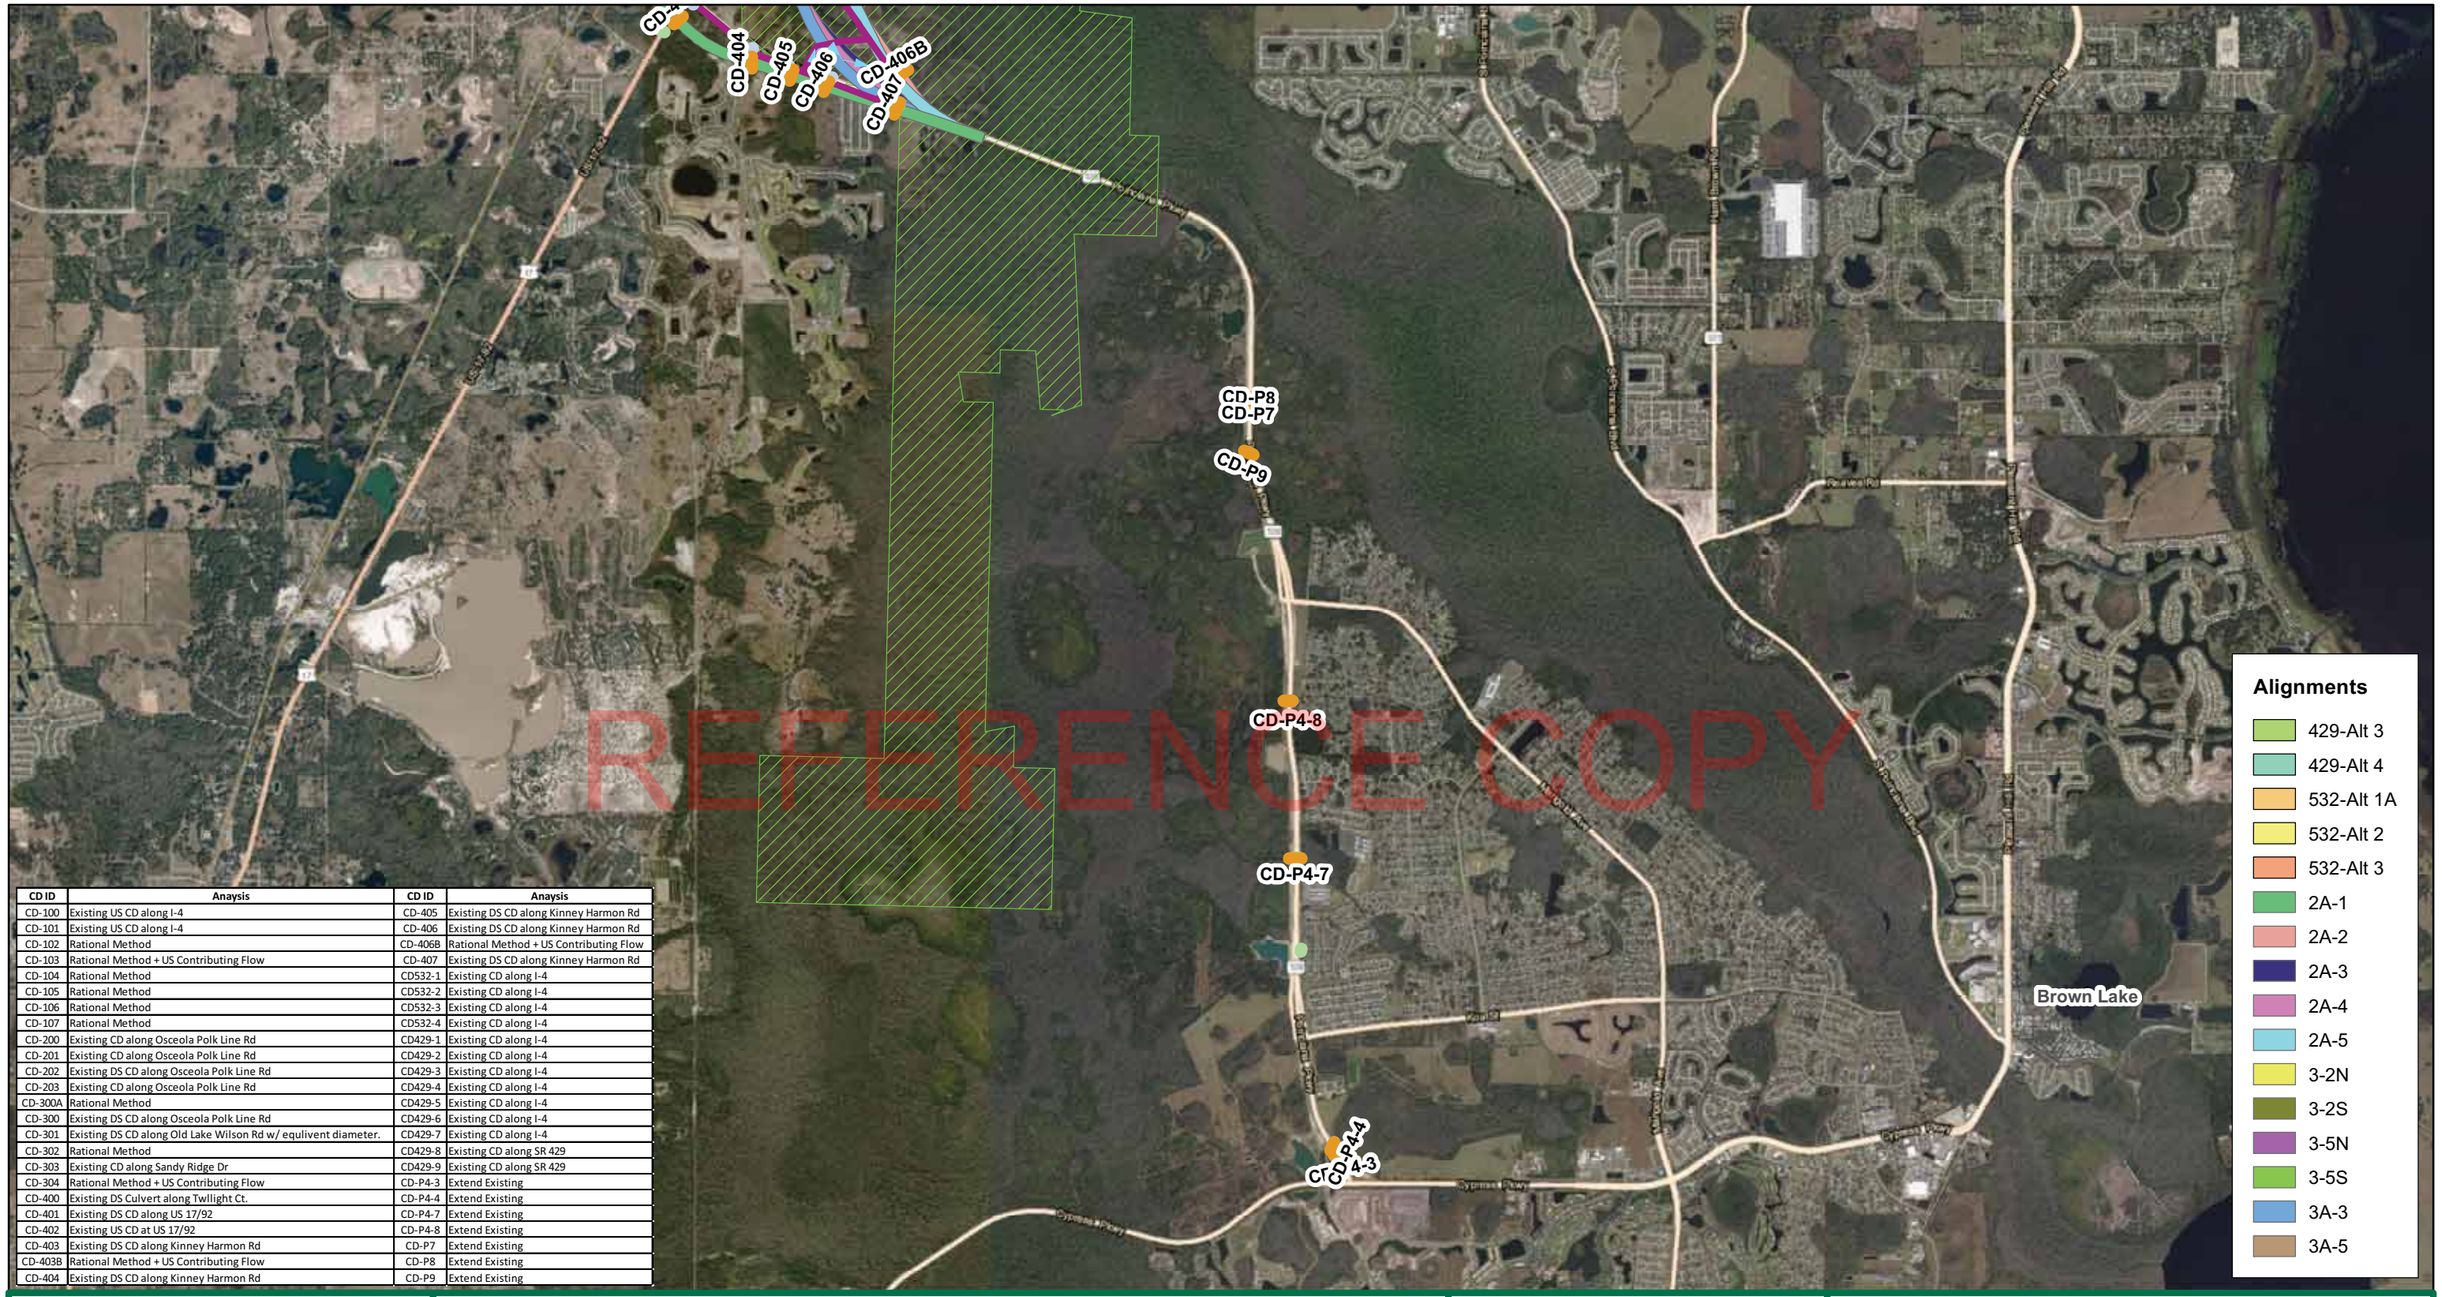

REFERENCE COPY

CD ID	Anaysis	CD ID	Anaysis
CD-100	Existing US CD along I-4	CD-405	Existing DS CD along Kinney Harmon Rd
CD-101	Existing US CD along I-4	CD-406	Existing DS CD along Kinney Harmon Rd
CD-102	Rational Method	CD-406B	Rational Method + US Contributing Flow
CD-103	Rational Method + US Contributing Flow	CD-407	Existing DS CD along Kinney Harmon Rd
CD-104	Rational Method	CD532-1	Existing CD along I-4
CD-105	Rational Method	CD532-2	Existing CD along I-4
CD-106	Rational Method	CD532-3	Existing CD along I-4
CD-107	Rational Method	CD532-4	Existing CD along I-4
CD-200	Existing CD along Osceola Polk Line Rd	CD429-1	Existing CD along I-4
CD-201	Existing CD along Osceola Polk Line Rd	CD429-2	Existing CD along I-4
CD-202	Existing DS CD along Osceola Polk Line Rd	CD429-3	Existing CD along I-4
CD-203	Existing CD along Osceola Polk Line Rd	CD429-4	Existing CD along I-4
CD-300A	Rational Method	CD429-5	Existing CD along I-4
CD-300	Existing DS CD along Osceola Polk Line Rd	CD429-6	Existing CD along I-4
CD-301	Existing DS CD along Old Lake Wilson Rd w/ equlivent diameter.	CD429-7	Existing CD along I-4
CD-302	Rational Method	CD429-8	Existing CD along SR 429
CD-303	Existing CD along Sandy Ridge Dr	CD429-9	Existing CD along SR 429
CD-304	Rational Method + US Contributing Flow	CD-P4-3	Extend Existing
CD-400	Existing DS Culvert along Twllight Ct.	CD-P4-4	Extend Existing
CD-401	Existing DS CD along US 17/92	CD-P4-7	Extend Existing
CD-402	Existing US CD at US 17/92	CD-P4-8	Extend Existing
CD-403	Existing DS CD along Kinney Harmon Rd	CD-P7	Extend Existing
CD-403B	Rational Method + US Contributing Flow	CD-P8	Extend Existing
CD-404	Existing DS CD along Kinney Harmon Rd	CD-P9	Extend Existing

The Balmoral Group
165 Lincoln Avenue
Winter Park, Florida 32789

Legend

- Cross Drains
- Longest Flow Path (Rational)
- Basins
- ReedyCreek_Miti...

Exist. Hydraulic Crossing

- Culvert
- Pipe

N
W E
S

0 0.75 1.5
Miles

Figure B-1 : Location Hydraulics Cross Drain Methodology

Concept, Feasibility, & Mobility Study
Poinciana Pkwy Extension/I-4 Connector Expressway
Osceola & Polk County, FL

PROJECT: CFX Feasibility Study: I-4 / Poinciana Parkway Connector **PREPARED:** ALE **DATE:** 11/06/17
LOCATION: Osceola and Polk County, Florida **CHECKED:** JAN **DATE:** 02/06/18

Table B.1 - Offsite Conveyance Summary of Quantities

Pay item	Description	Unit	Quantity													
			429-Alt3	429-Alt4	532-Alt1A	532-Alt2	532-Alt3	2A-1	2A-2	2A-3	2A-4	2A-5	3-2	3-5	3A-3	3A-5
400-1-2	Concrete Class I, Endwalls	CY	161.1	163.8	132.6	132.6	128.1	94.3	69.3	75.0	75.0	69.3	98.2	98.2	136.7	131.0
400-2-2	Concrete Class II, Endwalls	CY									22.6	22.6				
400-4-1	Concrete Class IV, Culverts	CY	5,297.5	5,527.9	1,492.4	1,492.4	1,733.3	2,442.9	3,552.2	3,469.6	3,469.6	3,731.1	3,270.0	2,540.6	3,593.4	3,854.9
415-1-1	Reinforcing Steel - Roadway	LB	1,403,839	1,464,894	395,486	395,486	459,325	647,369	941,334	919,445	920,835	990,133	866,551	673,260	952,252	1,021,550
430-94-1	Desilting Pipe, 0 - 24"	LF	300	300	202	202										
430-94-2	Desilting Pipe, 25-36"	LF	946	946	946	946	946	706	706	912	706	912	776	776	1,066	1,066
430-94-3	Desilting Pipe, 37-48"	LF	925	1,295	1,105	1,105	725	225	225	225	225	225	225	225	225	225
430-94-4	Desilting Pipe, 49-60"	LF		400												
430-950	Desilting Concrete Box Culvert	CY	835.6	835.6	346.7	346.7	346.7									
430-175-124	Pipe Culvert, Round, 24" CD	LF	240	240	92	92		1,470		588	588				588	
430-175-130	Pipe Culvert, Round, 30" CD	LF	74	74	74	74	74	74	74	74	74	74	74	74	624	624
430-175-136	Pipe Culvert, Round, 36" CD	LF	238	238	578	578	578	482	188	188	188	188	482	482	188	188
430-175-142	Pipe Culvert, Round, 42" CD	LF	270	300	208	208	588						882	882	588	588
430-175-148	Pipe Culvert, Round, 48" CD	LF	363	363	703	703	703	363	363	363	363	363	363	363	657	657
430-175-154	Pipe Culvert, Round, 54" CD	LF	588	718												
430-175-160	Pipe Culvert, Round, 60" CD	LF									294	294				
430-175-230	Pipe Culvert, Ellip/Arch, 30" CD	LF						588	588	382	588	382	588	588	588	588
430-175-236	Pipe Culvert, Ellip/Arch, 36" CD	LF													2,940	2,940
530-3-4	Riprap, Rubble, F&I, Ditch Lining	TN	412.8	393.8	200.3	200.3	208.0	192.6	216.1	220.5	233.4	239.2	227.3	204.9	290.9	296.7

REFERENCE COPY

PROJECT:	CFX Feasibility Study: I-4 / Poinciana Parkway Connector	**PREPARED:**	ALE	**DATE:**	11/09/17
LOCATION:	Osceola and Polk County, Florida	**CHECKED:**	JAN	**DATE:**	02/06/18

Table B.2 - Existing Offsite Conveyance Summary

Cross Drain ID	Corridor	Size	Source	Existing Length (LF)	Proposed Length (LF)****	Comment
CD-100	429_Alt4	2-7'x4' CBC	SFWMD Permit Application 020204-8	N/A***	304	Existing upstream crossing at I-4. Crossing Is larger than the 3-42" pipe at Lake Wilson Rd & the proposed crossing is assumed to have the same level of service as I-4.
CD-101	429_Alt4, 429_Alt3	4-12'x8' CBC	SFWMD Permit Application 020204-8	N/A***	304	Existing upstream crossing at I-4. Crossing Is larger than the 4-10'x8' CBC at Lake Wilson Rd. Proposed cross drain calculation preformed to verify Floodway level of service (100-yr) for location along Alt3 Interchange configuration.
CD-200	532_Alt1A, 532_Alt2	24" Pipe	SFWMD Permit Application 020114-21	202*	294	
CD-201	3-2, 3-5, 532_ALT 1A	2-42" Pipe	SFWMD Permit Application 020114-21	190*	294	
CD-202	3-2 & 3-5	3-42" Pipe	Google Earth	N/A***	294	Existing cross drain along Osceola Polk Line Rd. Size was estimated from Google Earth.
CD-203	3-2 & 3-5	36" Pipe	SFWMD Permit Application 020702-14	70*	294	
CD-300	532_Alt3	2-42" Pipe	SFWMD Permit Application 020114-21	N/A***	294	Downstream 2-42" at Osceola Polk Line Rd. has larger flow area than upstream 2-29"x45" & 24" at Lake Shore Pkwy.
CD-301	3A-3 & 3A-5	2-42" Pipe	Survey information in SWFWMD ERP 32681	N/A***	294	Existing downstream cross drain along Old Lake Wilson Rd. Survey shows 2-34"x52", used round equivalent size.
CD-303	3A-3 & 3A-5	6-29"x45" Pipe & 30" Wildlife Crossing	SFWMD Permit Application 020702-14	60*	550	At a skewed angle along alignments
				N/A	550	Existing is parallel with alignments. Would be entirely replaced.
CD-400	2A-1, 2A-2, 2A-3, 2A-4, 2A-5, 3-2, 3A-3, & 3A-5	3-5'x8' CBC	SFWMD Permit Application 940701-3	N/A***	304	Existing downstream cross drain at Twlight Ct.

REFERENCE COPY

PROJECT:	CFX Feasibility Study: I-4 / Poinciana Parkway Connector	**PREPARED:**	ALE	**DATE:**	11/09/17
LOCATION:	Osceola and Polk County, Florida	**CHECKED:**	JAN	**DATE:**	02/06/18

Table B.2 - Existing Offsite Conveyance Summary

Cross Drain ID	Corridor	Size	Source	Existing Length (LF)	Proposed Length (LF)****	Comment
CD-401	2A-2, 2A-3, 2A-4, 2A-5, 3-2, 3-5, 3A-3, & 3A-5	10'x3' CBC	US 17/US 92 FDOT Stright Line Diagram (Road ID: 16050000)	N/A***	304	Existing cross drain along US 17/US 92
CD-402	2A-3, 2A-4, 2A-5, 3-5, 3A-3, & 3A-5	4'x3' CBC	US 17/US 92 FDOT Stright Line Diagram (Road ID: 16050000)	N/A***	304	Existing cross drain along US 17/US 92
CD-403	2A-1	36" Pipe	SFWMD Permit Application 141010-12	N/A***	294	Existing downstream cross drain along Poinciana Pkwy / Kinney Harmon Rd
CD-404	2A-1	2-24" Pipe	SFWMD Permit Application 141010-12	N/A***	294	Existing downstream cross drain along Poinciana Pkwy / Kinney Harmon Rd
CD-405	2A-1	24" Pipe	SFWMD Permit Application 141010-12	N/A***	294	Existing downstream cross drain along Poinciana Pkwy / Kinney Harmon Rd
CD-406	2A-1, 2A-3, 2A-4, 3A-3	2-24" Pipe	SFWMD Permit Application 141010-12	N/A***	294	Existing cross drain along Poinciana Pkwy / Kinney Harmon Rd
CD-407	ALL Mainline Alternatives	2-24"x38" Pipe	SFWMD Permit Application 141010-12	103	294	Only alignments 2A-3 & 2A-5 will extend the existing pipe. All other alignments will only have new pipe.
CD532-1	ALL I-4 & SR 532 Interchange Alternatives	2-36" Pipe	SWFWMD ERP 11896	N/A***	85/ramp	This cross drain is a stand alone structure located under each ramp for all SR 532 interchange alternatives. Each alterantive includes 2 ramps.
CD532-2	All I-4 & SR 532 Interchange Alternatives	2-48" Pipe	SFWMD Permit Application 020204-8	250**	85/ramp	Extending cross drain for proposed ramps along I-4.
CD532-3 / CD429-1	All I-4 Interchange Alternatives	2-9'x7' CBC	SFWMD Permit Application 020204-8	260**	50/ramp	Extend cross drain for proposed ramps along I-4. SR 532 alternatives include extension for 2 ramps & SR 429 alternatives include extension for 1 ramp.

REFERENCE COPY

PROJECT:	CFX Feasibility Study: I-4 / Poinciana Parkway Connector	**PREPARED:**	ALE	**DATE:**	11/09/17
LOCATION:	Osceola and Polk County, Florida	**CHECKED:**	JAN	**DATE:**	02/06/18

Table B.2 - Existing Offsite Conveyance Summary

Cross Drain ID	Corridor	Size	Source	Existing Length (LF)	Proposed Length (LF)****	Comment
CD532-4 / CD429-2	All I-4 Interchange Alternatives	36" Pipe	SFWMD Permit Application 020204-8	240**	50/ramp	Extend cross drain for proposed ramps along I-4. SR 532 alternatives include extension for 1 ramp & SR 429 alternatives include extension for 1 ramp.
CD429-3	All I-4 & SR 429 Interchange Alternatives	4-12'X8' CBC	SFWMD Permit Application 020204-8	275**	50/ramp	Extending cross drain for proposed ramp along I-4.
CD429-4	I-4 & SR 429 Interchange Alternative 3	2-7'x4' CBC	FDEP Permit No. ERP49-187636-001-EI	N/A***	85/ramp	Stand alone cross drain for new ramp within SR 429 Alt3 Interchange. Assumed existing will not be impacted by proposed ramps that follow the existing ramp.
CD429-5	I-4 & SR 429 Interchange Alternative 3	2-7'x4' CBC	SFWMD Permit Application 020204-8	N/A***	85/ramp	Stand alone cross drain for new ramp within SR 429 Alt3 Interchange.
CD429-6	All I-4 & SR 429 Interchange Alternatives	42" Pipe	SFWMD Permit Application 101124-20	370**	Varies	Alt3 assumes 2 stand along cross drains under ramps. Alt 4 assumes extending existing cross drain under 3 ramps.
CD429-7	All I-4 & SR 429 Interchange Alternatives	2-42" Pipe	SFWMD Permit Application 020204-8	350**	50/ramp	Extending cross drain for proposed ramps along I-4. Alt 3 includes extension for two ramps, Alt 4 includes extension for one ramp.
CD429-8	I-4 & SR 429 Interchange Alternative 4	54" Pipe	FDEP Permit No. ERP49-187636-001-EI	400**	Varies	Extend cross drain along SR 429 under 3 ramps for Alt4 Interchange. Assumes cross drain location is outside of Alt 3 ramp relocation impacts.
CD429-9	All I-4 & SR 429 Interchange Alternatives	24" Pipe	FDEP Permit No. ERP49-187636-001-EI	300**	120/side	Extend cross drain along SR 429 for new interchange with Sinclair Rd. Includes Rt and Lt sides for both interchange alternatives.

REFERENCE COPY

PROJECT:	CFX Feasibility Study: I-4 / Poinciana Parkway Connector	**PREPARED:**	ALE	**DATE:**	11/09/17
LOCATION:	Osceola and Polk County, Florida	**CHECKED:**	JAN	**DATE:**	02/06/18

Table B.2 - Existing Offsite Conveyance Summary

Cross Drain ID	Corridor	Size	Source	Existing Length (LF)	Proposed Length (LF)****	Comment
CDP4-3	All Alternatives	48" Pipe	SFWMD Permit Application 141024-5	120	294	Connect existing cross drains.
CDP4-4	All Alternatives	48" Pipe	SFWMD Permit Application 141024-5	105	294	
CDP4-7	All Alternatives	1-8'x4' CBC	SFWMD Permit Application 141024-5	166	304	
CDP4-8	All Alternatives	3-10'x4' CBC	SFWMD Permit Application 141024-5	157	304	
CD-P9	All Alternatives	30" Pipe	SFWMD Permit Application 141010-12	126	200	
CD-P8	All Alternatives	2-36" Pipe	SFWMD Permit Application 141010-12	145	192	
CD-P7	All Alternatives	2-36" Pipe	SFWMD Permit Application 141010-12	145	192	

REFERENCE COPY

* Unknown pipe sizes will be estimated using same methods as proposed pipes. Assumed these will be entirely replaced to meet roadway design standards.

** Existing length was measured from aerial.

*** Existing pipe is either upstream or downstream of proposed alignment & is used to size the cross drain at the alignment alternatives crossing.

**** Proposed Typical Right of Way (ROW) is 324-ft. All cross drain lengths = ROW length less 10-ft for rip-rap/grading & 5-ft for Endwall (if applicable) on each side. Cross drain lengths within I-4 interchange vary depending upon ramp configuration.

PROJECT:	CFX Feasibility Study: I-4 / Poinciana Parkway Connector	**PREPARED:**	ALE	**DATE:**	11/09/17
LOCATION:	Osceola and Polk County, Florida	**CHECKED:**	JAN	**DATE:**	02/06/18

Table B.3 - Existing Offsite Conveyance Quantities

CD-100 2-7'x4' CBC

Pay Item No.	Description	Unit	Quantity
400-4-1	Concrete Class IV, Culverts	CY	523.0
415-1-1	Reinforcing Steel - Roadway	LB	138,595
530-3-4	Riprap, Rubble, F&I, Ditch Lining	TN	21.4

Impacted by 429-Alt4 Interchange

CD-200 24" Pipe

Pay Item No.	Description	Unit	Quantity
400-1-2	Concrete Class I, Endwalls	CY	4.5
430-94-1	Desilting Pipe, 0 - 24"	LF	202
430-175-124	Pipe Culvert, Round, 24" CD	LF	92
530-3-4	Riprap, Rubble, F&I, Ditch Lining	TN	5.7

CD-201 2-42" Pipe

Pay Item No.	Description	Unit	Quantity
400-1-2	Concrete Class I, Endwalls	CY	16.3
430-94-3	Desilting Pipe, 37-48"	LF	380
430-175-142	Pipe Culvert, Round, 42" CD	LF	208
530-3-4	Riprap, Rubble, F&I, Ditch Lining	TN	14.1

REFERENCE COPY

CD-202 3-42" Pipe

Pay Item No.	Description	Unit	Quantity
400-1-2	Concrete Class I, Endwalls	CY	19.8
430-175-142	Pipe Culvert, Round, 42" CD	LF	882
530-3-4	Riprap, Rubble, F&I, Ditch Lining	TN	18.9

PROJECT:	CFX Feasibility Study: I-4 / Poinciana Parkway Connector	**PREPARED:**	ALE	**DATE:**	11/09/17
LOCATION:	Osceola and Polk County, Florida	**CHECKED:**	JAN	**DATE:**	02/06/18

Table B.3 - Existing Offsite Conveyance Quantities

CD-203 36" Pipe

Pay Item No.	Description	Unit	Quantity
400-1-2	Concrete Class I, Endwalls	CY	9.1
430-94-2	Desilting Pipe, 25-36"	LF	70
430-175-136	Pipe Culvert, Round, 36" CD	LF	294
530-3-4	Riprap, Rubble, F&I, Ditch Lining	TN	8.1

CD-300 2-42" Pipe

Pay Item No.	Description	Unit	Quantity
400-1-2	Concrete Class I, Endwalls	CY	16.3
430-175-142	Pipe Culvert, Round, 42" CD	LF	588
530-3-4	Riprap, Rubble, F&I, Ditch Lining	TN	14.1

CD-301 2-42" Pipe

Pay Item No.	Description	Unit	Quantity
400-1-2	Concrete Class I, Endwalls	CY	16.3
430-175-142	Pipe Culvert, Round, 42" CD	LF	588
530-3-4	Riprap, Rubble, F&I, Ditch Lining	TN	14.1

REFERENCE COPY

CD-303 6-29"x45" Pipe & 30" Wildlife Crossing

Pay Item No.	Description	Unit	Quantity
400-1-2	Concrete Class I, Endwalls	CY	29.1
430-94-2	Desilting Pipe, 25-36"	LF	360
430-175-130	Pipe Culvert, Round, 30" CD	LF	550
430-175-236	Pipe Culvert, Ellip/Arch, 36" CD	LF	2,940
530-3-4	Riprap, Rubble, F&I, Ditch Lining	TN	38.6

CD-400 3-5'x8' CBC

Pay Item No.	Description	Unit	Quantity
400-4-1	Concrete Class IV, Culverts	CY	908.3
415-1-1	Reinforcing Steel - Roadway	LB	240,700
530-3-4	Riprap, Rubble, F&I, Ditch Lining	TN	32.6

PROJECT:	CFX Feasibility Study: I-4 / Poinciana Parkway Connector	**PREPARED:**	ALE	**DATE:**	11/09/17
LOCATION:	Osceola and Polk County, Florida	**CHECKED:**	JAN	**DATE:**	02/06/18

Table B.3 - Existing Offsite Conveyance Quantities

CD-401 10'x3' CBC

Pay Item No.	Description	Unit	Quantity
400-4-1	Concrete Class IV, Culverts	CY	302.8
415-1-1	Reinforcing Steel - Roadway	LB	80,242
530-3-4	Riprap, Rubble, F&I, Ditch Lining	TN	15.0

CD-402 4'x3' CBC

Pay Item No.	Description	Unit	Quantity
400-4-1	Concrete Class IV, Culverts	CY	178.9
415-1-1	Reinforcing Steel - Roadway	LB	47,409
530-3-4	Riprap, Rubble, F&I, Ditch Lining	TN	10.2

CD-403 36" Pipe

Pay Item No.	Description	Unit	Quantity
400-1-2	Concrete Class I, Endwalls	CY	9.1
430-175-136	Pipe Culvert, Round, 36" CD	LF	294
530-3-4	Riprap, Rubble, F&I, Ditch Lining	TN	8.1

REFERENCE COPY

CD-404 2-24" Pipe

Pay Item No.	Description	Unit	Quantity
400-1-2	Concrete Class I, Endwalls	CY	5.7
430-175-124	Pipe Culvert, Round, 24" CD	LF	588
530-3-4	Riprap, Rubble, F&I, Ditch Lining	TN	8.4

CD-405 24" Pipe

Pay Item No.	Description	Unit	Quantity
400-1-2	Concrete Class I, Endwalls	CY	4.5
430-175-124	Pipe Culvert, Round, 24" CD	LF	294
530-3-4	Riprap, Rubble, F&I, Ditch Lining	TN	5.7

PROJECT:	CFX Feasibility Study: I-4 / Poinciana Parkway Connector	**PREPARED:**	ALE	**DATE:**	11/09/17
LOCATION:	Osceola and Polk County, Florida	**CHECKED:**	JAN	**DATE:**	02/06/18

Table B.3 - Existing Offsite Conveyance Quantities

CD-406 2-24" Pipe

Pay Item No.	Description	Unit	Quantity
400-1-2	Concrete Class I, Endwalls	CY	5.7
430-175-124	Pipe Culvert, Round, 24" CD	LF	588
530-3-4	Riprap, Rubble, F&I, Ditch Lining	TN	8.4

CD-407 2-24"x38" Pipe *Extended (2A-3 & 2A-5)*

Pay Item No.	Description	Unit	Quantity
400-1-2	Concrete Class I, Endwalls	CY	7.1
430-94-2	Desilting Pipe, 25-36"	LF	206
430-175-230	Pipe Culvert, Ellip/Arch, 30" CD	LF	382
530-3-4	Riprap, Rubble, F&I, Ditch Lining	TN	10.7

CD-407 2-24"x38" Pipe *All other Alignments*

Pay Item No.	Description	Unit	Quantity
400-1-2	Concrete Class I, Endwalls	CY	7.1
430-175-230	Pipe Culvert, Ellip/Arch, 30" CD	LF	588
530-3-4	Riprap, Rubble, F&I, Ditch Lining	TN	10.7

REFERENCE COPY

CD532-1 2-36"

Pay Item No.	Description	Unit	Quantity
400-1-2	Concrete Class I, Endwalls	CY	23.0
430-175-136	Pipe Culvert, Round, 36" CD	LF	340
530-3-4	Riprap, Rubble, F&I, Ditch Lining	TN	24.2

Assumed Pipe Length under Ramp = 85

CD532-2 2-48"

Pay Item No.	Description	Unit	Quantity
400-1-2	Concrete Class I, Endwalls	CY	20.8
430-94-3	Desilting Pipe, 37-48"	LF	500
430-175-148	Pipe Culvert, Round, 48" CD	LF	340
530-3-4	Riprap, Rubble, F&I, Ditch Lining	TN	15.9

Assumed Pipe Extention Length under each Ramp = 85

PROJECT:	CFX Feasibility Study: I-4 / Poinciana Parkway Connector	**PREPARED:**	ALE	**DATE:**	11/09/17
LOCATION:	Osceola and Polk County, Florida	**CHECKED:**	JAN	**DATE:**	02/06/18

Table B.3 - Existing Offsite Conveyance Quantities

CD532-3 2-9'x7' CBC

Pay Item No.	Description	Unit	Quantity
400-4-1	Concrete Class IV, Culverts	CY	240.0
430-950	Desilting Concrete Box Culvert	CY	347
415-1-1	Reinforcing Steel - Roadway	LB	63,600
530-3-4	Riprap, Rubble, F&I, Ditch Lining	TN	29.4

Assumed Pipe Extention Length under each Ramp = 50

CD532-4 36"

Pay Item No.	Description	Unit	Quantity
400-1-2	Concrete Class I, Endwalls	CY	5.8
430-94-2	Desilting Pipe, 25-36"	LF	240
430-175-136	Pipe Culvert, Round, 36" CD	LF	50
530-3-4	Riprap, Rubble, F&I, Ditch Lining	TN	8.1

Assumed Pipe Extention Length under each Ramp = 50

CD429-1 2-9'x7' CBC

Pay Item No.	Description	Unit	Quantity
400-4-1	Concrete Class IV, Culverts	CY	120.0
430-950	Desilting Concrete Box Culvert	CY	347
415-1-1	Reinforcing Steel - Roadway	LB	31,800
530-3-4	Riprap, Rubble, F&I, Ditch Lining	TN	29.4

REFERENCE COPY

Assumed Pipe Extention Length under each Ramp = 50

CD429-2 36"

Pay Item No.	Description	Unit	Quantity
400-1-2	Concrete Class I, Endwalls	CY	5.8
430-94-2	Desilting Pipe, 25-36"	LF	240
430-175-136	Pipe Culvert, Round, 36" CD	LF	50
530-3-4	Riprap, Rubble, F&I, Ditch Lining	TN	8.1

Assumed Pipe Extention Length under each Ramp = 50

CD429-3 4-12'x8' CBC

Pay Item No.	Description	Unit	Quantity
400-4-1	Concrete Class IV, Culverts	CY	358.6
430-950	Desilting Concrete Box Culvert	CY	488.9
415-1-1	Reinforcing Steel - Roadway	LB	95,029
530-3-4	Riprap, Rubble, F&I, Ditch Lining	TN	59.3

Assumed Pipe Extention Length under each Ramp = 50

PROJECT:	CFX Feasibility Study: I-4 / Poinciana Parkway Connector	**PREPARED:**	ALE	**DATE:**	11/09/17
LOCATION:	Osceola and Polk County, Florida	**CHECKED:**	JAN	**DATE:**	02/06/18

Table B.3 - Existing Offsite Conveyance Quantities

CD429-4_Alt3 2-7'x4' CBC

Pay Item No.	Description	Unit	Quantity
400-4-1	Concrete Class IV, Culverts	CY	146.3
415-1-1	Reinforcing Steel - Roadway	LB	38,770
530-3-4	Riprap, Rubble, F&I, Ditch Lining	TN	21.4

Assumed Pipe Length under Ramp = 85

CD429-5_Alt3 2-7'x4' CBC

Pay Item No.	Description	Unit	Quantity
400-4-1	Concrete Class IV, Culverts	CY	146.3
415-1-1	Reinforcing Steel - Roadway	LB	38,770
530-3-4	Riprap, Rubble, F&I, Ditch Lining	TN	21.4

Assumed Pipe Length under Ramp = 85

CD429-6_Alt3 42"

Pay Item No.	Description	Unit	Quantity
400-1-2	Concrete Class I, Endwalls	CY	25.4
430-175-142	Pipe Culvert, Round, 42" CD	LF	170
530-3-4	Riprap, Rubble, F&I, Ditch Lining	TN	18.6

REFERENCE COPY

CD under each Ramp. Assumed Pipe Length under Ramp = 85

CD429-6_Alt4 42"

Pay Item No.	Description	Unit	Quantity
400-1-2	Concrete Class I, Endwalls	CY	12.7
430-94-3	Desilting Pipe, 37-48"	LF	370
430-175-142	Pipe Culvert, Round, 42" CD	LF	250
530-3-4	Riprap, Rubble, F&I, Ditch Lining	TN	9.3

Extending Existing CD under 3 ramps.

CD429-7_Alt3 2-42"

Pay Item No.	Description	Unit	Quantity
400-1-2	Concrete Class I, Endwalls	CY	16.3
430-94-3	Desilting Pipe, 37-48"	LF	700
430-175-142	Pipe Culvert, Round, 42" CD	LF	100
530-3-4	Riprap, Rubble, F&I, Ditch Lining	TN	14.1

Assumed Pipe Extention Length under each Ramp = 50

PROJECT:	CFX Feasibility Study: I-4 / Poinciana Parkway Connector	**PREPARED:**	ALE	**DATE:**	11/09/17
LOCATION:	Osceola and Polk County, Florida	**CHECKED:**	JAN	**DATE:**	02/06/18

Table B.3 - Existing Offsite Conveyance Quantities

CD429-7_Alt4 2-42"

Pay Item No.	Description	Unit	Quantity
400-1-2	Concrete Class I, Endwalls	CY	8.2
430-94-3	Desilting Pipe, 37-48"	LF	700
430-175-142	Pipe Culvert, Round, 42" CD	LF	50
530-3-4	Riprap, Rubble, F&I, Ditch Lining	TN	14.1

Assumed Pipe Extention Length under each Ramp = 50

CD429-8_Alt4 54"

Pay Item No.	Description	Unit	Quantity
400-1-2	Concrete Class I, Endwalls	CY	23.5
430-94-4	Desilting Pipe, 49-60"	LF	400
430-175-154	Pipe Culvert, Round, 54" CD	LF	130
530-3-4	Riprap, Rubble, F&I, Ditch Lining	TN	11.7

Extending Existing CD under proposed ramps.

CD429-9 24"

Pay Item No.	Description	Unit	Quantity
400-1-2	Concrete Class I, Endwalls	CY	4.5
430-94-1	Desilting Pipe, 0 - 24"	LF	300
430-175-124	Pipe Culvert, Round, 24" CD	LF	240
530-3-4	Riprap, Rubble, F&I, Ditch Lining	TN	5.7

REFERENCE COPY

Extending Existing CD under proposed ramps.

Assume 100 ft each side of SR 429 with additional 20' for tie-in and clear zone.

CDP4-3 48"

Pay Item No.	Description	Unit	Quantity
400-1-2	Concrete Class I, Endwalls	CY	16.3
430-94-3	Desilting Pipe, 37-48"	LF	120
430-175-148	Pipe Culvert, Round, 48" CD	LF	174
530-3-4	Riprap, Rubble, F&I, Ditch Lining	TN	10.5

Extending Existing CD under proposed ramps.

CDP4-4 48"

Pay Item No.	Description	Unit	Quantity
400-1-2	Concrete Class I, Endwalls	CY	16.3
430-94-3	Desilting Pipe, 37-48"	LF	105
430-175-148	Pipe Culvert, Round, 48" CD	LF	189
530-3-4	Riprap, Rubble, F&I, Ditch Lining	TN	10.5

PROJECT:	CFX Feasibility Study: I-4 / Poinciana Parkway Connector	**PREPARED:**	ALE	**DATE:**	11/09/17
LOCATION:	Osceola and Polk County, Florida	**CHECKED:**	JAN	**DATE:**	02/06/18

Table B.3 - Existing Offsite Conveyance Quantities

CDP4-7 1-8'x4' CBC

Pay Item No.	Description	Unit	Quantity
400-4-1	Concrete Class IV, Culverts	CY	282.2
415-1-1	Reinforcing Steel - Roadway	LB	74,783
530-3-4	Riprap, Rubble, F&I, Ditch Lining	TN	15

CDP4-8 3-10'x4' CBC

Pay Item No.	Description	Unit	Quantity
400-4-1	Concrete Class IV, Culverts	CY	970.2
415-1-1	Reinforcing Steel - Roadway	LB	257,103
530-3-4	Riprap, Rubble, F&I, Ditch Lining	TN	35.8

CD-P9 30"

Pay Item No.	Description	Unit	Quantity
400-1-2	Concrete Class I, Endwalls	CY	6.6
430-94-2	Desilting Pipe, 25-36"	LF	126
430-175-130	Pipe Culvert, Round, 30" CD	LF	74
530-3-4	Riprap, Rubble, F&I, Ditch Lining	TN	6.9

REFERENCE COPY

CD-P8 2-36"

Pay Item No.	Description	Unit	Quantity
400-1-2	Concrete Class I, Endwalls	CY	11.5
430-94-2	Desilting Pipe, 25-36"	LF	290
430-175-136	Pipe Culvert, Round, 36" CD	LF	94
530-3-4	Riprap, Rubble, F&I, Ditch Lining	TN	12.1

CD-P7 2-36"

Pay Item No.	Description	Unit	Quantity
400-1-2	Concrete Class I, Endwalls	CY	11.5
430-94-2	Desilting Pipe, 25-36"	LF	290
430-175-136	Pipe Culvert, Round, 36" CD	LF	94
530-3-4	Riprap, Rubble, F&I, Ditch Lining	TN	12.1

PROJECT:	CFX Feasibility Study: I-4 / Poinciana Parkway Connector	**PREPARED:**	ALE	**DATE:**	11/09/17
LOCATION:	Osceola and Polk County, Florida	**CHECKED:**	JAN	**DATE:**	02/20/18

Table B.4 - Proposed Offsite Conveyance Summary

Cross Drain ID	Required Minimum Size	Regulated Floodway?	Design Storm	Basin Area (ac)	Method
CD-100	2-7'x4' CBC	No	50-year	--	Use Existing Crossing Size
CD-101	4-12'x8' CBC	Yes	100-year	--	Rational Method + Contributing Flow
CD-102	54" Pipe	No	50-year	21.53	Rational Method
CD-103	2-10'x7' CBC	No	50-year	519.72	Rational Method + Contributing Flow
CD-104	8' x 6' CBC	No	50-year	166.28	Rational Method
CD-105	54" Pipe	No	50-year	36.68	Rational Method
CD-106	7'x5' CBC	No	50-year	43.10	Rational Method
CD-107	60" Pipe	No	50-year	103.83	Rational Method
CD-200	24" Pipe	No	50-year	--	Extend Existing
CD-201	2-42" Pipe	No	50-year	--	Extend Existing
CD-202	3-42" Pipe	No	50-year	--	Use Existing Crossing Size
CD-203	36" Pipe	No	50-year	--	Extend Existing
CD-300A	6'x4' CBC	No	50-year	53.67	Rational Method
CD-300	2-42" Pipe	No	50-year	--	Use Existing Crossing Size
CD-301	2-42" Pipe	No	50-year	--	Use Existing Crossing Size
CD-302	48" Pipe	No	50-year	54.38	Rational Method
CD-303	6-29"x45" Pipe & 30" Wildlife Crossing	No	50-year	--	Extend Existing
CD-304	10' x 8' CBC	No	50-year	75.85	Rational Method + Contributing Flow
CD-400	3-5'x8' CBC	No	50-year	--	Use Existing Crossing Size
CD-401	10'x3' CBC	No	50-year	--	Use Existing Crossing Size
CD-402	4'x3' CBC	No	50-year	--	Use Existing Crossing Size
CD-403	36" Pipe	No	50-year	--	Use Existing Crossing Size
CD-403B	12' x 8' CBC	No	50-year	280.49	Rational Method + Contributing Flow
CD-404	2-24" Pipe	No	50-year	--	Use Existing Crossing Size
CD-405	24" Pipe	No	50-year	--	Use Existing Crossing Size
CD-406	2-24" Pipe	No	50-year	--	Use Existing Crossing Size
CD-406B	7' x 4' CBC	No	50-year	66.52	Rational Method + Contributing Flow
CD-407 (Extended)	2-24"x38" Pipe	No	50-year	--	Extend Existing
CD-407	2-24"x38" Pipe	No	50-year	--	Use Existing Crossing Size
CD532-1	2-36" Pipe	No	50-year	--	Use Existing Crossing Size
CD532-2	2-48" Pipe	No	50-year	--	Extend Existing
CD532-3	2-9'x7' CBC	No	50-year	--	Extend Existing
CD532-4	36" Pipe	No	50-year	--	Extend Existing

REFERENCE COPY

PROJECT:	CFX Feasibility Study: I-4 / Poinciana Parkway Connector	**PREPARED:**	ALE	**DATE:**	11/09/17
LOCATION:	Osceola and Polk County, Florida	**CHECKED:**	JAN	**DATE:**	02/20/18

Table B.4 - Proposed Offsite Conveyance Summary

Cross Drain ID	Required Minimum Size	Regulated Floodway?	Design Storm	Basin Area (ac)	Method
CD429-1	2-9'x7' CBC	No	50-year	--	Extend Existing
CD429-2	36" Pipe	No	50-year	--	Extend Existing
CD429-3	4-12'X8' CBC	No	50-year	--	Extend Existing
CD429-4	2-7'x4' CBC	No	50-year	--	Use Existing Crossing Size
CD429-5	2-7'x4' CBC	No	50-year	--	Use Existing Crossing Size
CD429-6	42" Pipe	No	50-year	--	Alt3 = Use Existing Crossing Size Alt4 = Extend Existing
CD429-7	2-42" Pipe	No	50-year	--	Extend Existing
CD429-8	54" Pipe	No	50-year	--	Extend Existing
CD429-9	24" Pipe	No	50-year	--	Extend Existing
CDP4-3	48" Pipe	No	50-year	--	Extend Existing
CDP4-4	48" Pipe	No	50-year	--	Extend Existing
CDP4-7	1-8'x4' CBC	No	50-year	--	Extend Existing
CDP4-8	3-10'x4' CBC	No	50-year	--	Extend Existing
CD-P9	30" Pipe	No	50-year	--	Extend Existing
CD-P8	2-36" Pipe	No	50-year	--	Extend Existing
CD-P7	2-36" Pipe	No	50-year	--	Extend Existing

REFERENCE COPY

PROJECT:	CFX Feasibility Study: I-4 / Poinciana Parkway Connector	**PREPARED:**	ALE	**DATE:**	11/09/17
LOCATION:	Osceola and Polk County, Florida	**CHECKED:**	JAN	**DATE:**	02/06/18

Table B.4 - Proposed Offsite Conveyance Summary

Cross Drain ID	Required Minimum Size	Regulated Floodway?	Design Storm	Basin Area (ac)	Method
CD429-1	2-9'x7' CBC	No	50-year	--	Extend Existing
CD429-2	36" Pipe	No	50-year	--	Extend Existing
CD429-3	4-12'X8' CBC	No	50-year	--	Extend Existing
CD429-4	2-7'x4' CBC	No	50-year	--	Use Existing Crossing Size
CD429-5	2-7'x4' CBC	No	50-year	--	Use Existing Crossing Size
CD429-6	42" Pipe	No	50-year	--	Alt3 = Use Existing Crossing Size Alt4 = Extend Existing
CD429-7	2-42" Pipe	No	50-year	--	Extend Existing
CD429-8	54" Pipe	No	50-year	--	Extend Existing
CD429-9	24" Pipe	No	50-year	--	Extend Existing
CDP4-3	48" Pipe	No	50-year	--	Extend Existing
CDP4-4	48" Pipe	No	50-year	--	Extend Existing
CDP4-7	1-8'x4' CBC	No	50-year	--	Extend Existing
CDP4-8	3-10'x4' CBC	No	50-year	--	Extend Existing
CD-P9	30" Pipe	No	50-year	--	Extend Existing
CD-P8	2-36" Pipe	No	50-year	--	Extend Existing
CD-P7	2-36" Pipe	No	50-year	--	Extend Existing

REFERENCE COPY

PROJECT:	CFX Feasibility Study: I-4 / Poinciana Parkway Connector	**PREPARED:**	ALE	**DATE:**	01/17/18
LOCATION	Osceola and Polk County, Florida	**CHECKED:**	JAN	**DATE:**	02/06/18

Table B.5 - Proposed Offsite Conveyance Calculations

Proposed Cross Drain at Poinciana Pkwy Extension/I-4 Connector

Cross Drain Name	CD-101
Corridor	429_Alt4, 429_Alt3
Precipitation Zone	7
Pervious C-Value[1]	0.3
Impervious C-value	0.95
Time of Concentration (min)	**25.0**

31.3 Minutes from Time of Conc. Calc

Basin Runoff Calculations

Total Contributing Area (acres)	293.92
Pervious Contributing Area (acres)	264.53
Impervious Contributing Area (acres)	29.39
Weighted Runoff Coefficient[1]	0.43
Design Event[2]	100-year
Design Intensity (in/hr)[3]	6.41
Design Peak Flow (cfs)	814

Basin downstream of existing cross drains.

Total Contributing Flow Calculations

Exist. 2-7'x4' CBC at I-4	201	*SFWMD ERP App. 020204-8 (100-yr Storm)*
USGS Gage 02266480 (Exist. 4-10'x8' CBC)	418	*Peak FQ Results from Gage Data (100-yr Storm)*
Total Design Peak Flow (cfs)	1433	

Cross Drain Sizing Calculations

Assumed Velocity (ft/s)	6
Cross-sectional Area Required (ft^2)	238.86
Recommended Culvert Size	4 - 12 ft x 5 ft
Provided Cross Sectional Area (ft^2)	240.00
Est. SHWL Elev (ft-NAVD88)	80.0
Est. Ground Elev (ft-NAVD88)	77.0
Additional Culvert Height Required	3.0
Recommended Culvert Size Total	4 - 12 ft x 8 ft

Matches I-4 Davenport Bridge Culvert Size

More Costly to assume the use of both exist. US cross drains along I-4

REFERENCE COPY

Cost Estimate Calculations

Pay Item No.	Description	Unit	Quantity
400-4-1	Concrete Class IV, Culverts	CY	2179.8
415-1-1	Reinforcing Steel - Roadway	LB	577,647
530-3-4	Riprap, Rubble, F&I, Ditch Lining	TN	59.3

Notes:

[1] Pervious Runoff Coefficients value assumed to be the max of Pasture/Grass with poorly drained soils at 2-7% slope. Frequency Factor applied per Design Storm Event (Tables B-4 & B-5, FDOT Drainage Design Guide, January 2017).

[2] Per FDOT Drainage Manual, 50-year considered design event for mainline interstates and 100-year used if culvert proposed within regulated floodway.

[3] Design Intensity calculated from FDOT IDF Regression Equations for Tc < 180 minutes. If Tc > 180 minutes, intensity estimated directly from the IDF Curve.

PROJECT:	CFX Feasibility Study: I-4 / Poinciana Parkway Connector	**PREPARED:**	ALE	**DATE:**	01/17/18
LOCATION:	Osceola and Polk County, Florida	**CHECKED:**	JAN	**DATE:**	02/06/18

Table B.5 - Proposed Offsite Conveyance Calculations

Proposed Cross Drain at Poinciana Pkwy Extension/I-4 Connector

Cross Drain Name	CD-102
Corridor	429_Alt4, 429_Alt3
Precipitation Zone	7
Pervious C-Value[1]	0.3
Impervious C-value	0.95
Time of Concentration (min)	10.0

Basin Runoff Calculations

Total Contributing Area (acres)	21.53
Pervious Contributing Area (acres)	20.45
Impervious Contributing Area (acres)	1.08
Weighted Runoff Coefficient[1]	0.39
Design Event[2]	50-year
Design Intensity (in/hr)[3]	8.92
Design Peak Flow (cfs)	74.83

Cross Drain Sizing Calculations

Assumed Velocity (ft/s)	6
Cross-sectional Area Required (ft^2)	12.47
Recommended Culvert Size	48 inch
Provided Cross Sectional Area (ft^2)	12.57
Upstream Est. SHWL Elev (ft-NAVD88)	77.0
Upstream Est. Ground Elev (ft-NAVD88)	76.6
Additional Culvert Height Required	0.4
Recommended Culvert Size Total	54 inch

REFERENCE COPY

Cost Estimate Calculations

Pay Item No.	Description	Unit	Quantity
400-1-2	Concrete Class I, Endwalls	CY	23.5
430-175-154	Pipe Culvert, Round, 54" CD	LF	294
530-3-4	Riprap, Rubble, F&I, Ditch Lining	TN	11.7

Notes:

[1] Pervious Runoff Coefficients value assumed to be the max of Pasture/Grass with poorly drained soils at 2-7% slope. Frequency Factor applied per Design Storm Event (Tables B-4 & B-5, FDOT Drainage Design Guide, January 2017).

[2] Per FDOT Drainage Manual, 50-year considered design event for mainline interstates and 100-year used if culvert proposed within regulated floodway.

[3] Design Intensity calculated from FDOT IDF Regression Equations for Tc < 180 minutes. If Tc > 180 minutes, intensity estimated directly from the IDF Curve.

PROJECT:	CFX Feasibility Study: I-4 / Poinciana Parkway Connector	**PREPARED:**	ALE	**DATE:**	01/17/18
LOCATION:	Osceola and Polk County, Florida	**CHECKED:**	JAN	**DATE:**	02/06/18

Table B.5 - Proposed Offsite Conveyance Calculations

Proposed Cross Drain at Poinciana Pkwy Extension/I-4 Connector

Cross Drain Name	CD-103
Corridor	429_Alt4, 429_Alt3
Precipitation Zone	7
Pervious C-Value[1]	0.3
Impervious C-value	0.95
Time of Concentration (min)	102.7

Basin Runoff Calculations

Total Contributing Area (acres)	519.72	Permit 040625-1 and 000522-5 show development within this basin with stormwater ponds, constructed in 2004. Assume pre/post discharges were met and use existing condition for impervious/pervious area estimates.
Pervious Contributing Area (acres)	509.33	
Impervious Contributing Area (acres)	10.39	
Weighted Runoff Coefficient[1]	0.37	
Design Event[2]	50-year	
Design Intensity (in/hr)[3]	2.87	
Design Peak Flow (cfs)	554	Basin between Osceola Polk Rd and Proposed CD

Total Contributing Flow Calculations

Exist. 3-42" at Osceola Polk Line Rd (cfs)	173	Assumed full flow at 6 fps
Total Design Peak Flow (cfs)	727	Added flows from existing CD at Osceola Polk Rd

Cross Drain Sizing Calculations

Assumed Velocity (ft/s)	6
Cross-sectional Area Required (ft^2)	121.13
Recommended Culvert Size	2 - 10 ft x 6.1 ft
Provided Cross Sectional Area (ft^2)	122.00
Est. SHWL Elev (ft-NAVD88)	74.0
Est. Ground Elev (ft-NAVD88)	73.3
Additional Culvert Height Required	0.7
Recommended Culvert Size Total	2 - 10 ft x 7 ft

REFERENCE COPY

Cost Estimate Calculations

Pay Item No.	Description	Unit	Quantity
400-4-1	Concrete Class IV, Culverts	CY	770.7
415-1-1	Reinforcing Steel - Roadway	LB	204,236
530-3-4	Riprap, Rubble, F&I, Ditch Lining	TN	31.0

Notes:

[1] Pervious Runoff Coefficients value assumed to be the max of Pasture/Grass with poorly drained soils at 2-7% slope. Frequency Factor applied per Design Storm Event (Tables B-4 & B-5, FDOT Drainage Design Guide, January 2017).

[2] Per FDOT Drainage Manual, 50-year considered design event for mainline interstates and 100-year used if culvert proposed within regulated floodway.

[3] Design Intensity calculated from FDOT IDF Regression Equations for Tc < 180 minutes. If Tc > 180 minutes, intensity estimated directly from the IDF Curve.

PROJECT:	CFX Feasibility Study: I-4 / Poinciana Parkway Connector	**PREPARED:**	ALE	**DATE:**	01/17/18
LOCATION:	Osceola and Polk County, Florida	**CHECKED:**	JAN	**DATE:**	02/06/18

Table B.5 - Proposed Offsite Conveyance Calculations

Proposed Cross Drain at Poinciana Pkwy Extension/I-4 Connector

Cross Drain Name	CD-104
Corridor	429_Alt4, 429_Alt3
Precipitation Zone	7
Pervious C-Value[1]	0.3
Impervious C-value	0.95
Time of Concentration (min)	114.7

Basin Runoff Calculations

Total Contributing Area (acres)	166.28
Pervious Contributing Area (acres)	154.64
Impervious Contributing Area (acres)	11.64
Weighted Runoff Coefficient[1]	0.40
Design Event[2]	50-year
Design Intensity (in/hr)[3]	2.64
Design Peak Flow (cfs)	176.14

Cross Drain Sizing Calculations

Assumed Velocity (ft/s)	6
Cross-sectional Area Required (ft^2)	29.36
Recommended Culvert Size	8 ft x 4 ft
Provided Cross Sectional Area (ft^2)	32.00
Upstream Est. SHWL Elev (ft-NAVD88)	75
Upstream Est. Ground Elev (ft-NAVD88)	73.5
Additional Culvert Height Required	1.5
Recommended Culvert Size Total	8 ft x 6 ft

REFERENCE COPY

Cost Estimate Calculations

Pay Item No.	Description	Unit	Quantity
400-4-1	Concrete Class IV, Culverts	CY	323.4
415-1-1	Reinforcing Steel - Roadway	LB	85,701
530-3-4	Riprap, Rubble, F&I, Ditch Lining	TN	18.2

Notes:

[1] Pervious Runoff Coefficients value assumed to be the max of Pasture/Grass with poorly drained soils at 2-7% slope. Frequency Factor applied per Design Storm Event (Tables B-4 & B-5, FDOT Drainage Design Guide, January 2017).

[2] Per FDOT Drainage Manual, 50-year considered design event for mainline interstates and 100-year used if culvert proposed within regulated floodway.

[3] Design Intensity calculated from FDOT IDF Regression Equations for Tc < 180 minutes. If Tc > 180 minutes, intensity estimated directly from the IDF Curve.

PROJECT:	CFX Feasibility Study: I-4 / Poinciana Parkway Connector	**PREPARED:**	ALE	**DATE:**	01/17/18
LOCATION:	Osceola and Polk County, Florida	**CHECKED:**	JAN	**DATE:**	02/06/18

Table B.5 - Proposed Offsite Conveyance Calculations

Proposed Cross Drain at Poinciana Pkwy Extension/I-4 Connector

Cross Drain Name	CD-105
Corridor	429_Alt4, 429_Alt3
Precipitation Zone	7
Pervious C-Value[1]	0.3
Impervious C-value	0.95
Time of Concentration (min)	37.7

Basin Runoff Calculations

Total Contributing Area (acres)	36.68
Pervious Contributing Area (acres)	34.85
Impervious Contributing Area (acres)	1.83
Weighted Runoff Coefficient[1]	0.39
Design Event[2]	50-year
Design Intensity (in/hr)[3]	5.29
Design Peak Flow (cfs)	75.51

Cross Drain Sizing Calculations

Assumed Velocity (ft/s)	6
Cross-sectional Area Required (ft^2)	12.58
Recommended Culvert Size	54 inch
Provided Cross Sectional Area (ft^2)	15.90
Upstream Est. SHWL Elev (ft-NAVD88)	75.0
Upstream Est. Ground Elev (ft-NAVD88)	76.4
Additional Culvert Height Required	0.0
Equlivent Recommended Culvert Size (CBC)	54 inch

REFERENCE COPY

Cost Estimate Calculations

Pay Item No.	Description	Unit	Quantity
400-1-2	Concrete Class I, Endwalls	CY	23.42
430-175-154	Pipe Culvert, Round, 54" CD	LF	294
530-3-4	Riprap, Rubble, F&I, Ditch Lining	TN	11.7

Notes:

[1] Pervious Runoff Coefficients value assumed to be the max of Pasture/Grass with poorly drained soils at 2-7% slope. Frequency Factor applied per Design Storm Event (Tables B-4 & B-5, FDOT Drainage Design Guide, January 2017).

[2] Per FDOT Drainage Manual, 50-year considered design event for mainline interstates and 100-year used if culvert proposed within regulated floodway.

[3] Design Intensity calculated from FDOT IDF Regression Equations for Tc < 180 minutes. If Tc > 180 minutes, intensity estimated directly from the IDF Curve.

PROJECT:	CFX Feasibility Study: I-4 / Poinciana Parkway Connector	**PREPARED:**	ALE	**DATE:**	01/17/18
LOCATION:	Osceola and Polk County, Florida	**CHECKED:**	JAN	**DATE:**	02/06/18

Table B.5 - Proposed Offsite Conveyance Calculations

Proposed Cross Drain at Poinciana Pkwy Extension/I-4 Connector

Cross Drain Name	CD-106
Corridor	2A-1, 2, 3, 4, 5
Precipitation Zone	7
Pervious C-Value[1]	0.3
Impervious C-value	0.95
Time of Concentration (min)	52.8

Basin Runoff Calculations

Total Contributing Area (acres)	43.10
Pervious Contributing Area (acres)	25.78
Impervious Contributing Area (acres)	17.32
Weighted Runoff Coefficient[1]	0.60
Design Event[2]	50-year
Design Intensity (in/hr)[3]	4.42
Design Peak Flow (cfs)	113.65

Cross Drain Sizing Calculations

Assumed Velocity (ft/s)	6	
Cross-sectional Area Required (ft^2)	18.94	
Recommended Culvert Size	60 inch	
Provided Cross Sectional Area (ft^2)	19.63	
Upstream Est. SHWL Elev (ft-NAVD88)	85.5	
Upstream Est. Ground Elev (ft-NAVD88)	83.5	
Additional Culvert Height Required	2.0	Would require a pipe > 60", convert to CBC.
Equlivent Recommended Culvert Size (CBC)	7 ft x 3 ft	
Provided Cross Sectional Area (ft^2)	21.00	
Total Recommended Culvert Size (CBC)	7 ft x 5 ft	

REFERENCE COPY

Cost Estimate Calculations

Pay Item No.	Description	Unit	Quantity
400-4-1	Concrete Class IV, Culverts	CY	282.2
415-1-1	Reinforcing Steel - Roadway	LB	74,783
530-3-4	Riprap, Rubble, F&I, Ditch Lining	TN	15.8

Notes:

[1] Pervious Runoff Coefficients value assumed to be the max of Pasture/Grass with poorly drained soils at 2-7% slope. Frequency Factor applied per Design Storm Event (Tables B-4 & B-5, FDOT Drainage Design Guide, January 2017).

[2] Per FDOT Drainage Manual, 50-year considered design event for mainline interstates and 100-year used if culvert proposed within regulated floodway.

[3] Design Intensity calculated from FDOT IDF Regression Equations for Tc < 180 minutes. If Tc > 180 minutes, intensity estimated directly from the IDF Curve.

PROJECT:	CFX Feasibility Study: I-4 / Poinciana Parkway Connector	**PREPARED:**	ALE	**DATE:**	01/17/18
LOCATION:	Osceola and Polk County, Florida	**CHECKED:**	JAN	**DATE:**	02/06/18

Table B.5 - Proposed Offsite Conveyance Calculations

Proposed Cross Drain at Poinciana Pkwy Extension/I-4 Connector

Cross Drain Name	CD-107
Corridor	2A-4 & 2A-5
Precipitation Zone	7
Pervious C-Value[1]	0.3
Impervious C-value	0.95
Time of Concentration (min)	108.9

Basin Runoff Calculations

Total Contributing Area (acres)	103.83
Pervious Contributing Area (acres)	103.00
Impervious Contributing Area (acres)	0.83
Weighted Runoff Coefficient[1]	0.36
Design Event[2]	50-year
Design Intensity (in/hr)[3]	2.74
Design Peak Flow (cfs)	103.93

Cross Drain Sizing Calculations

Assumed Velocity (ft/s)	6	
Cross-sectional Area Required (ft^2)	17.32	
Recommended Culvert Size	60 inch	
Provided Cross Sectional Area (ft^2)	19.63	
Upstream Est. SHWL Elev (ft-NAVD88)	N/A	SHWT was not estimated here for floodplain impacts.
Upstream Est. Ground Elev (ft-NAVD88)	79.9	
Additional Culvert Height Required	0.0	
Equlivent Recommended Culvert Size (CBC)	60 inch	

REFERENCE COPY

Cost Estimate Calculations

Pay Item No.	Description	Unit	Quantity
400-2-2	Concrete Class II, Endwalls	CY	22.6
415-1-1	Reinforcing Steel - Roadway	LB	1390
430-175-160	Pipe Culvert, Round, 60" CD	LF	294
530-3-4	Riprap, Rubble, F&I, Ditch Lining	TN	12.9

Notes:

[1] Pervious Runoff Coefficients value assumed to be the max of Pasture/Grass with poorly drained soils at 2-7% slope. Frequency Factor applied per Design Storm Event (Tables B-4 & B-5, FDOT Drainage Design Guide, January 2017).

[2] Per FDOT Drainage Manual, 50-year considered design event for mainline interstates and 100-year used if culvert proposed within regulated floodway.

[3] Design Intensity calculated from FDOT IDF Regression Equations for Tc < 180 minutes. If Tc > 180 minutes, intensity estimated directly from the IDF Curve.

PROJECT:	CFX Feasibility Study: I-4 / Poinciana Parkway Connector	**PREPARED:**	ALE	**DATE:**	01/17/18
LOCATION:	Osceola and Polk County, Florida	**CHECKED:**	JAN	**DATE:**	02/06/18

Table B.5 - Proposed Offsite Conveyance Calculations

Proposed Cross Drain at Poinciana Pkwy Extension/I-4 Connector

Cross Drain Name	CD-300A
Corridor	532_Alt3
Precipitation Zone	8
Pervious C-Value[1]	0.3
Impervious C-value	0.95
Time of Concentration (min)	0.0

Basin Runoff Calculations

Total Contributing Area (acres)	53.67
Pervious Contributing Area (acres)	50.00
Impervious Contributing Area (acres)	0.00
Weighted Runoff Coefficient[1]	0.34
Design Event[2]	50-year
Design Intensity (in/hr)[3]	#NUM!
Design Peak Flow (cfs)	#NUM!

Cross Drain Sizing Calculations

Assumed Velocity (ft/s)	6
Cross-sectional Area Required (ft^2)	#NUM!
Recommended Culvert Size	6 ft x 4 ft
Provided Cross Sectional Area (ft^2)	24
Upstream Est. SHWL Elev (ft-NAVD88)	N/A; SHWT below US Ground Elevation
Upstream Est. Ground Elev (ft-NAVD88)	
Additional Culvert Height Required	
Recommended Culvert Size Total	6 ft x 4 ft

REFERENCE COPY

Cost Estimate Calculations

Pay Item No.	Description	Unit	Quantity
400-4-1	Concrete Class IV, Culverts	CY	240.9
415-1-1	Reinforcing Steel - Roadway	LB	63,839
530-3-4	Riprap, Rubble, F&I, Ditch Lining	TN	13.4

Notes:

[1] Pervious Runoff Coefficients value assumed to be the max of Pasture/Grass with poorly drained soils at 2-7% slope. Frequency Factor applied per Design Storm Event (Tables B-4 & B-5, FDOT Drainage Design Guide, January 2017).

[2] Per FDOT Drainage Manual, 50-year considered design event for mainline interstates and 100-year used if culvert proposed within regulated floodway.

[3] Design Intensity calculated from FDOT IDF Regression Equations for Tc < 180 minutes. If Tc > 180 minutes, intensity estimated directly from the IDF Curve.

PROJECT:	CFX Feasibility Study: I-4 / Poinciana Parkway Connector	**PREPARED:**	ALE	**DATE:**	01/17/18
LOCATION:	Osceola and Polk County, Florida	**CHECKED:**	JAN	**DATE:**	02/06/18

Table B.5 - Proposed Offsite Conveyance Calculations

Proposed Cross Drain at Poinciana Pkwy Extension/I-4 Connector

Cross Drain Name	CD-302
Corridor	3A-3 & 3A-5
Precipitation Zone	8
Pervious C-Value[1]	0.3
Impervious C-value	0.95
Time of Concentration (min)	98.0

Basin Runoff Calculations

Total Contributing Area (acres)	54.38
Pervious Contributing Area (acres)	53.84
Impervious Contributing Area (acres)	0.54
Weighted Runoff Coefficient[1]	0.37
Design Event[2]	50-year
Design Intensity (in/hr)[3]	3.09
Design Peak Flow (cfs)	61

Cross Drain Sizing Calculations

Assumed Velocity (ft/s)	7
Cross-sectional Area Required (ft^2)	8.77
Recommended Culvert Size	42 inch
Provided Cross Sectional Area (ft^2)	9.62
Upstream Est. SHWL Elev (ft-NAVD88)	87.0
Upstream Est. Ground Elev (ft-NAVD88)	86.5
Additional Culvert Height Required	0.5
Recommended Culvert Size Total	48 inch

REFERENCE COPY

Cost Estimate Calculations

Pay Item No.	Description	Unit	Quantity
400-1-2	Concrete Class I, Endwalls	CY	16.3
430-175-148	Pipe Culvert, Round, 48" CD	LF	294
530-3-4	Riprap, Rubble, F&I, Ditch Lining	TN	10.5

Notes:

[1] Pervious Runoff Coefficients value assumed to be the max of Pasture/Grass with poorly drained soils at 2-7% slope. Frequency Factor applied per Design Storm Event (Tables B-4 & B-5, FDOT Drainage Design Guide, January 2017).

[2] Per FDOT Drainage Manual, 50-year considered design event for mainline interstates and 100-year used if culvert proposed within regulated floodway.

[3] Design Intensity calculated from FDOT IDF Regression Equations for Tc < 180 minutes. If Tc > 180 minutes, intensity estimated directly from the IDF Curve.

PROJECT:	CFX Feasibility Study: I-4 / Poinciana Parkway Connector	**PREPARED:**	ALE	**DATE:**	01/17/18
LOCATION:	Osceola and Polk County, Florida	**CHECKED:**	JAN	**DATE:**	02/06/18

Table B.5 - Proposed Offsite Conveyance Calculations

Proposed Cross Drain at Poinciana Pkwy Extension/I-4 Connector

Cross Drain Name	CD-304
Corridor	3A-3 & 3A-5
Precipitation Zone	8
Pervious C-Value[1]	0.3
Impervious C-value	0.95
Time of Concentration (min)	139.6

Basin Runoff Calculations

Total Contributing Area (acres)	75.85
Pervious Contributing Area (acres)	75.09
Impervious Contributing Area (acres)	0.76
Weighted Runoff Coefficient[1]	0.37
Design Event[2]	50-year
Design Intensity (in/hr)[3]	2.34
Design Peak Flow (cfs)	64.88

Total Contributing Flow Calculations

Exist. 36" at Osceola Polk Line Rd (cfs)	42.41	Assumed full flow at 6 fps
Exist. 6-29"x45" at Sandy Ridge Dr (cfs)	266.4	Assumed full flow at 6 fps
Total Design Peak Flow (cfs)	374	

Cross Drain Sizing Calculations

REFERENCE COPY

Assumed Velocity (ft/s)	6
Cross-sectional Area Required (ft^2)	62.28
Recommended Culvert Size	10 ft x 7 ft
Provided Cross Sectional Area (ft^2)	70.00
Upstream Est. SHWL Elev (ft-NAVD88)	83
Upstream Est. Ground Elev (ft-NAVD88)	82.7
Additional Culvert Height Required	0.3
Recommended Culvert Size Total	10 ft x 8 ft

Cost Estimate Calculations

Pay Item No.	Description	Unit	Quantity
400-4-1	Concrete Class IV, Culverts	CY	406.0
415-1-1	Reinforcing Steel - Roadway	LB	107,590
530-3-4	Riprap, Rubble, F&I, Ditch Lining	TN	23.0

Notes:

[1] Pervious Runoff Coefficients value assumed to be the max of Pasture/Grass with poorly drained soils at 2-7% slope. Frequency Factor applied per Design Storm Event (Tables B-4 & B-5, FDOT Drainage Design Guide, January 2017).

[2] Per FDOT Drainage Manual, 50-year considered design event for mainline interstates and 100-year used if culvert proposed within regulated floodway.

[3] Design Intensity calculated from FDOT IDF Regression Equations for Tc < 180 minutes. If Tc > 180 minutes, intensity estimated directly from the IDF Curve.

PROJECT:	CFX Feasibility Study: I-4 / Poinciana Parkway Connector	**PREPARED:**	ALE	**DATE:**	01/17/18
LOCATION:	Osceola and Polk County, Florida	**CHECKED:**	JAN	**DATE:**	02/06/18

Table B.5 - Proposed Offsite Conveyance Calculations

Proposed Cross Drain at Poinciana Pkwy Extension/I-4 Connector

Cross Drain Name	CD-403B
Corridor	2A-2, 2A-3, 2A-4, 2A-5, 3-5, 3-2, 3A-3, 3A-5
Precipitation Zone	8
Pervious C-Value[1]	0.3
Impervious C-value	0.95
Time of Concentration (min)	116.3

Basin Runoff Calculations

Total Contributing Area (acres)	280.49
Pervious Contributing Area (acres)	278.63
Impervious Contributing Area (acres)	1.86
Weighted Runoff Coefficient[1]	0.36
Design Event[2]	50-year
Design Intensity (in/hr)[3]	2.71
Design Peak Flow (cfs)	276.65

Total Contributing Flow Calculations[4]

36" at Kinny Harmon Rd (cfs)	53
2-24" at Kinny Harmon Rd (cfs)	37
24" at Kinney Harmon Rd (cfs)	24
Total Design Peak Flow (cfs)	391

REFERENCE COPY

Cross Drain Sizing Calculations

Assumed Velocity (ft/s)	6
Cross-sectional Area Required (ft^2)	65.11
Recommended Culvert Size	1 - 12 ft x 6 ft
Provided Cross Sectional Area (ft^2)	72.00
Upstream Est. SHWL Elev (ft-NAVD88)	65
Upstream Est. Ground Elev (ft-NAVD88)	64.8
Additional Culvert Height Required	0.2
Recommended Culvert Size Total	1 - 12 ft x 8 ft

Cost Estimate Calculations

Pay Item No.	Description	Unit	Quantity
400-4-1	Concrete Class IV, Culverts	CY	545.0
415-1-1	Reinforcing Steel - Roadway	LB	144,425
530-3-4	Riprap, Rubble, F&I, Ditch Lining	TN	24.9

Notes:

[1] Pervious Runoff Coefficients value assumed to be the max of Pasture/Grass with poorly drained soils at 2-7% slope. Frequency Factor applied per Design Storm Event (Tables B-4 & B-5, FDOT Drainage Design Guide, January 2017).

[2] Per FDOT Drainage Manual, 50-year considered design event for mainline interstates and 100-year used if culvert proposed within regulated floodway.

[3] Design Intensity calculated from FDOT IDF Regression Equations for Tc < 180 minutes. If Tc > 180 minutes, intensity estimated directly from the IDF Curve.

[4] Additional flow from CDs along Kinny Harmon Rd. from Flood Data Box within SFWMD ERP App. 141010-12 Poinciana Pkwy

PROJECT:	CFX Feasibility Study: I-4 / Poinciana Parkway Connector	**PREPARED:**	ALE	**DATE:**	01/17/18
LOCATION:	Osceola and Polk County, Florida	**CHECKED:**	JAN	**DATE:**	02/06/18

Table B.5 - Proposed Offsite Conveyance Calculations

Proposed Cross Drain at Poinciana Pkwy Extension/I-4 Connector

Cross Drain Name	CD-406B
Corridor	2A-2, 2A-5, 3-2, 3-5, 3A-5
Precipitation Zone	8
Pervious C-Value[1]	0.3
Impervious C-value	0.95
Time of Concentration (min)	109.0

Basin Runoff Calculations

Total Contributing Area (acres)	66.52
Pervious Contributing Area (acres)	65.88
Impervious Contributing Area (acres)	0.64
Weighted Runoff Coefficient[1]	0.37
Design Event[2]	50-year
Design Intensity (in/hr)[3]	2.85
Design Peak Flow (cfs)	69.33

Total Contributing Flow Calculations[4]

2-24" at Kinny Harmon Rd (cfs)	24	SFWMD Permit App. 141010-12
2-24"x38" at Kinny Harmon Rd (cfs)	24	SFWMD Permit App. 141010-12
Total Design Peak Flow (cfs)	117	

Cross Drain Sizing Calculations

REFERENCE COPY

Assumed Velocity (ft/s)	6	
Cross-sectional Area Required (ft^2)	19.6	
Recommended Culvert Size	60 inch	
Provided Cross Sectional Area (ft^2)	19.6	
Upstream Est. SHWL Elev (ft-NAVD88)	74	
Upstream Est. Ground Elev (ft-NAVD88)	73.5	
Additional Culvert Height Required	0.5	Would require a pipe > 60", convert to CBC.
Equlivent Recommended Culvert Size (CBC)	7 ft x 3 ft	
Provided Cross Sectional Area (ft^2)	21.0	
Total Recommended Culvert Size (CBC)	7 ft x 4 ft	

Cost Estimate Calculations

Pay Item No.	Description	Unit	Quantity
400-4-1	Concrete Class IV, Culverts	CY	261.5
415-1-1	Reinforcing Steel - Roadway	LB	69,298
530-3-4	Riprap, Rubble, F&I, Ditch Lining	TN	14.2

Notes:

[1] Pervious Runoff Coefficients value assumed to be the max of Pasture/Grass with poorly drained soils at 2-7% slope. Frequency Factor applied per Design Storm Event (Tables B-4 & B-5, FDOT Drainage Design Guide, January 2017).

[2] Per FDOT Drainage Manual, 50-year considered design event for mainline interstates and 100-year used if culvert proposed within regulated floodway.

[3] Design Intensity calculated from FDOT IDF Regression Equations for Tc < 180 minutes. If Tc > 180 minutes, intensity estimated directly from the IDF Curve.

[4] Additional flow from CDs along Kinny Harmon Rd. from Flood Data Box within SFWMD ERP App. 141010-12 Poinciana Pkwy

PROJECT:	CFX Feasibility Study:	**PREPARED:**	EAR	**DATE:**	02/15/18
	I-4 / Poinciana Parkway Connector				
LOCATION:	Osceola and Polk County, Florida	**CHECKED:**	JAN	**DATE:**	02/15/18

Table B.6 - Proposed Time of Concentration Summary

Cross Drain ID	Time of Concentration (min)
CD-101	31.3
CD-102	10.0
CD-103	102.7
CD-104	114.7
CD-105	37.7
CD-106	52.8
CD-107	108.9
CD-300A	16.8
CD-302	98.0
CD-304	139.6
CD-403B	116.3
CD-406B	109.0

REFERENCE COPY

PROJECT:	CFX Feasibility Study: I-4 / Poinciana Parkway Connector	**PREPARED:**	ALE	**DATE:**	12/18/17
LOCATION:	Osceola County, Florida	**CHECKED:**	JAN	**DATE:**	02/15/18

Table B.7 - Proposed Offsite Time of Concentration Calculations

EXISTING or DEVELOPED / UNDEVELOPED BASIN: CD-101

Tc or Tt (through subarea)

L = 2,158 ft

Sheet flow (Applicable to Tc only)

Segment ID	AB
1. Surface description†	Grass
2. Mannings roughness coeff., n †	0.15
3. Flow length, L (total L ≤ 100 ft.)	100
4. 2-year, 24-hour rainfall (in.) ††	4.5
5. Land slope, s (ft./ft.)	0.017
6. Compute Tt in hr, Tt = $[0.007(nL)^{0.8}] / [P_{24hr}^{0.5} s^{0.4}]$ †††	0.147
Subtotal	**0.15**

Shallow Concentrated Flow

Segment ID	BC	BC
7. Surface description (Paved or Unpaved)	Paved	Unpaved
8. Flow length, L (ft)	1,000	1,058
9. Watercourse slope, s (ft/ft)	0.005	0.010
10. Average velocity††† , V = kS^0.5 (fps)	1.45	1.61
11. Compute Tt in hr, Tt = L/3600V	0.19	0.18
Subtotal		**0.37**

REFERENCE COPY

Channel & Pipe Flow

Segment ID	
12. Segment Type	
13. Pipe Diameter (in.)	
14. Cross sectional flow area, a (assumed d=0.5 ft)	
15. Wetted perimeter, Pw	
16. Hydraulic radius (ft), r = a/Pw, Compute r	
17. Channel/Pipe slope, s (ft./ft.)	
18. Manning's roughness coeff., n	
19. V = 1.486(r^0.667)(s^0.50)/n, Compute V	
20. Flow length, L	
21. Compute Tt in hr, Tt = L/3600V	
22. Subtotal	

Time of Concentration, hr. (summation of subtotals)

Hours	0.52
Minutes	31.3
Total	**31.3**

Notes:

† Values from Table 3-1 of Urban Hydrology for Small Watersheds, Technical Release of TR-55

†† The 2-year, 24-hour rainfall was used based on TR-55 Figure B-3.

††† This equation is derived from TR-55

PROJECT:	CFX Feasibility Study:	**PREPARED:**	EAR	**DATE:**	2/15/2018
	I-4 / Poinciana Parkway Connector				
LOCATION:	Osceola and Polk County, Florida	**CHECKED:**	JAN	**DATE:**	02/15/18

Table B.7 - Proposed Offsite Time of Concentration Calculations

EXISTING or DEVELOPED / UNDEVELOPED BASIN: CD-102

Tc or Tt (through subarea)

L = 665 ft

Sheet flow (Applicable to Tc only)

Segment ID	AB
1. Surface description†	Grass
2. Mannings roughness coeff., n †	0.15
3. Flow length, L (total L ≤ 100 ft.)	100
4. 2-year, 24-hour rainfall (in.) ††	4.5
5. Land slope, s (ft./ft.)	0.038
6. Compute Tt in hr, Tt = $[0.007(nL)^{0.8}] / [P_{24hr}^{0.5} s^{0.4}]$ †††	0.107
Subtotal	**0.11**

Shallow Concentrated Flow

Segment ID	BC
7. Surface description (Paved or Unpaved)	Unpaved
8. Flow length, L (ft)	565
9. Watercourse slope, s (ft/ft)	0.037
10. Average velocity†††, V = kS^0.5 (fps)	3.09
11. Compute Tt in hr, Tt = L/3600V	0.05
Subtotal	**0.05**

REFERENCE COPY

Channel & Pipe Flow

Segment ID		
12. Segment Type		
12. Pipe Diameter (in.)		
12. Cross sectional flow area, a (assumed d=0.5 ft)		
13. Wetted perimeter, Pw		
14. Hydraulic radius (ft), r = a/Pw, Compute r		
15. Channel/Pipe slope, s (ft./ft.)		
16. Manning's roughness coeff., n		
17. V = 1.486(r^0.667)(s^0.50)/n, Compute V		
18. Flow length, L		
19. Tt = L/3600V		
20. Subtotal		

Time of Concentration, hr. (summation of subtotals)

Hours	0.16
Minutes	9.4
Total	**10.0**

Notes:

† Values from Table 3-1 of Urban Hydrology for Small Watersheds, Technical Release of TR-55

†† The 2-year, 24-hour rainfall was used based on TR-55 Figure B-3.

††† This equation is derived from TR-55

PROJECT:	CFX Feasibility Study:	**PREPARED:**	EAR	**DATE:**	2/15/2018
	I-4 / Poinciana Parkway Connector				
LOCATION:	Osceola and Polk County, Florida	**CHECKED:**	JAN	**DATE:**	02/15/18

Table B.7 - Proposed Offsite Time of Concentration Calculations

EXISTING or DEVELOPED / UNDEVELOPED BASIN: CD-103

Tc or Tt (through subarea)

L = 6184 ft

Sheet flow (Applicable to Tc only)

Segment ID	AB
1. Surface description†	Range
2. Mannings roughness coeff., n †	0.13
3. Flow length, L (total L ≤ 100 ft.)	100
4. 2-year, 24-hour rainfall (in.) ††	4.5
5. Land slope, s (ft./ft.)	0.045
6. Compute Tt in hr, Tt = $[0.007(nL)^{0.8}] / [P_{24hr}^{0.5} s^{0.4}]$ †††	0.089
Subtotal	**0.09**

Shallow Concentrated Flow

Segment ID	BC	BC
7. Surface description (Paved or Unpaved)	Unpaved	Unpaved
8. Flow length, L (ft)	1138	4946
9. Watercourse slope, s (ft/ft)	0.036	0.003
10. Average velocity†††, V = kS^0.5 (fps)	3.08	0.90
11. Compute Tt in hr, Tt = L/3600V	0.10	1.52
Subtotal		**1.62**

REFERENCE COPY

Channel & Pipe Flow

Segment ID		
12. Segment Type		
12. Pipe Diameter (in.)		
12. Cross sectional flow area, a (assumed d=0.5 ft)		
13. Wetted perimeter, Pw		
14. Hydraulic radius (ft), r = a/Pw, Compute r		
15. Channel/Pipe slope, s (ft./ft.)		
16. Manning's roughness coeff., n		
17. V = 1.486(r^0.667)(s^0.50)/n, Compute V		
18. Flow length, L		
19. Tt = L/3600V		
20. Subtotal		

Time of Concentration, hr. (summation of subtotals)

Hours	1.71
Minutes	102.7
Total	**102.7**

Notes:

† Values from Table 3-1 of Urban Hydrology for Small Watersheds, Technical Release of TR-55

†† The 2-year, 24-hour rainfall was used based on TR-55 Figure B-3.

††† This equation is derived from TR-55

PROJECT:	CFX Feasibility Study:	**PREPARED:**	EAR	**DATE:**	2/15/2018
	I-4 / Poinciana Parkway Connector				
LOCATION:	Osceola and Polk County, Florida	**CHECKED:**	JAN	**DATE:**	02/15/18

Table B.7 - Proposed Offsite Time of Concentration Calculations

EXISTING or DEVELOPED / UNDEVELOPED BASIN: CD-104

Tc or Tt (through subarea)

L = 4870 ft

Sheet flow (Applicable to Tc only)

Segment ID	AB
1. Surface description†	Woods
2. Mannings roughness coeff., n †	0.4
3. Flow length, L (total L ≤ 100 ft.)	100
4. 2-year, 24-hour rainfall (in.) ††	4.5
5. Land slope, s (ft./ft.)	0.004
6. Compute Tt in hr, Tt = $[0.007(nL)^{0.8}] / [P_{24hr}^{0.5} s^{0.4}]$ †††	0.575
Subtotal	**0.57**

Shallow Concentrated Flow

Segment ID	BC
7. Surface description (Paved or Unpaved)	Unpaved
8. Flow length, L (ft)	4770
9. Watercourse slope, s (ft/ft)	0.004
10. Average velocity†††, V = kS^0.5 (fps)	0.99
11. Compute Tt in hr, Tt = L/3600V	1.34
Subtotal	**1.34**

REFERENCE COPY

Channel & Pipe Flow

Segment ID		
12. Segment Type		
12. Pipe Diameter (in.)		
12. Cross sectional flow area, a (assumed d=0.5 ft)		
13. Wetted perimeter, Pw		
14. Hydraulic radius (ft), r = a/Pw, Compute r		
15. Channel/Pipe slope, s (ft./ft.)		
16. Manning's roughness coeff., n		
17. V = 1.486(r^0.667)(s^0.50)/n, Compute V		
18. Flow length, L		
19. Tt = L/3600V		
20. Subtotal		

Time of Concentration, hr. (summation of subtotals)

Hours	1.91
Minutes	114.7
Total	**114.7**

Notes:

† Values from Table 3-1 of Urban Hydrology for Small Watersheds, Technical Release of TR-55

†† The 2-year, 24-hour rainfall was used based on TR-55 Figure B-3.

††† This equation is derived from TR-55

PROJECT:	CFX Feasibility Study:	**PREPARED:**	EAR	**DATE:**	2/15/2018
	I-4 / Poinciana Parkway Connector				
LOCATION:	Osceola and Polk County, Florida	**CHECKED:**	JAN	**DATE:**	02/15/18

Table B.7 - Proposed Offsite Time of Concentration Calculations

EXISTING or DEVELOPED / UNDEVELOPED BASIN: CD-105

Tc or Tt (through subarea)

L = 1517 ft

Sheet flow (Applicable to Tc only)

Segment ID	AB
1. Surface description†	Range
2. Mannings roughness coeff., n †	0.13
3. Flow length, L (total L ≤ 100 ft.)	100
4. 2-year, 24-hour rainfall (in.) ††	4.5
5. Land slope, s (ft./ft.)	0.004
6. Compute Tt in hr, Tt = $[0.007(nL)^{0.8}] / [P_{24hr}^{0.5} s^{0.4}]$ †††	0.234
Subtotal	**0.23**

Shallow Concentrated Flow

Segment ID	BC	BC
7. Surface description (Paved or Unpaved)	Unpaved	Unpaved
8. Flow length, L (ft)	441	1417
9. Watercourse slope, s (ft/ft)	0.012	0.006
10. Average velocity†††, V = kS^0.5 (fps)	1.74	1.21
11. Compute Tt in hr, Tt = L/3600V	0.07	0.32
Subtotal		**0.40**

REFERENCE COPY

Channel & Pipe Flow

Segment ID		
12. Segment Type		
12. Pipe Diameter (in.)		
12. Cross sectional flow area, a (assumed d=0.5 ft)		
13. Wetted perimeter, Pw		
14. Hydraulic radius (ft), r = a/Pw, Compute r		
15. Channel/Pipe slope, s (ft./ft.)		
16. Manning's roughness coeff., n		
17. V = 1.486(r^0.667)(s^0.50)/n, Compute V		
18. Flow length, L		
19. Tt = L/3600V		
20. Subtotal		

Time of Concentration, hr. (summation of subtotals)

Hours	0.63
Minutes	37.7
Total	**37.7**

Notes:

† Values from Table 3-1 of Urban Hydrology for Small Watersheds, Technical Release of TR-55

†† The 2-year, 24-hour rainfall was used based on TR-55 Figure B-3.

††† This equation is derived from TR-55

PROJECT:	CFX Feasibility Study:	**PREPARED:**	EAR	**DATE:**	2/15/2018
	I-4 / Poinciana Parkway Connector				
LOCATION:	Osceola and Polk County, Florida	**CHECKED:**	JAN	**DATE:**	02/15/18

Table B.7 - Proposed Offsite Time of Concentration Calculations

EXISTING or DEVELOPED / UNDEVELOPED BASIN: CD-106

Tc or Tt (through subarea)

L = 2418 ft

Sheet flow (Applicable to Tc only)

Segment ID	AB
1. Surface description†	Range
2. Mannings roughness coeff., n †	0.13
3. Flow length, L (total L ≤ 100 ft.)	100
4. 2-year, 24-hour rainfall (in.) ††	4.5
5. Land slope, s (ft./ft.)	0.004
6. Compute Tt in hr, Tt = $[0.007(nL)^{0.8}] / [P_{24hr}^{0.5} s^{0.4}]$ †††	0.234
Subtotal	**0.23**

Shallow Concentrated Flow

Segment ID	BC
7. Surface description (Paved or Unpaved)	Unpaved
8. Flow length, L (ft)	2318
9. Watercourse slope, s (ft/ft)	0.004
10. Average velocity†††, V = kS^0.5 (fps)	1.00
11. Compute Tt in hr, Tt = L/3600V	0.65
Subtotal	**0.65**

REFERENCE COPY

Channel & Pipe Flow

Segment ID	
12. Segment Type	
12. Pipe Diameter (in.)	
12. Cross sectional flow area, a (assumed d=0.5 ft)	
13. Wetted perimeter, Pw	
14. Hydraulic radius (ft), r = a/Pw, Compute r	
15. Channel/Pipe slope, s (ft./ft.)	
16. Manning's roughness coeff., n	
17. V = 1.486(r^0.667)(s^0.50)/n, Compute V	
18. Flow length, L	
19. Tt = L/3600V	
20. Subtotal	

Time of Concentration, hr. (summation of subtotals)		
	Hours	0.88
	Minutes	52.8
	Total	**52.8**

Notes:

† Values from Table 3-1 of Urban Hydrology for Small Watersheds, Technical Release of TR-55

†† The 2-year, 24-hour rainfall was used based on TR-55 Figure B-3.

††† This equation is derived from TR-55

PROJECT:	CFX Feasibility Study: I-4 / Poinciana Parkway Connector	**PREPARED:**	ALE	**DATE:**	11/3/2017
LOCATION:	Osceola County, Florida	**CHECKED:**	JAN	**DATE:**	02/15/18

Table B.7 - Proposed Offsite Time of Concentration Calculations

EXISTING or DEVELOPED / UNDEVELOPED BASIN: CD-107

Tc or Tt (through subarea)

L = 3,255 ft

Sheet flow (Applicable to Tc only)

Segment ID	AB
1. Surface description†	Woods
2. Mannings roughness coeff., n †	0.4
3. Flow length, L (total L ≤ 100 ft.)	100
4. 2-year, 24-hour rainfall (in.) ††	4.5
5. Land slope, s (ft./ft.)	0.005
6. Compute Tt in hr, Tt = $[0.007(nL)^{0.8}] / [P_{24hr}^{0.5} s^{0.4}]$ †††	0.525
Subtotal	**0.53**

Shallow Concentrated Flow

Segment ID	BC
7. Surface description (Paved or Unpaved)	Unpaved
8. Flow length, L (ft)	3,155
9. Watercourse slope, s (ft/ft)	0.002
10. Average velocity†††, V = kS^0.5 (fps)	0.68
11. Compute Tt in hr, Tt = L/3600V	1.29
Subtotal	**1.29**

REFERENCE COPY

Channel & Pipe Flow

Segment ID	
12. Segment Type	
13. Pipe Diameter (in.)	
14. Cross sectional flow area, a (assumed d=0.5 ft)	
15. Wetted perimeter, Pw	
16. Hydraulic radius (ft), r = a/Pw, Compute r	
17. Channel/Pipe slope, s (ft./ft.)	
18. Manning's roughness coeff., n	
19. V = 1.486(r^0.667)(s^0.50)/n, Compute V	
20. Flow length, L	
21. Compute Tt in hr, Tt = L/3600V	
22. Subtotal	

Time of Concentration, hr. (summation of subtotals)

Hours	1.81
Minutes	108.9
Total	**108.9**

Notes:

† Values from Table 3-1 of Urban Hydrology for Small Watersheds, Technical Release of TR-55

†† The 2-year, 24-hour rainfall was used based on TR-55 Figure B-3.

††† This equation is derived from TR-55

PROJECT:	CFX Feasibility Study: I-4 / Poinciana Parkway Connector	**PREPARED:**	ALE	**DATE:**	12/18/17
LOCATION:	Osceola County, Florida	**CHECKED:**	JAN	**DATE:**	02/15/18

Table B.7 - Proposed Offsite Time of Concentration Calculations

EXISTING or DEVELOPED / UNDEVELOPED BASIN: CD-300A

Tc or Tt (through subarea)

L = 1,181 ft

Sheet flow (Applicable to Tc only)

Segment ID	AB
1. Surface description†	Grass
2. Mannings roughness coeff., n †	0.15
3. Flow length, L (total L ≤ 100 ft.)	100
4. 2-year, 24-hour rainfall (in.) ††	4.5
5. Land slope, s (ft./ft.)	0.021
6. Compute Tt in hr, Tt = $[0.007(nL)^{0.8}] / [P_{24hr}^{0.5} s^{0.4}]$ †††	0.135
Subtotal	**0.14**

Shallow Concentrated Flow

Segment ID	BC
7. Surface description (Paved or Unpaved)	Unpaved
8. Flow length, L (ft)	1,081
9. Watercourse slope, s (ft/ft)	0.017
10. Average velocity†††, V = kS^0.5 (fps)	2.08
11. Compute Tt in hr, Tt = L/3600V	0.14
Subtotal	**0.14**

REFERENCE COPY

Channel & Pipe Flow

Segment ID	
12. Segment Type	
13. Pipe Diameter (in.)	
14. Cross sectional flow area, a (assumed d=0.5 ft)	
15. Wetted perimeter, Pw	
16. Hydraulic radius (ft), r = a/Pw, Compute r	
17. Channel/Pipe slope, s (ft./ft.)	
18. Manning's roughness coeff., n	
19. V = 1.486(r^0.667)(s^0.50)/n, Compute V	
20. Flow length, L	
21. Compute Tt in hr, Tt = L/3600V	
22. Subtotal	

Time of Concentration, hr. (summation of subtotals)		
	Hours	0.28
	Minutes	16.8
	Total	**16.8**

Notes:

† Values from Table 3-1 of Urban Hydrology for Small Watersheds, Technical Release of TR-55

†† The 2-year, 24-hour rainfall was used based on TR-55 Figure B-3.

††† This equation is derived from TR-55

PROJECT:	CFX Feasibility Study:	**PREPARED:**	ALE	**DATE:**	11/03/17
	I-4 / Poinciana Parkway Connector				
LOCATION:	Osceola County, Florida	**CHECKED:**	JAN	**DATE:**	02/15/18

Table B.7 - Proposed Offsite Time of Concentration Calculations

EXISTING or DEVELOPED / UNDEVELOPED BASIN: CD-302

Tc or Tt (through subarea)

L = 2,124 ft

Sheet flow (Applicable to Tc only)

Segment ID	AB
1. Surface description†	Woods
2. Mannings roughness coeff., n †	0.4
3. Flow length, L (total L ≤ 100 ft.)	100
4. 2-year, 24-hour rainfall (in.) ††	4.5
5. Land slope, s (ft./ft.)	0.004
6. Compute Tt in hr, Tt = $[0.007(nL)^{0.8}] / [P_{24hr}^{0.5} s^{0.4}]$ †††	0.575
Subtotal	**0.57**

Shallow Concentrated Flow

Segment ID	BC	BC
7. Surface description (Paved or Unpaved)	Unpaved	Unpaved
8. Flow length, L (ft)	570	1,454
9. Watercourse slope, s (ft/ft)	0.009	0.0007
10. Average velocity†††, V = kS^0.5 (fps)	1.51	0.42
11. Compute Tt in hr, Tt = L/3600V	0.10	0.95
Subtotal		**1.06**

REFERENCE COPY

Channel & Pipe Flow

Segment ID	
12. Segment Type	
13. Pipe Diameter (in.)	
14. Cross sectional flow area, a (assumed d=0.5 ft)	
15. Wetted perimeter, Pw	
16. Hydraulic radius (ft), r = a/Pw, Compute r	
17. Channel/Pipe slope, s (ft./ft.)	
18. Manning's roughness coeff., n	
19. V = 1.486(r^0.667)(s^0.50)/n, Compute V	
20. Flow length, L	
21. Compute Tt in hr, Tt = L/3600V	
22. Subtotal	

Time of Concentration, hr. (summation of subtotals)

Hours	1.63
Minutes	98.0
Total	**98.0**

Notes:

† Values from Table 3-1 of Urban Hydrology for Small Watersheds, Technical Release of TR-55

†† The 2-year, 24-hour rainfall was used based on TR-55 Figure B-3.

††† This equation is derived from TR-55

PROJECT:	CFX Feasibility Study: I-4 / Poinciana Parkway Connector	**PREPARED:**	ALE	**DATE:**	11/03/17
LOCATION:	Osceola County, Florida	**CHECKED:**	JAN	**DATE:**	02/15/18

Table B.7 - Proposed Offsite Time of Concentration Calculations

EXISTING or DEVELOPED / UNDEVELOPED BASIN: CD-304

Tc or Tt (through subarea)

L = 1,537 ft

Sheet flow (Applicable to Tc only)

Segment ID	AB
1. Surface description†	Woods
2. Mannings roughness coeff., n †	0.4
3. Flow length, L (total L ≤ 100 ft.)	100
4. 2-year, 24-hour rainfall (in.) ††	4.5
5. Land slope, s (ft./ft.)	0.001
6. Compute Tt in hr, Tt = $[0.007(nL)^{0.8}] / [P_{24hr}^{0.5} s^{0.4}]$ †††	1.000
Subtotal	**1.00**

Shallow Concentrated Flow

Segment ID	BC
7. Surface description (Paved or Unpaved)	Unpaved
8. Flow length, L (ft)	1,437
9. Watercourse slope, s (ft/ft)	0.0003
10. Average velocity†††, V = kS^0.5 (fps)	0.30
11. Compute Tt in hr, Tt = L/3600V	1.33
Subtotal	**1.33**

REFERENCE COPY

Channel & Pipe Flow

Segment ID	
12. Segment Type	
13. Pipe Diameter (in.)	
14. Cross sectional flow area, a (assumed d=0.5 ft)	
15. Wetted perimeter, Pw	
16. Hydraulic radius (ft), r = a/Pw, Compute r	
17. Channel/Pipe slope, s (ft./ft.)	
18. Manning's roughness coeff., n	
19. V = 1.486(r^0.667)(s^0.50)/n, Compute V	
20. Flow length, L	
21. Compute Tt in hr, Tt = L/3600V	
22. Subtotal	

Time of Concentration, hr. (summation of subtotals)		
	Hours	2.33
	Minutes	139.6
	Total	**139.6**

Notes:

† Values from Table 3-1 of Urban Hydrology for Small Watersheds, Technical Release of TR-55

†† The 2-year, 24-hour rainfall was used based on TR-55 Figure B-3.

††† This equation is derived from TR-55

PROJECT:	CFX Feasibility Study: I-4 / Poinciana Parkway Connector	**PREPARED:**	ALE	**DATE:**	11/03/17
LOCATION:	Osceola County, Florida	**CHECKED:**	JAN	**DATE:**	02/15/18

Table B.7 - Proposed Offsite Time of Concentration Calculations

EXISTING or DEVELOPED / UNDEVELOPED BASIN: CD-403B

Tc or Tt (through subarea)

L = 3,748 ft

Sheet flow (Applicable to Tc only)

Segment ID	AB
1. Surface description†	Woods
2. Mannings roughness coeff., n †	0.4
3. Flow length, L (total L ≤ 100 ft.)	100
4. 2-year, 24-hour rainfall (in.) ††	4.5
5. Land slope, s (ft./ft.)	0.003
6. Compute Tt in hr, Tt = $[0.007(nL)^{0.8}] / [P_{24hr}^{0.5} s^{0.4}]$ †††	0.645
Subtotal	**0.64**

Shallow Concentrated Flow

Segment ID	BC
7. Surface description (Paved or Unpaved)	Unpaved
8. Flow length, L (ft)	205
9. Watercourse slope, s (ft/ft)	0.005
10. Average velocity†††, V = kS^0.5 (fps)	1.13
11. Compute Tt in hr, Tt = L/3600V	0.05
Subtotal	**0.05**

REFERENCE COPY

Channel & Pipe Flow

Segment ID	CD
12. Segment Type	Channel
13. Pipe Diameter (in.)	--
14. Cross sectional flow area, a (assumed d=0.5 ft)	3.5
15. Wetted perimeter, Pw	9.12
16. Hydraulic radius (ft), r = a/Pw, Compute r	0.38
17. Channel/Pipe slope, s (ft./ft.)	0.006
18. Manning's roughness coeff., n	0.08
19. V = 1.486(r^0.667)(s^0.50)/n, Compute V	0.77
20. Flow length, L	3,443
21. Compute Tt in hr, Tt = L/3600V	1.24
22. Subtotal	**1.24**

Time of Concentration, hr. (summation of subtotals)	
Hours	1.94
Minutes	116.3
Total	**116.3**

Notes:

† Values from Table 3-1 of Urban Hydrology for Small Watersheds, Technical Release of TR-55

†† The 2-year, 24-hour rainfall was used based on TR-55 Figure B-3.

††† This equation is derived from TR-55

PROJECT:	CFX Feasibility Study: I-4 / Poinciana Parkway Connector	**PREPARED:**	ALE	**DATE:**	11/03/17
LOCATION:	Osceola County, Florida	**CHECKED:**	JAN	**DATE:**	02/15/18

Table B.7 - Proposed Offsite Time of Concentration Calculations

EXISTING or DEVELOPED / UNDEVELOPED BASIN: CD-406B

Tc or Tt (through subarea)

L = 2,924 ft

Sheet flow (Applicable to Tc only)

Segment ID	AB
1. Surface description†	Grass
2. Mannings roughness coeff., n †	0.15
3. Flow length, L (total L ≤ 100 ft.)	100
4. 2-year, 24-hour rainfall (in.) ††	4.5
5. Land slope, s (ft./ft.)	0.002
6. Compute Tt in hr, Tt = $[0.007(nL)^{0.8}] / [P_{24hr}^{0.5} s^{0.4}]$ †††	0.346
Subtotal	**0.35**

Shallow Concentrated Flow

Segment ID	BC	BC
7. Surface description (Paved or Unpaved)	Unpaved	Unpaved
8. Flow length, L (ft)	900	2,824
9. Watercourse slope, s (ft/ft)	0.005	0.002
10. Average velocity†††, V = kS^0.5 (fps)	1.12	0.63
11. Compute Tt in hr, Tt = L/3600V	0.22	1.25
Subtotal		**1.47**

REFERENCE COPY

Channel & Pipe Flow

Segment ID	
12. Segment Type	
13. Pipe Diameter (in.)	
14. Cross sectional flow area, a (assumed d=0.5 ft)	
15. Wetted perimeter, Pw	
16. Hydraulic radius (ft), r = a/Pw, Compute r	
17. Channel/Pipe slope, s (ft./ft.)	
18. Manning's roughness coeff., n	
19. V = 1.486(r^0.667)(s^0.50)/n, Compute V	
20. Flow length, L	
21. Compute Tt in hr, Tt = L/3600V	
22. Subtotal	

Time of Concentration, hr. (summation of subtotals)

Hours	1.82
Minutes	109.0
Total	**109.0**

Notes:

† Values from Table 3-1 of Urban Hydrology for Small Watersheds, Technical Release of TR-55

†† The 2-year, 24-hour rainfall was used based on TR-55 Figure B-3.

††† This equation is derived from TR-55